


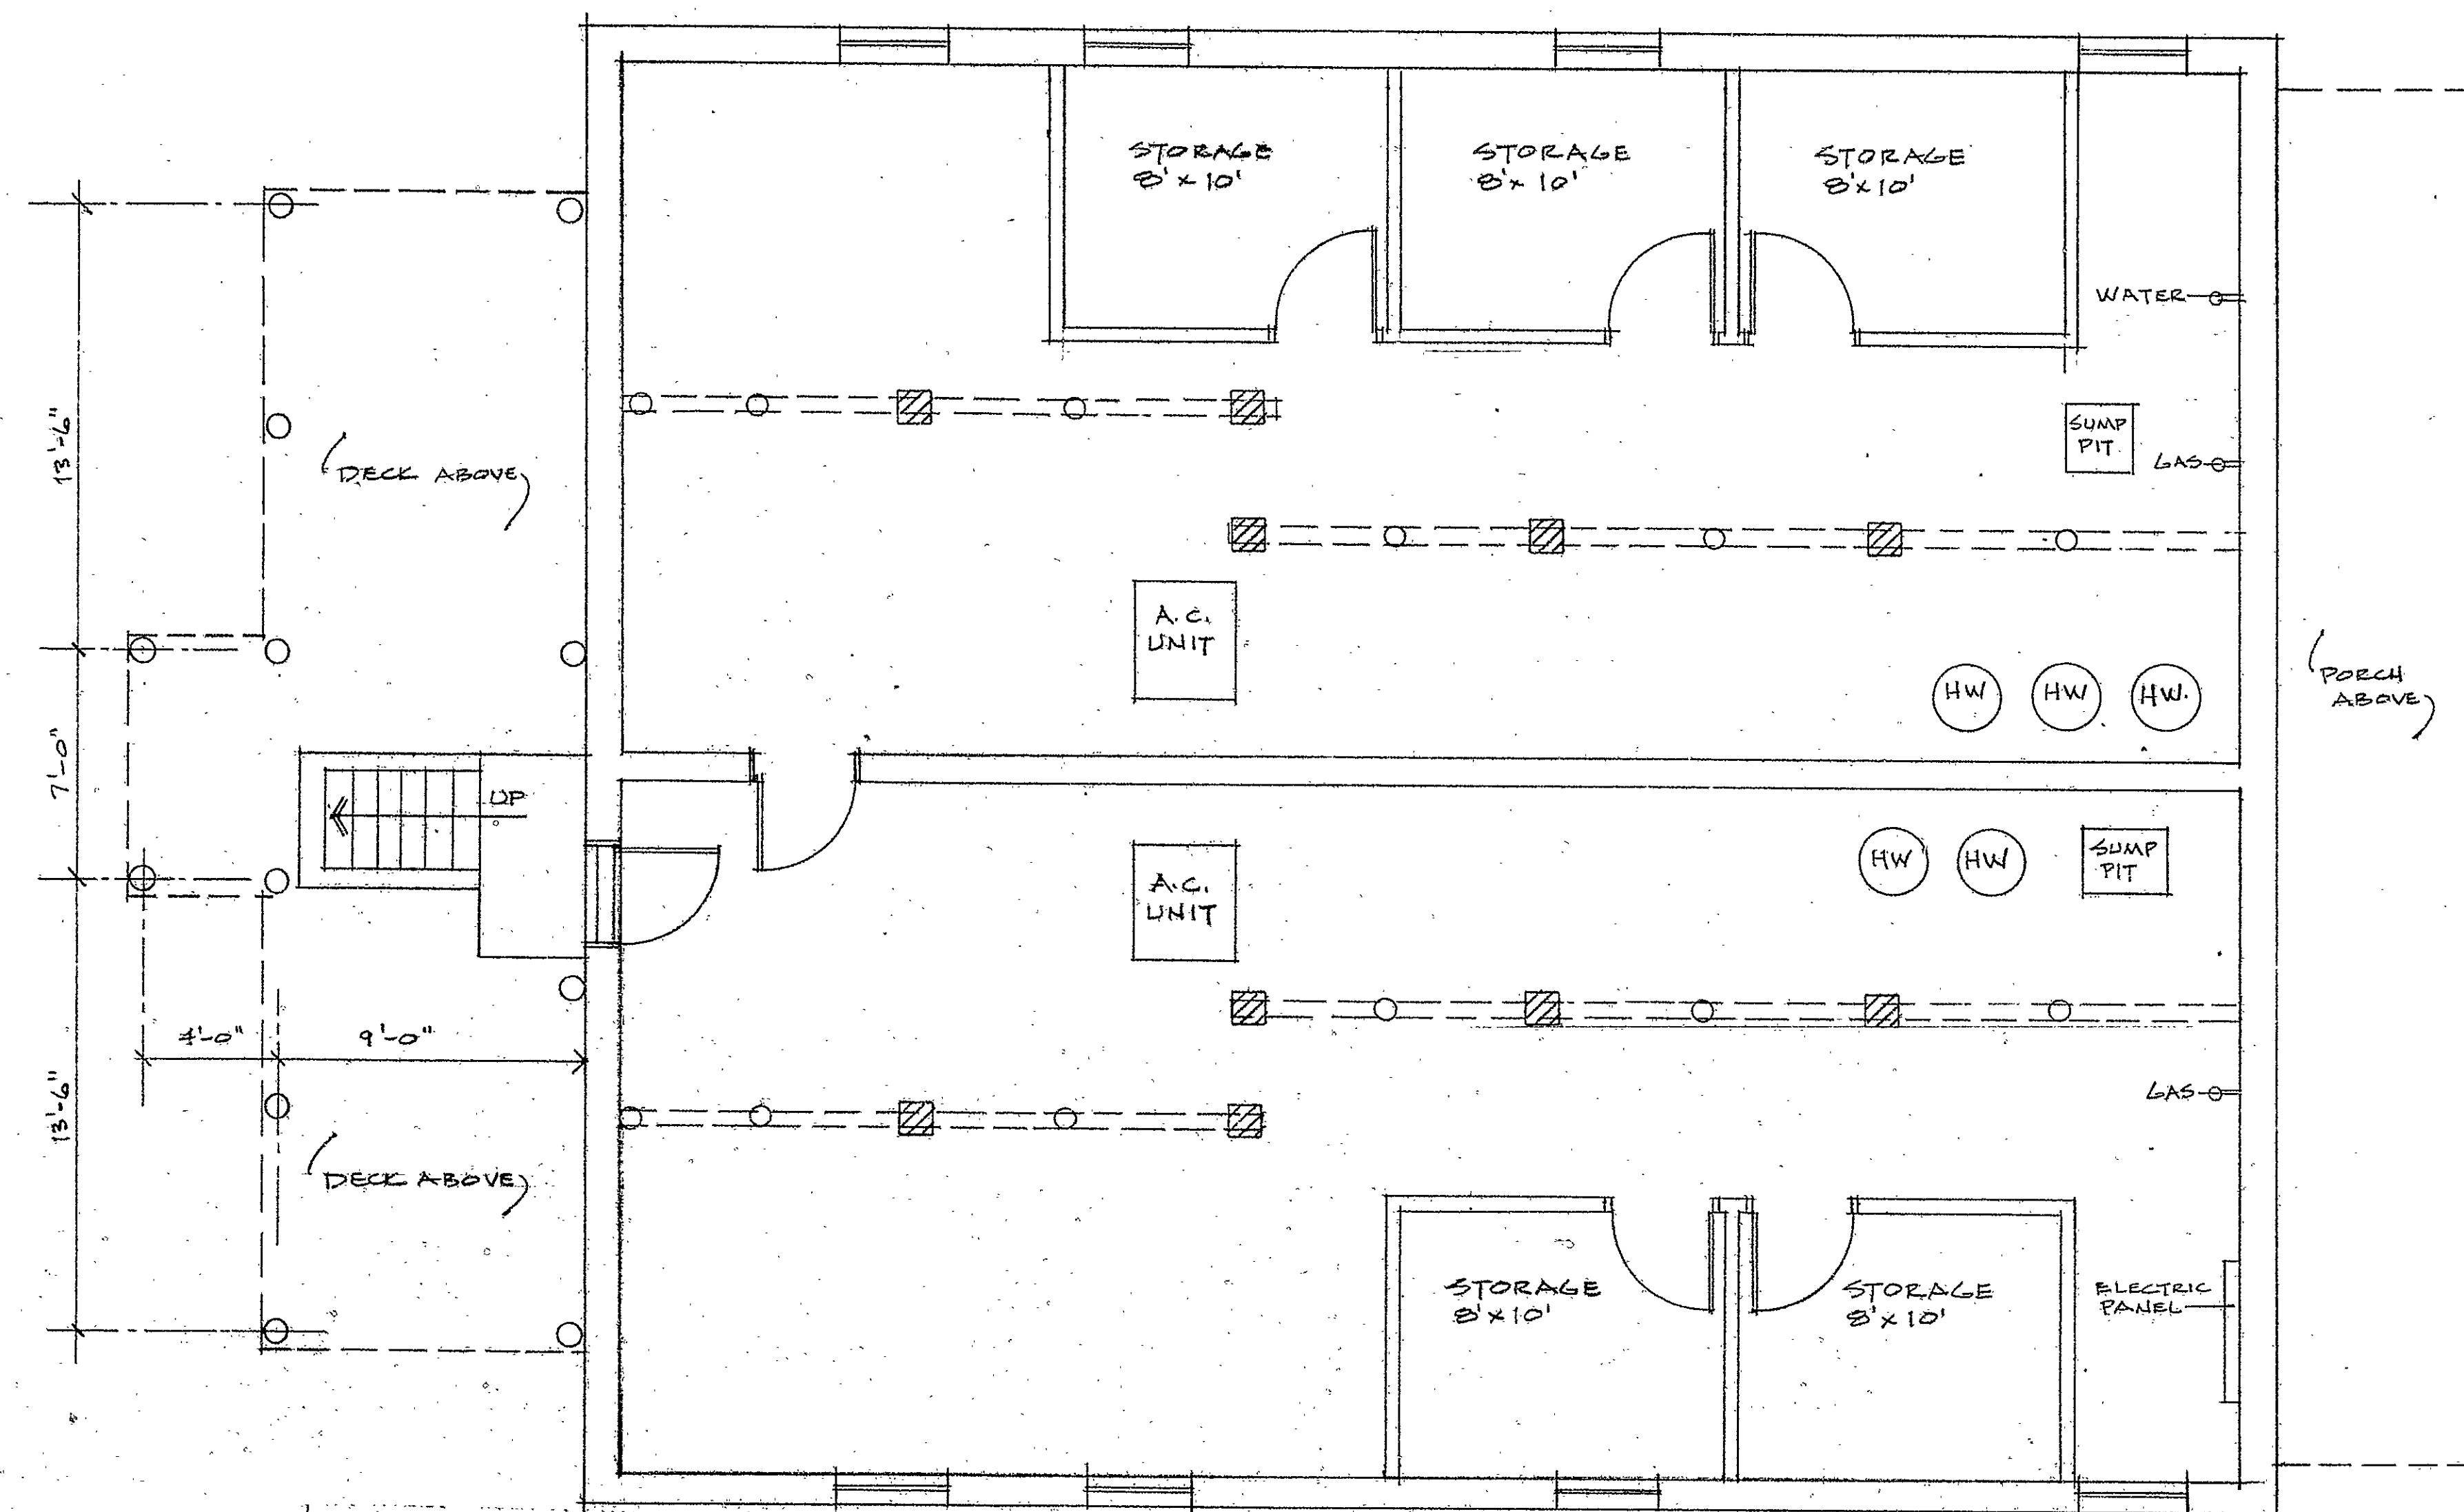


I hereby certify that these plans are an accurate copy of that portion of the plans filed with the building official of the Town of Hartford appointed pursuant to Section 19-396 of the Connecticut General Statutes Revision of 1958, as amended.

Richard J. Christinger

Subscribed and sworn to, before me, this 21 day of February, 1980.

Martha Stone
Commissioner of the Superior Court.

BASEMENT PLAN
1/4" = 1'-0"

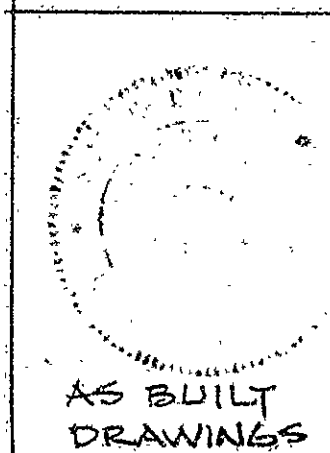

AS BUILT
DRAWINGS

67-69 WILLARD ST., A CONDOMINIUM
67 WS ASSOCIATES, DEVELOPERS
HARTFORD, CONNECTICUT

BASEMENT PLAN

FEBRUARY 15, 1980 DRAWING No. A-2

RECEIVED BY
Robert A. DeLeon
FEB 22 12 37 PM '80
TOWN OF HARTFORD
VOLUME PAGE

20

Condo # 20

0 INCHES 1 2 3 4