


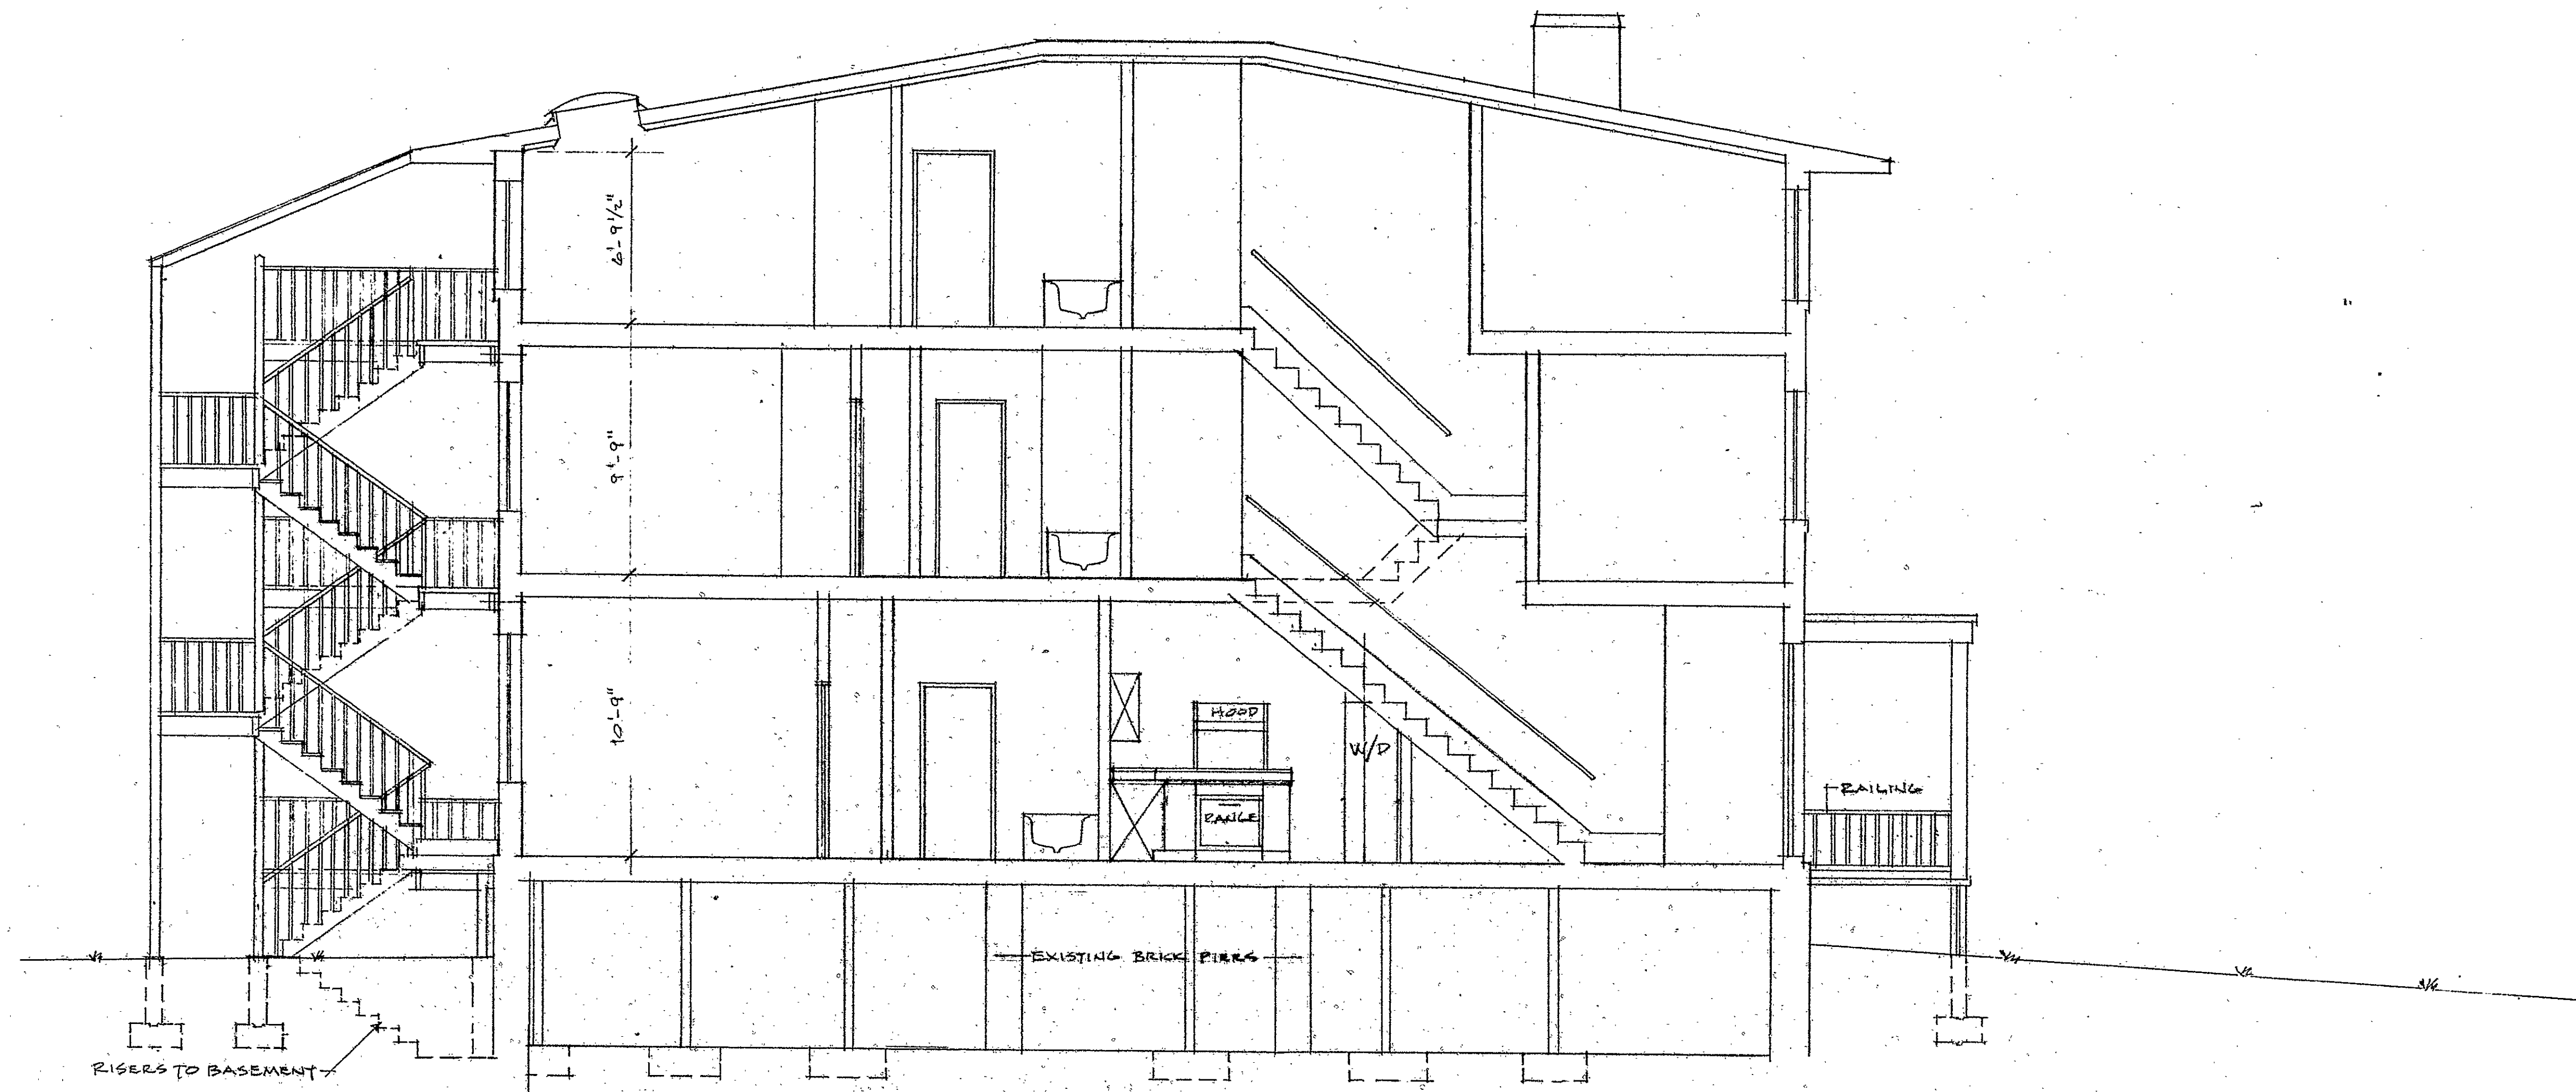


I hereby certify that these plans are an accurate copy of that portion of the plans filed with the building official of the Town of Hartford appointed pursuant to Section 15-396 of the Connecticut General Statutes Revision of 1958, as amended.

Philip J. Heringer

Subscribed and sworn to, before me, this 21 day of February, 1980.

Martha Stone
Commissioner of the Superior Court

LONGITUDINAL SECTION
1/4" = 1'-0"

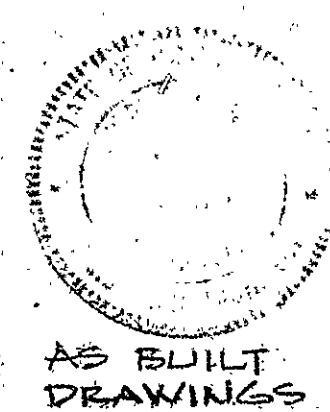

AS BUILT
DRAWINGS

67-69 WILLARD ST., A CONDOMINIUM
GT WS ASSOCIATES, DEVELOPERS
HARTFORD, CONNECTICUT

LONGITUDINAL SECTION

FEBRUARY 15, 1980 DRAWING NO. A-6

RECEIVED BY
Robert A. Sullivan
FEB 22 12 38 PM '80
TOWN OF HARTFORD
101 - PAGE

20

Condo # 20

