



RECEIVED BY  
DEC 24 12 19 PM '00  
PAGE 10

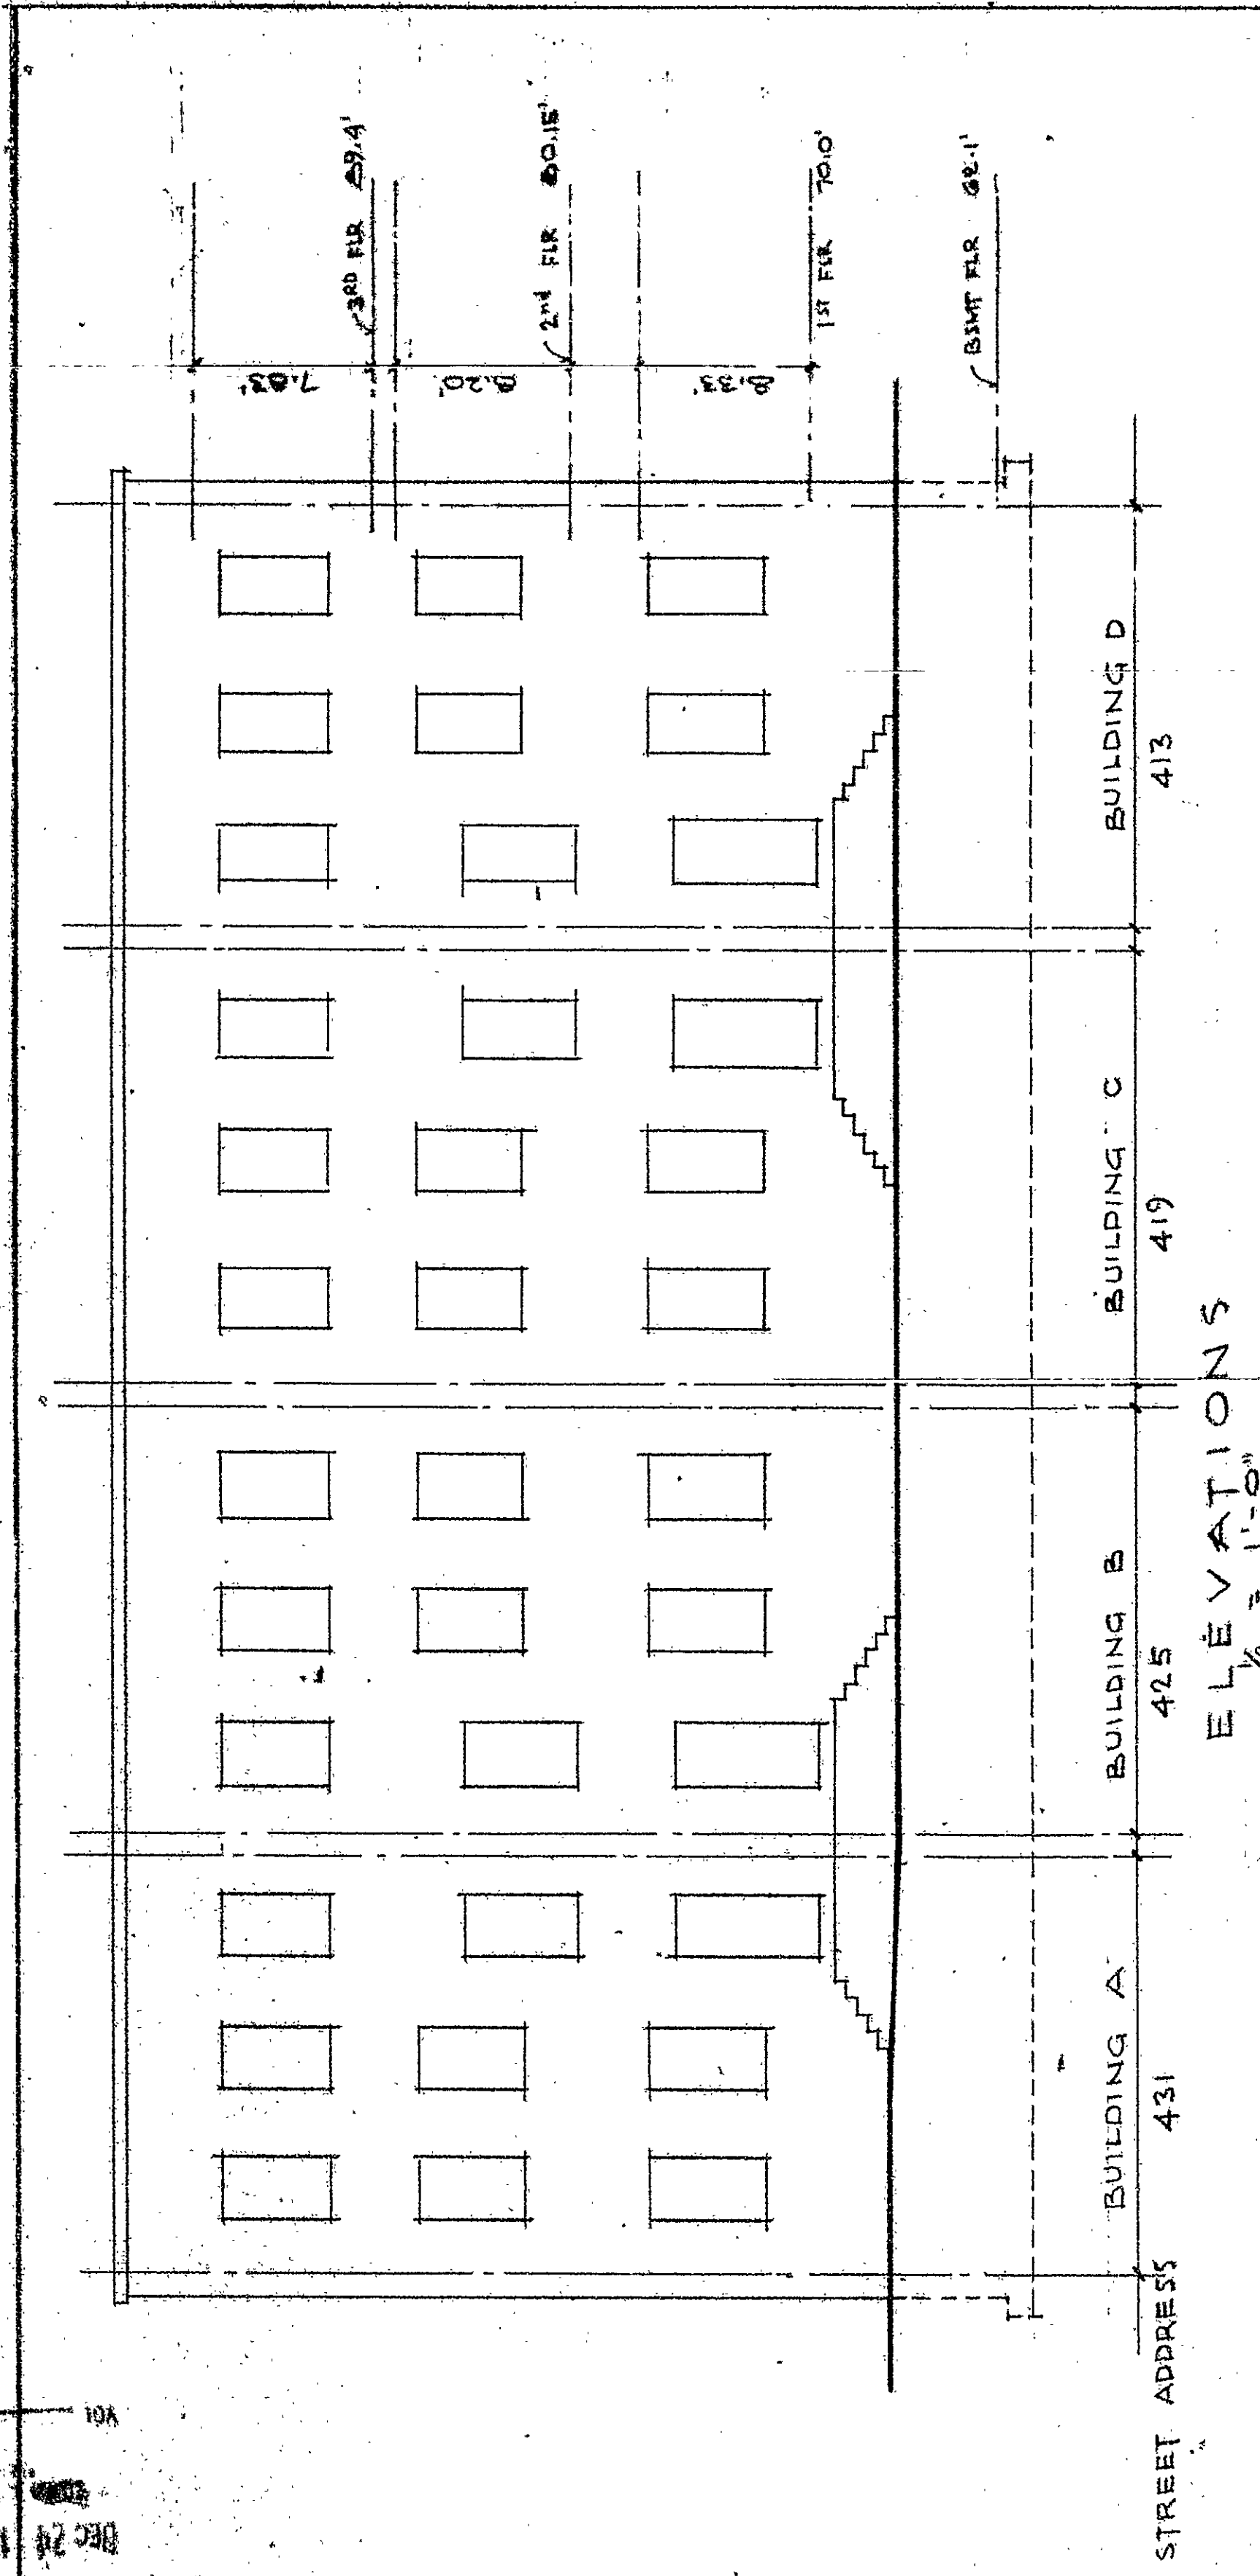

HUDSON STREET CONDOMINIUMS  
413-431 HUDSON STREET  
HARTFORD CT



I HEREBY CERTIFY THAT THIS PLAN REPRESENTS A  
COPY OF PORTIONS OF THE APPROVED PLANS ON FILE  
WITH THE CITY OF HARTFORD BUILDING DEPARTMENT  
AND/OR AS BUILT CONDITIONS AND IS SUBSTANTIALLY CORRECT  
HELEN F. BEHRENS ARCHITECT  
CONNECTICUT REGISTRATION 2749

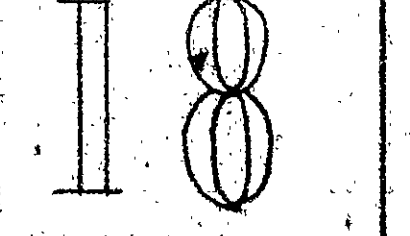

80-065

| BUILDING   | UNIT NO. | ADDRESS       | DESIGN TYPE             | AREA<br>SQUARE FEET | PERCENT OF<br>INTEREST IN<br>LIMITED COMMON<br>AREA | PERCENT OF<br>INTEREST IN<br>COMMON AREA | DRAWING<br>NO. |
|------------|----------|---------------|-------------------------|---------------------|-----------------------------------------------------|------------------------------------------|----------------|
| A          | A-1      | 431 HUDSON ST | 1 BED RM - FIRST FLOOR  | 575.00              | 33.05                                               | 7.49                                     | 2              |
| A          | A-2      | 431 HUDSON ST | 1 BED RM - SECOND FLOOR | 564.00              | 33.10                                               | 7.61                                     | 3              |
| A          | A-3      | 431 HUDSON ST | 1 BED RM - THIRD FLOOR  | 579.00              | 33.32                                               | 7.54                                     | 4              |
| A          |          | 431 HUDSON ST | LIMITED COMMON AREA     |                     |                                                     |                                          | 5              |
| B          | B-1      | 425 HUDSON ST | 1 BED RM - FIRST FLOOR  | 627.00              | 33.02                                               | 8.16                                     | 6              |
| B          | B-2      | 425 HUDSON ST | 1 BED RM - SECOND FLOOR | 636.00              | 33.19                                               | 8.29                                     | 7              |
| B          | B-3      | 425 HUDSON ST | 1 BED RM - THIRD FLOOR  | 636.00              | 33.19                                               | 8.29                                     | 8              |
| B          |          | 425 HUDSON ST | LIMITED COMMON AREA     |                     |                                                     |                                          | 9              |
| C          | C-1      | 419 HUDSON ST | 1 BED RM - FIRST FLOOR  | 654.00              | 33.10                                               | 8.52                                     | 10             |
| C          | C-2      | 419 HUDSON ST | 1 BED RM - SECOND FLOOR | 661.00              | 33.15                                               | 8.61                                     | 11             |
| C          | C-3      | 419 HUDSON ST | 1 BED RM - THIRD FLOOR  | 661.00              | 33.15                                               | 8.61                                     | 12             |
| C          |          | 419 HUDSON ST | LIMITED COMMON AREA     |                     |                                                     |                                          | 13             |
| D          | D-1      | 413 HUDSON ST | 2 BED RM - FIRST FLOOR  | 679.00              | 32.92                                               | 8.84                                     | 14             |
| D          | D-2      | 413 HUDSON ST | 2 BED RM - SECOND FLOOR | 692.00              | 33.54                                               | 9.02                                     | 15             |
| D          | D-3      | 413 HUDSON ST | 2 BED RM - THIRD FLOOR  | 692.00              | 33.54                                               | 9.02                                     | 16             |
| D          |          | 413 HUDSON ST | LIMITED COMMON AREA     |                     |                                                     |                                          | 17             |
| ELEVATIONS |          |               |                         |                     |                                                     |                                          | 18             |

I HEREBY CERTIFY THAT THIS PLAN REPRESENTS A COPY  
OF PORTIONS OF THE APPROVED PLANS ON FILE WITH  
THE CITY OF HARTFORD BUILDING DEPARTMENT AND/OR  
AS BUILT CONDITIONS AND IS SUBSTANTIALLY CORRECT  
HELEN F. BEHRENS ARCHITECT  
CONNECTICUT REGISTRATION 2749

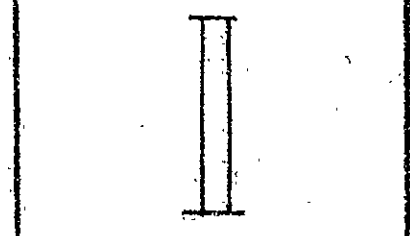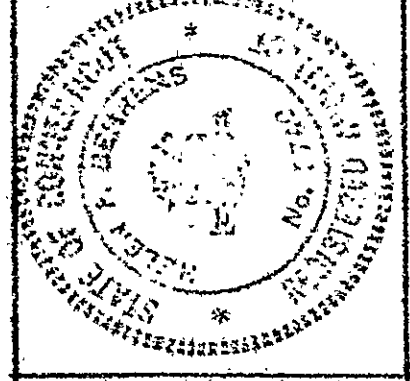

80-065

HUDSON STREET CONDOMINIUMS  
413-431 HUDSON STREET  
HARTFORD CT

Condo Floor Plan # 37