


37

37-2


RECEIVED BY
DATE 24 12 20 00
TOWN & CITY CLERK
PAGE 3

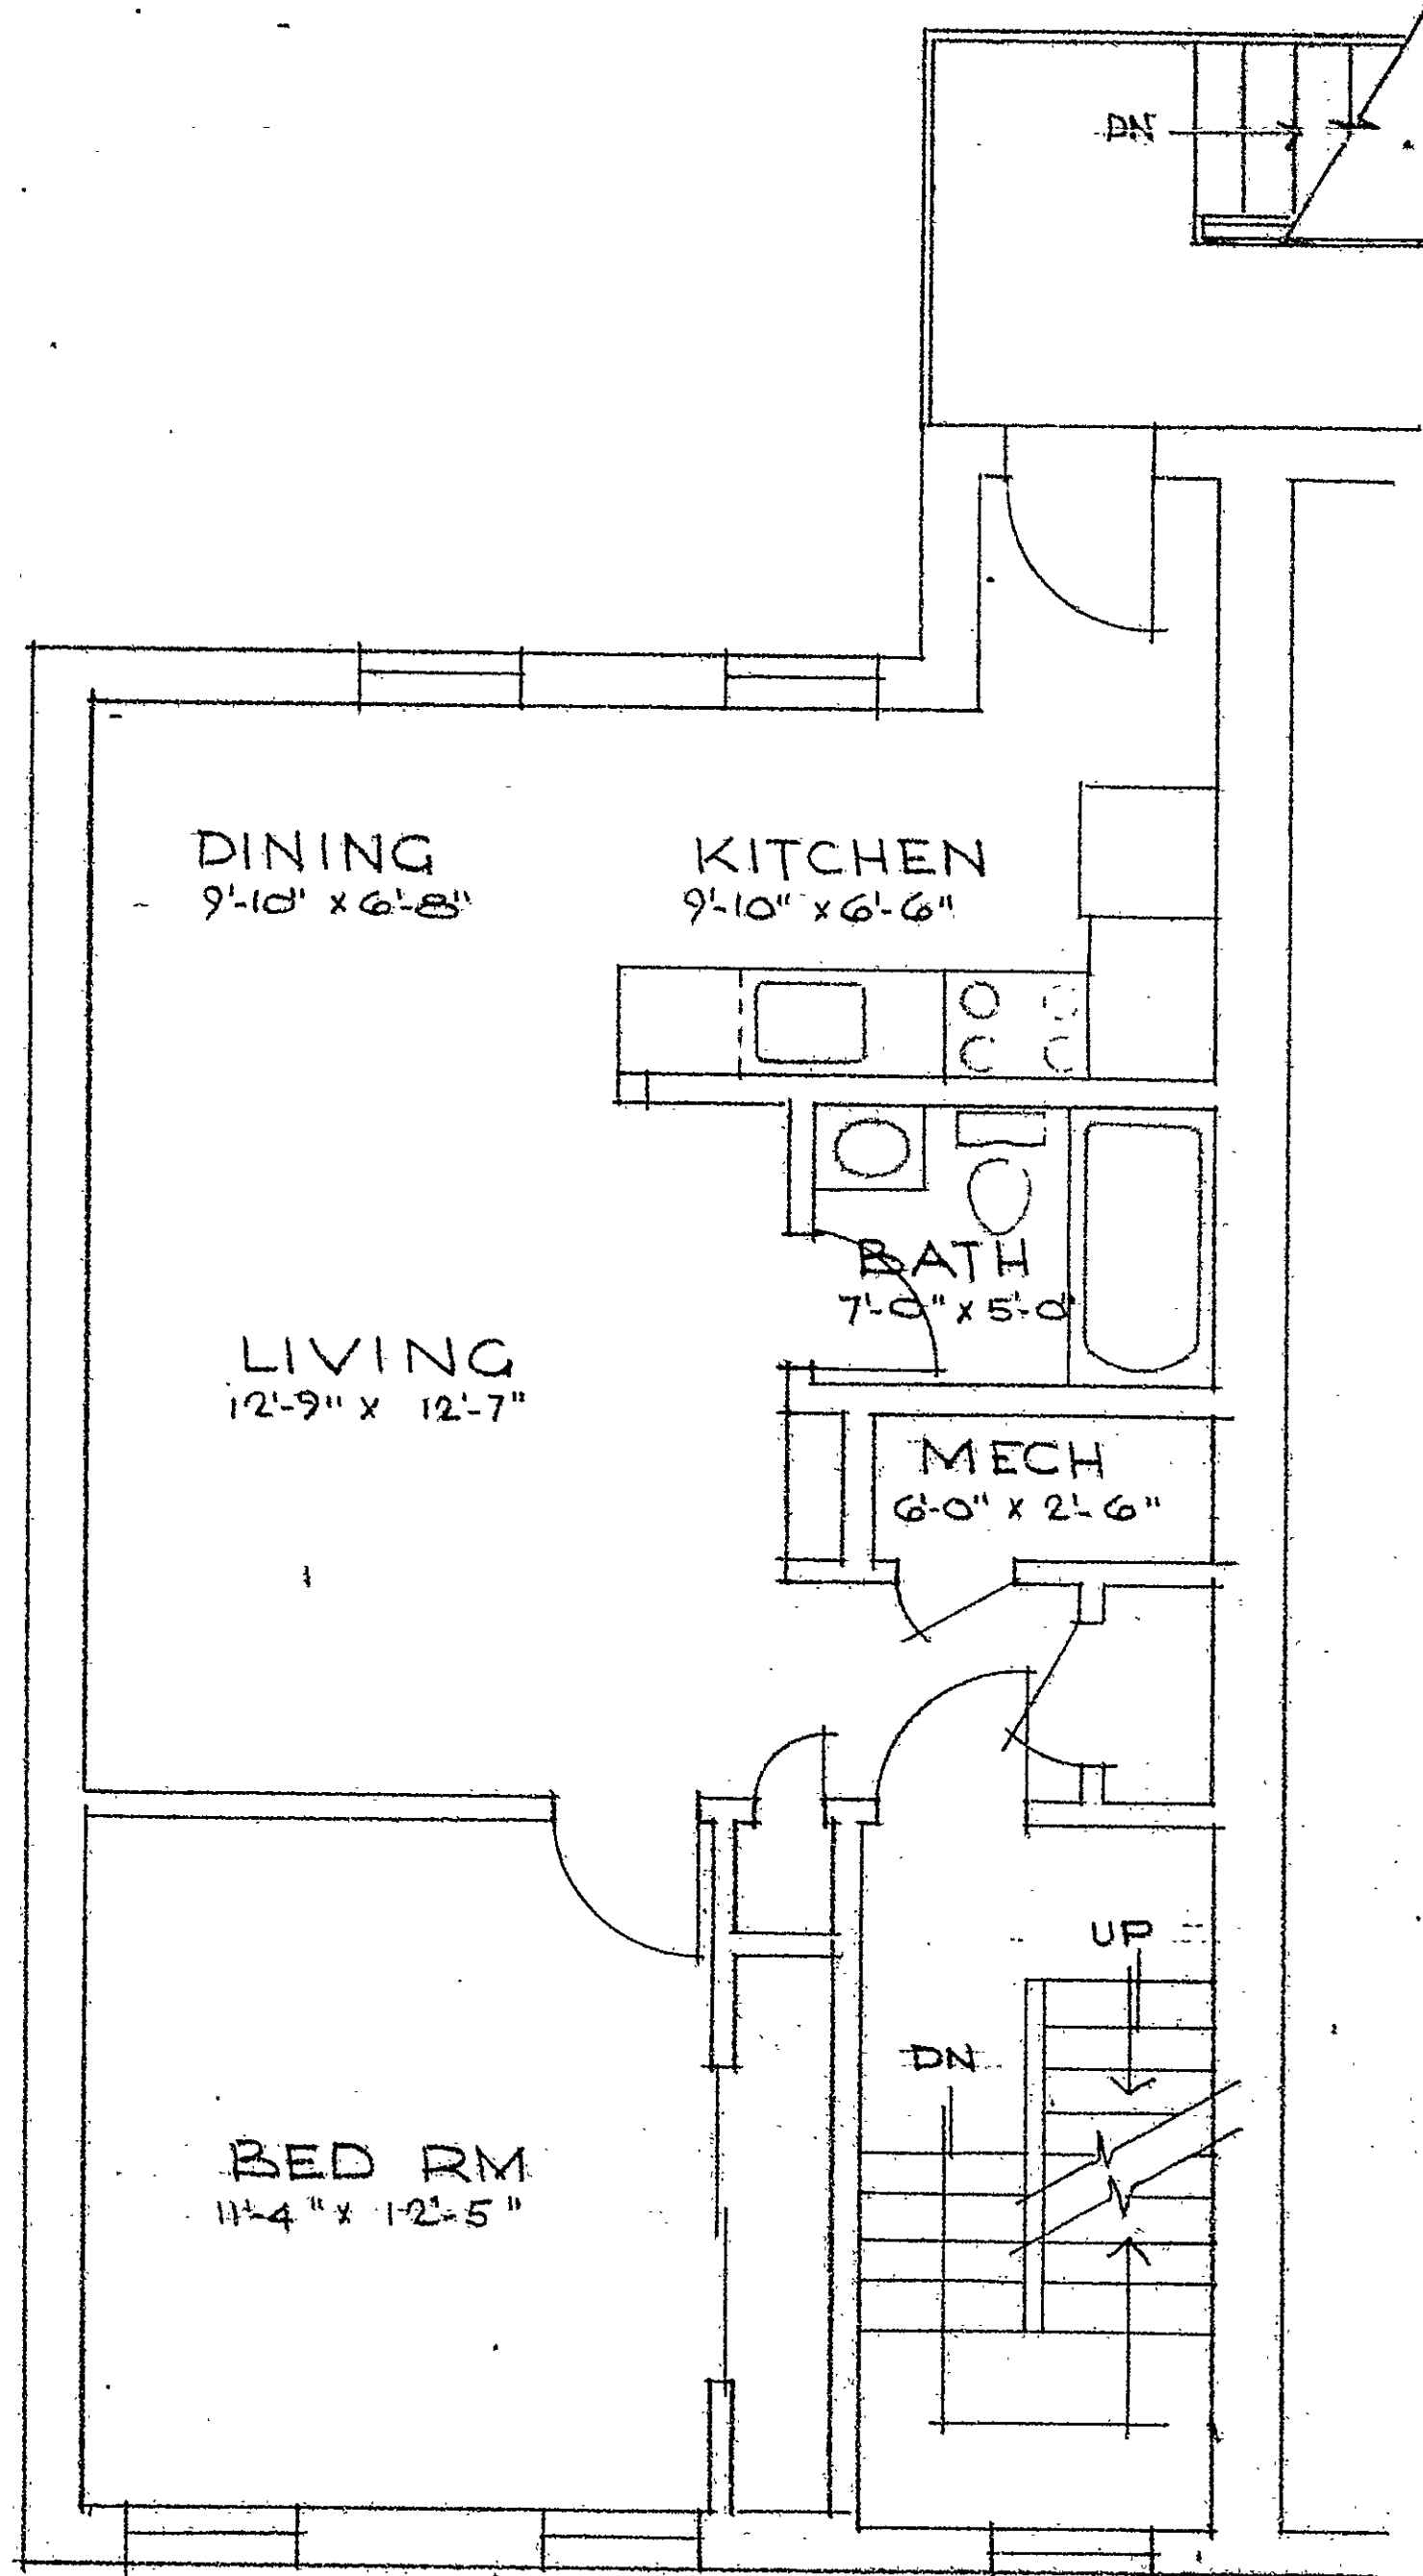

UNIT A-2
1/4" = 1'-0"


HUDSON STREET CONDOMINIUMS
413 - 431 HUDSON STREET
HARTFORD CT

I HEREBY CERTIFY THAT THIS PLAN REPRESENTS A COPY OF PORTIONS OF THE APPROVED PLANS ON FILE WITH THE CITY OF HARTFORD BUILDING DEPARTMENT AND/OR AS BUILT CONDITIONS AND IS SUBSTANTIALLY CORRECT.
Helen F. Behrens, Architect
April 15, 1990
CONNECTICUT REGISTRATION 2749

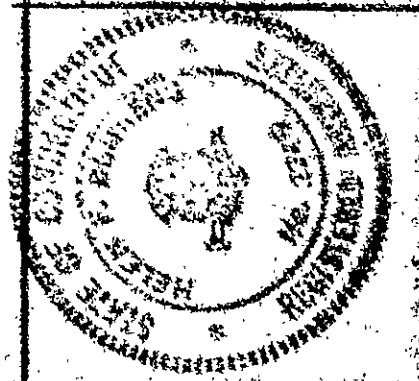

3


80-065

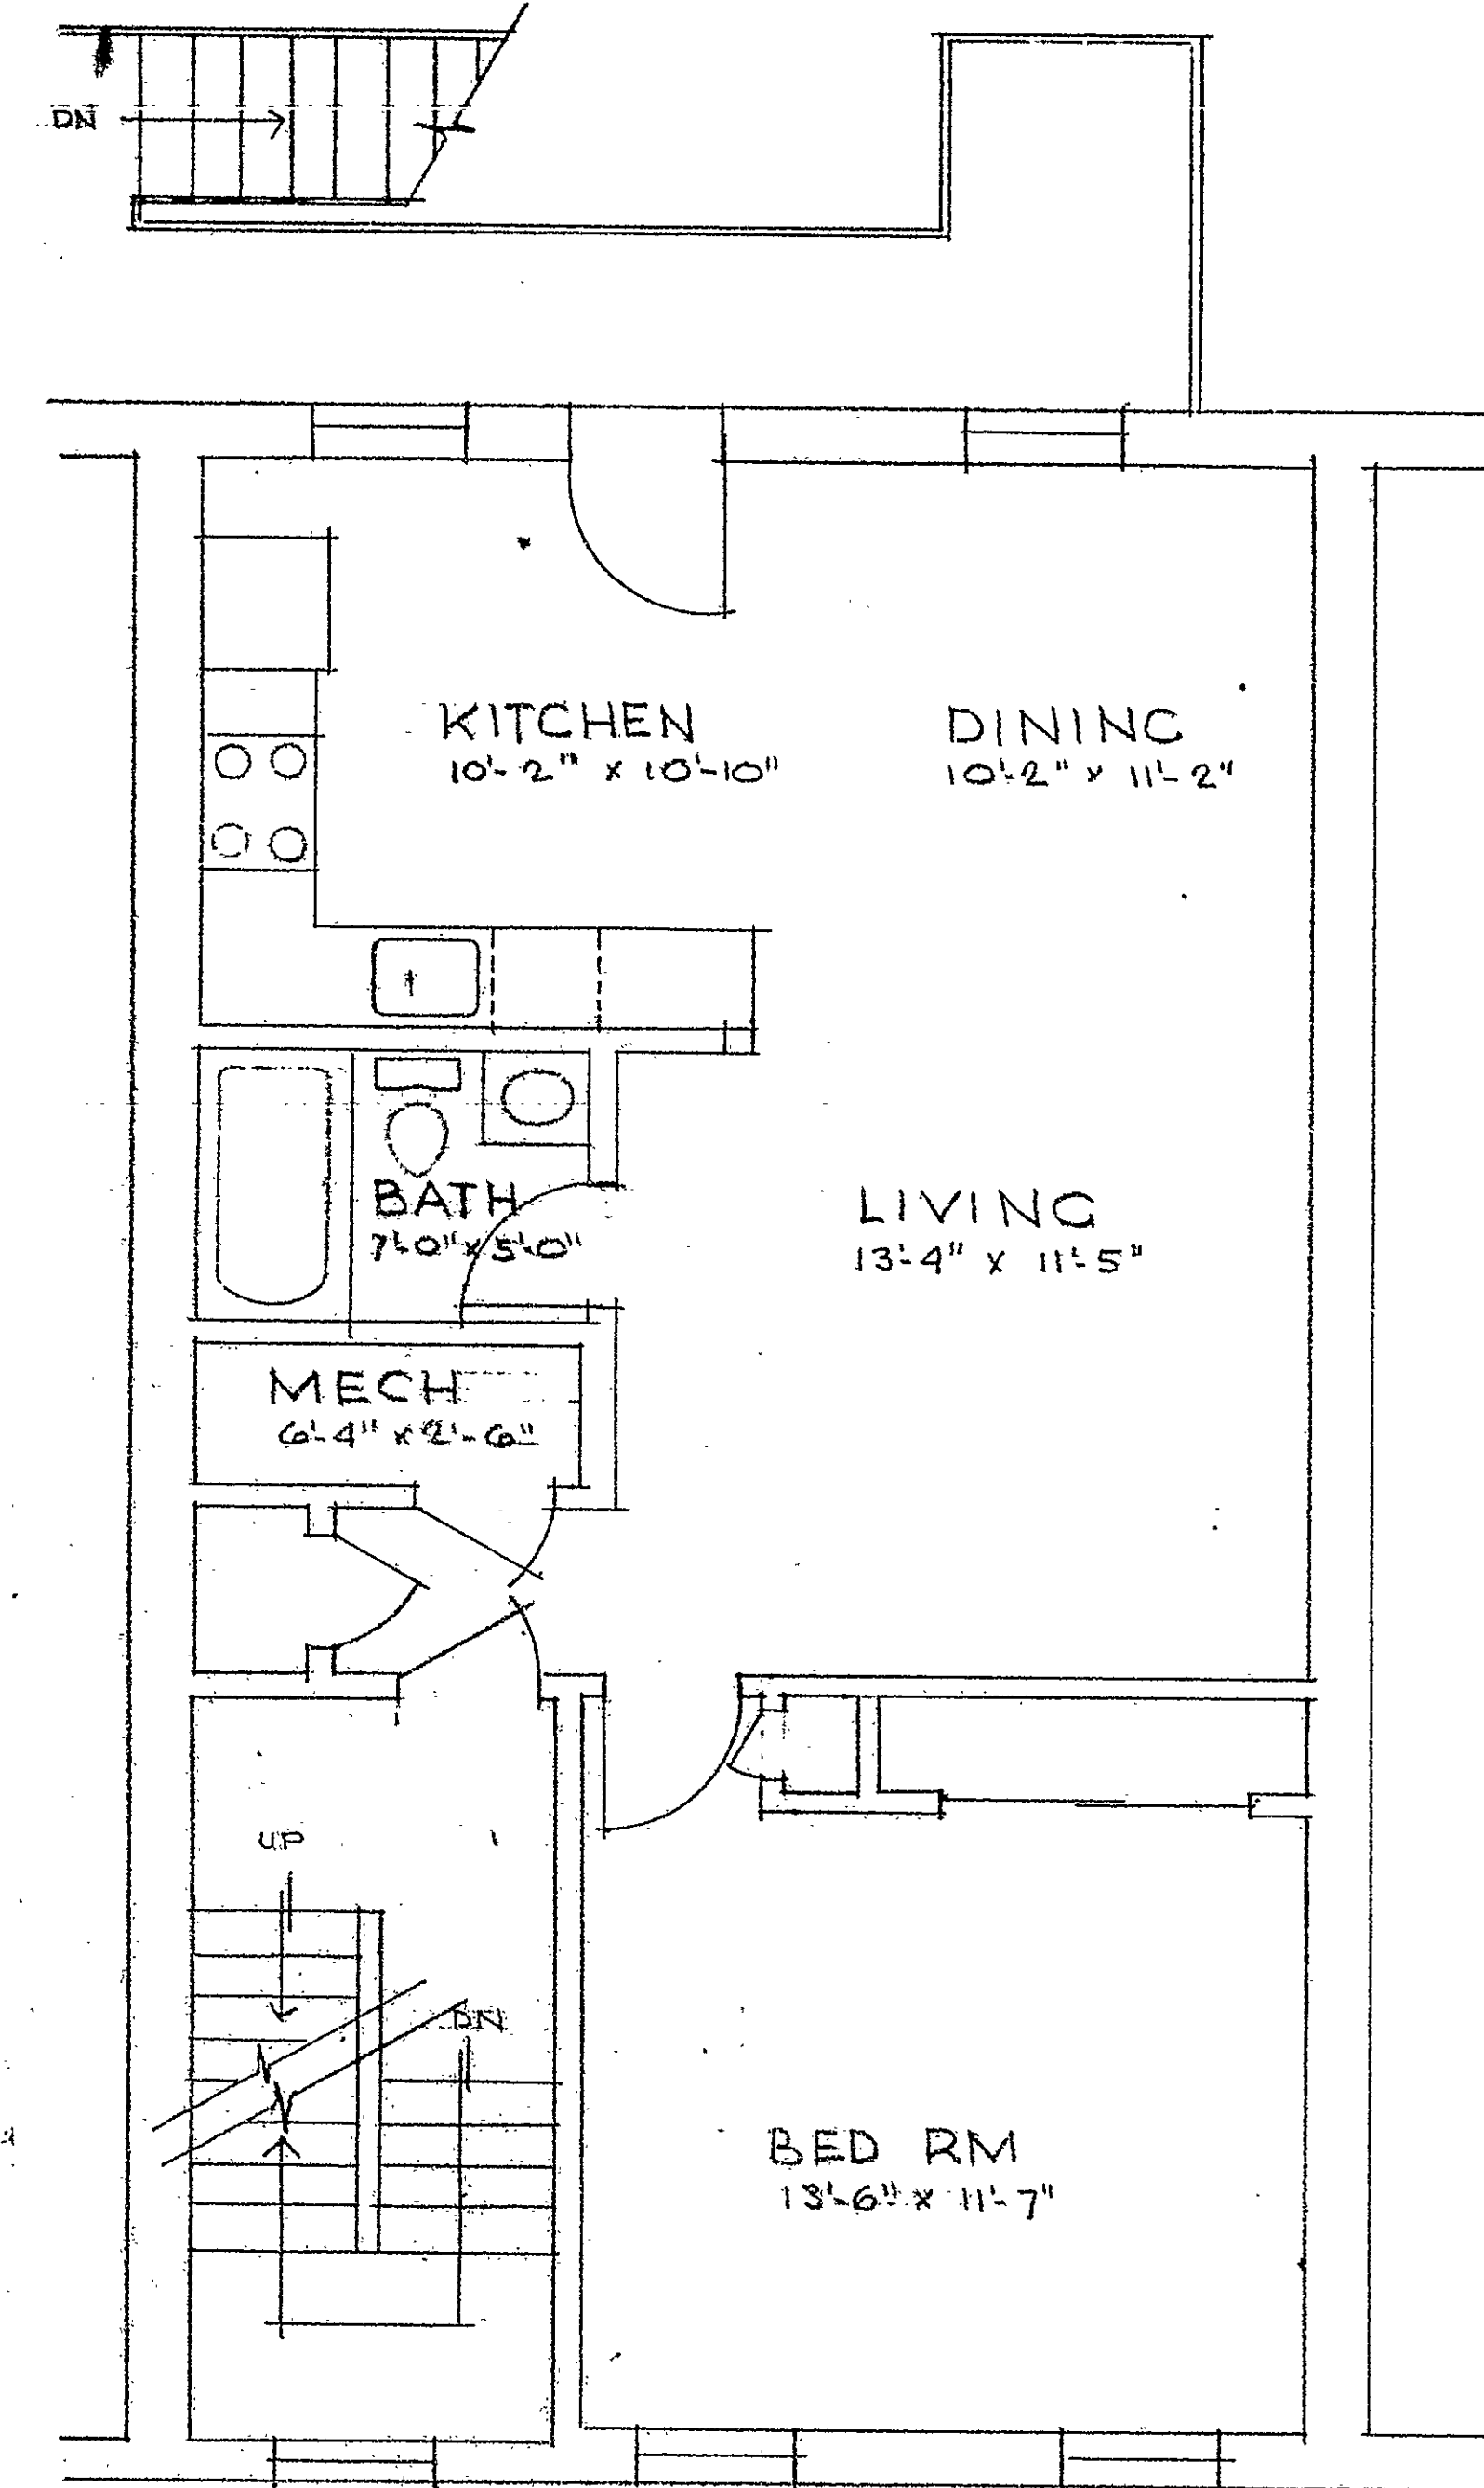

UNIT B-2
1/4" = 1'-0"

HUDSON STREET CONDOMINIUMS
413 - 431 HUDSON STREET
HARTFORD CT

I HEREBY CERTIFY THAT THIS PLAN REPRESENTS A COPY OF PORTIONS OF THE APPROVED PLANS ON FILE WITH THE CITY OF HARTFORD BUILDING DEPARTMENT AND/OR AS BUILT CONDITIONS AND IS SUBSTANTIALLY CORRECT.
Helen F. Behrens, Architect
April 15, 1990
CONNECTICUT REGISTRATION 2749

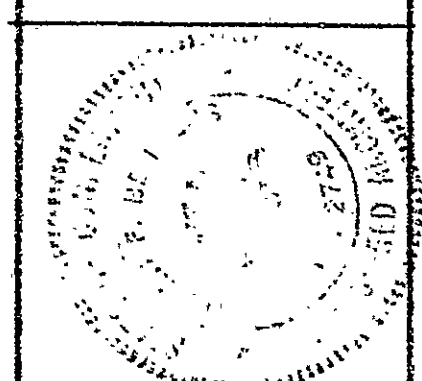

7

80-065

Condo Plan A-2 7-37

