



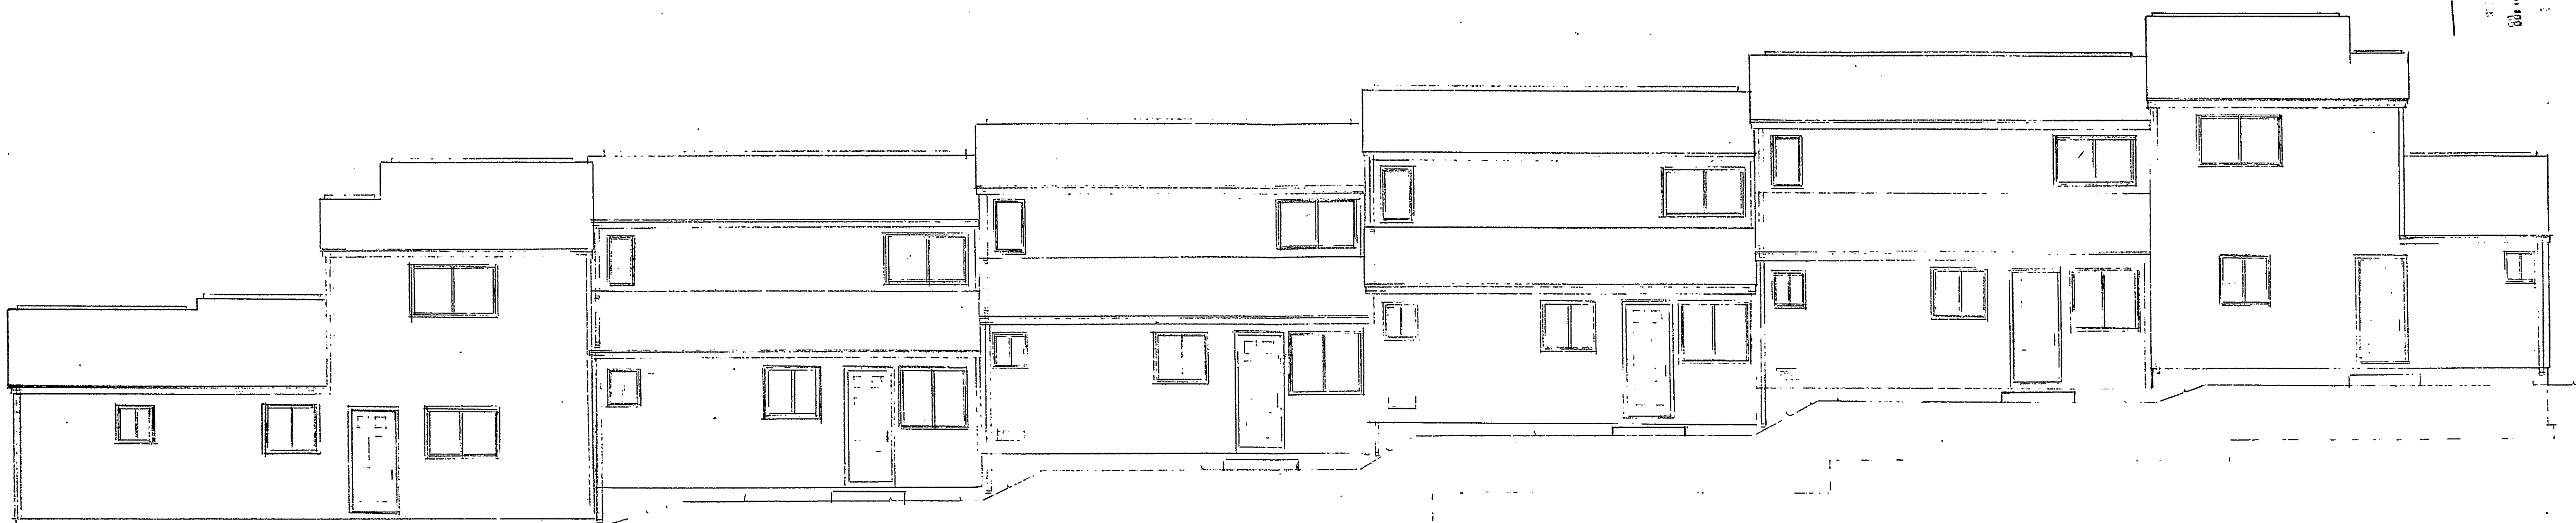

• REAR ELEVATION •

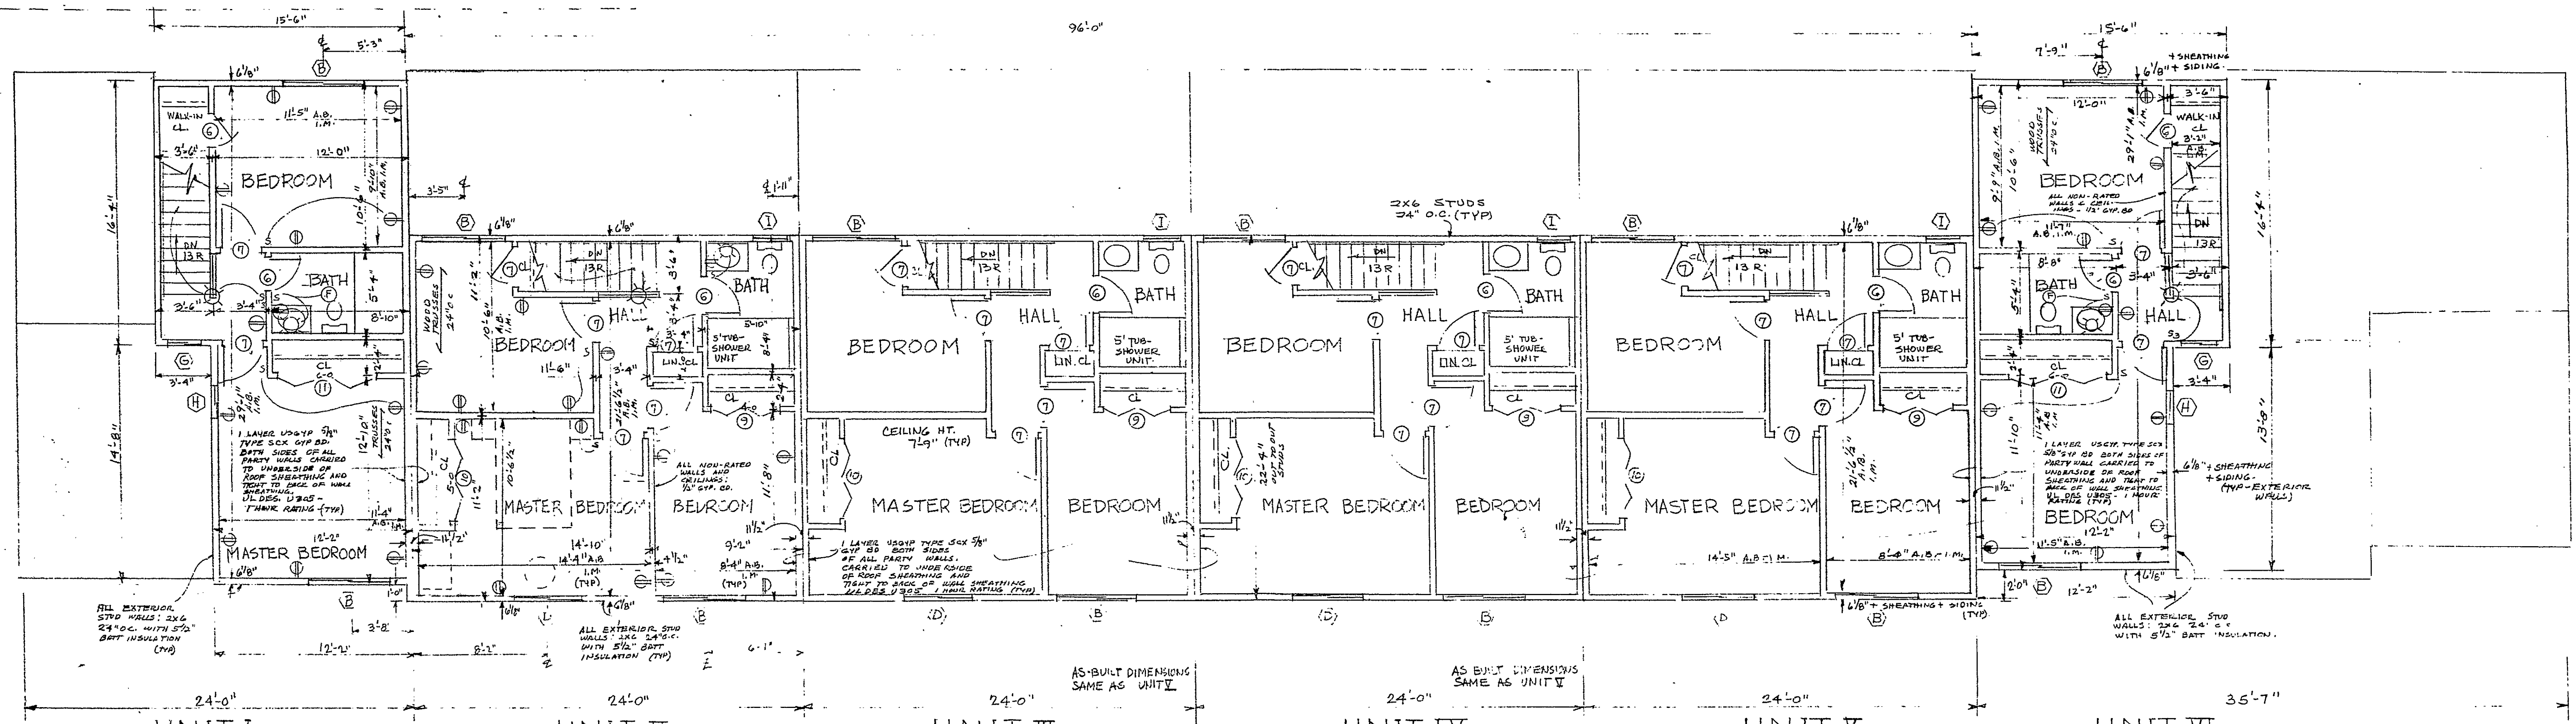

UNIT I 2ND FLOOR EL. 108.5' UNIT II 2ND FLOOR EL. 107.5' UNIT III 2ND FLOOR EL. 106.5' UNIT IV 2ND FLOOR EL. 105.5' UNIT V 2ND FLOOR EL. 104.5' UNIT VI 2ND FLOOR EL. 102.5'

• SECOND FLOOR PLANS •
SCALE: 1/4" = 1'-0"

I hereby certify that the above Plans contain all of the information required by the Sub-section 29(d) of the Common Interest Ownership Act, Connecticut General Statutes Section 47-229 (d), as amended.

LEGEND:
A.B. - AS BUILT
I.M. - INSIDE MEASUREMENT

UNDERSIGNED ARCHITECT CERTIFIES THAT THESE PLANS ARE AN ACCURATE COPY OF PORTIONS OF PLANS FILED WITH THE BUILDING OFFICIAL APPOINTED PURSUANT TO SEC 20-266.

DUTIL REALTY CORPORATION	
11/16/87	REV 2/2/87
GRAFTON STREET CONDOMINIUMS	
1/4" = 1'	DRG. NO. 209-B

72

Condo Floor Plan #92

