




• FRONT ELEVATION •

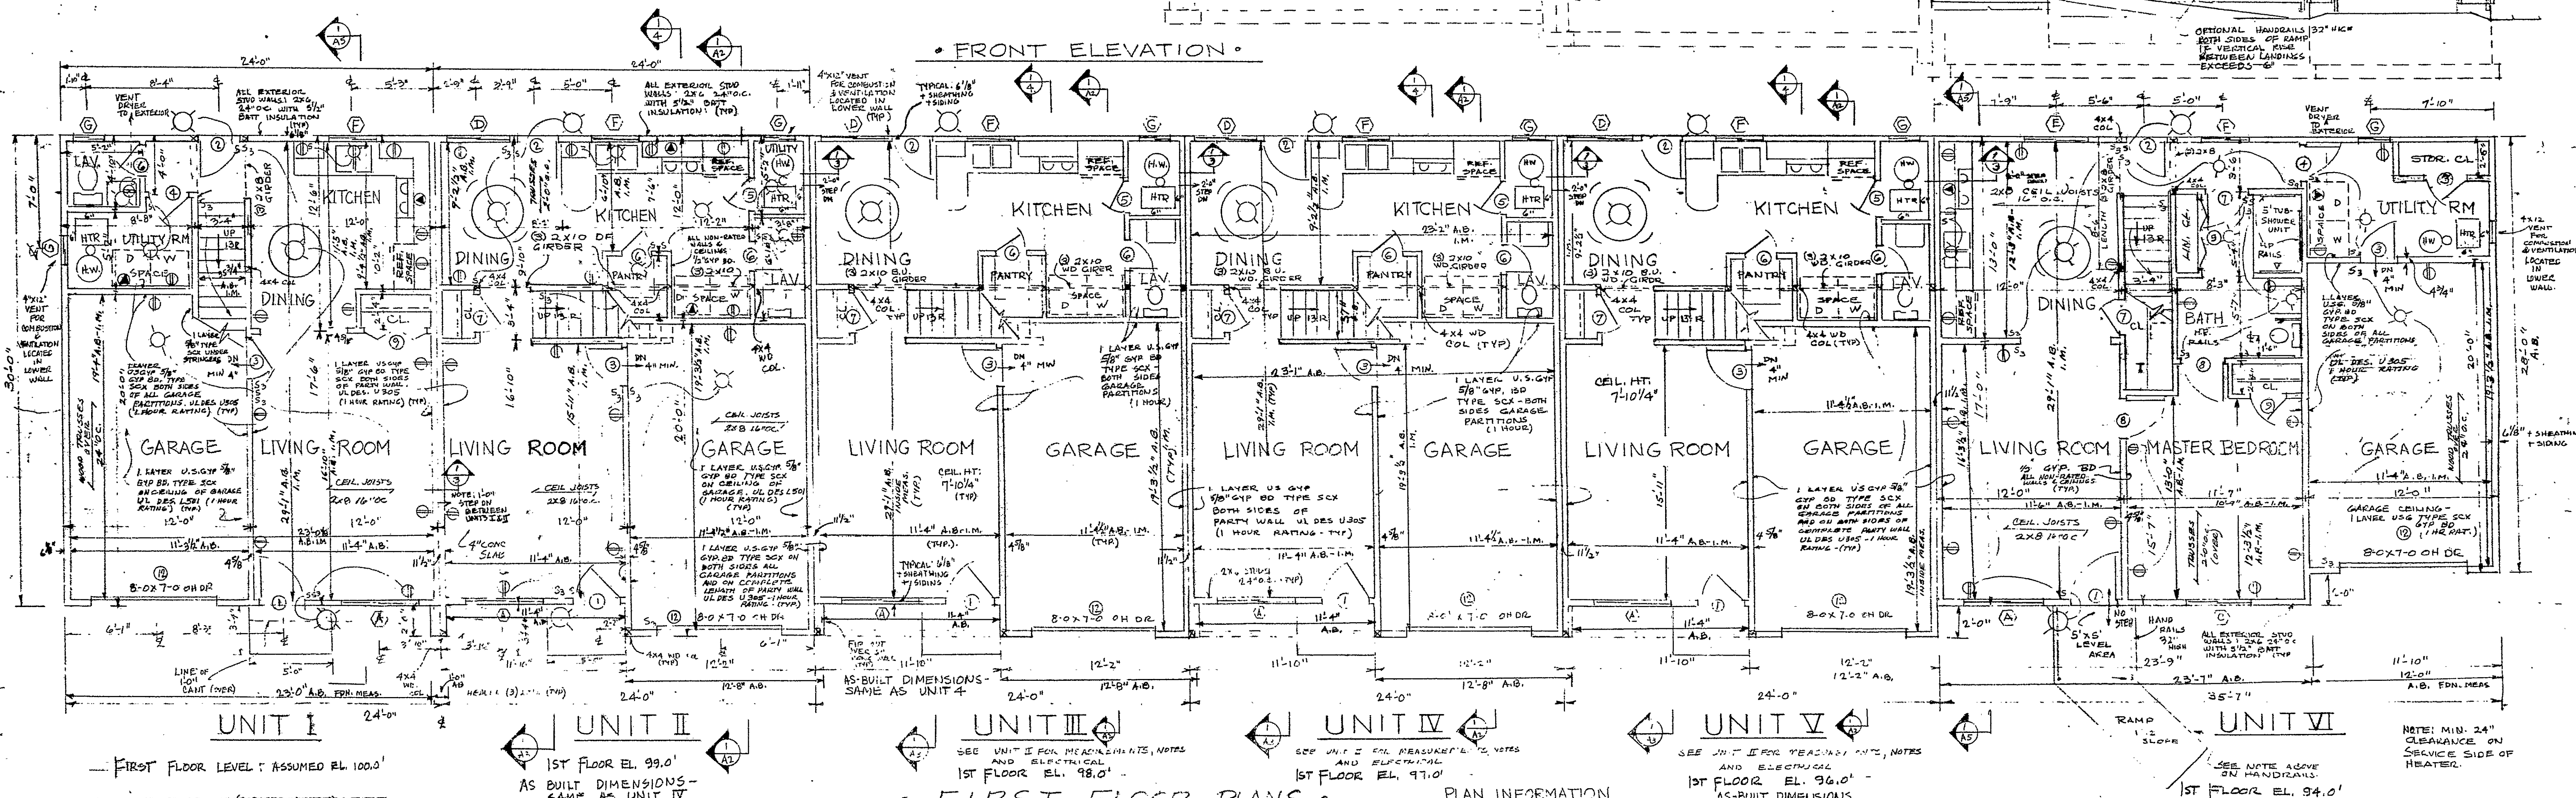

— FIRST FLOOR LEVEL: ASSUMED EL. 100.0' —
 CROSS FLOOR AREA: (GARAGES INCLUDED)
 UNIT I 1,180 SQ. FT.
 UNIT II 1,280 SQ. FT.
 UNIT III 1,280 SQ. FT.
 UNIT IV 1,280 SQ. FT.
 UNIT V 1,280 SQ. FT.
 UNIT VI 1,464 SQ. FT.

Thereby certify that the above Plans contain all of the information required by the Sub-section 29 (a) of the Common Interest Ownership Act, Connecticut General Statutes Section 47-228 (a), as amended.

• FIRST FLOOR PLANS •

SCALE: 1/4" = 1'-0"

PLAN INFORMATION
 USE GROUP R-3 RESIDENTIAL
 TYPE CONSTRUCTION: 4-B

LEGEND:
 - AS BUILT
 - INSIDE MEASUREMENT

UNDERSIGNED ARCHITECT
 CERTIFIES THAT THESE PLANS
 ARE AN ACCURATE COPY OF
 PORTIONS OF PLANS FILED
 WITH THE BUILDING OFFICIAL
 PURSUANT TO
 SEC. 29-240.

DUTIL REALTY CORPORATION	
11/16/07	REV 2/1/07
GRAFTON STREET CONDOMINIUMS	
1/4" = 1'-0"	DRG No. 1003

D-7

Condo Home Plan # 92

