


The Hartford Hospital

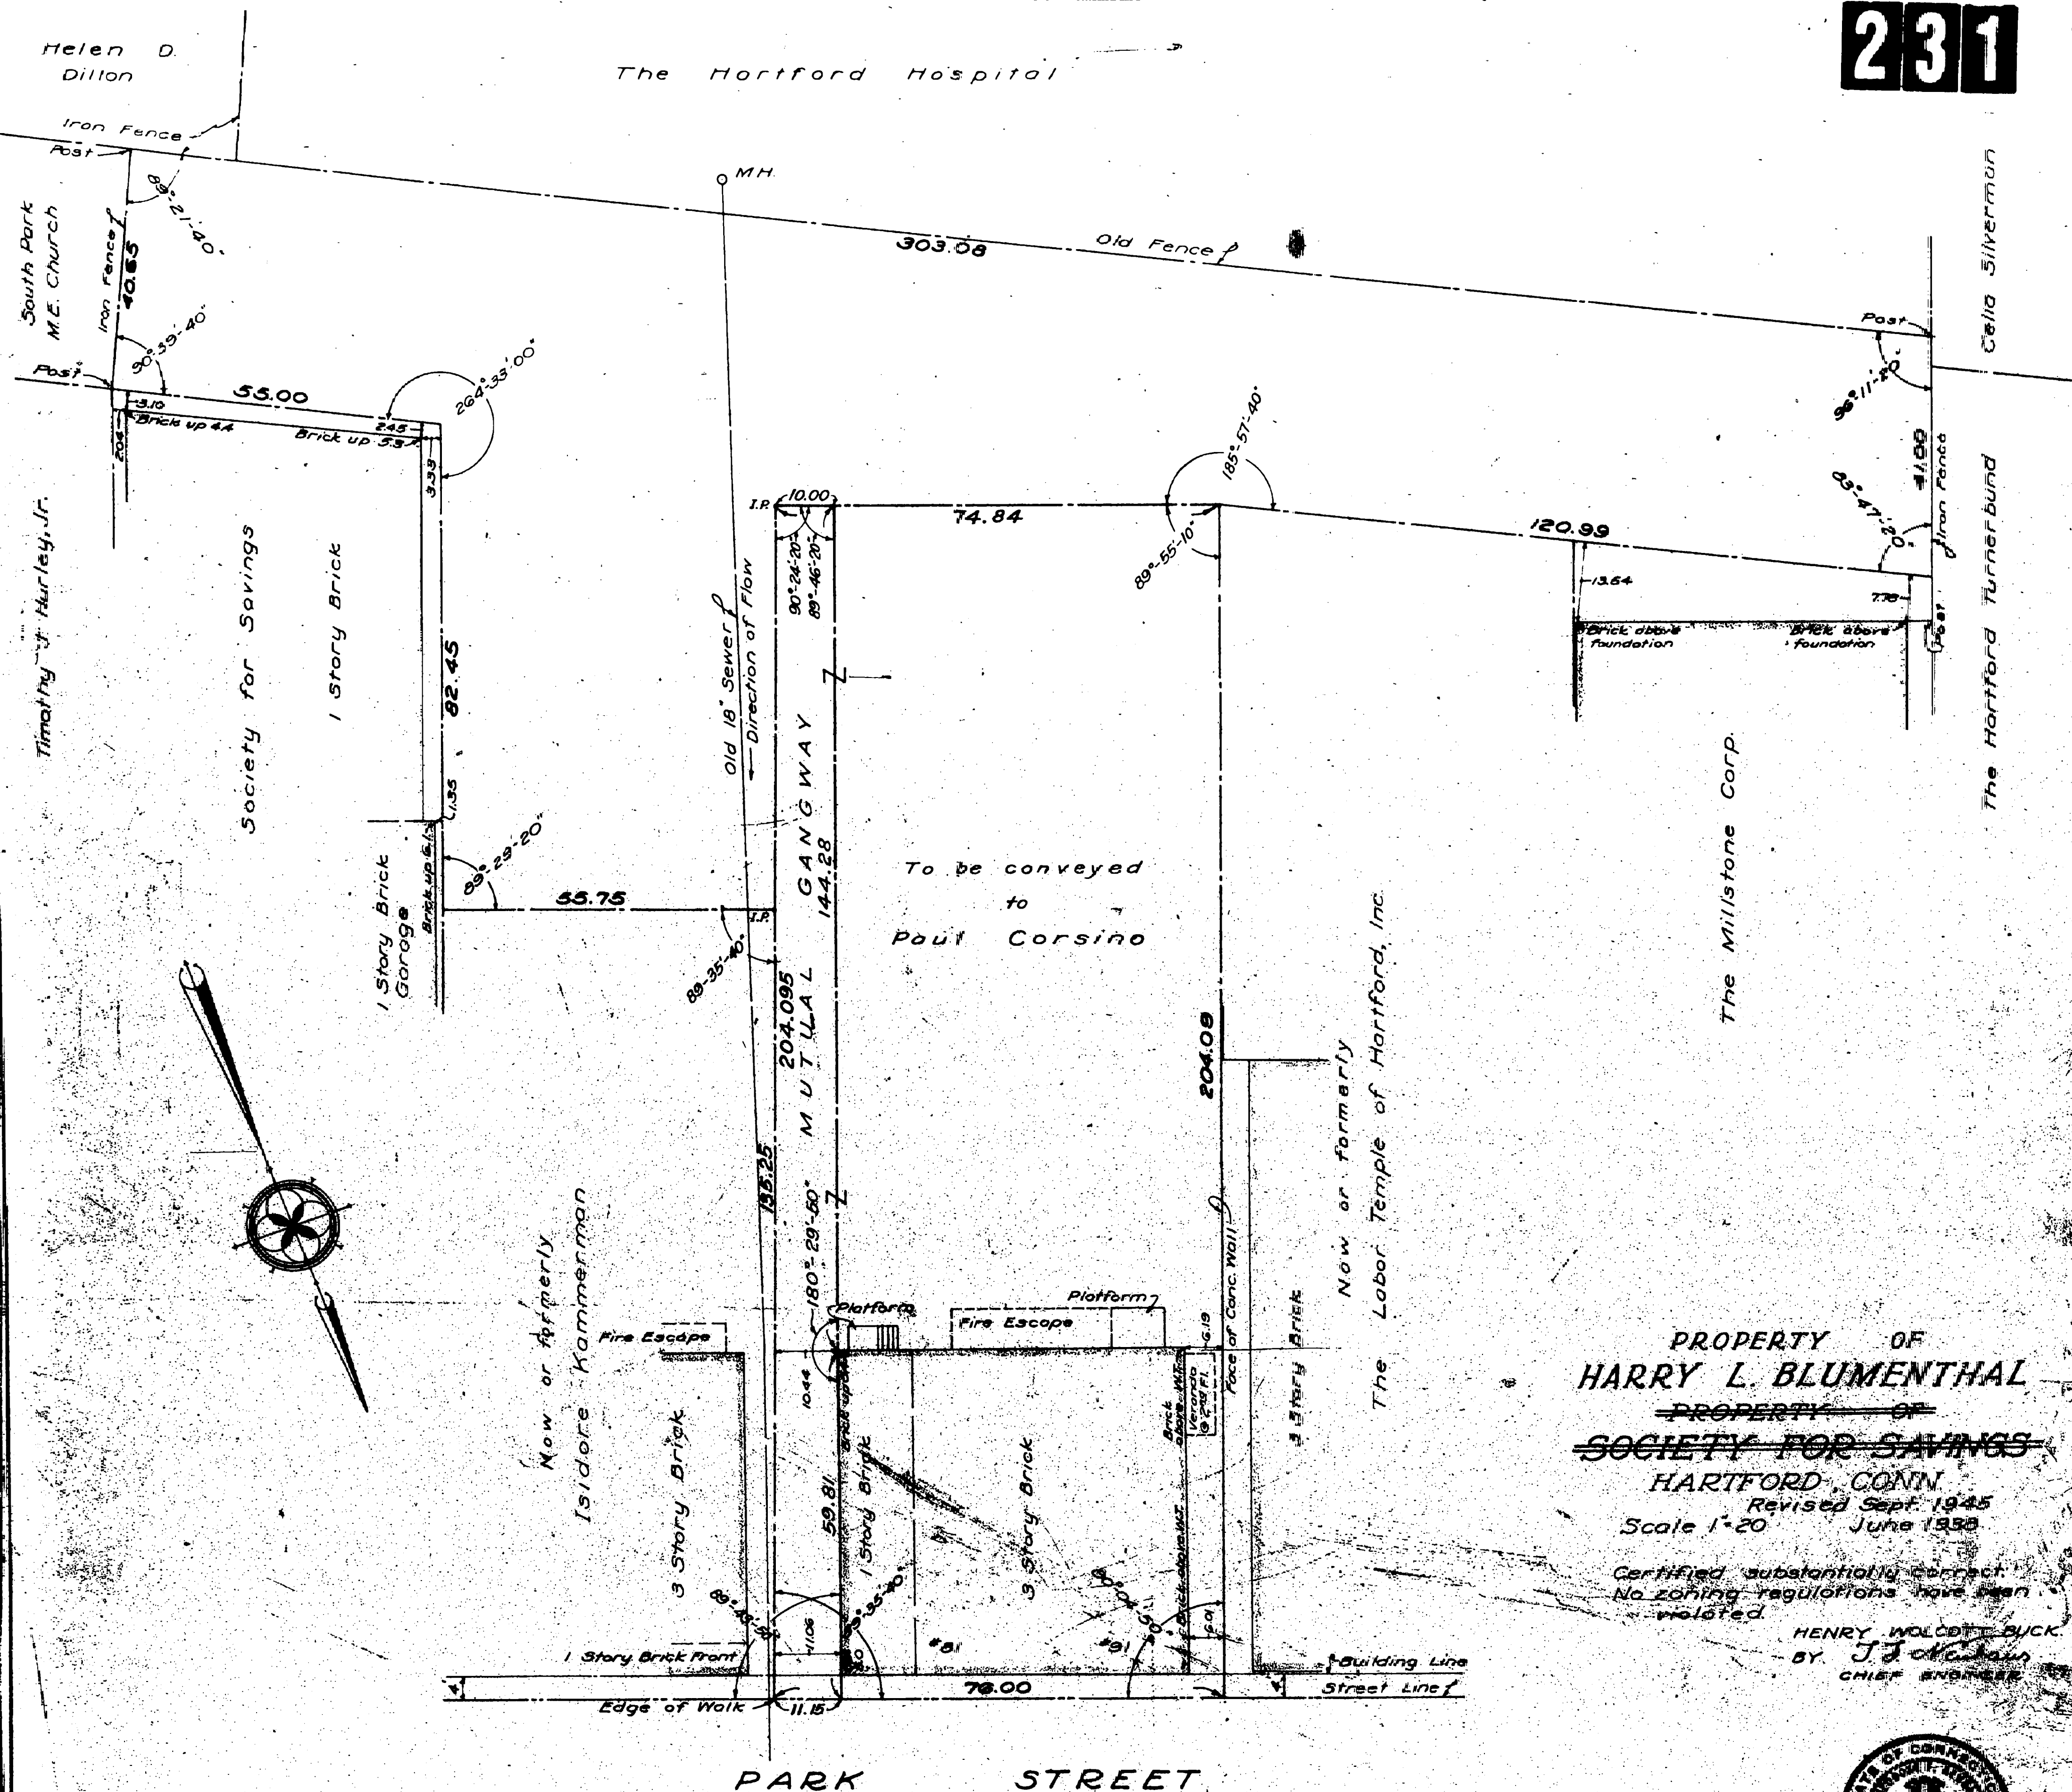

PROPERTY OF
HARRY L. BLUMENTHAL
~~PROPERTY OF~~
~~SOCIETY FOR SAVINGS~~
HARTFORD, CONN.
Revised Sept. 1945
Scale 1"-20' June 1938

Certified substantially correct.
No zoning regulations have been violated.

HENRY WOLCOTT BUCK
BY J. J. McInnis
CHIEF ENGINEER



HENRY WOLCOTT BUCK
CIVIL ENGINEER
HARTFORD, CONN.

Sept., 1945 Revision to show mutual
gangway and property to be conveyed
to Paul Corsino

Certified Substantially Correct

J. H. Williams
Civil Engineer

Comm. No 498

SHEET NO. 1 ~ COMM. NO. 4708-8