

427-1

RECEIVED
HARTFORD, CONN.

DEC 11 3 56 PM '57

WILLIAM A. LINNANE
TOWN & CITY CLERK

SKETCH SHOWING LOCATION OF SEWER HOUSE
CONNECTION AS CONSTRUCTED FOR COMMON USE
OF HOUSES #75 DART STREET, LOT 87, AND #79
DART STREET, LOT 86 AND 214 CHANDLER STREET,
LOT 85. LOCATIONS OF PIPE ARE AS DESCRIBED AND
RECORDED BY METROPOLITAN DISTRICT INSPECTORS
APRIL 8, 1957 TO APRIL 15, 1957.


The portions of Dart St.
and Chandler St. shown on
this plan are established
public streets of the City
of Hartford.

Dec. 16, 1957

Winifred M. Dillman
CITY ENGINEER

DART STREET

sanitary sewer

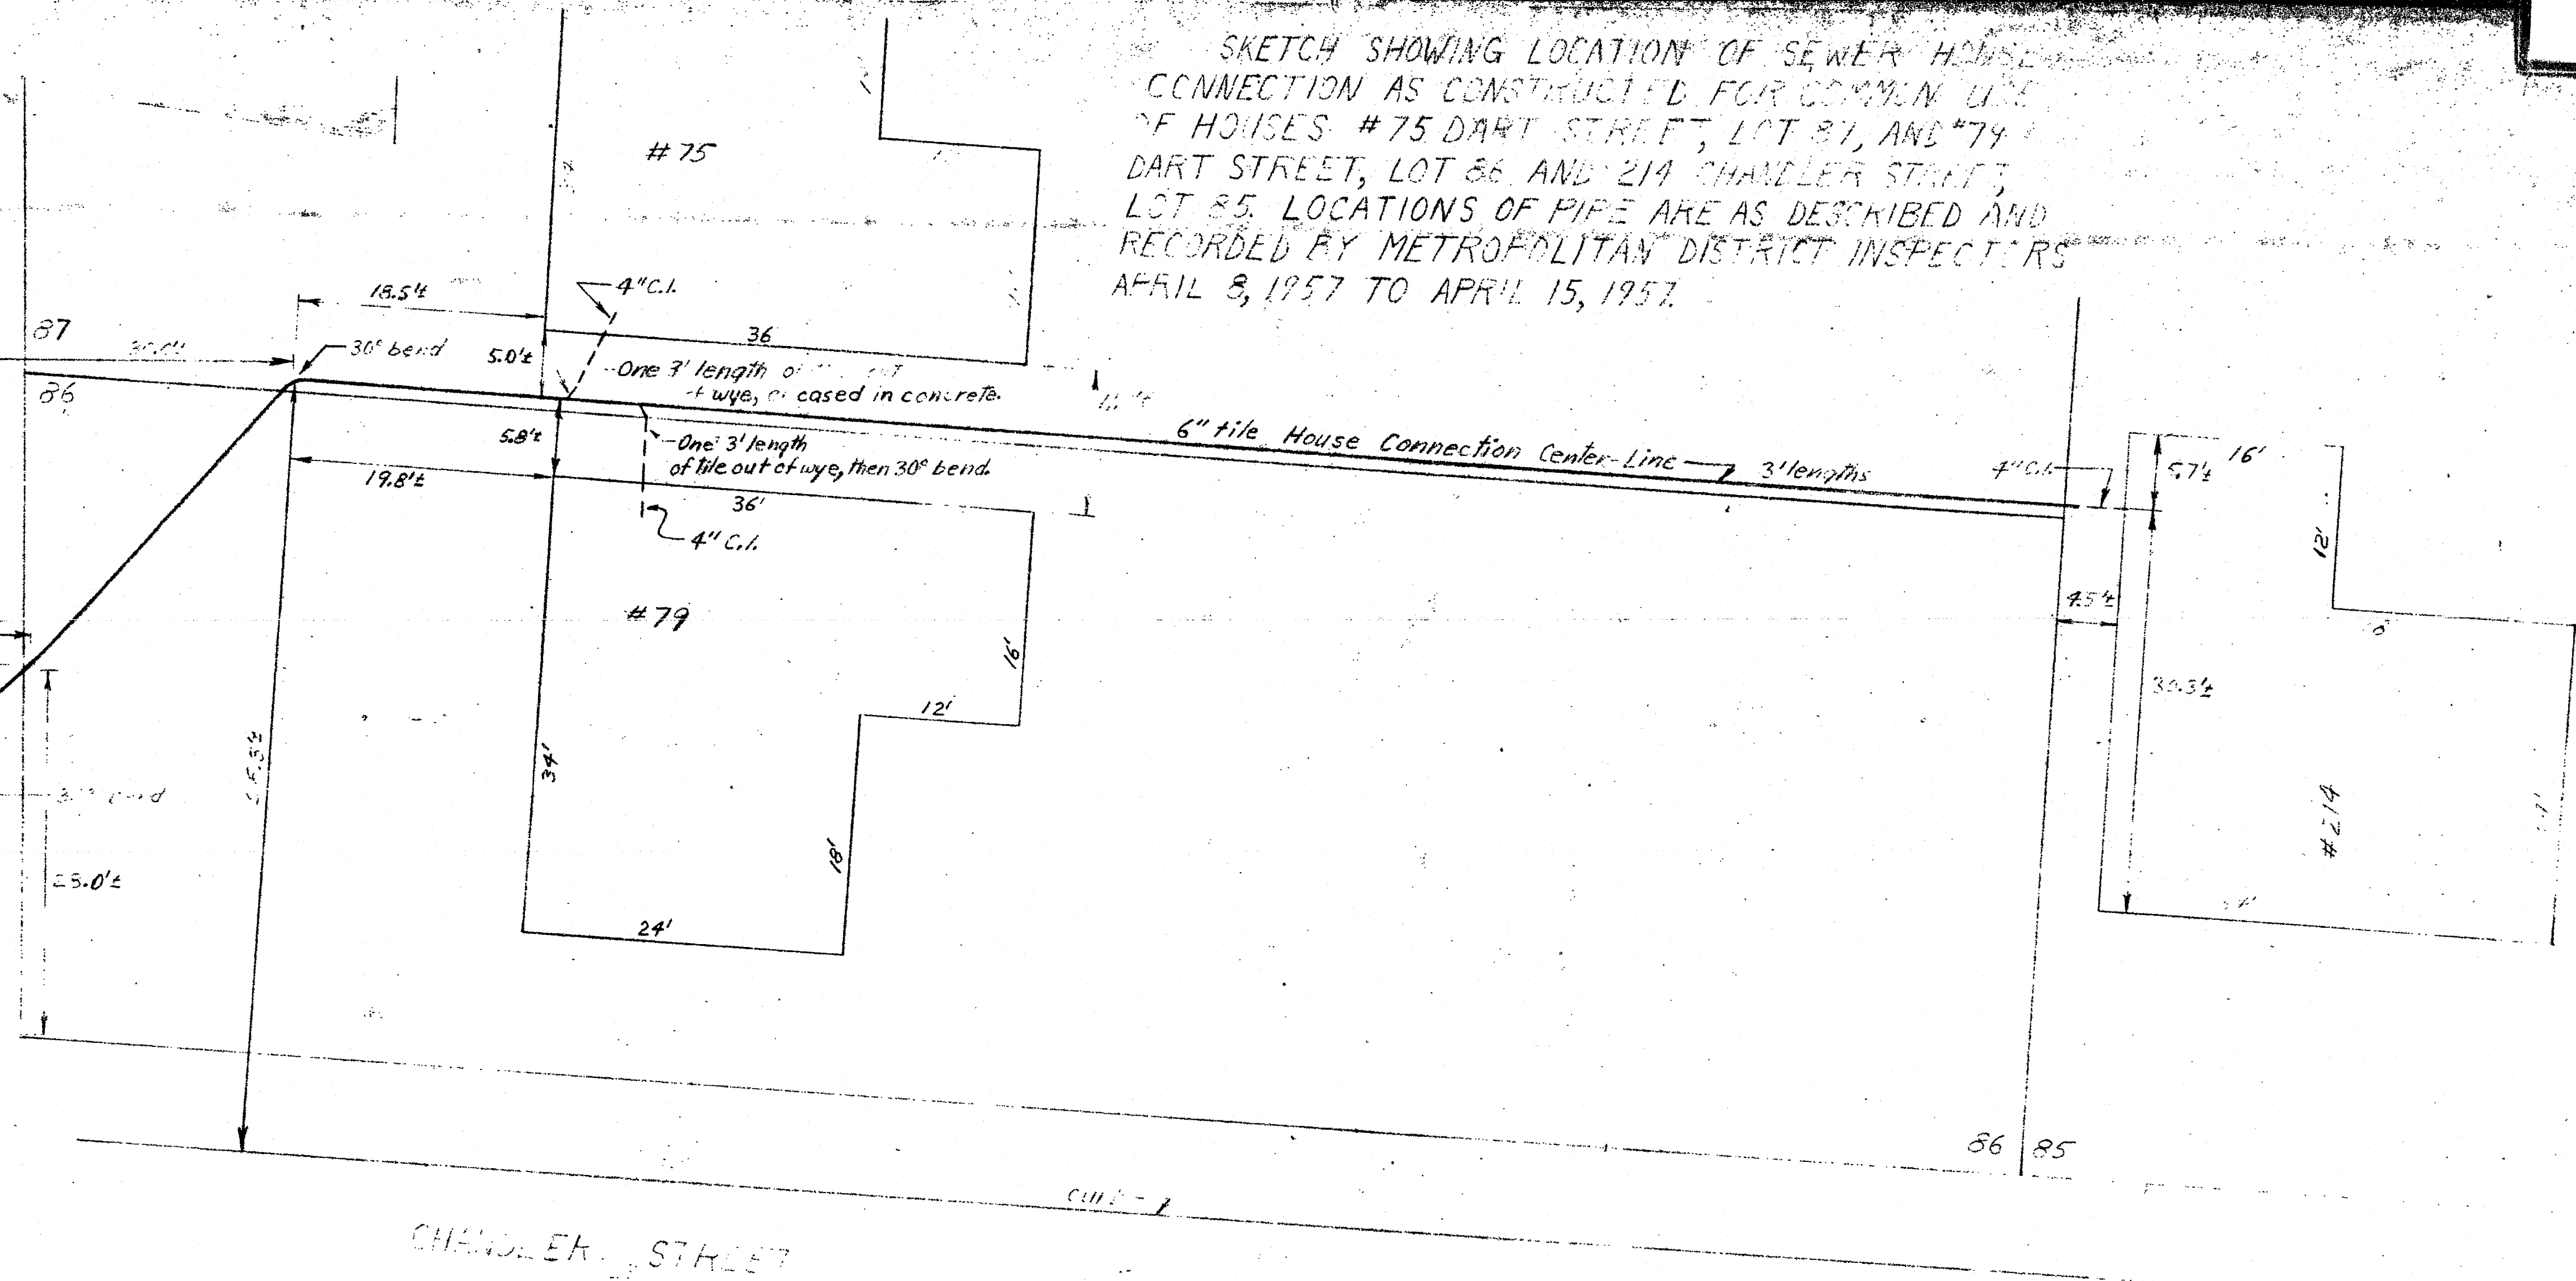

CHANDLER STREET

Drawn by W.H.D. 12/11/57
SCALE: 1" = 10'

