


The portion of Brainard Rd shown on this plan is as established public street of the City of Hartford.
August 20, 1971

RECEIVED
HARTFORD, CONN.
19 4 23 PM '71
ROBERT J. GALLIVAN
TOWN & CITY CLERK

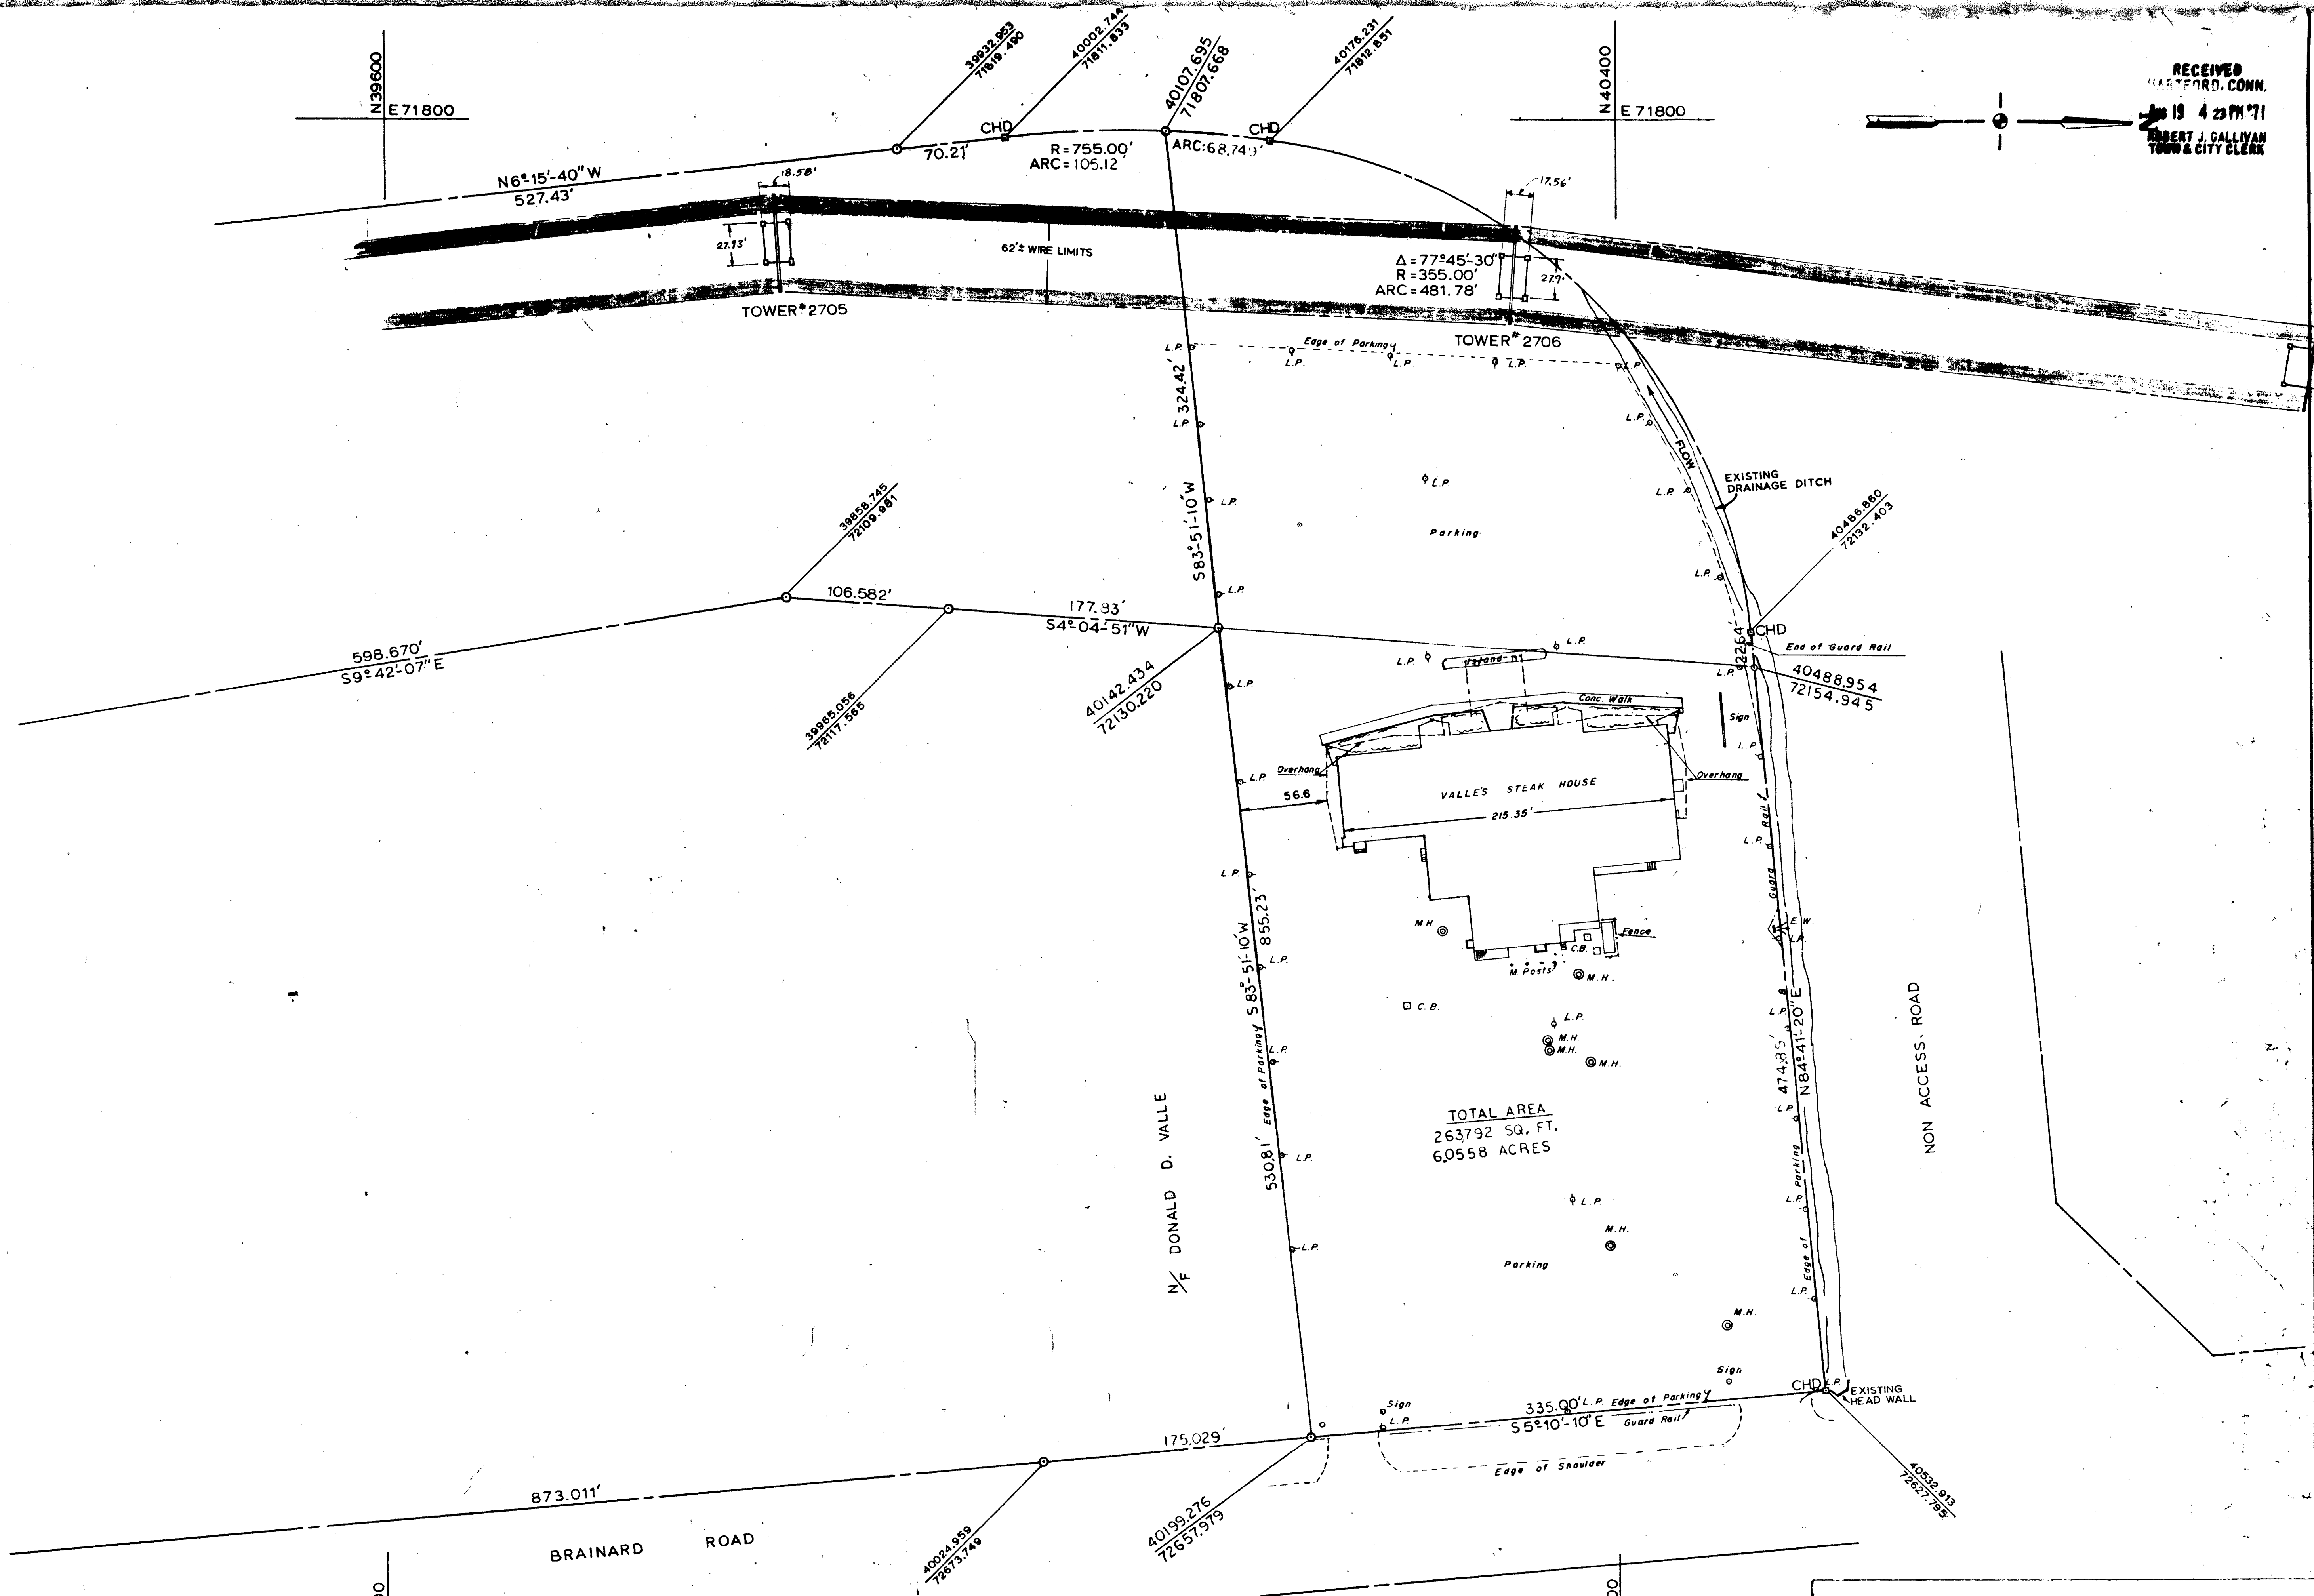

I hereby certify that this survey and the bounds and measurements shown hereon are substantially correct; that the lines shown hereon and the lines of actual possession are the same; that the buildings are located as shown and do not encroach ever or upon street, title or building lines, except as shown hereon; that there are no violations of zoning ordinances, restrictions or other rules and regulations in respect to the location of said buildings; and that there are no easements or encroachments affecting this property apparent from a careful inspection of the same, other than those shown and depicted hereon.

8-10-71


THIS MAP CONFORMS TO CLASS A-1 OF CODE OF CONN. TECHNICAL COUNCIL, INC.



HENRY N. LOOMIS & ASSOCIATES
AVON PLAINVILLE HARTFORD
CONSULTING ENGINEERS

SURVEY OF PROPERTY
OF
VALLE REALTY CO. OF CONN., INC.
HARTFORD, CONN.

SCALE: 1" = 50'
SURVEYED BY: DATE: 8-8-71
"AS BUILT" 8-8-71
KPP 65-18(1)

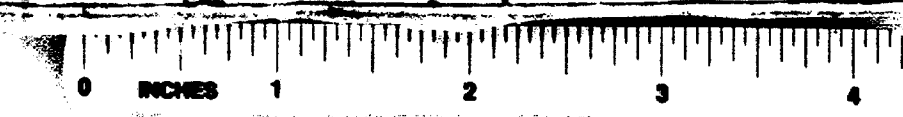

439