


The portion of Woodland Street shown on this plan is an established public street of the City of Hartford.

October 12, 1971

*George C. Hynes*  
City Engineer

HARTFORD SECRETERIAL SCHOOL INC.

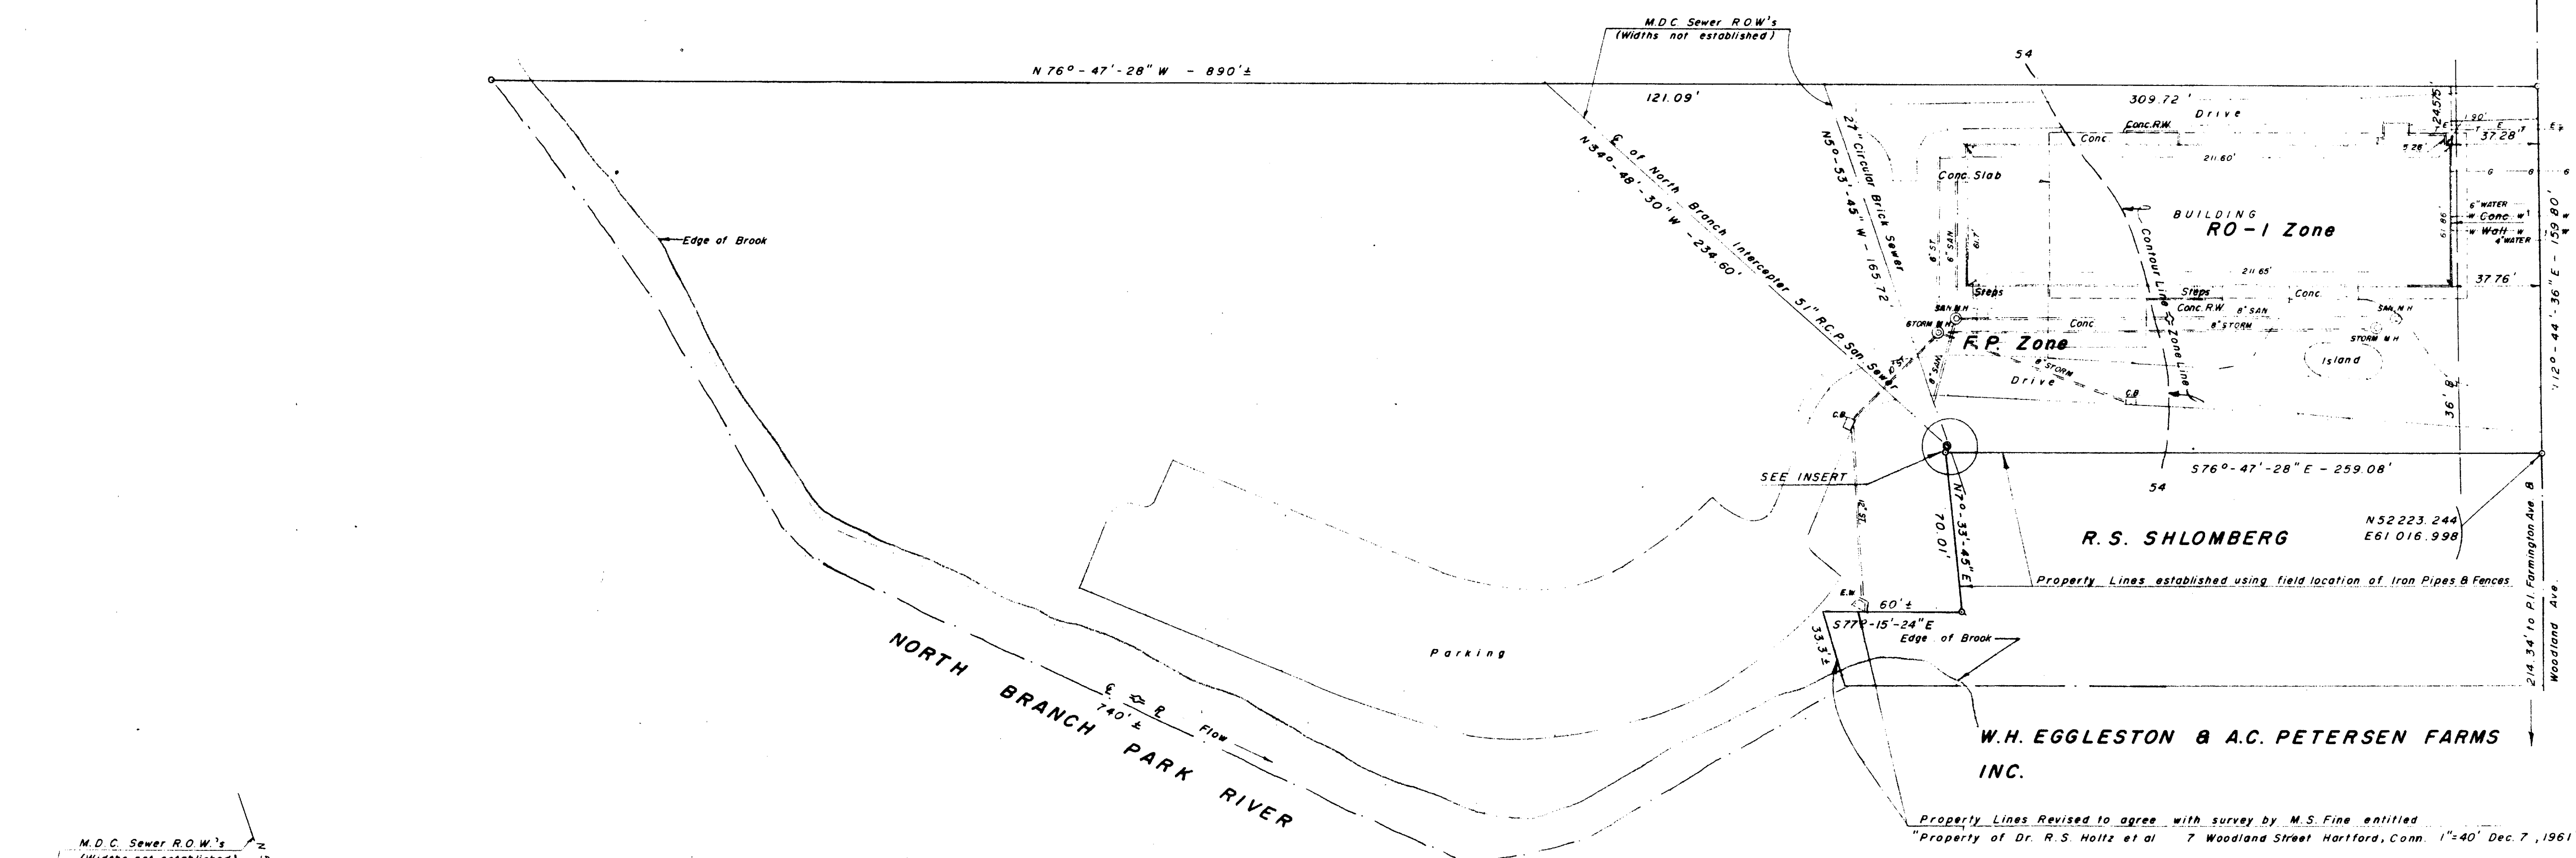

**SURVEY MAP**  
Property of  
**IMMANUEL CHURCH HOUSING CORPORATION**  
**HARTFORD, CONN.**

Area = 4.37 ac ± (190,500 s. f. ±)

**NOTE:**

Location of E. R.O.W.'s based on field location "as built" and Layouts by M.D.C. May 1921 & April 1937.

I hereby certify to Connecticut Attorneys' Title Guaranty Fund, Inc. that this survey was actually made upon the ground on 5-21-68 & 5-7-70 and that the squares and measurements shown hereon are correct within the standards of Class A-1 of the Code of the Technical Council, Inc. and that, unless otherwise shown, title lines and lines of actual possession are the same, buildings are located as shown and do not encroach over or upon street, title or building lines, there are no violations of zoning regulations with reference to the location of said buildings, and there are no easements or encroachments affecting this property apparent from a careful inspection of the same.

Federal Housing Administration  
The Connecticut Bank and Trust Company  
Federal National Mortgage Association  
Employers Commercial Union Insurance Company of America  
Immanuel Church Housing Corporation  
Professional Engineer and Land Surveyor

"FHA Project No. 017-44002-NP"  
Project Name - "IMMANUEL HOUSE"

10- 6-71 Edge of Brook  
9-30-71  
9-27-71 As Built  
8-3-70 As Built  
7-17-70 PARK RIVER CHANNEL AS OF JUNE 1948 BY M.D.C.

**IGOR VECHESLOFF**  
PROFESSIONAL ENGINEER & LAND SURVEYOR  
51 LORRAINE STREET  
HARTFORD, CONNECTICUT

SCALE 1" = 40' DATE 5-7-70  
DRAWING NO. 1043

RECEIVED  
OCT 8 4 01 PM '71  
TOWN & CITY CLERK  
HARTFORD, CONN.

440  
C&S FILE COMP. JUNE 1971  
C&S