
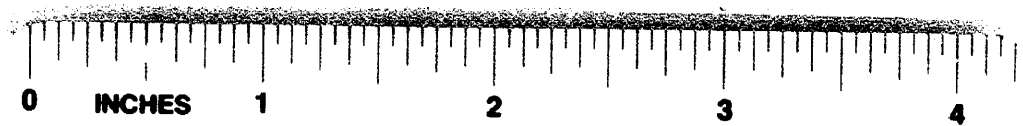
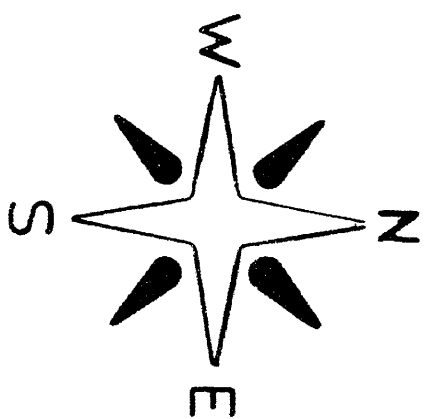


1050

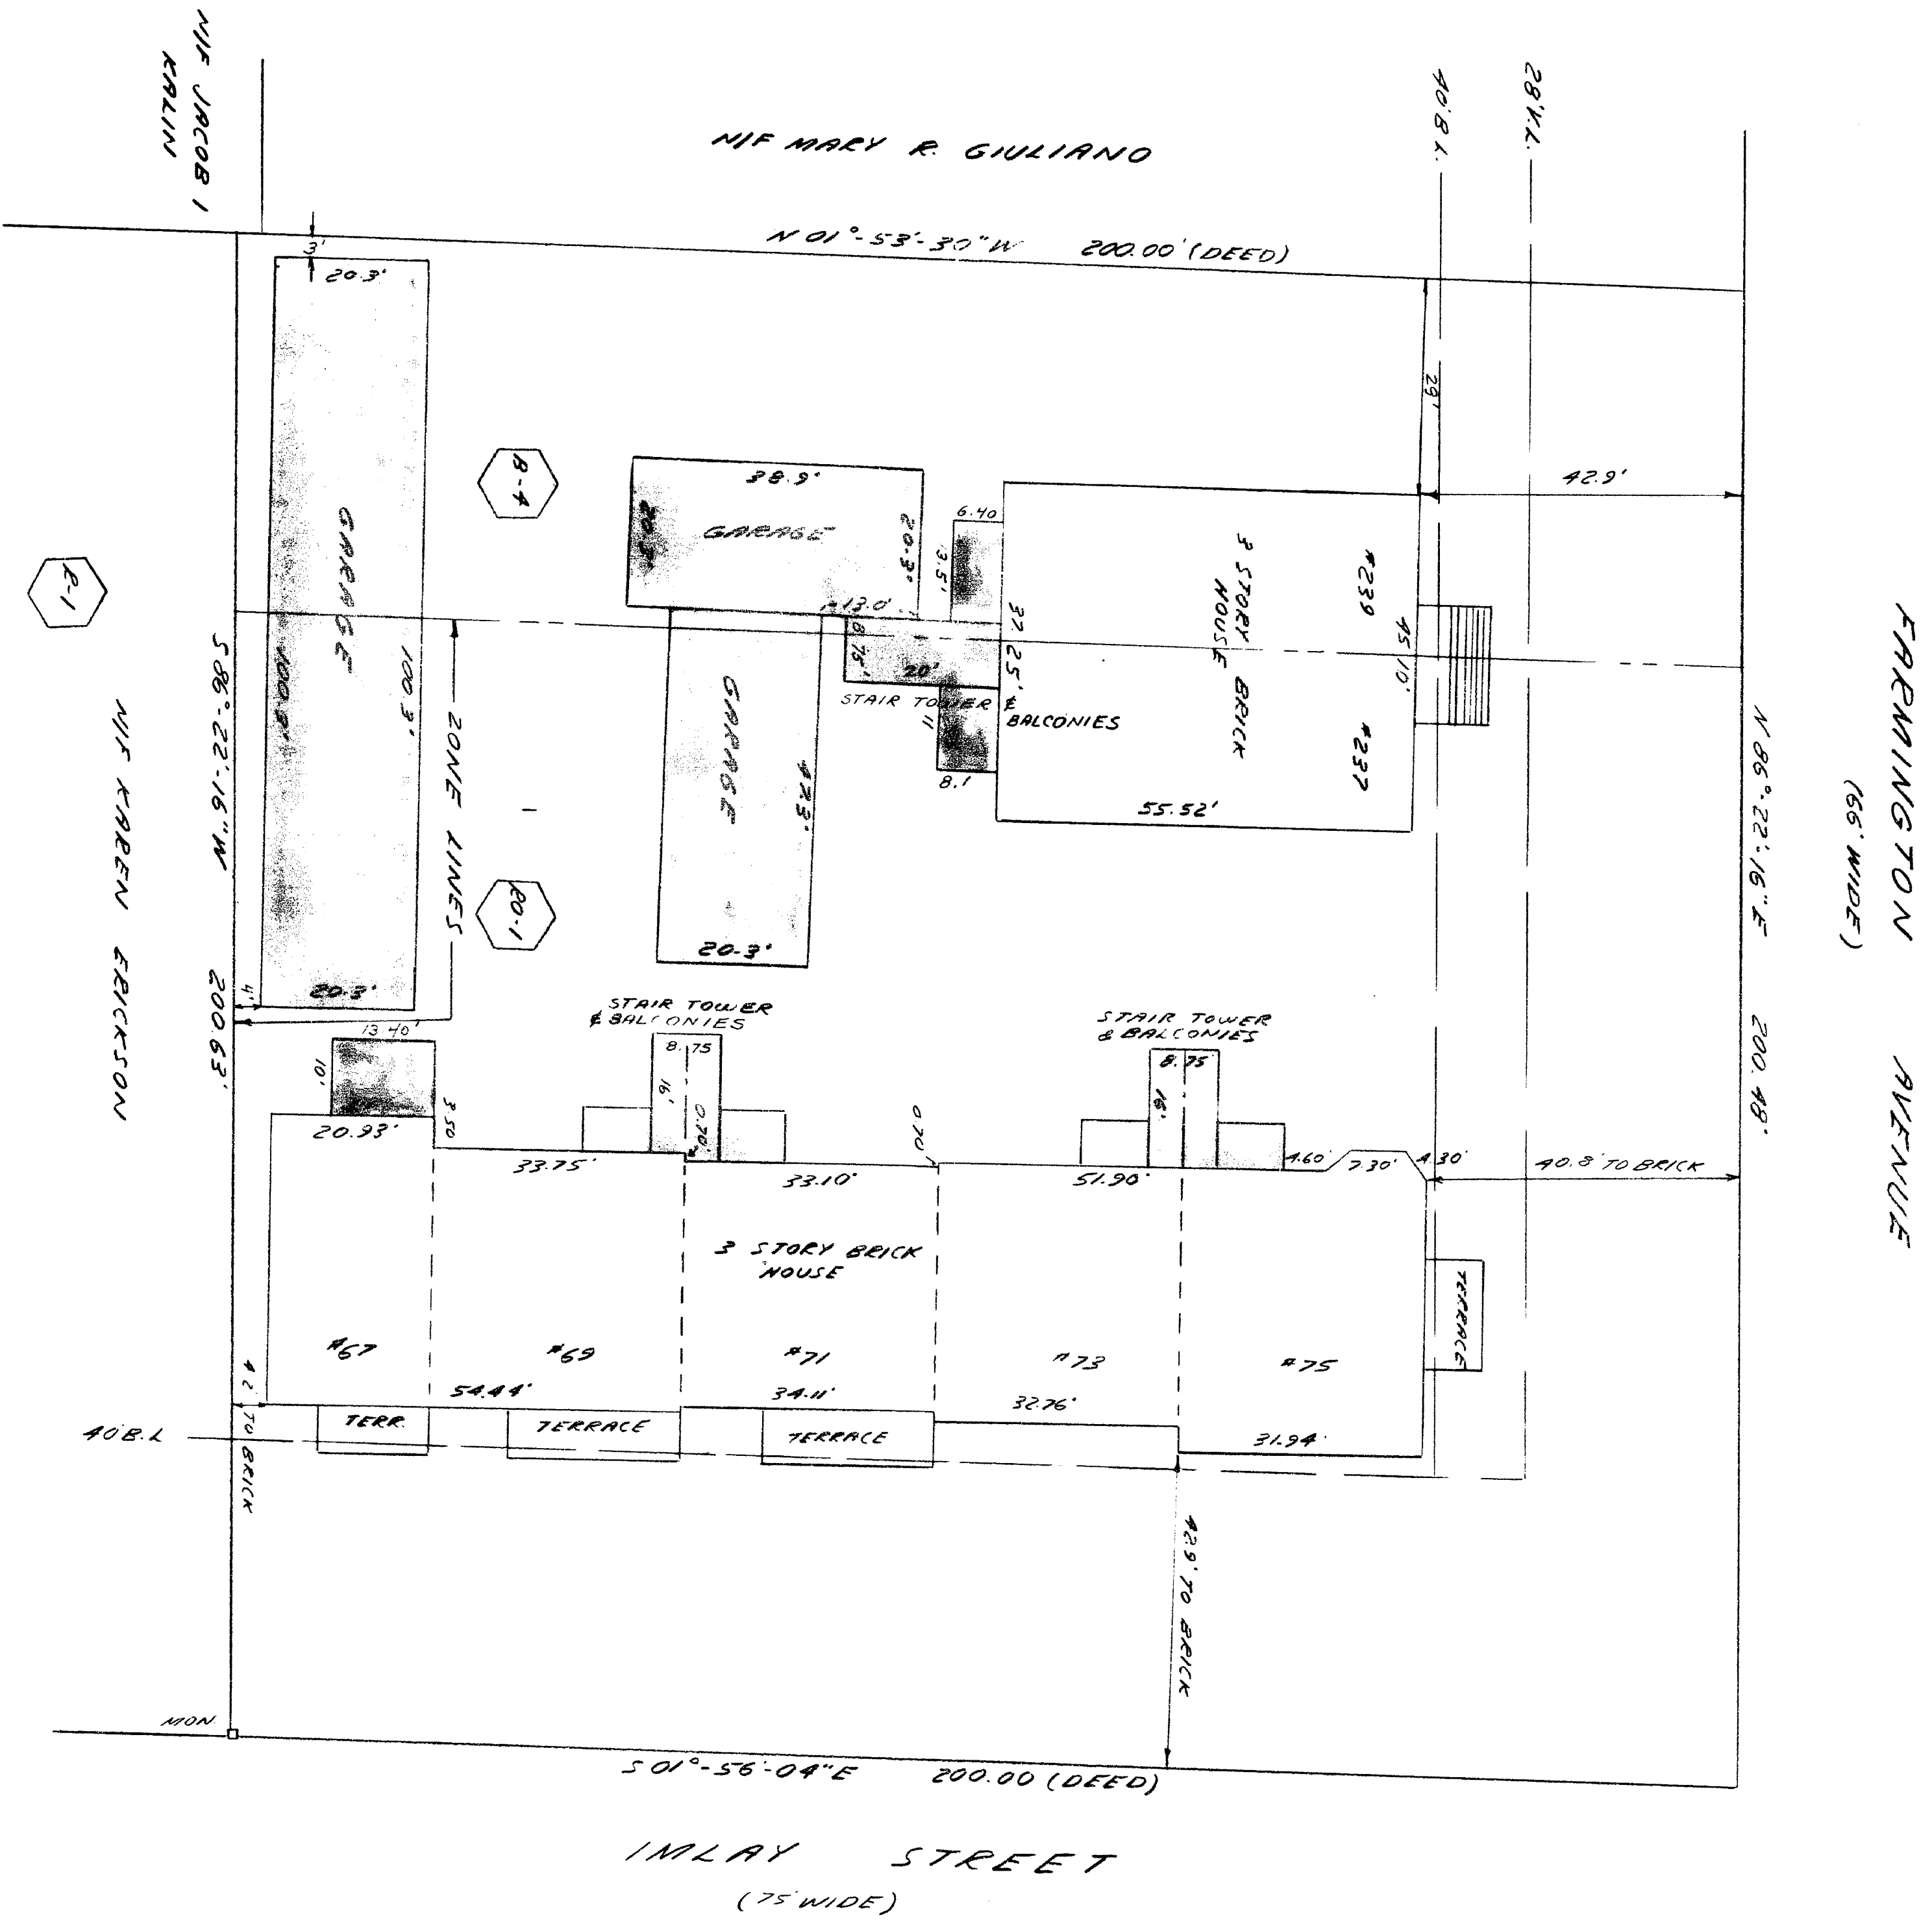

AS BUILT PLAN
FOR
COMMUNITY REHABILITATION
INVESTMENT CORPORATION
HARTFORD, CONN.

TO COMMUNITY REHABILITATION INVESTMENT CORPORATION, COMMONGUEALTH LAND TITLE INSURANCE COMPANY, FARMINGTON PLACE CONDOMINIUM ASSOCIATION, INC. AND SCHWARTZ & SCHWARTZ, P.C. & KOTLIN. I hereby certify that the survey and the boundaries and measurements shown hereon are substantially correct, that the title lines and the lines of actual possession are the same, that the buildings are located as shown and do not encroach over or upon street, title or building lines, that there are no violations of zoning ordinances, restrictions or other rules and regulations in respect to the location of said buildings and that there are no assessments or other encumbrances affecting this property, shown from a careful inspection of the same other than those shown and depicted hereon.

8.24.1978

I hereby certify this map to be substantially correct and in accordance with Class A-2 of Conn. Technical Council, Inc. Code.

Myron Feinstein, L.S.

SEP 15, 1978

Charles E. Hyatt, City Engineer

The portions of Farmington Avenue and Imlay Street shown on this plan are established public streets of the City of Hartford.

MYRON FEINSTEIN ASSOCIATES LAND SURVEYING & LAND PLANNING ENGINEERING HARTFORD, CONNECTICUT		DRAWN BY T.D. DATE 8.24.1978 SHEET NO. 7815
TITLE OF SHEET AS BUILT PLAN SCALE 1" = 20'		REVISIONS
SURVEY BY DESIGN BY		

415629
RECEIVED BY
SEP 15 12 19 PM '78
TOWN ENGINEER