


Unit 1

62-39414-2

BEACH MEAK
TOP OF FINE HYDRANT
FLYBY. 05:16 MDC DATUM

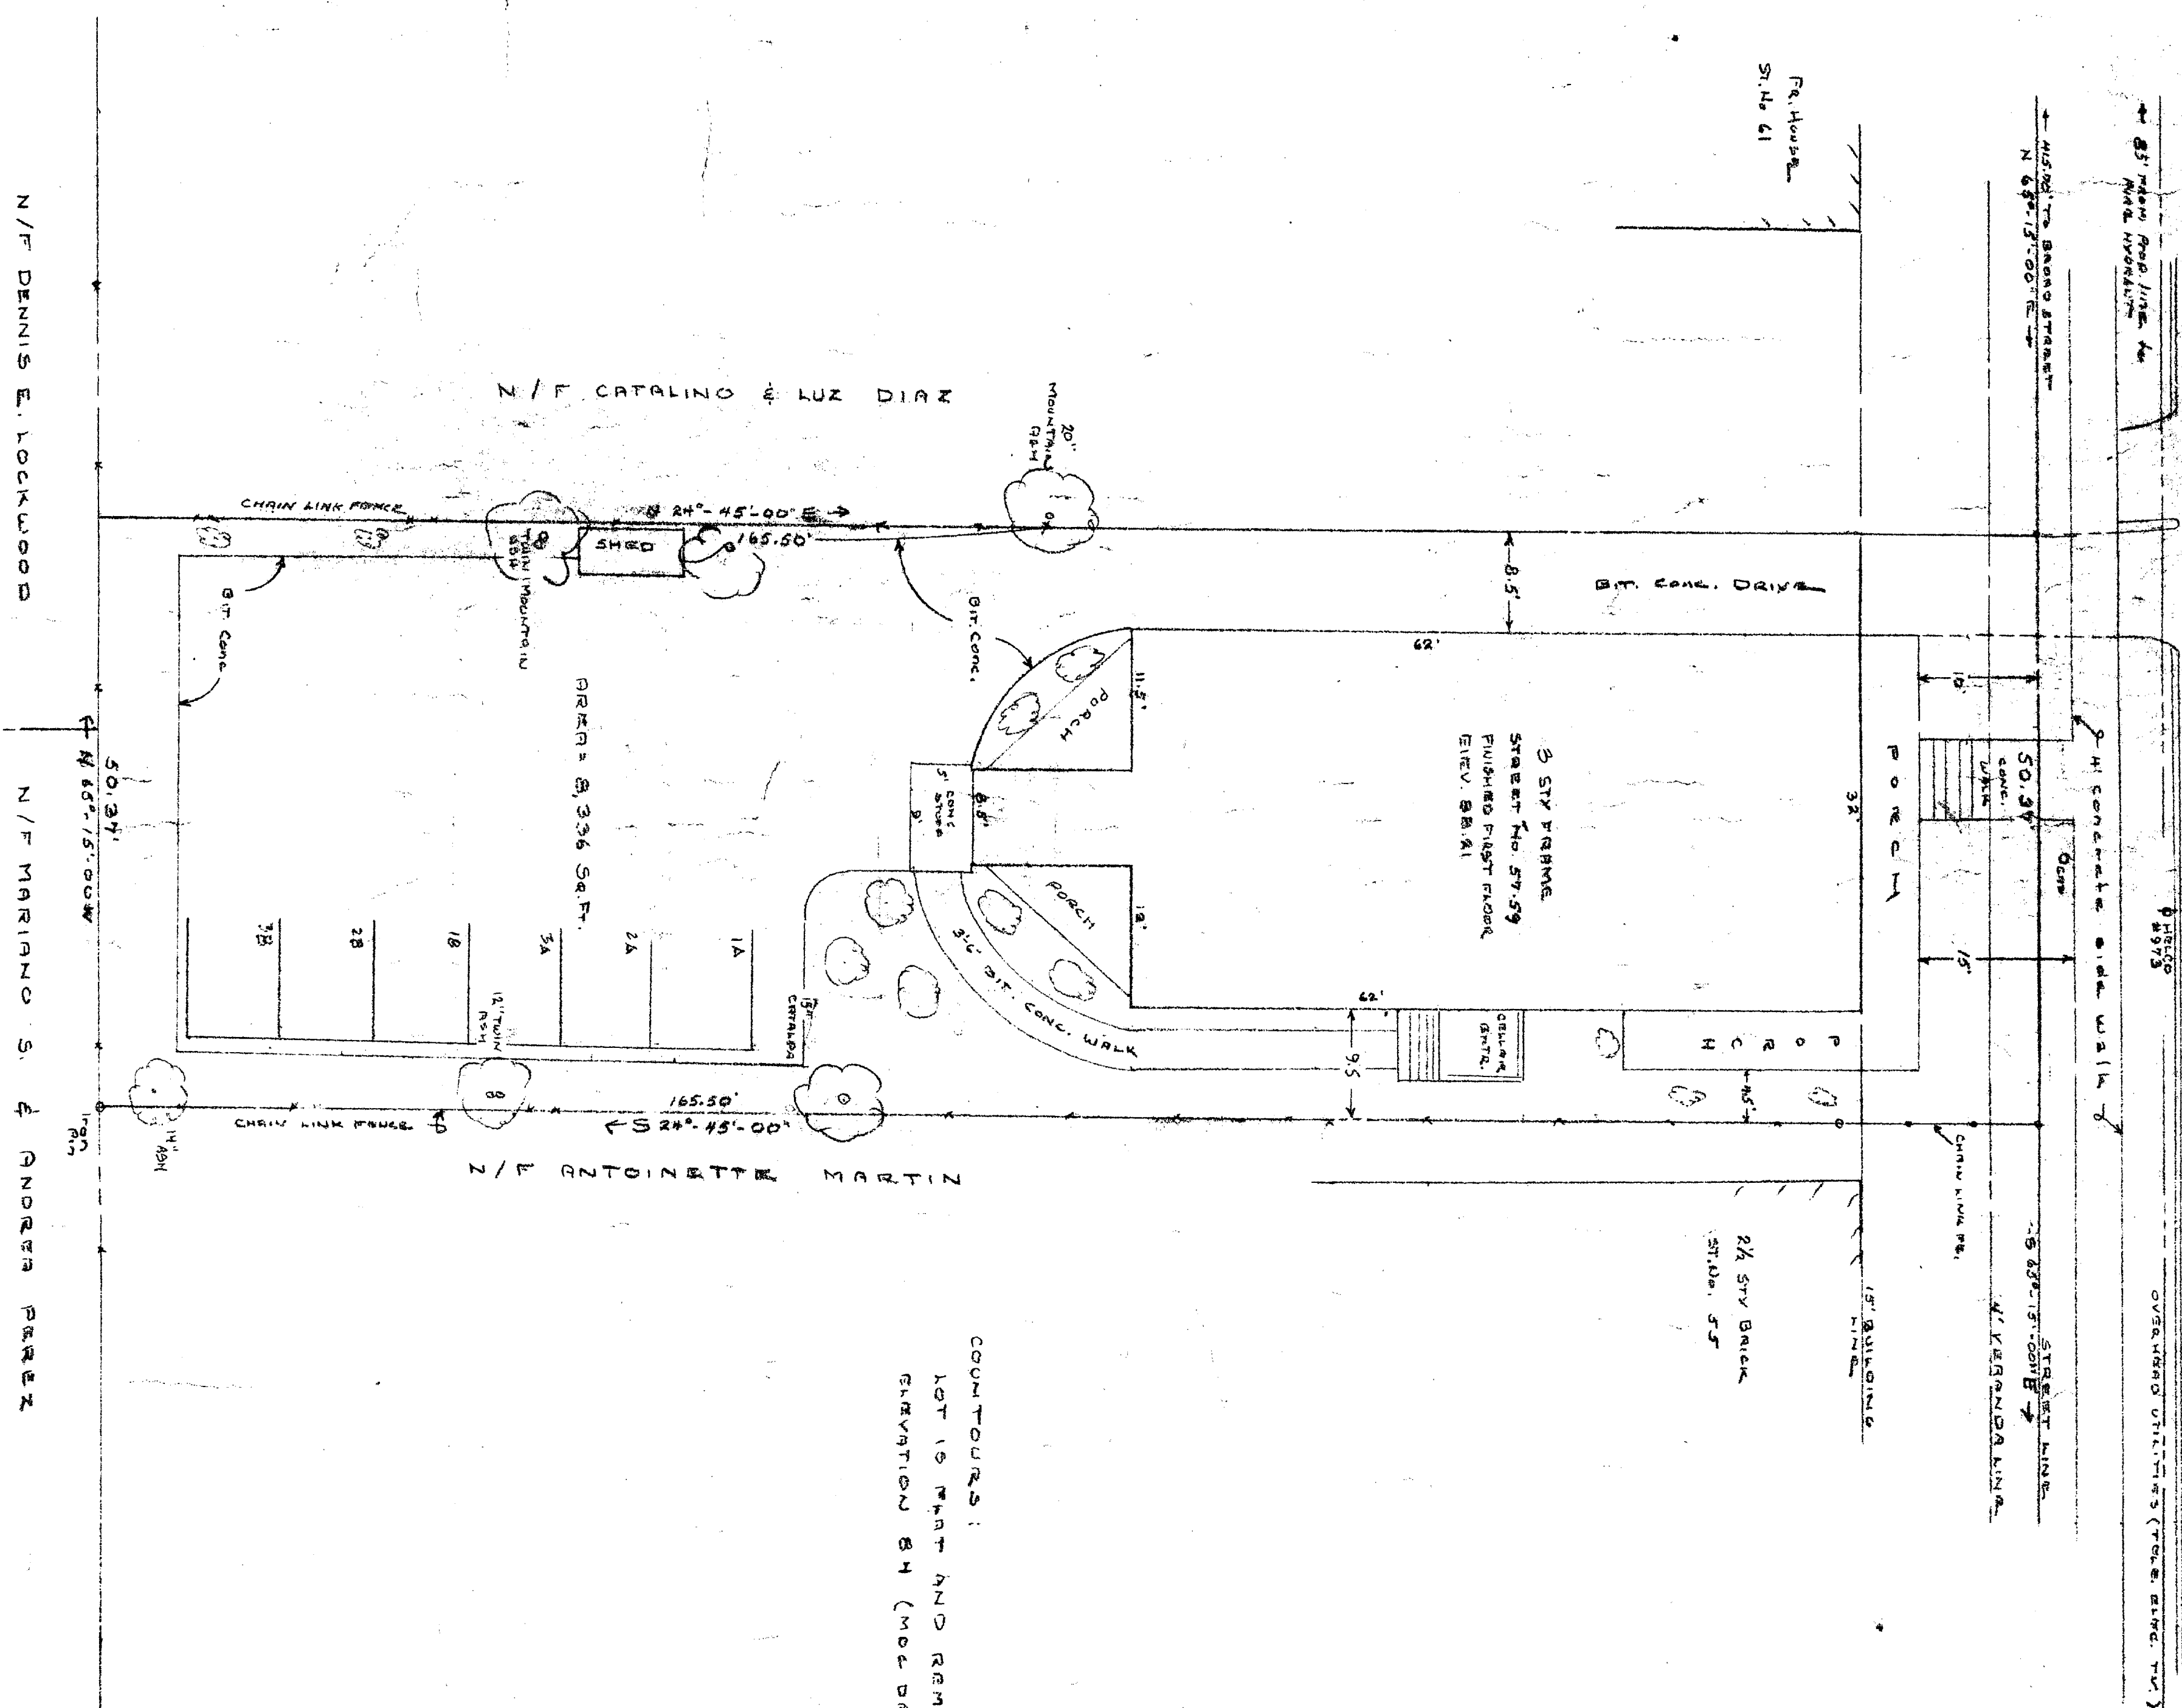

COGITATION
LOTT - 0 FIGHT 420 REMAINS 3.712
EXPLANATION BT (3000 DATES)

LIKED TO BE ABLE TO GET THE LAND AND SURVEY
CHARTERED AND ACCORDANCE WITH THE REGULATIONS
OF A CLASS A SURVEY, THAT THE ZONING REGULATIONS
OF THE CITY OF HARTFORD ARE NOT VIOLATED WITH
REGARD TO LOT AREA, LOT DIMENSIONS OR LOCATION
OF STRUCTURE.

1. RECEIVED 1.1.1967
SURVEYED RICHARD T. TOWER VIA L. 1.5
24 WINNING KANAN EVON CT.

TOPOGRAPHICAL SURVEY
CITY OF HARTFORD, CONNECTICUT
STREET 57/59 MADISON STREET
SCALE 1"=10' DATE 3-14-81
REVISED 7-31-81 TO SHOW ASUILT TOPOGRAPHY

Revised 7-31-81 To Show As Built Topography

MORTGAGE CREATION

[illegible]

The portion of Madison Street shown on this plan is an extension to the public street of the City of Portland.

August 1981

Louise Elling
City Engineer

City Engineer

City Engineer

WHITE ST

THE MADISON • CONDOMINIUM
57/59 MADISON ST. • HARTFORD CONNECTICUT

1

	1173		EXP. DATE
--	------	--	-----------