


SEP 27 11:13 AM '88
PAGE

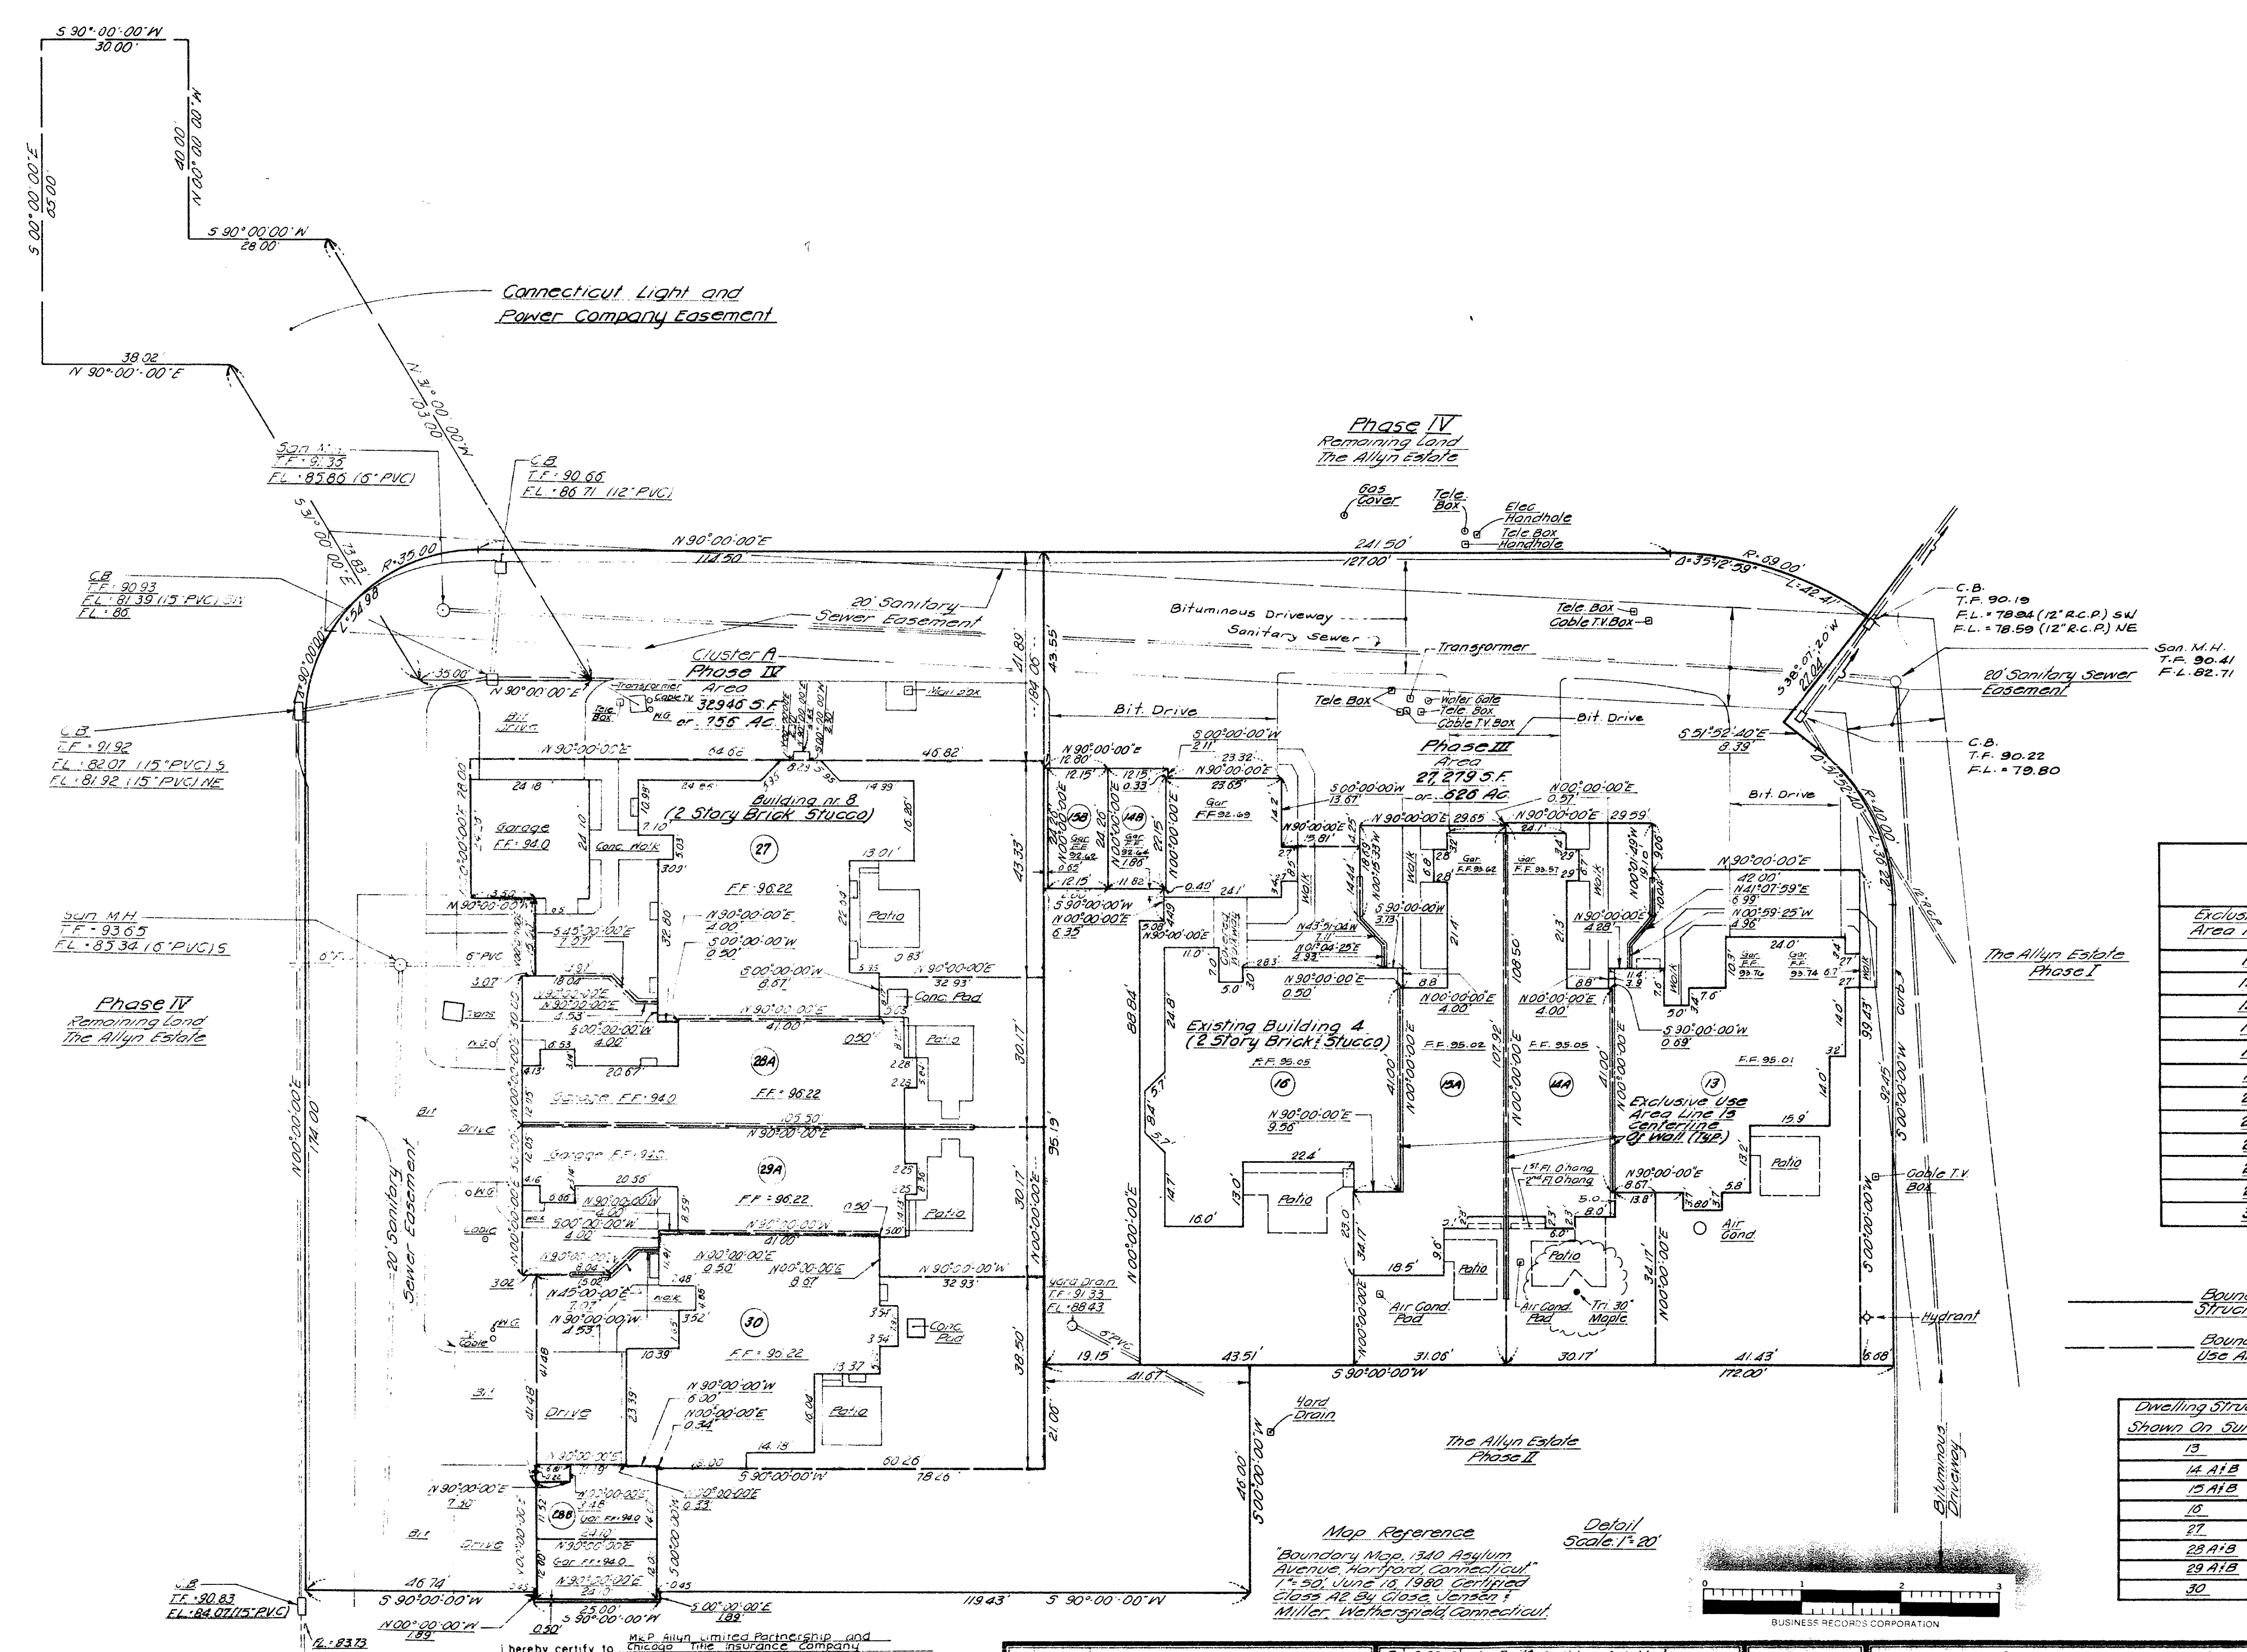

Exclusive Use Area Data	
Exclusive Use Area Number	Area
13	4558 S.F. or .105 AC
14A	2889 S.F. or .065 AC
14B	2885 S.F. or .065 AC
15A	2881 S.F. or .065 AC
15B	2895 S.F. or .065 AC
16	5280 S.F. or .121 AC
27	5288 S.F. or .121 AC
28A	2781 S.F. or .063 AC
28B	2781 S.F. or .063 AC
29A	2781 S.F. or .063 AC
29B	2781 S.F. or .063 AC
30	4587 S.F. or .105 AC

Legend
Boundary of Dwelling Structure (Including Garage)
Boundary of Exclusive Use Areas (Shaded)

Dwelling Structure Numbers Shown on Survey	
Identification Number	
13	1338 Asylum Avenue
14A	1340E Asylum Avenue
14B	1340W Asylum Avenue
15	1342 Asylum Avenue
16	1348 Asylum Avenue
27	1352 Asylum Avenue
28A	1358S Asylum Avenue
28B	1358N Asylum Avenue
29	1362 Asylum Avenue

The property shown on this plan is North of Asylum Ave which is an established public street of the City of Hartford.
Date 10/7/88 City Engineer

SURVEY AND PLAN CONTAINS ALL THE INFORMATION REQUIRED BY SECTION 39 OF THE CONN. INTEREST OWNERSHIP ACT, EXCEPT INFORMATION PROVIDED ON PLANS, PLATS.

I hereby certify that this survey was actually made upon the ground on 9/15/88, and that it and the bounds and measurements shown hereon are correct within the standards of a Class A-E survey as defined in the Code of Practice for Standards of Accuracy of Surveys and Maps, adopted December 10, 1975, and as amended by the Connecticut Association of Land Surveyors, Inc. and that, unless otherwise shown, deed lines and lines of actual possession are the same, buildings are located as shown and do not encroach over or upon street, deed or building lines, there are no violations of zoning regulations with reference to the location of said buildings, and there are no easements or encroachments affecting this property apparent from a careful inspection of the same, other than those noted and depicted hereon.
CLOSE, JENSEN & MILLER
Civil Engineers & Surveyors
By John H. Miller

No.	Date	Description	Revisions
1	2/22/88	As Built Building 4 Added	
2	3/12/87	Phase II Added	
3	8/12/87	Phase III Added	
4	2/22/88	As Built Building 5 Added	

C. J. M.
Close, Jensen & Miller
Consulting Engineers, Land Planners & Surveyors
1137 Silas Deane Highway
Wethersfield, Connecticut 06091

THE ALLYN ESTATE
Planned Community
Asylum Avenue
Hartford, Connecticut

Designed
Drawn
Checked
Scale
Date
Sheet No.
Of
Job No.
File No.

1776

115 1776