


#2473-1

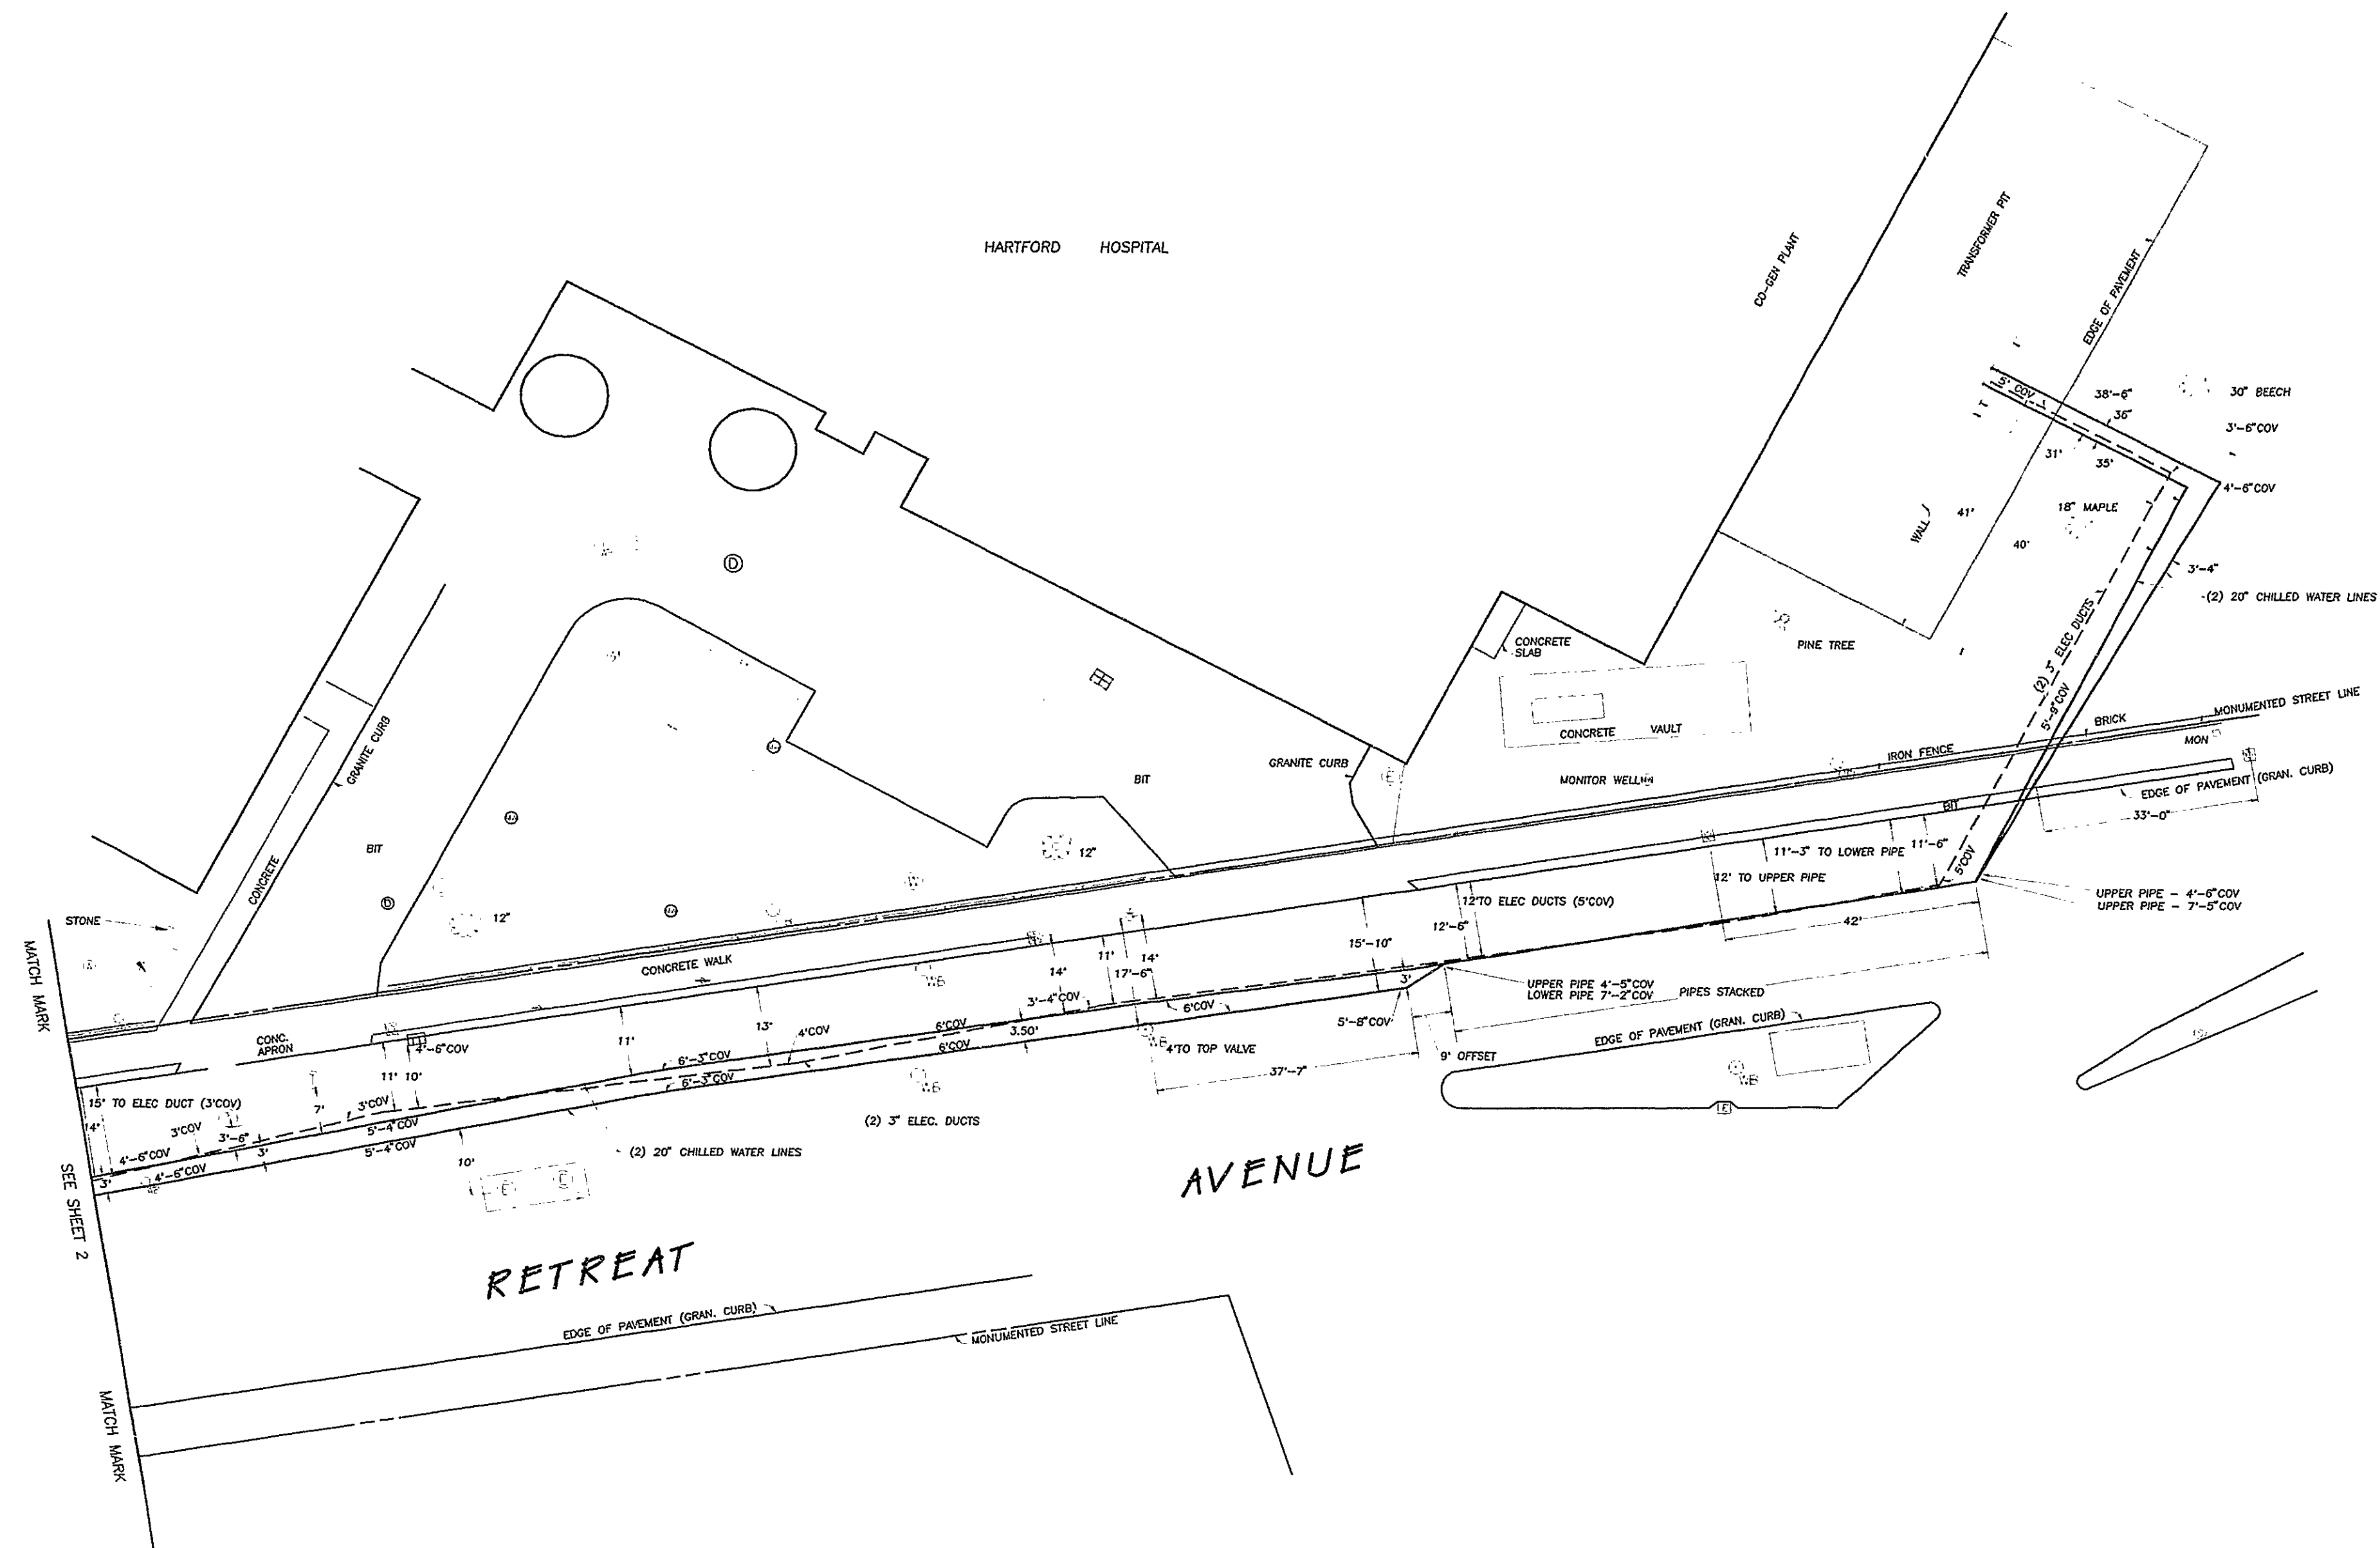

NOTE:
EXISTING UNDERGROUND STRUCTURES OR SERVICES ARE SHOWN IN AS NEAR
THEIR CORRECT POSITION AS POSSIBLE. HOWEVER, ALL SUCH LOCATIONS
ARE APPROXIMATE ONLY AND ALL SUCH STRUCTURES OR SERVICES MAY
NOT BE SHOWN. FIELD TEST HOLES ARE RECOMMENDED TO VERIFY LOCATIONS.
CALL BEFORE YOU DIG. 1-800-322-4433

1 INCH = 20 FEET

THIS MAP PRODUCED BY
ORIGINAL INK DRAWING ON
POLY FILM OR LINEN
SARGIS ASSOCIATES
1000 SHAS DEANE HWY., SUITE 212
ROCKY HILL, CT 06867

SHEET 1 OF 6
PLAN
OF
AS-BUILT PIPE ROUTE
RETREAT AVENUE, HARTFORD
PREPARED FOR
THE ENERGY NETWORK
DATE: 12-00 SCALE: 1"=20'
SARGIS ASSOCIATES, INC.

The portion of this sheet
shown on this map is not
established public street of
The City of Hartford
Survey Supervisor
O. Blitt
12/01

#2473-1

0 1 2 3 4
INCHES

2473 1