


#2473-2

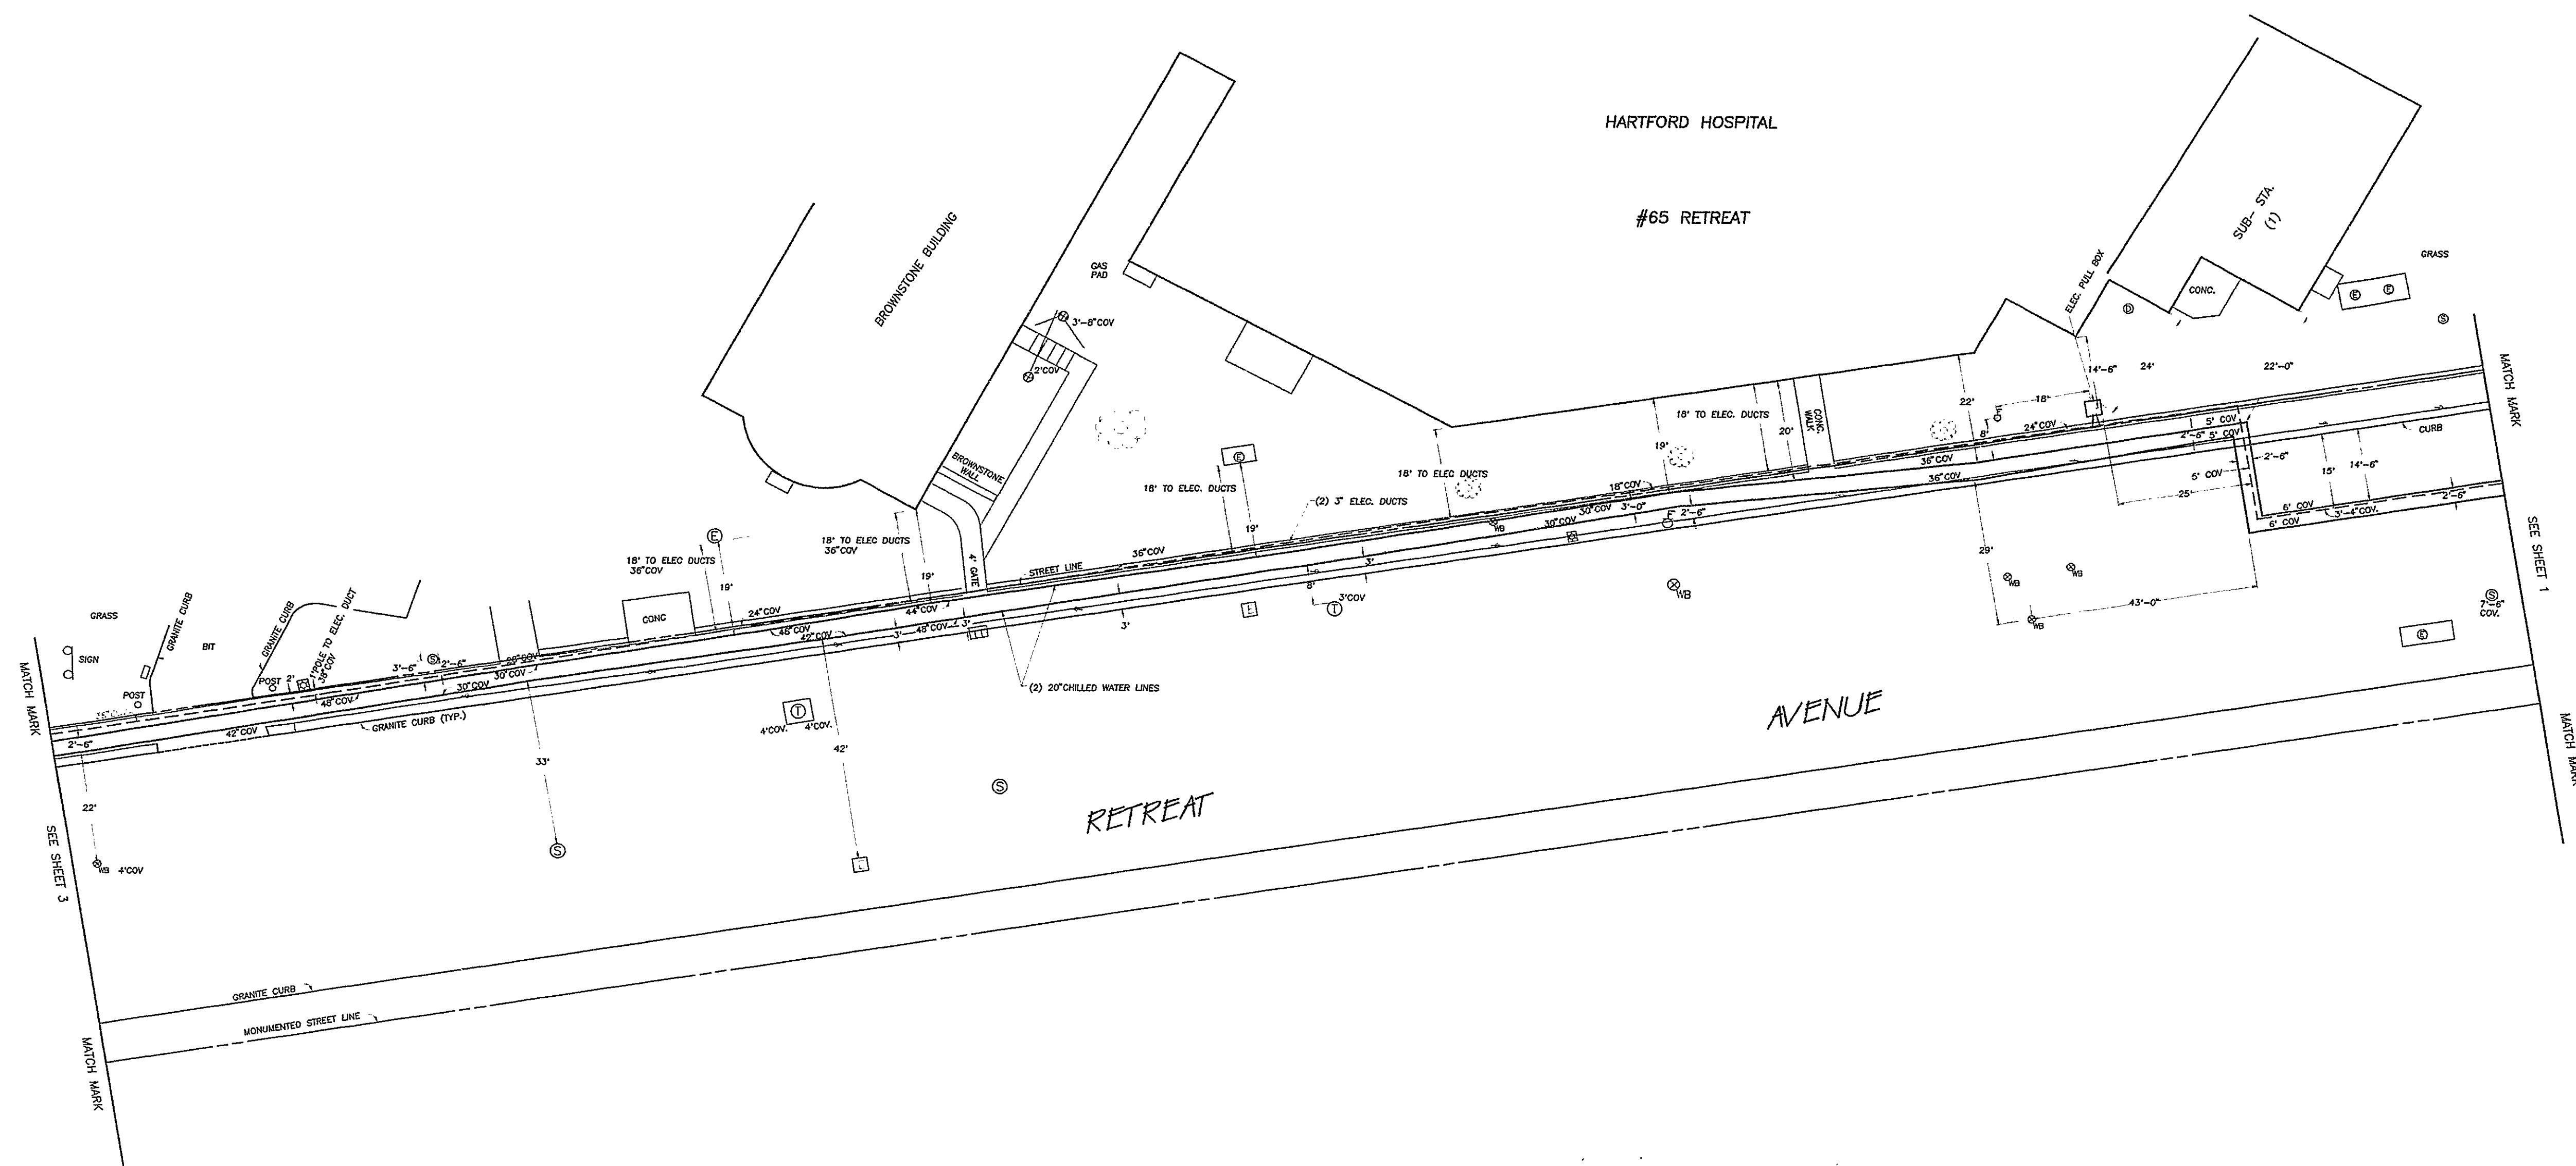

2473 2

NOTE:
EXISTING UNDERGROUND STRUCTURES OR SERVICES ARE SHOWN IN AS NEAR
THEIR CORRECT POSITION AS POSSIBLE. HOWEVER, ALL SUCH LOCATIONS
ARE APPROXIMATE ONLY AND ALL SUCH STRUCTURES OR SERVICES MAY
NOT BE SHOWN. FIELD TEST HOLES ARE RECOMMENDED TO VERIFY LOCATIONS.
CALL BEFORE YOU DIG. 1-800-322-4455

1 INCH = 20 FEET

THIS MAP PRODUCED BY
ORIGINAL INK DRAWING ON
POLY FILM OR LINEN
SARGIS ASSOCIATES
1800 SHAS DEARE HWY., SUITE 212
ROCKY HILL, CT 06067

SHEET 2 OF 6
PLAN
OF
AS-BUILT PIPE ROUTE
RETREAT AVENUE, HARTFORD
PREPARED FOR
THE ENERGY NETWORK
DATE: 12-00 SCALE: 1"=20'
SARGIS ASSOCIATES, INC.
ENGINEERS & SURVEYORS

Tr. The sheet
showing the location of
electricity and public street of
The City of Hartford
Survey Supervisor
O. Blum
6/6/01

#2473-2

0 1 2 3 4
INCHES