


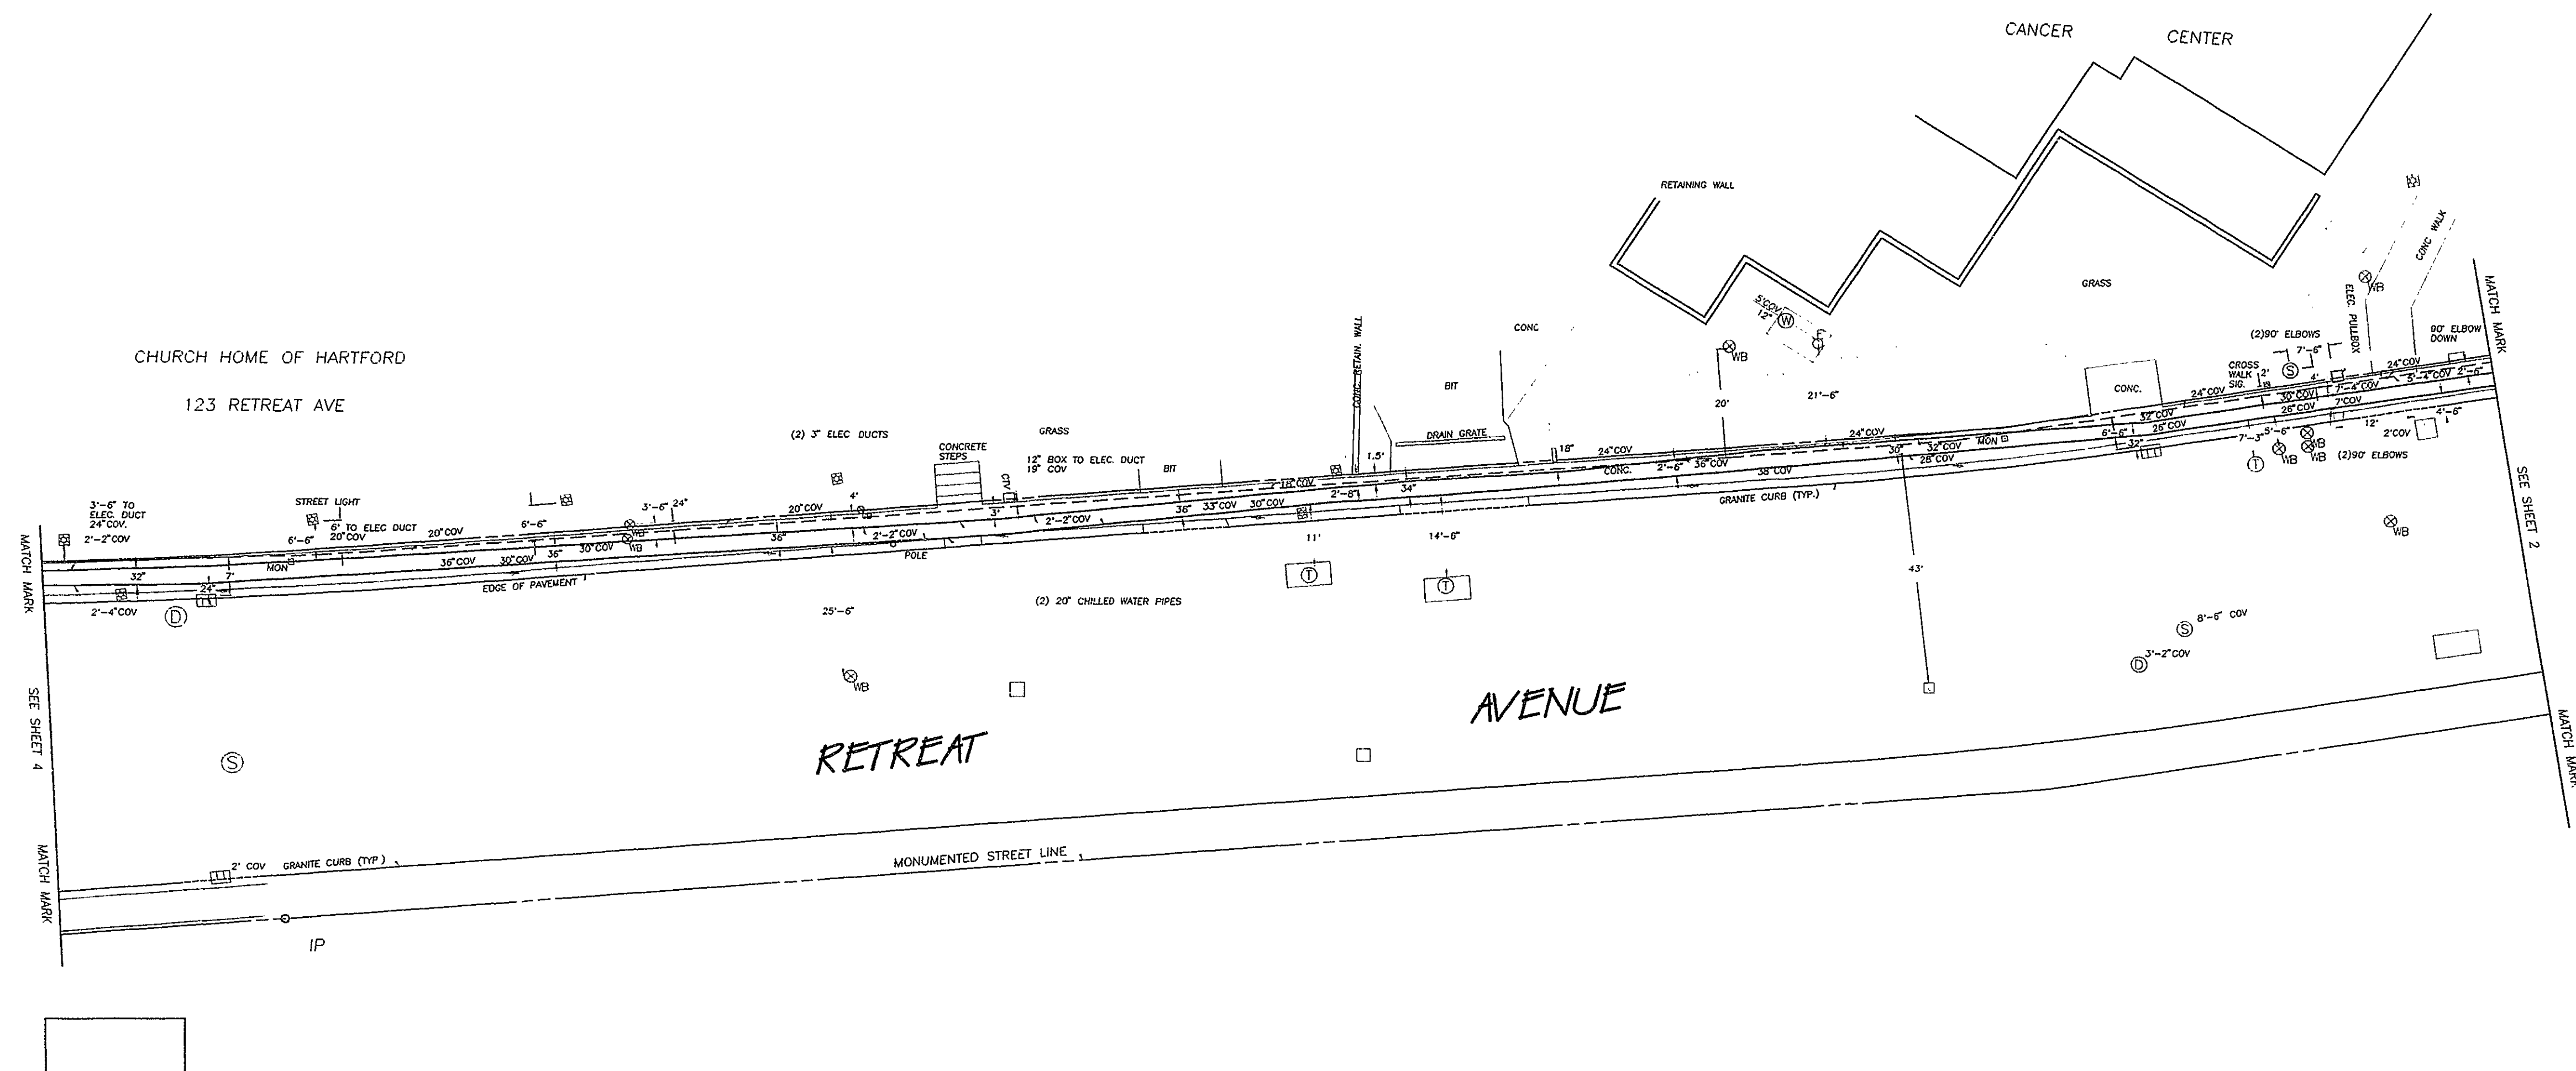

The portion of the street shown on this map is located within the City of Hartford.
 O. Blinn
 Survey Supervisor

THIS MAP PRODUCED BY
 ORIGINAL INK DRAWING ON
 POLY FILM OR LINEN
 SARGIS ASSOCIATES
 1500 SILAS DEANE HWY., SUITE 217
 ROCKY HILL, CT 06067

SHEET 3 OF 6
 PLAN
 OF
 AS-BUILT PIPE ROUTE
 RETREAT AVENUE, HARTFORD
 PREPARED FOR
 THE ENERGY NETWORK
 DATE: 12-00 SCALE: 1"=20'
 SARGIS ASSOCIATES, INC.



NOTE:
 EXISTING UNDERGROUND STRUCTURES OR SERVICES ARE SHOWN IN AS NEAR
 THEIR CORRECT POSITION AS POSSIBLE. HOWEVER, ALL SUCH LOCATIONS
 ARE APPROXIMATE ONLY AND ALL SUCH STRUCTURES OR SERVICES MAY
 NOT BE SHOWN. FIELD TEST HOLES ARE RECOMMENDED TO VERIFY LOCATIONS.
 CALL BEFORE YOU DIG. 1-800-922-4455.

2473 3

