



2473
2473
2473

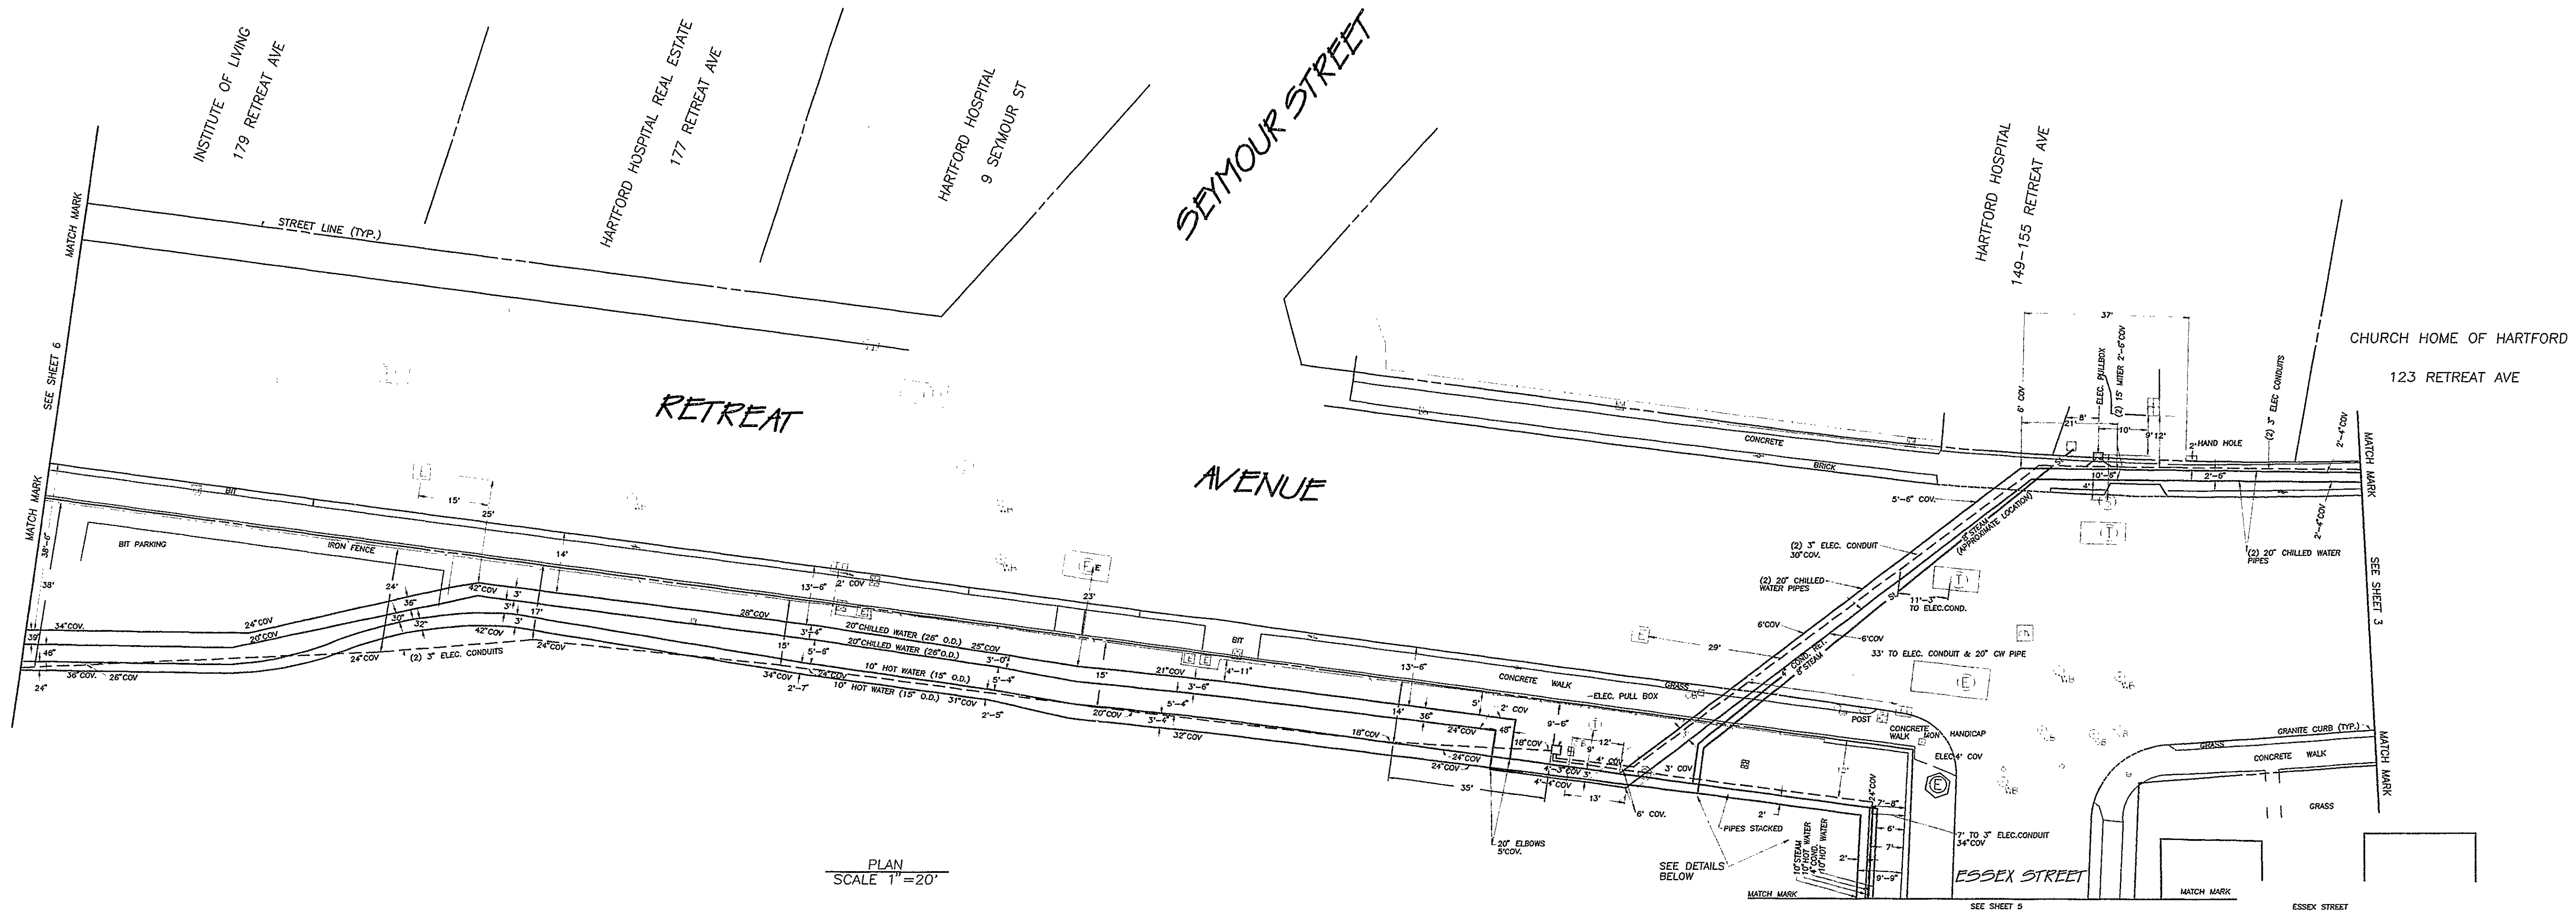


PLAN
SCALE 1"=20'

NOTES:
EXISTING UNDERGROUND STRUCTURES OR SERVICES ARE SHOWN IN AS NEAR THEIR CORRECT POSITION AS POSSIBLE. HOWEVER, ALL SUCH LOCATIONS ARE APPROXIMATE ONLY AND ALL SUCH STRUCTURES OR SERVICES MAY NOT BE SHOWN.

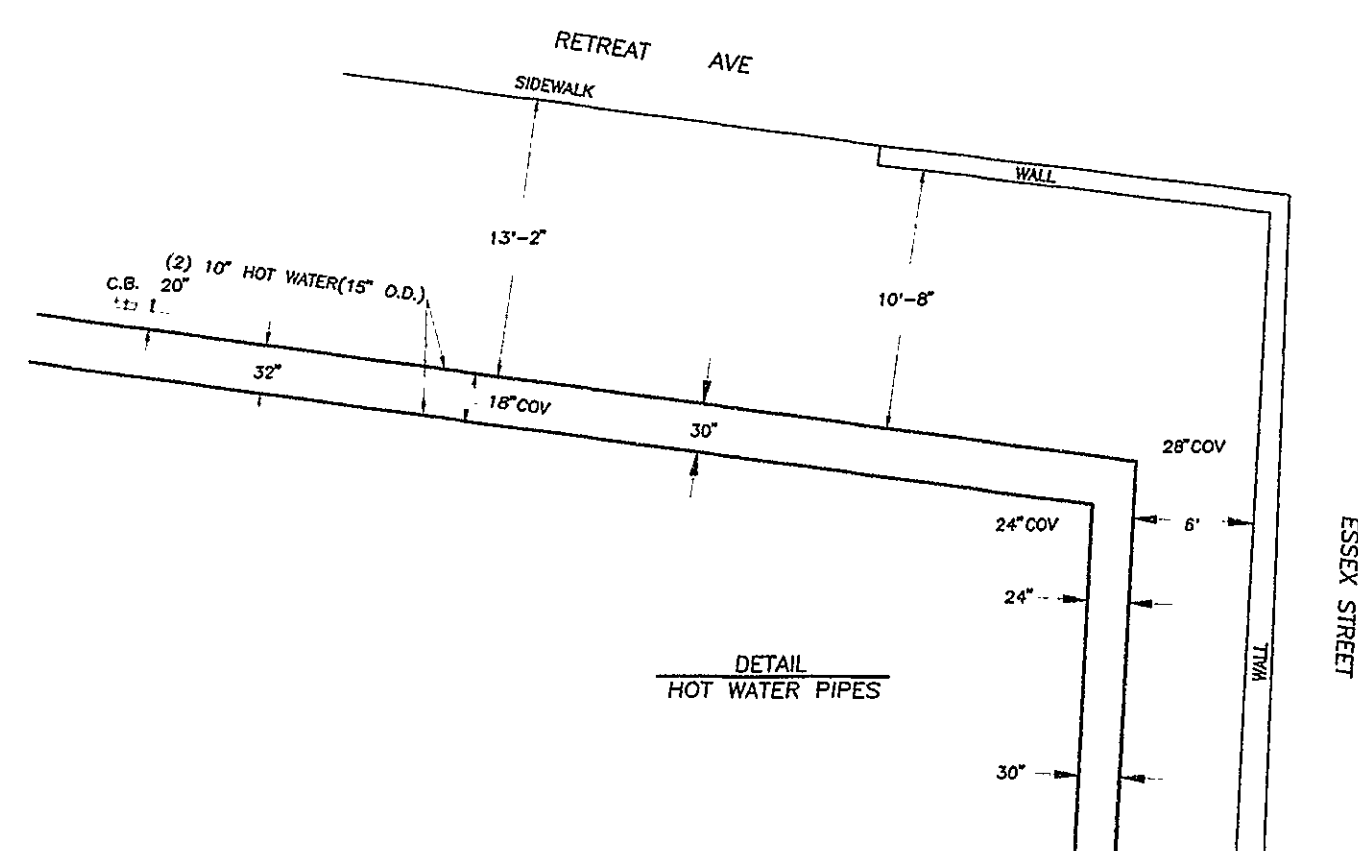

DETAIL
HOT WATER PIPES

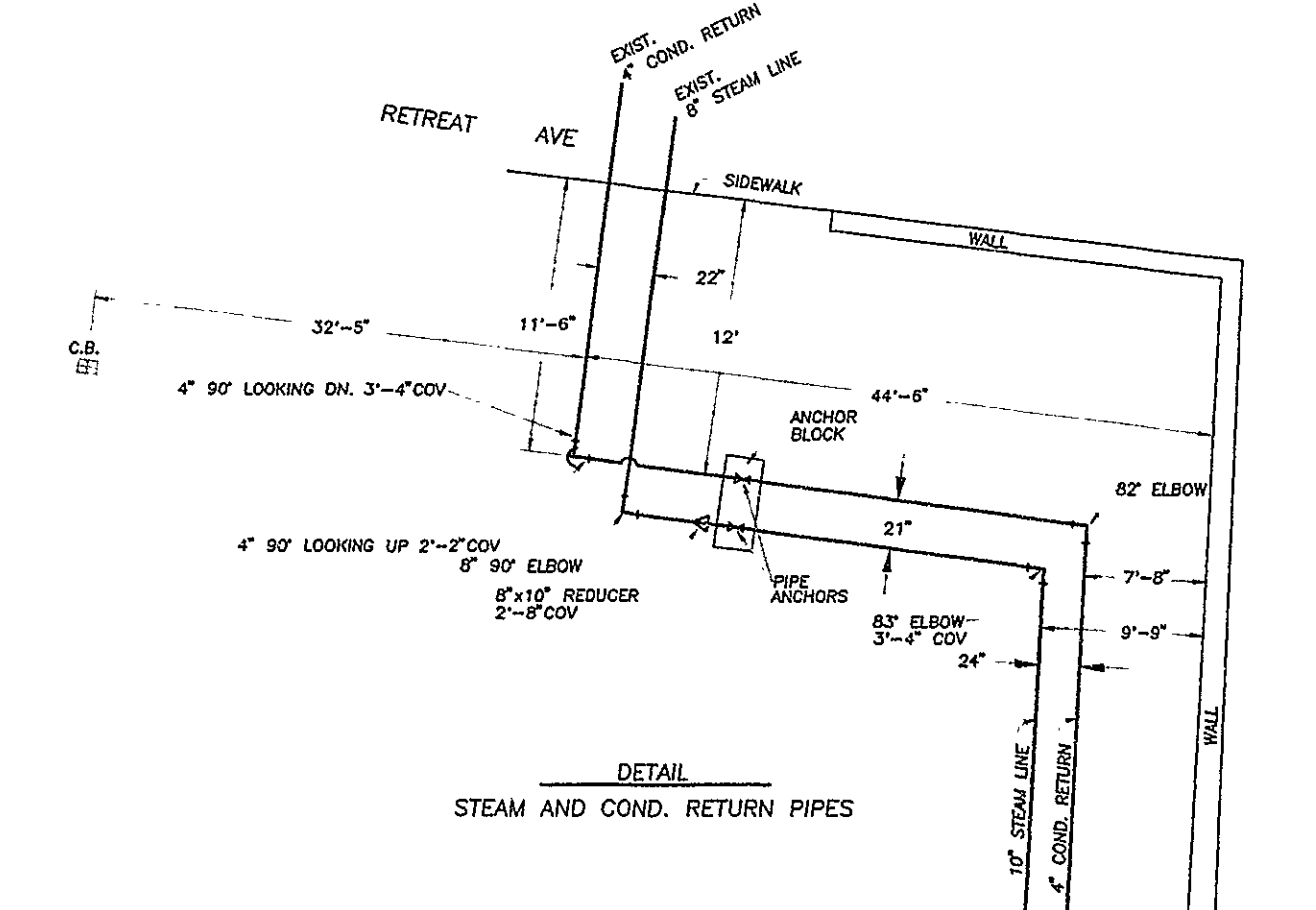

DETAIL
STEAM AND COND. RETURN PIPES

1 INCH = 20 FEET

THIS MAP PRODUCED BY
ORIGINAL INK DRAWING ON
POLY FILM OR LINEN
SARGIS ASSOCIATES
1800 BLUE HILL RD., SUITE 217
ROCKY HILL, CT 06867

SHEET 4 OF 6
OF
AS-BUILT PIPE ROUTE
RETREAT AVENUE, HARTFORD
PREPARED FOR
THE ENERGY NETWORK
DATE: 12-00 SCALE: 1"=20'
SARGIS ASSOCIATES, INC.