

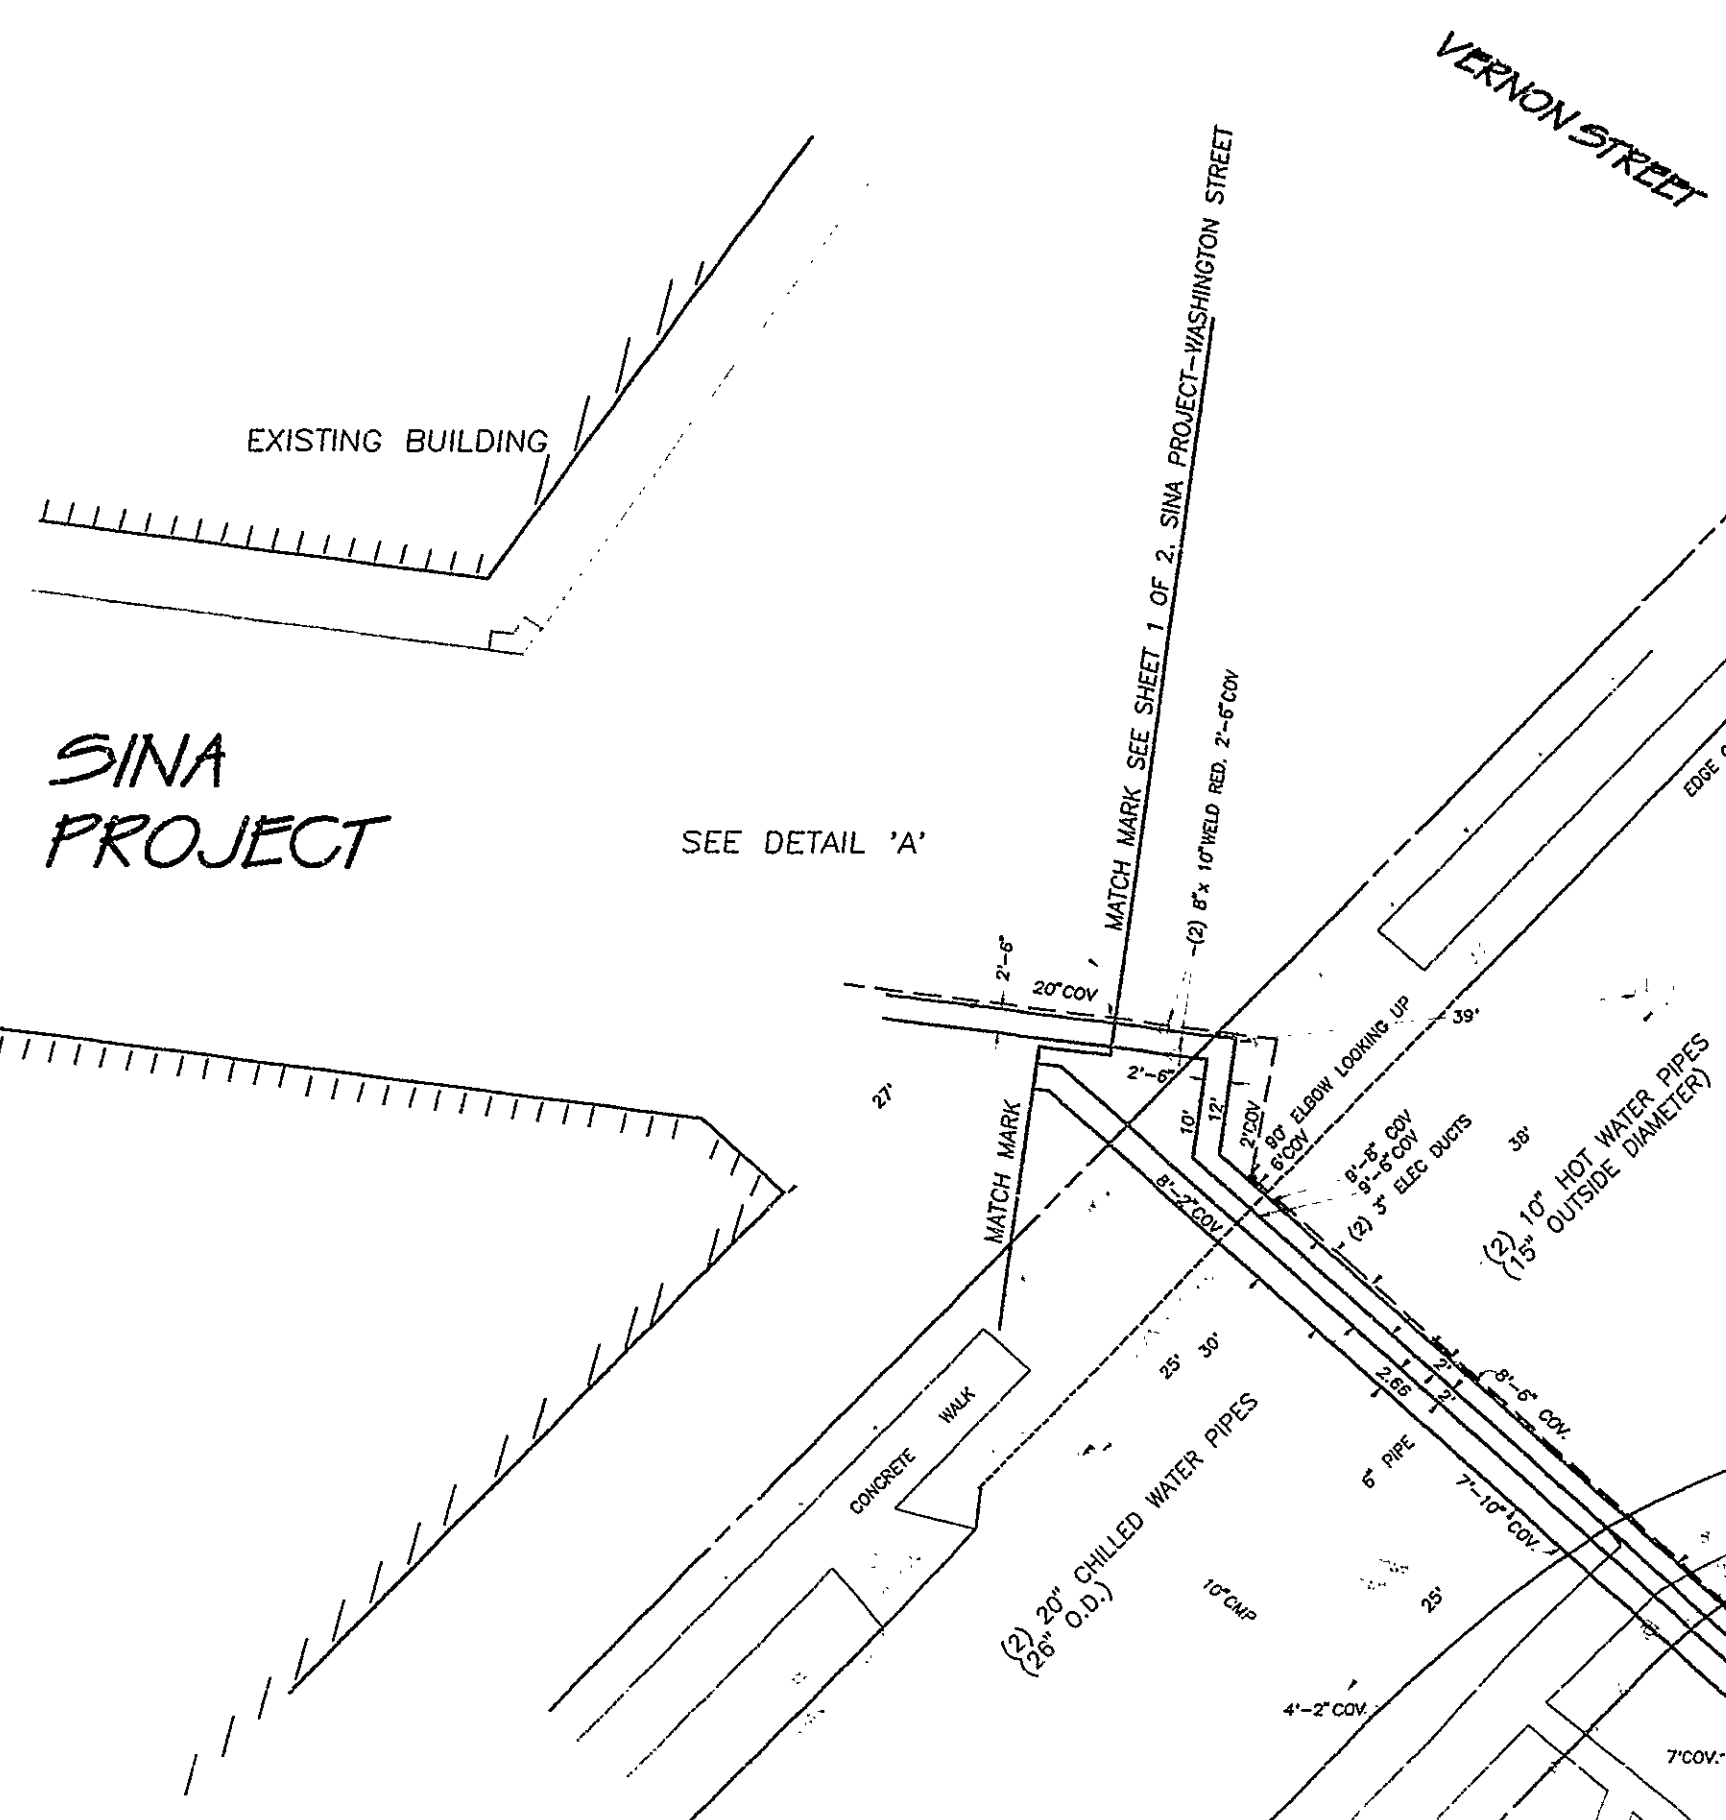


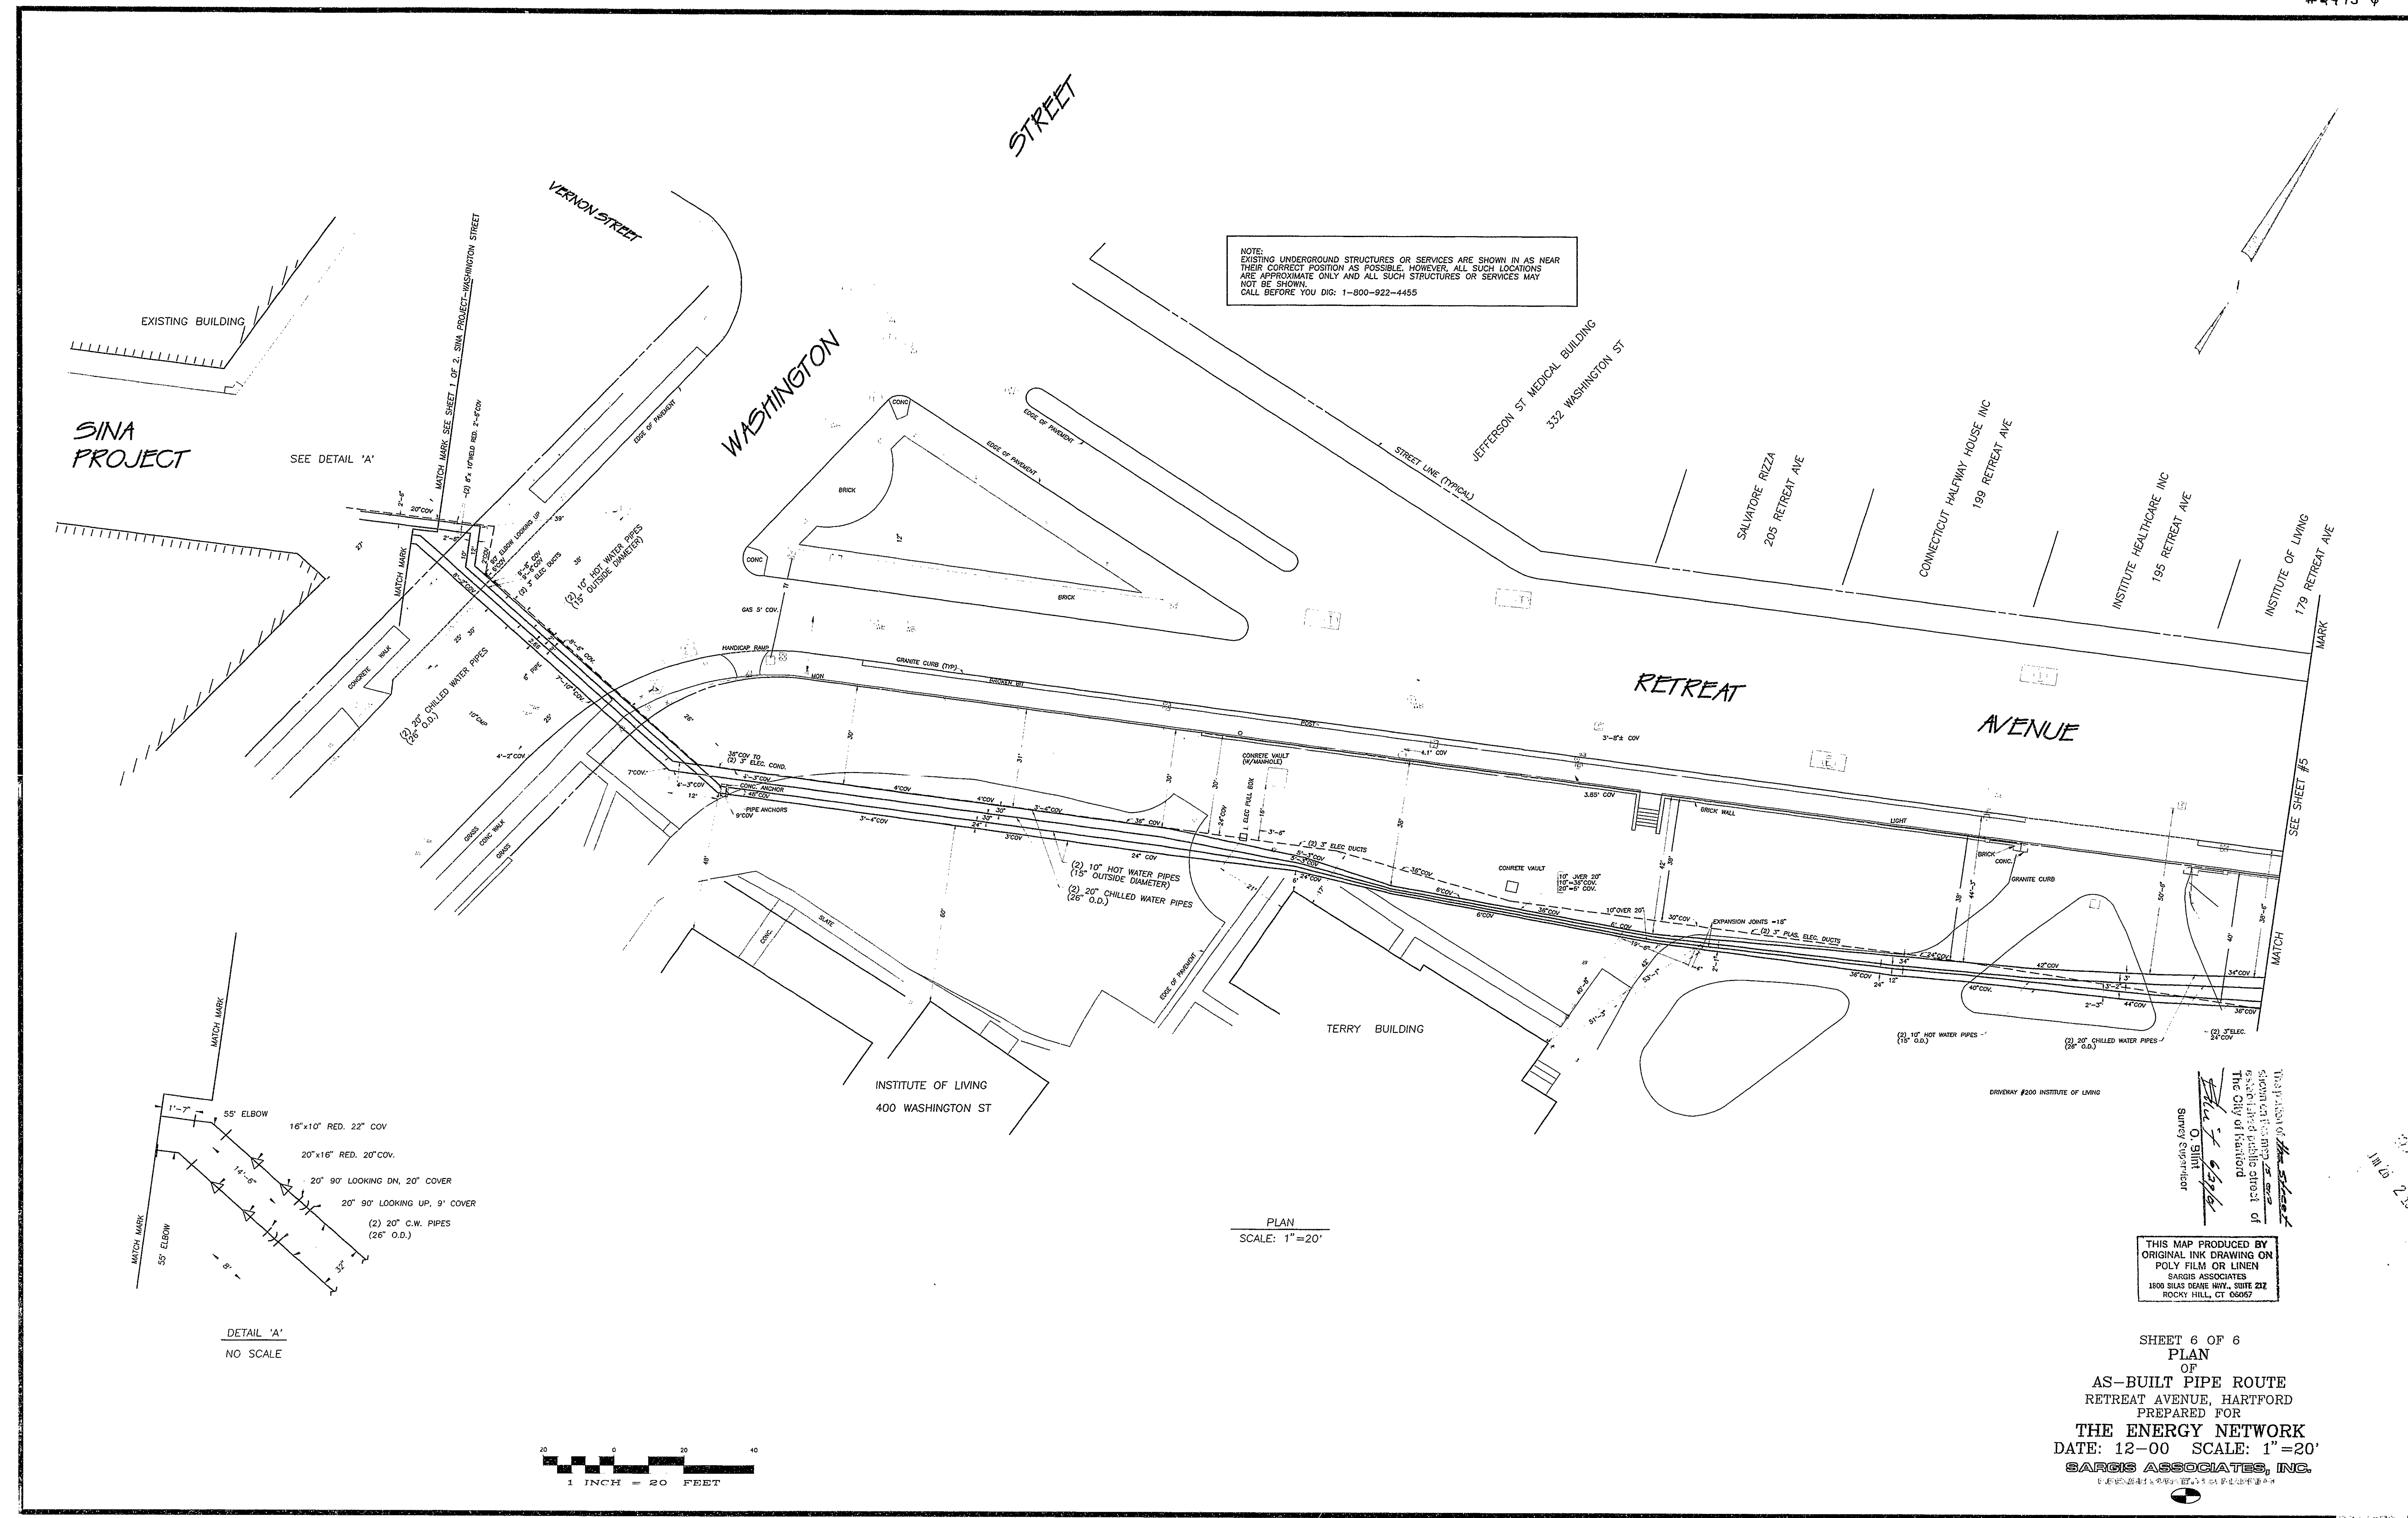

DETAIL 'A'
NO SCALE

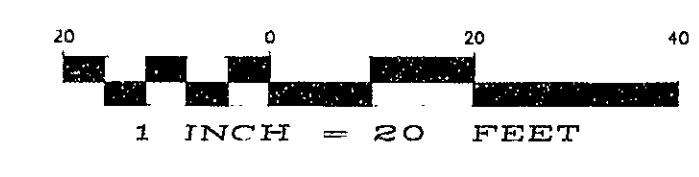

PLAN
SCALE: 1\"/>

THIS MAP PRODUCED BY
ORIGINAL INK DRAWING ON
POLY FILM OR LINEN
SARGIS ASSOCIATES
1800 SILAS DEANE HWY., SUITE 212
ROCKY HILL, CT 06067

SHEET 6 OF 6
PLAN
OF
AS-BUILT PIPE ROUTE
RETREAT AVENUE, HARTFORD
PREPARED FOR
THE ENERGY NETWORK
DATE: 12-00 SCALE: 1\"/>

