



#2473-1

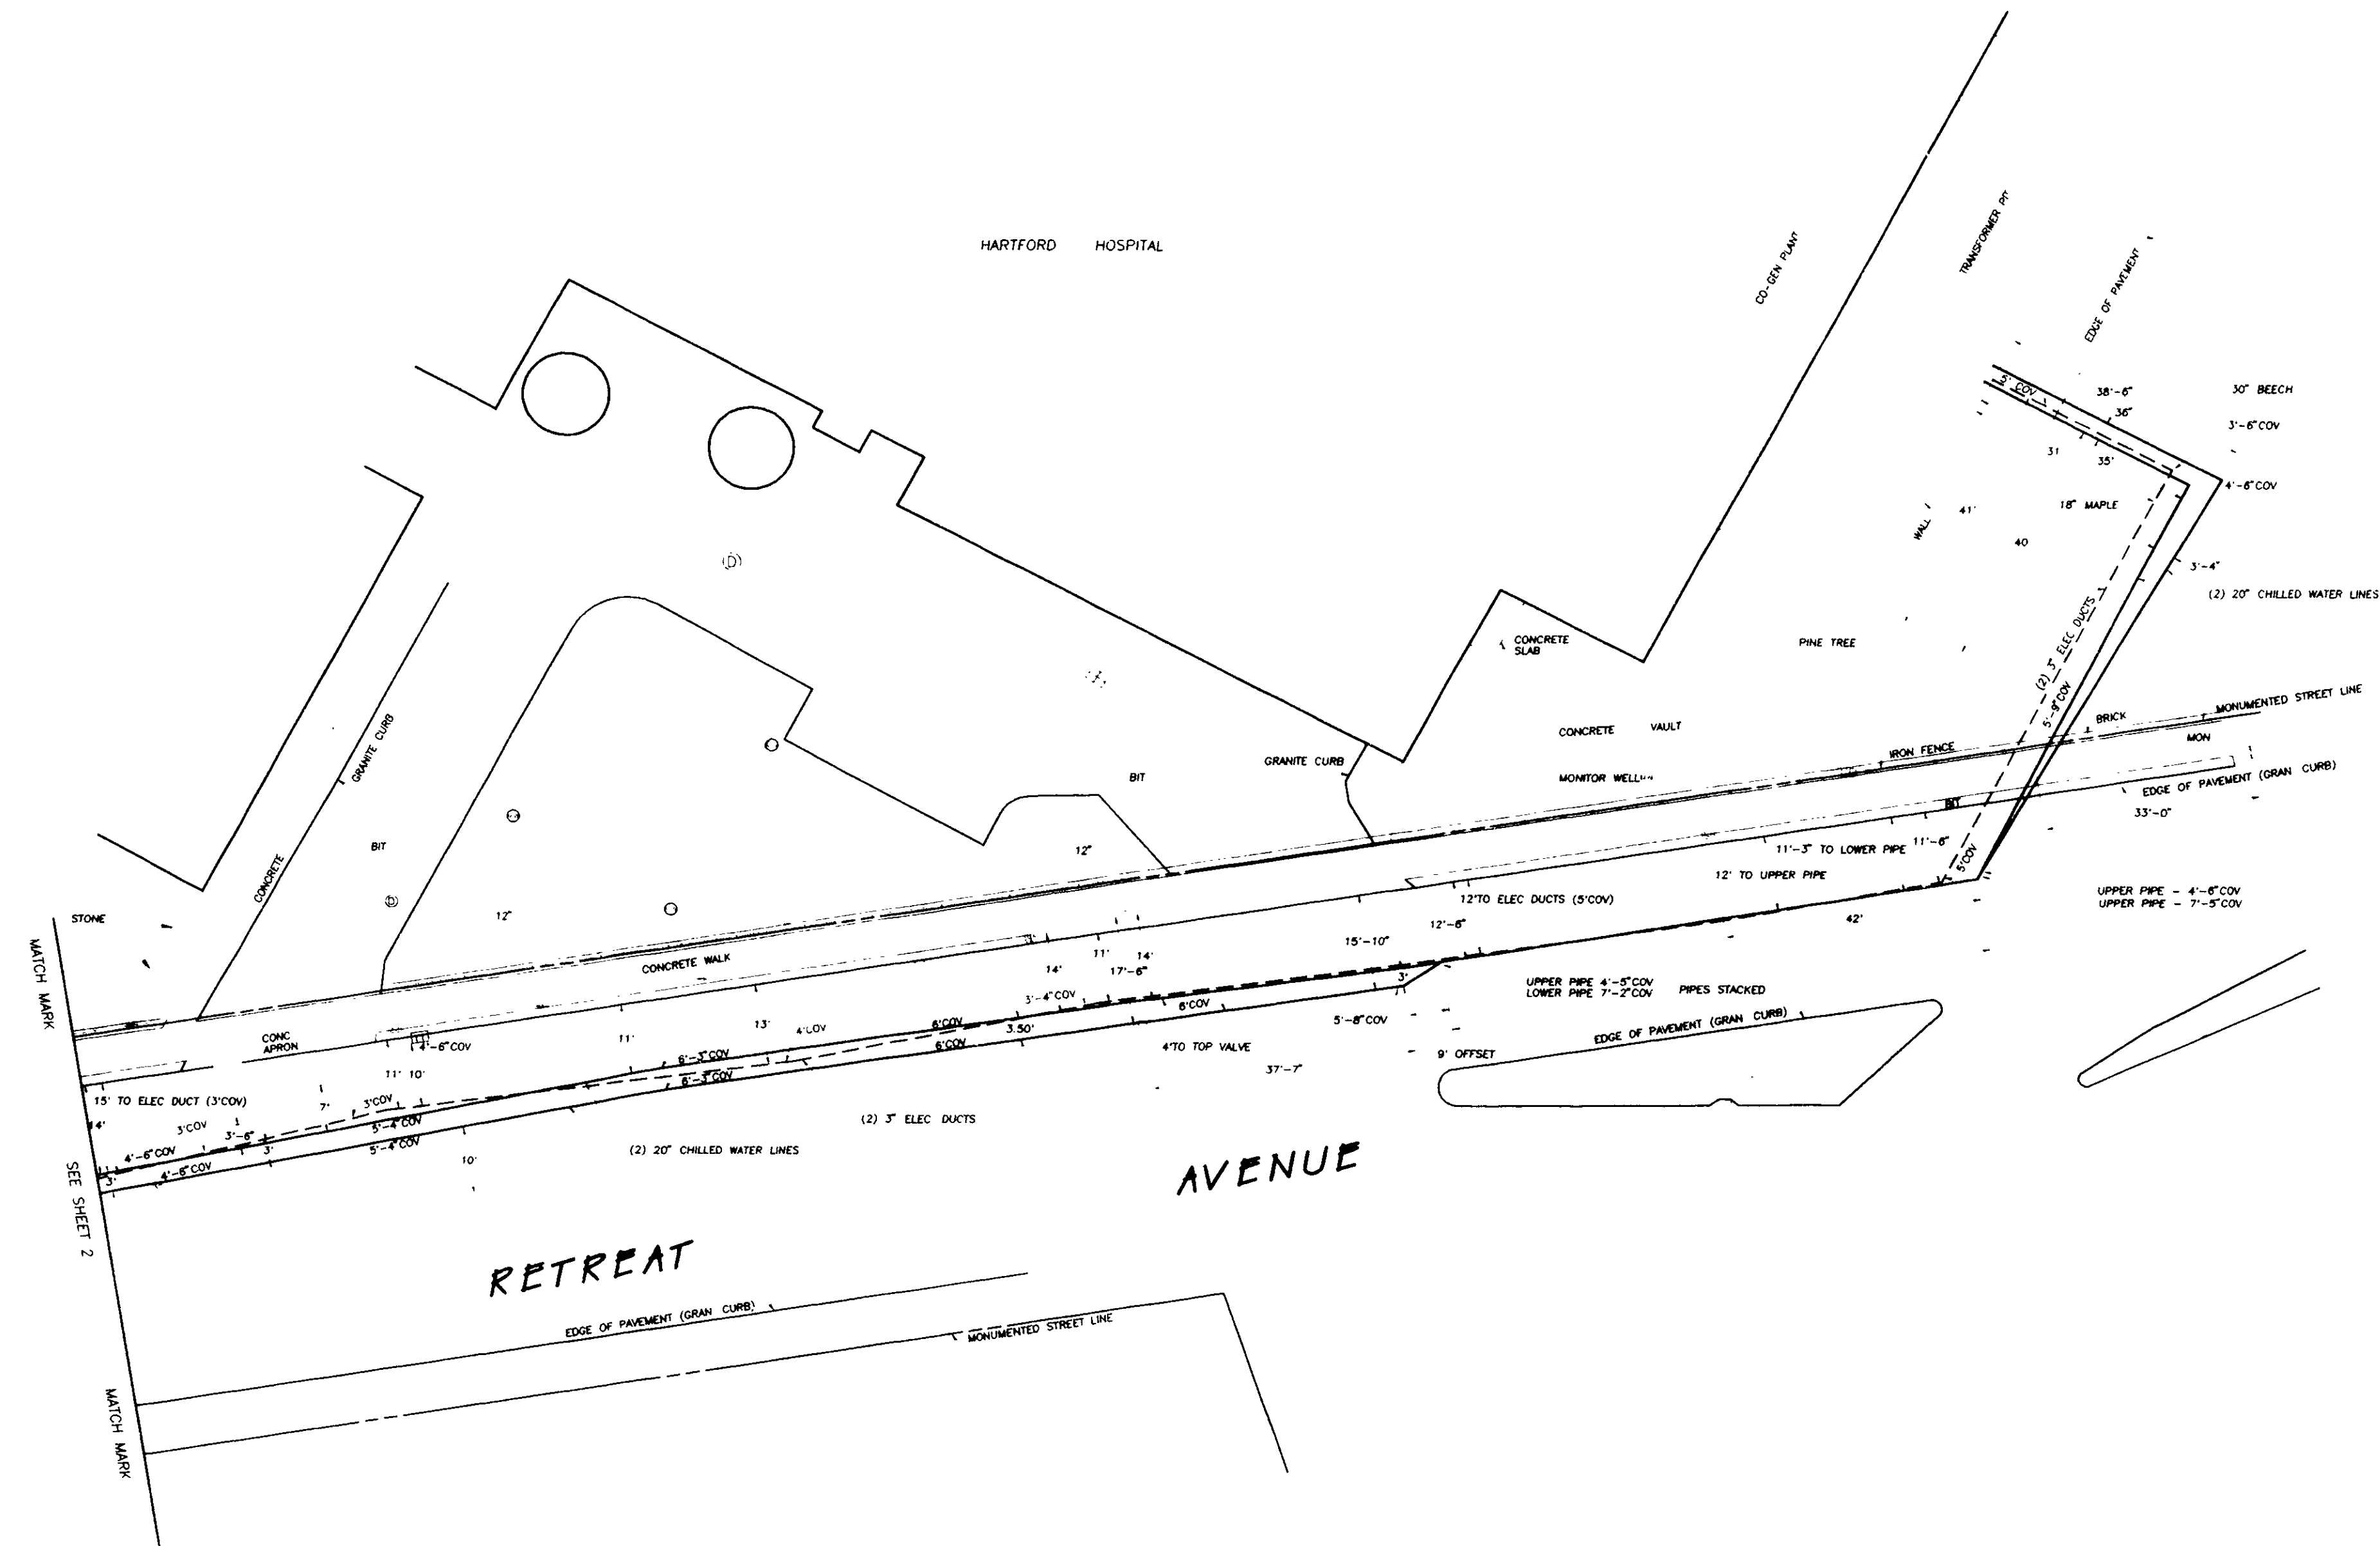

NOTE: EXISTING UNDERGROUND STRUCTURES OR SERVICES ARE SHOWN IN AS NEAR THEIR CORRECT POSITION AS POSSIBLE. HOWEVER, ALL SUCH LOCATIONS ARE APPROXIMATE ONLY, AND ALL SUCH STRUCTURES OR SERVICES MAY NOT BE SHOWN. FIELD TEST HOLES ARE RECOMMENDED TO VERIFY LOCATIONS. CALL BEFORE YOU DIG. 1-800-362-4455

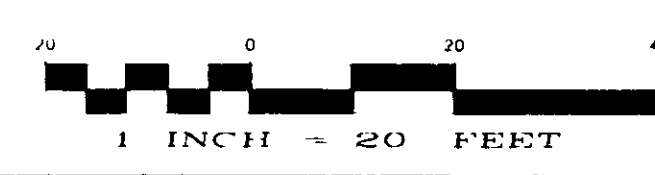

SHEET 1 OF 6
OF
AS-BUILT PIPE ROUTE
RETREAT AVENUE, HARTFORD
PREPARED FOR
THE ENERGY NETWORK
DATE: 12-00 SCALE: 1"=20'
SARGIS ASSOCIATES, INC.
1000 SHAS DRANE HWY., SUITE 217
WEST HAVEN, CT 06617

The portion of the street shown on this map is established public street of the City of Hartford.
JAN 20 2 15 PM '01
O. Blinn
Survey Supervisor

THIS MAP PRODUCED BY
ORIGINAL INK DRAWING ON
POLY FILM OR LINEN
SARGIS ASSOCIATES
1000 SHAS DRANE HWY., SUITE 217
WEST HAVEN, CT 06617

2473-1