
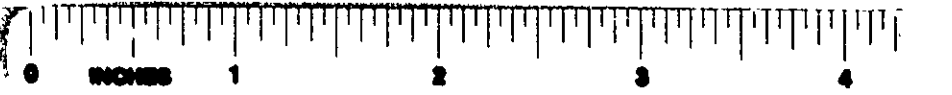


The portion of the street shown on this map is a part of established public street of the City of Hartford
[Signature]
 O. Blunt
 Survey Supervisor

THIS MAP PRODUCED BY
 ORIGINAL INK DRAWING ON
 POLY FILM OR LINEN
 SARGIS ASSOCIATES
 1800 SHAW NEAR HWY. ROUTE 217
 ROCKY HILL, CT 06067

SHEET 3 OF 6
 OF
 AS-BUILT PIPE ROUTE
 RETREAT AVENUE, HARTFORD
 PREPARED FOR
THE ENERGY NETWORK
 DATE: 12-00 SCALE: 1"=20'
SARGIS ASSOCIATES, INC.

NOTE:
 EXISTING UNDERGROUND STRUCTURES OR SERVICES ARE SHOWN IN AS NEAR THEIR CORRECT POSITION AS POSSIBLE. HOWEVER, ALL SUCH LOCATIONS ARE APPROXIMATE ONLY AND ALL SUCH STRUCTURES OR SERVICES MAY NOT BE SHOWN. FIELD TEST HOLES ARE RECOMMENDED TO VERIFY LOCATIONS. CALL BEFORE YOU DIG. 1-800-522-4455

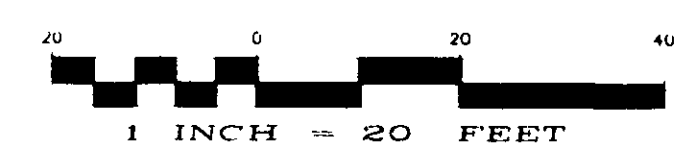

DATE: 12-00
 SHEET: 3
 OF: 6
 DRAWING NO: 2473-3