



#2473-5

NOTE:
EXISTING UNDERGROUND STRUCTURES OR SERVICES ARE SHOWN IN AS NEAR
THEIR CORRECT POSITION AS POSSIBLE. HOWEVER, ALL SUCH LOCATIONS
ARE APPROXIMATE ONLY AND ALL SUCH STRUCTURES OR SERVICES MAY
NOT BE SHOWN.

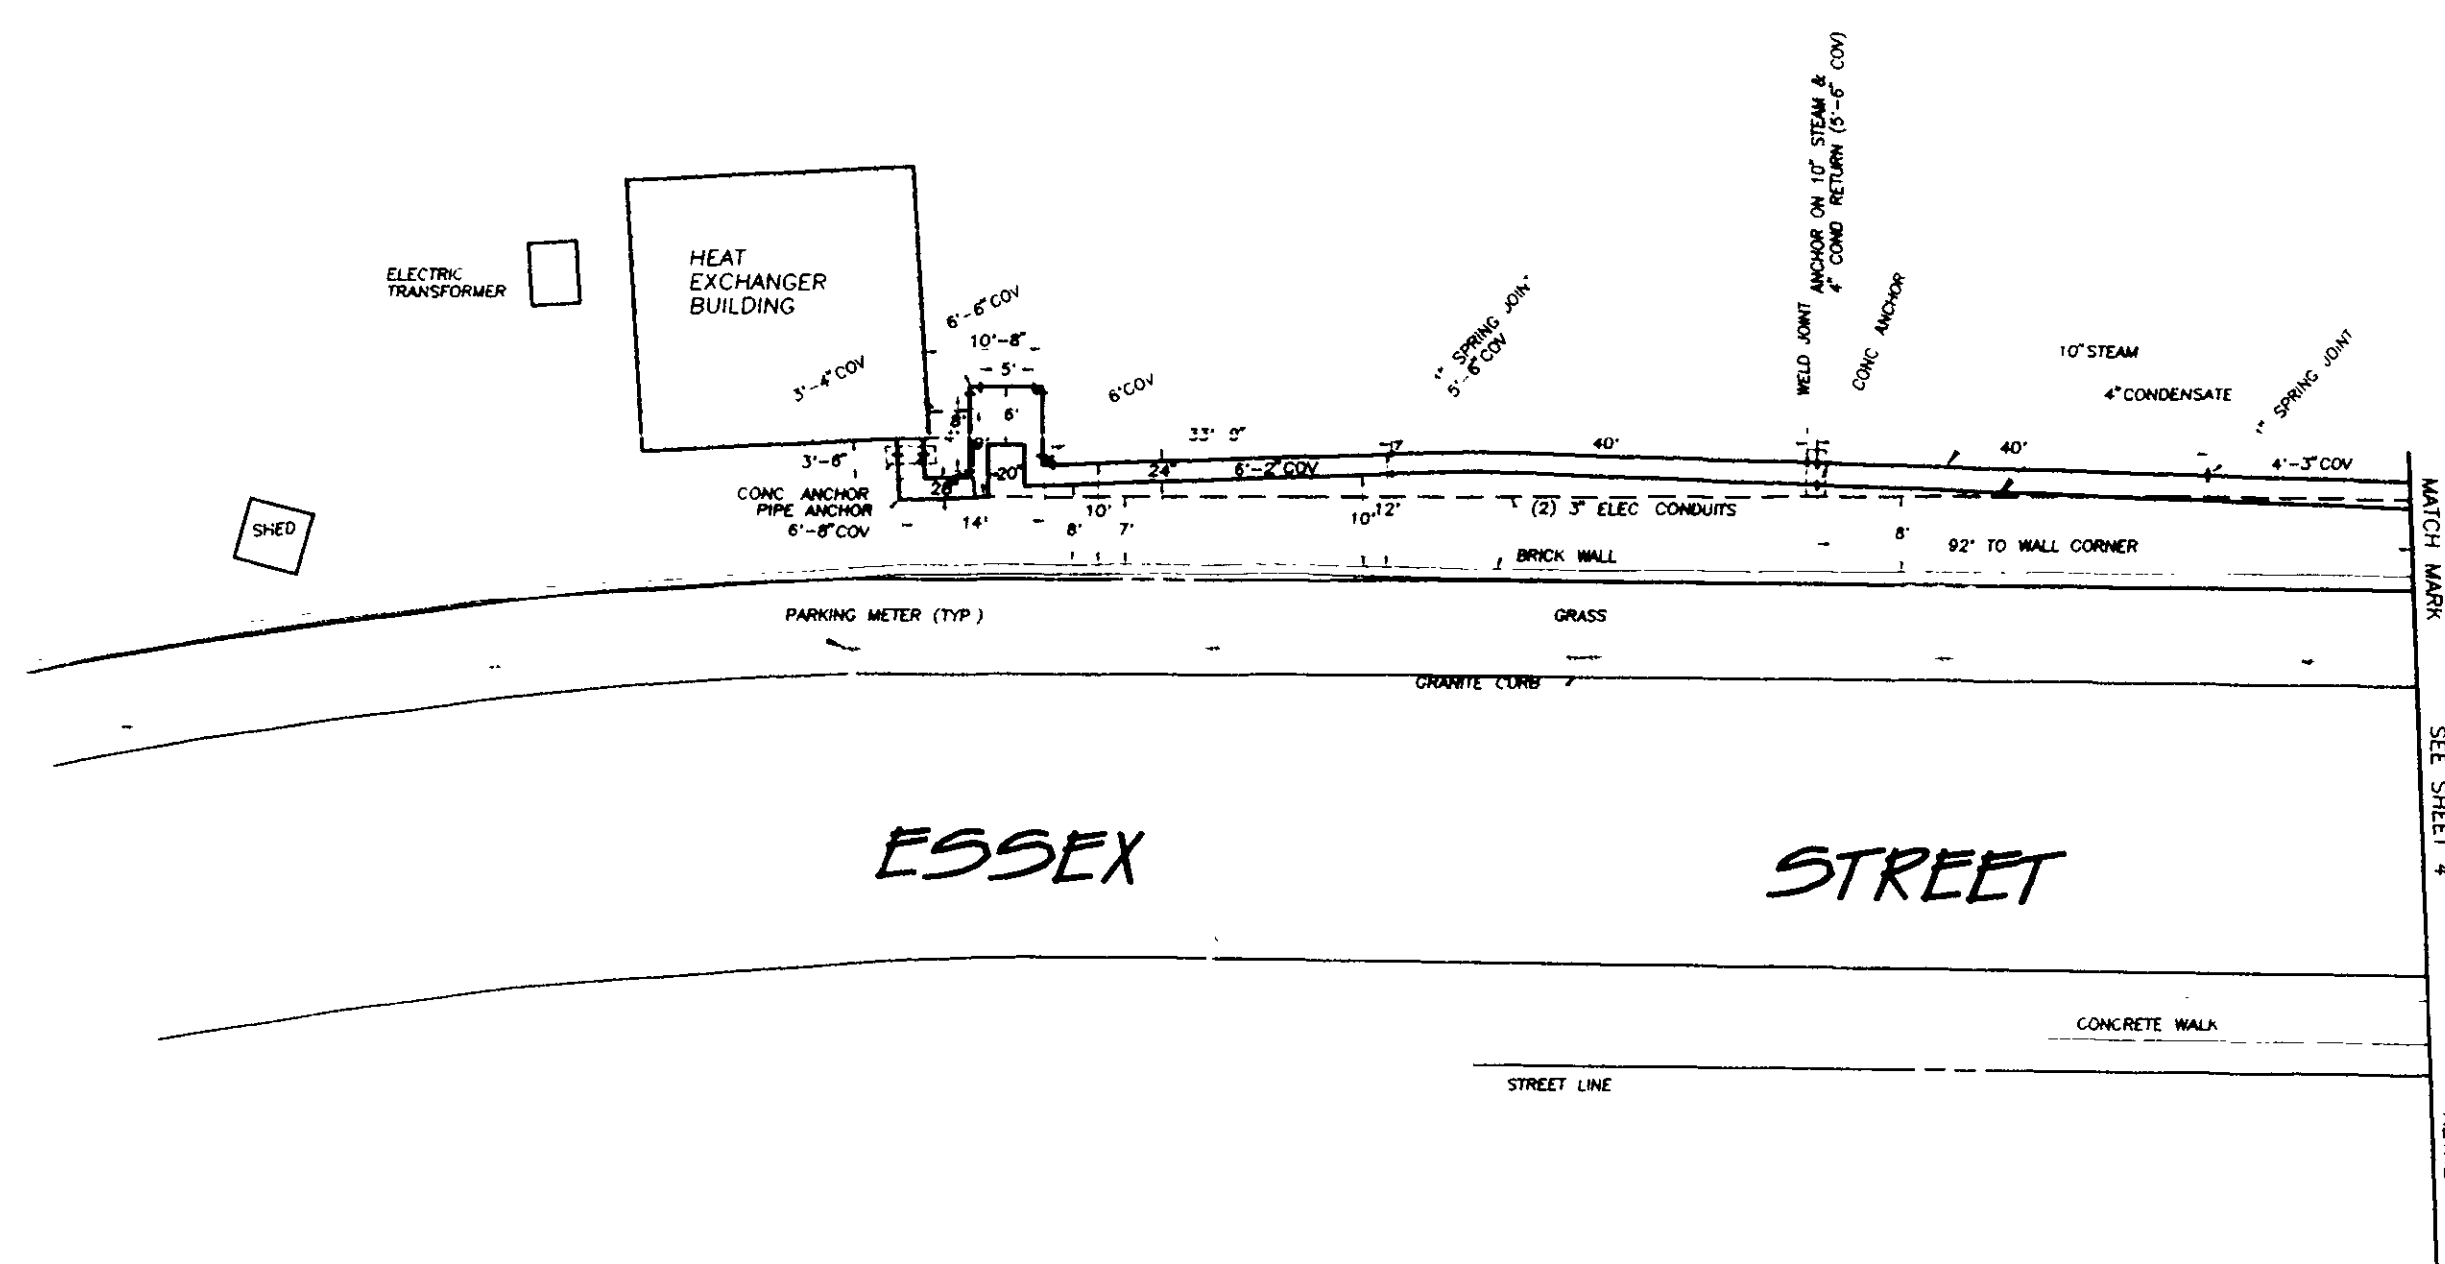

10" STEAM \ 4" CONDENSATE RETURN \ ELECTRICAL CONDUIT
SCALE 1"=20'

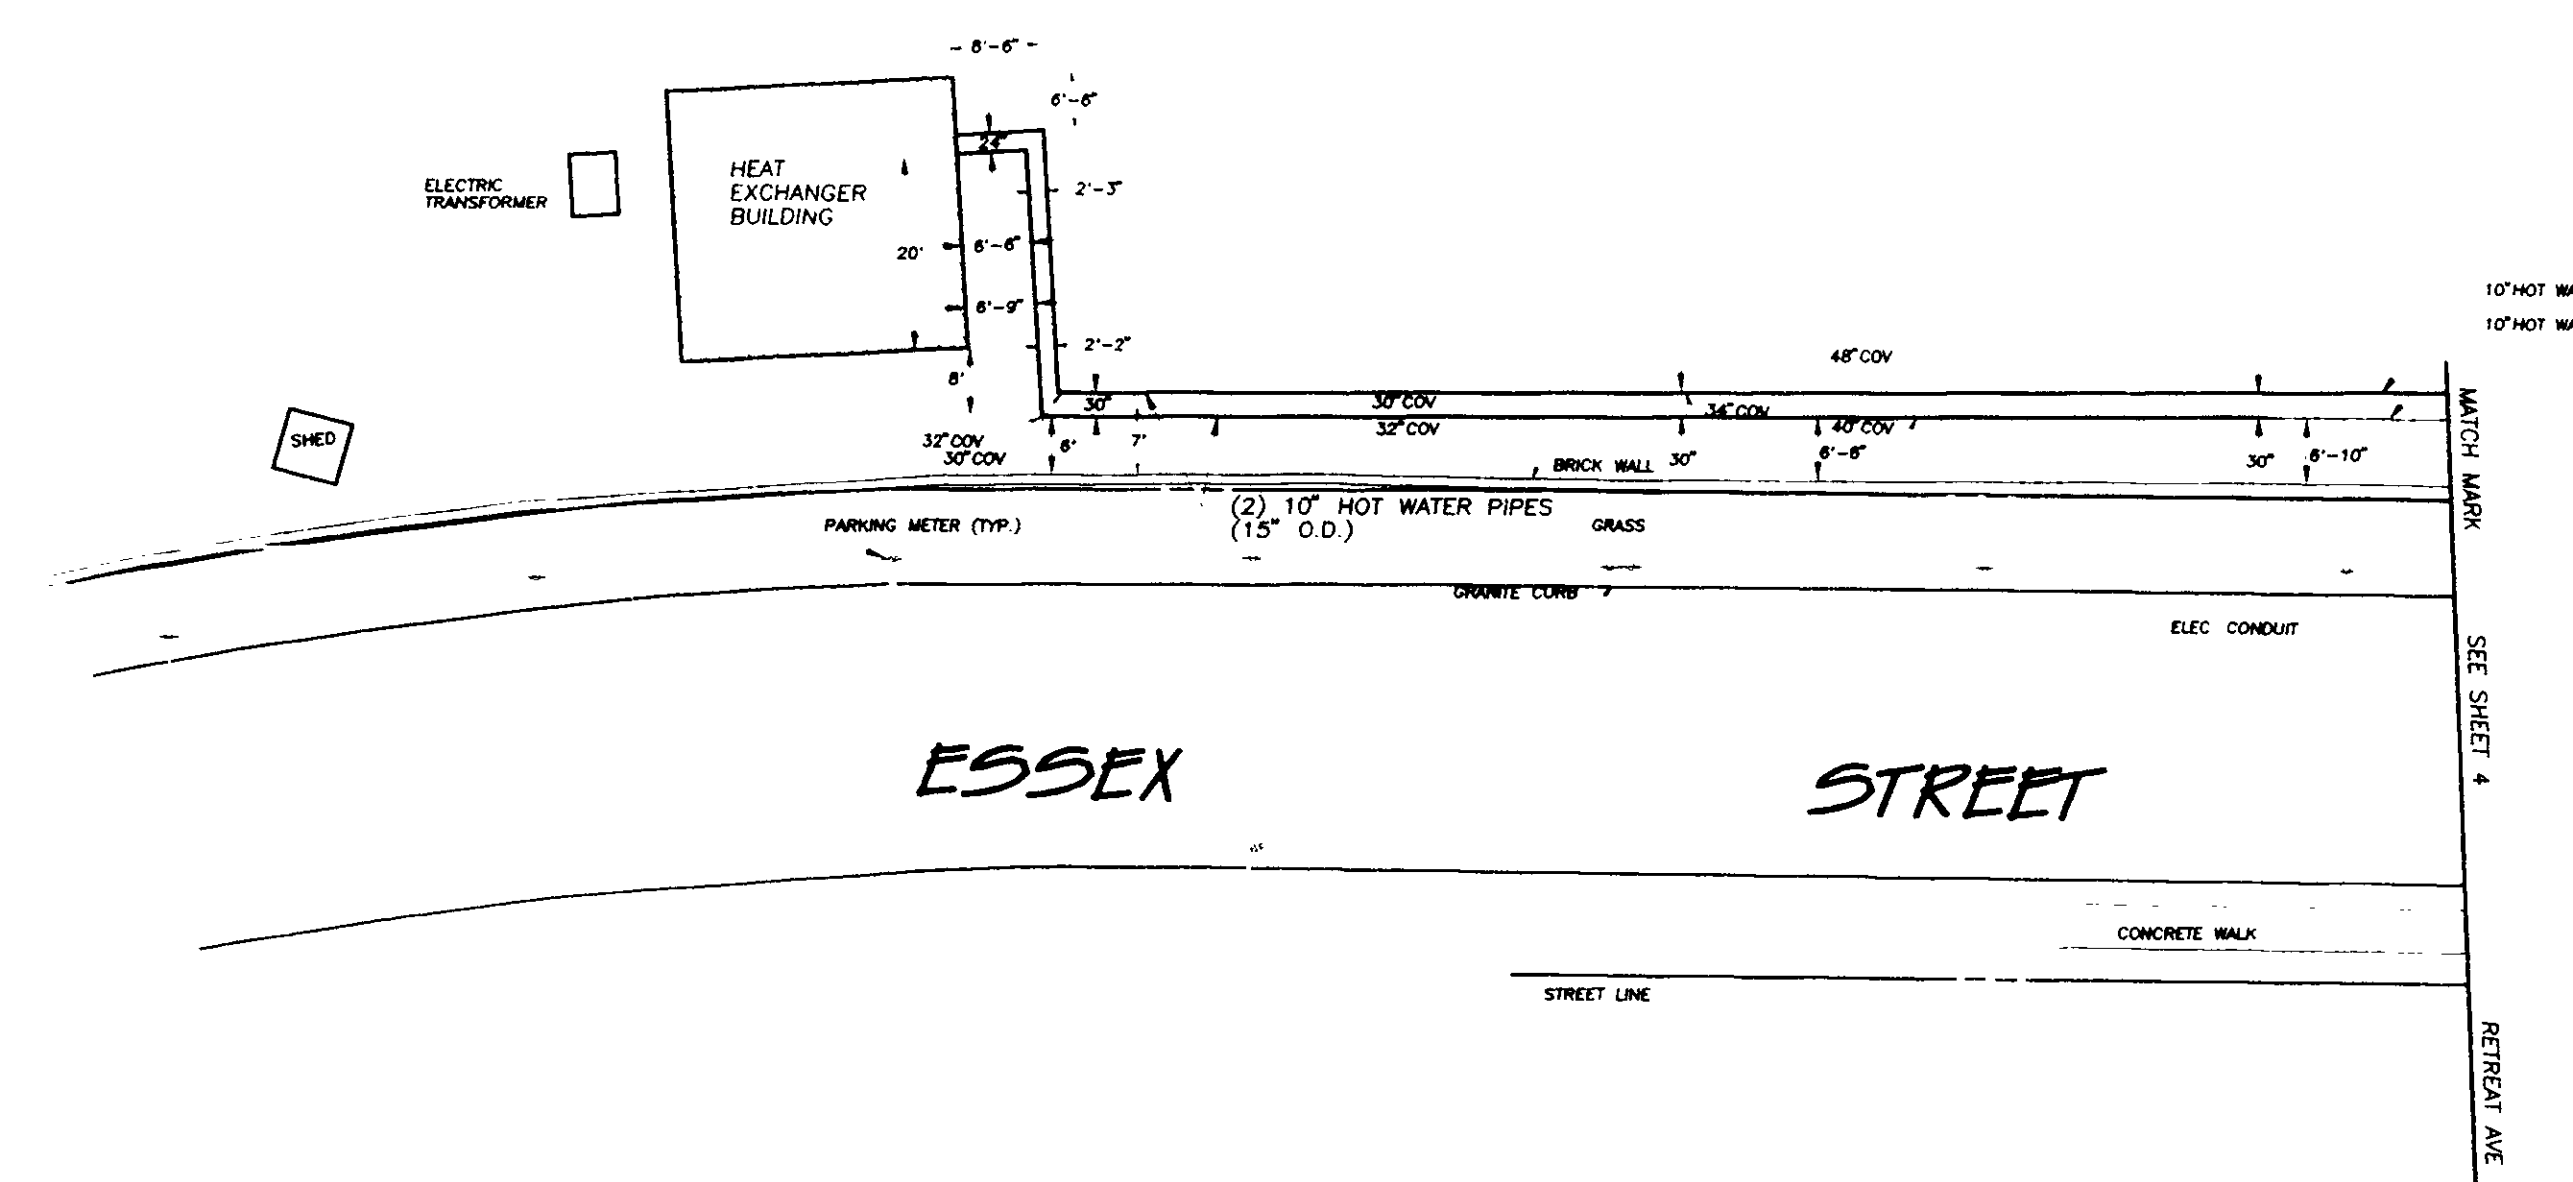

10" HOT WATER PIPES
SCALE 1"=20'

The portion of the street
shown on this map is an
established public street of
The City of Hartford
Survey Supervisor
O. Blinn

THIS MAP PRODUCED BY
ORIGINAL INK DRAWING ON
POLY FILM OR LINEN
SARGIS ASSOCIATES
1000 SILENT TRAIL HWY., SUITE 202
HARTFORD, CT 06107

SHEET 5 OF 6
PLAN
OF
AS-BUILT PIPE ROUTE
ESSEX STREET, HARTFORD
PREPARED FOR
THE ENERGY NETWORK
DATE: 10-00 SCALE: AS SHOWN
SARGIS ASSOCIATES, INC.

#2473-5



DATE FILED: 10-00-00
BY: 2473-5