


2501-1

#2501-1

NOTES

1. THE LOCATION OF PHYSICAL FEATURES WHICH ARE SHOWN ON THIS PLAN PICTORIALLY ONLY AND WITHOUT DIMENSIONS WERE VERIFIED BY OBSERVATIONS AND SELECTED MEASUREMENTS AT THE SITE. THE LOCATION OF THESE PHYSICAL FEATURES WERE NOTED DURING OCTOBER 1974 AND ARE SUBJECT TO NORMAL CONSTRUCTION TOLERANCES AS TO PLACEMENT.
2. ELEVATIONS REFER TO METROPOLITAN DISTRICT COMMISSION DATUM.

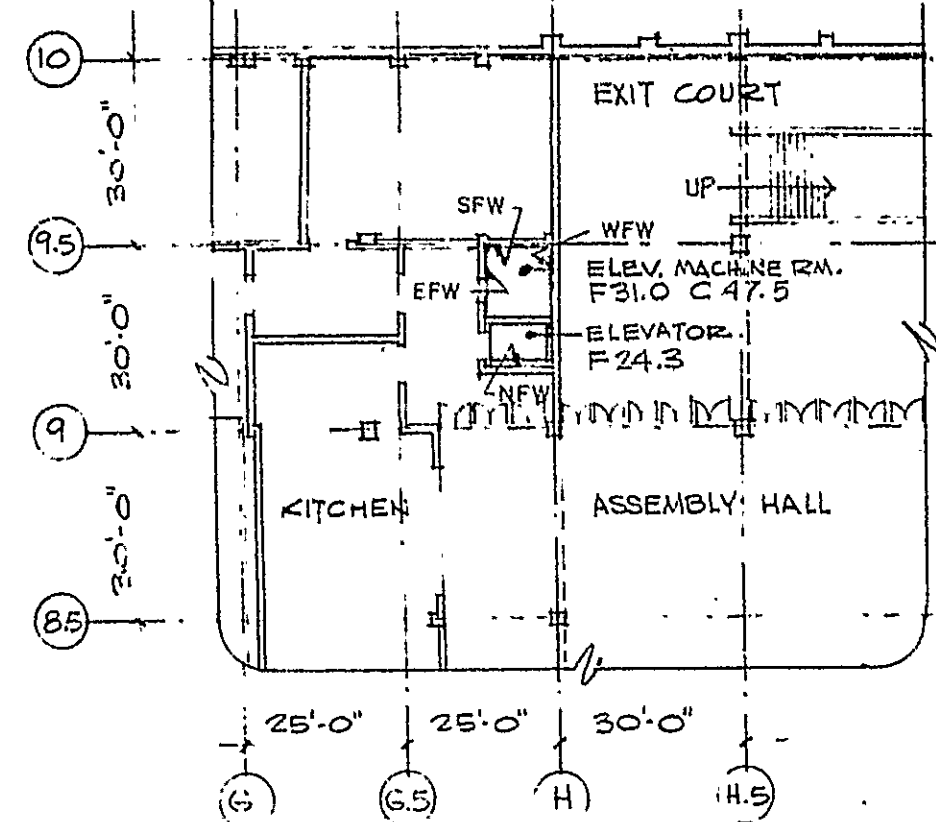

PART PLAN - LEVEL 31

CREST GRAPHICS
FIXED LINE MYLAR

AS-BUILT REVISIONS AS OF MAY 1, 1985	
THE HARTFORD CENTER HARTFORD, CONN	
HEWITT ENGINEERING P.C. Engineers and Surveyors Berlin, Connecticut	
DATE: MAY 1, 1985	PROJECT NO. 85041
DRAWN & CHECKED BY: JCE	SHEET NO. 1 OF 3


I hereby certify that all the items indicated by the symbol Δ are items added or modified on this existing map by my office on or about May 1, 1985.

Roderick D. Hewitt L.S. #8432
Certificate date 10/01/01


LEGEND
NFW NORTH FACE WALL
SFW SOUTH FACE WALL
EFW EAST FACE WALL
WFW WEST FACE WALL

I HEREBY CERTIFY THAT THIS PLAN IS SUBSTANTIALLY CORRECT AND THAT THE LEASEHOLD PROPERTY LINE IS IN ACCORDANCE WITH CLASS A-2 OF THE CODE OF CONNECTICUT TECHNICAL COUNCIL, INC. AND ALL OTHER MEASUREMENTS ARE IN ACCORDANCE WITH NOTE 1 ABOVE.


Roderick D. Hewitt
REGISTERED LAND SURVEYOR

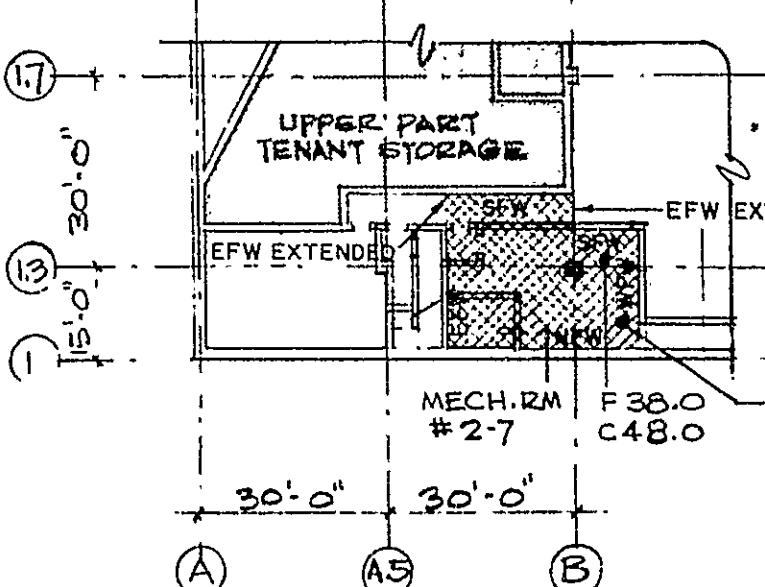

PART PLAN - LEVEL 38

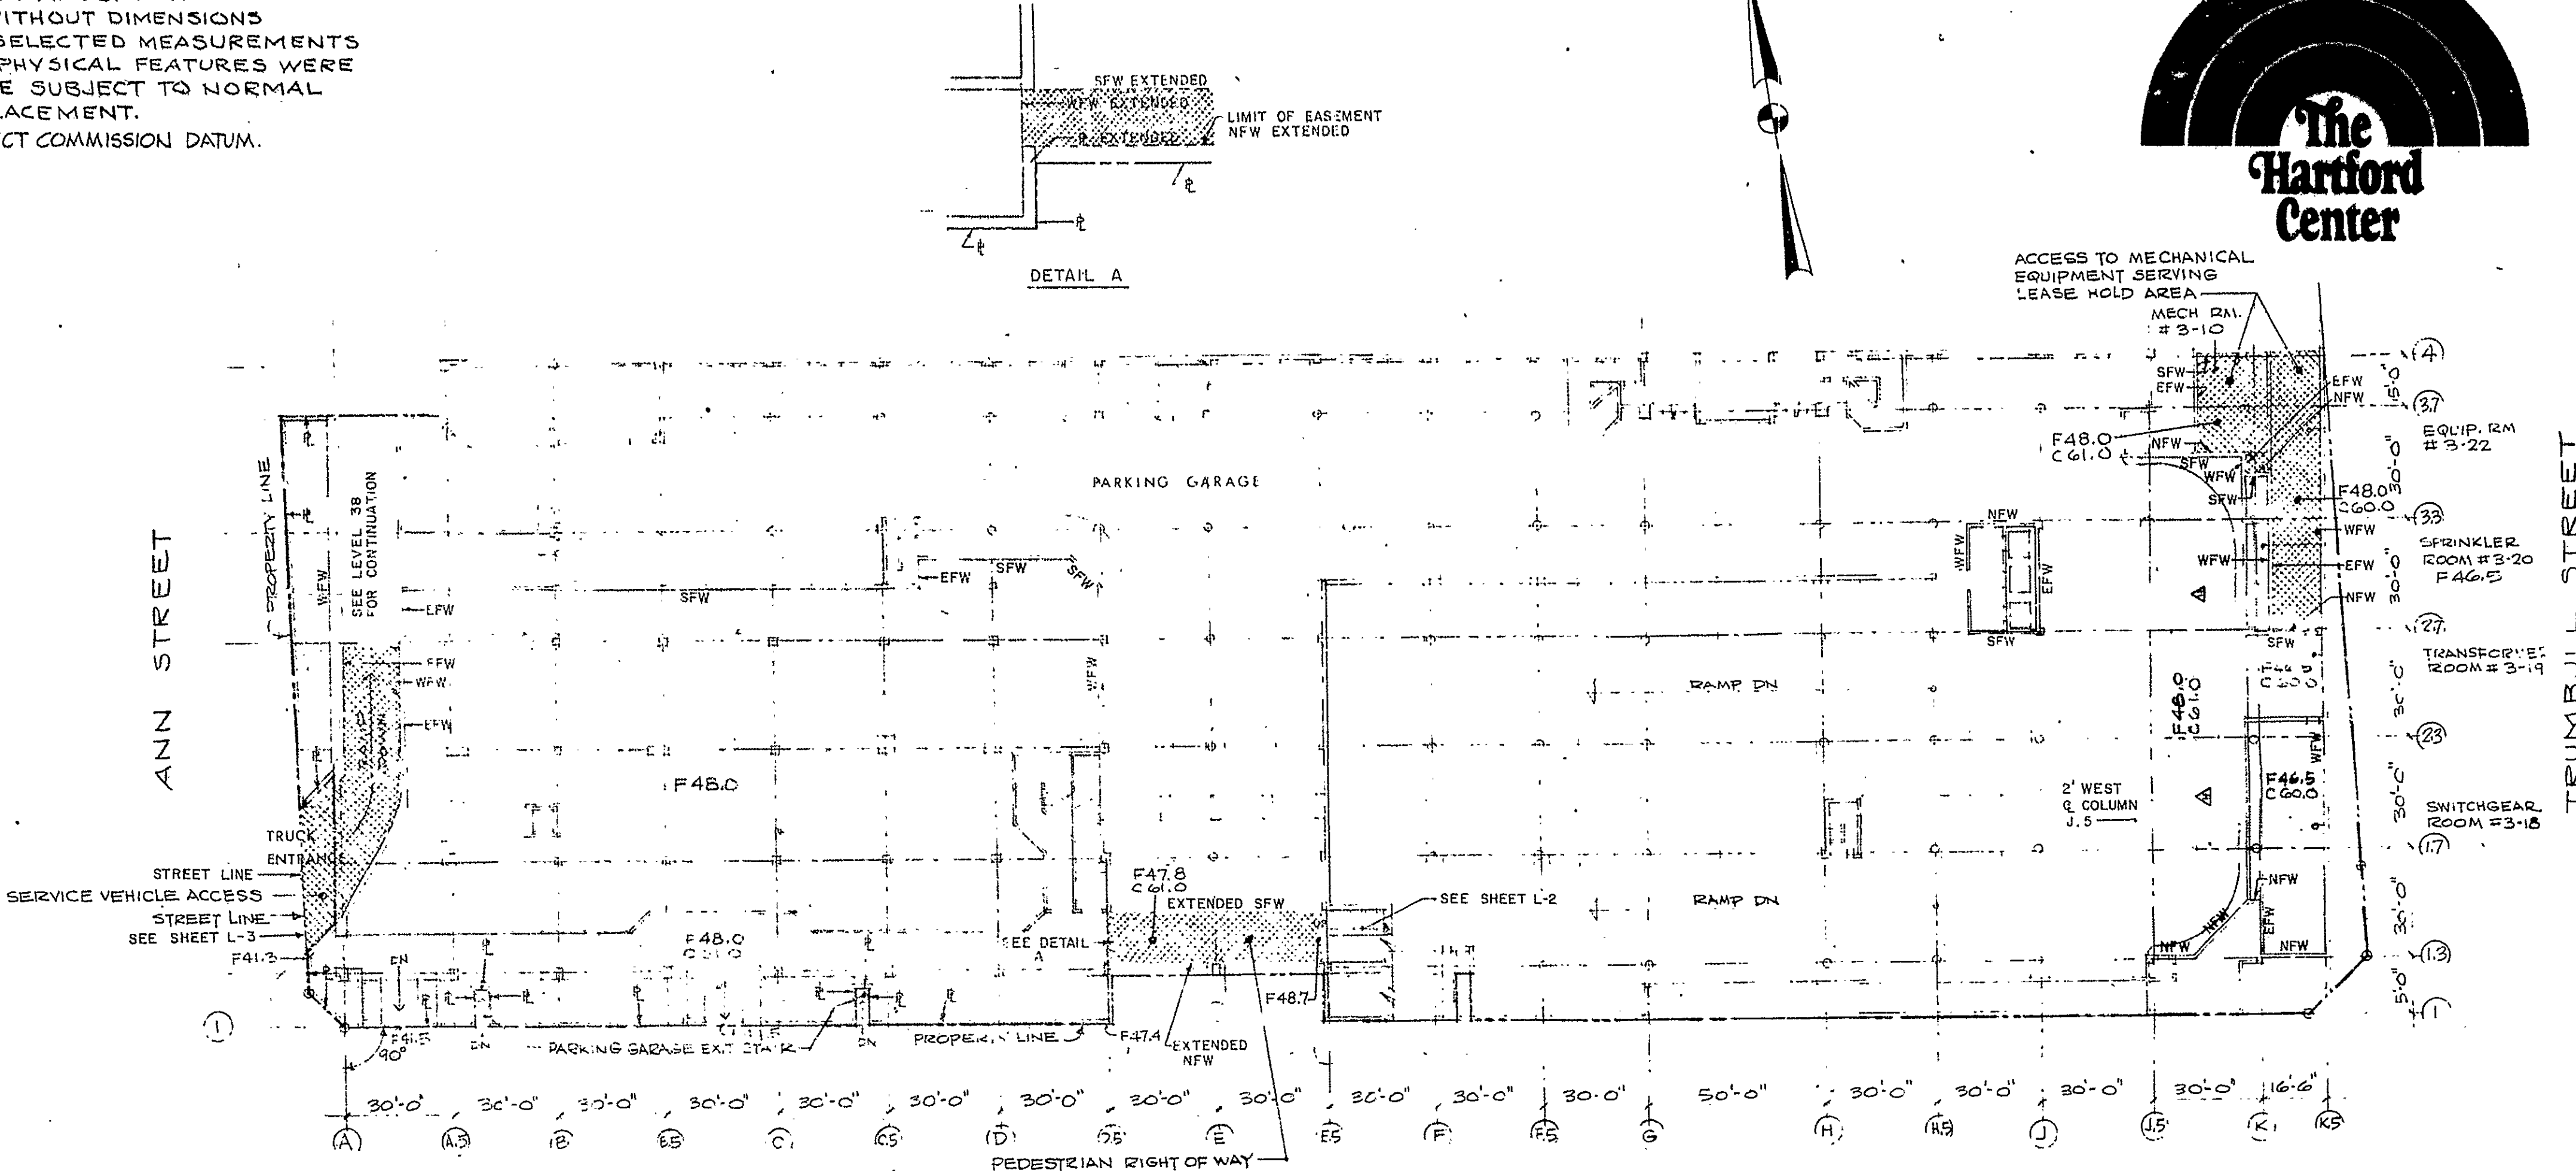

PLAN - LEVEL 48

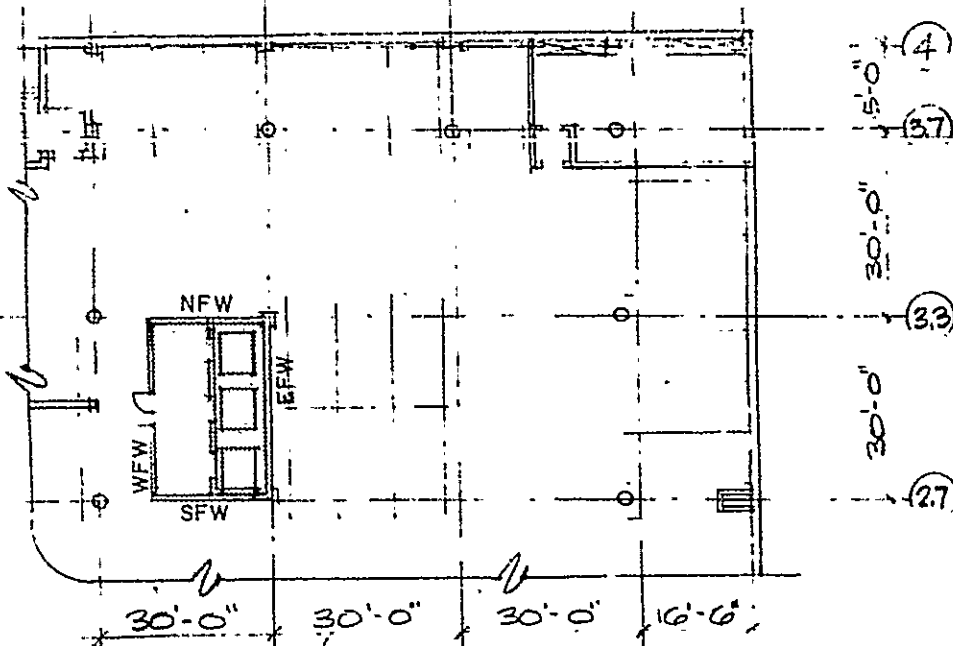

PART PLAN - LEVEL 38

LEGEND
PROPERTY OF CITY OF HARTFORD
AETNA LEASEHOLD AREA
AETNA EASEMENT ON CITY PROPERTY
F 00.0 BOTTOM LIMITING ELEVATION OF LEASEHOLD OR EASEMENT AREA (NORMAL FLOOR ELEVATION)
C 00.0 TOP LIMITING ELEVATION OF LEASEHOLD OR EASEMENT AREA
P PROPERTY LINE. SEE 80 LEVEL PLAN SHEET L-3 FOR BOUNDARY DESCRIPTION.

LEASEHOLD & EASEMENT PLAN
LEVELS 23.5, 31, 38, & 48

THE HARTFORD CENTER
HARTFORD CONNECTICUT

0 50 FT SCALE 1" = 32 FT 16 SEP 74

REVISED NOV. 14, 1974
MORTON S. FINE AND ASSOCIATES
711 Cottage Grove Rd. Bloomfield, Conn.
Engineers Landscape Architects Surveyors

DAYBOOK No. 010426A

L1

0 INCHES 1 2 3 4