



#2504

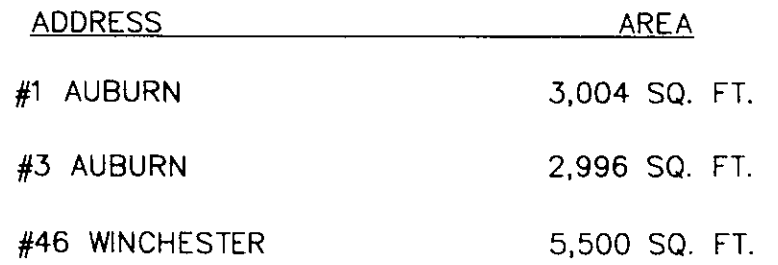

N/F WILLIAM H. & GERALDINE LOGAN
TOTAL PARCEL AREA = 11,500 SQ. FT.

ORIGINAL LINK
ON CYLAR
DRAWING

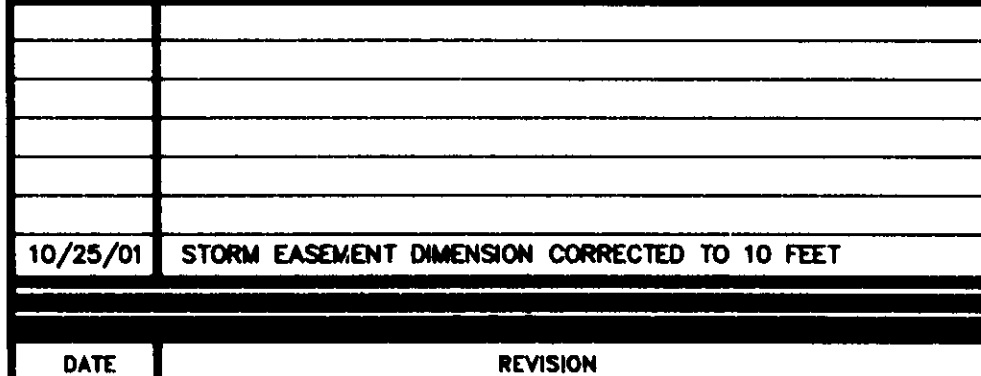

and associates, Inc.

AS-BUILT SURVEY
PREPARED FOR
HABITAT FOR HUMANITY
46 WINCHESTER ST. , 1 & 3 AUBURN ST.
HARTFORD - CONNECTICUT

• 111 PROSPECT HILL ROAD • WINDSOR, CT 06095 • (203) 688-2413

SCALE: 1 IN. = 20 FT

DECEMBER 14, 1999

#2504

