


2602-4

#2602-4

MAP REFERENCE:

MAP ENTITLED, "SUBDIVISION PLAN REDEVELOPMENT OF HARRIET BEECHER STOWE VILLAGE FOR THE HOUSING AUTHORITY OF THE CITY OF HARTFORD, CONNECTICUT CM DEVELOPMENT TEAM, LLC SCALE: 1"=40' DATE: 7-9-99 SHEETS C-1 THRU C-5 PETER D. FLYNN L.S.

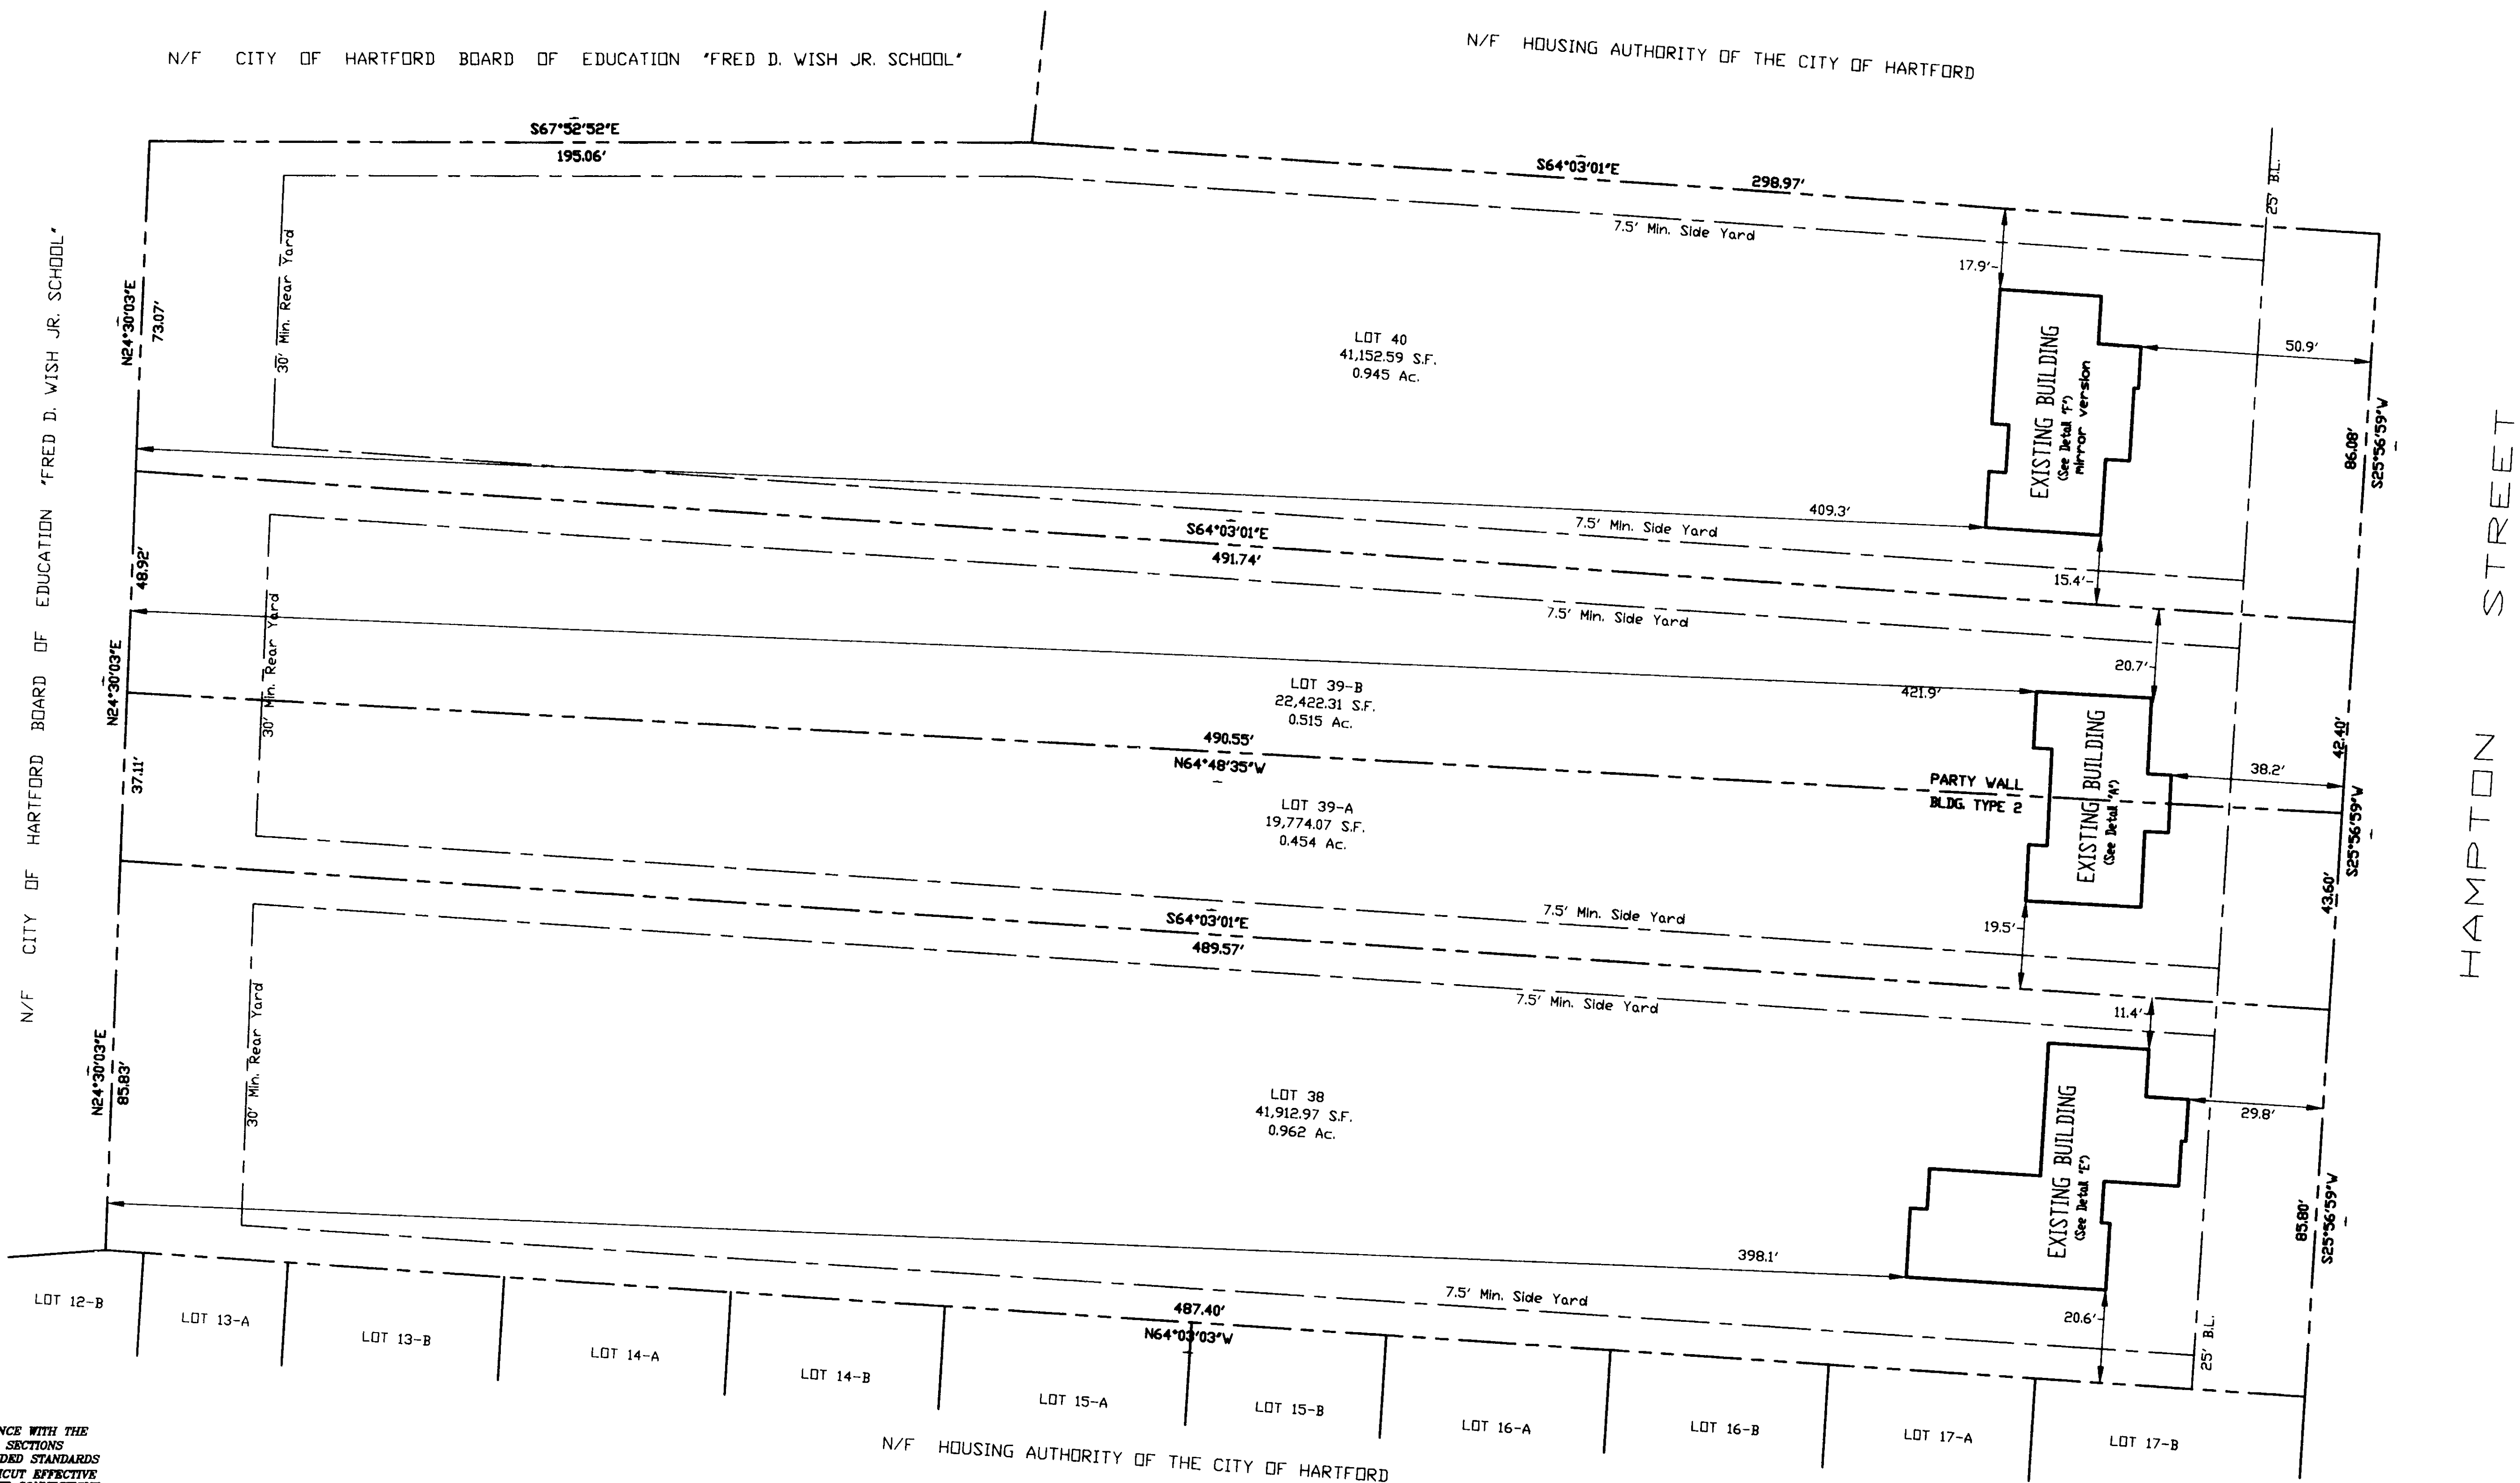

REGULATIONS FOR R-4 ZONE

ITEM	REQUIRED
MIN. LOT AREA	6,000 S.F.
MIN. FRONTAGE	50'
MIN. FRONT YARD	25'
MIN. SIDE YARD	7.5'
AGG. SIDE YARD	15'
MIN. REAR YARD	30'

CERTIFICATION:

- THIS MAP AND SURVEY WERE PREPARED IN ACCORDANCE WITH THE REGULATIONS OF CONNECTICUT STATE AGENCIES, SECTIONS 20-300B-1 THRU 20-300B-20, AND THE RECOMMENDED STANDARDS FOR SURVEYS AND MAPS IN THE STATE OF CONNECTICUT EFFECTIVE SEPTEMBER 26, 1996 PREPARED AND ADOPTED BY THE CONNECTICUT ASSOCIATION OF LAND SURVEYORS, INC. PURSUANT TO AND AS SET FORTH THESE STANDARDS. THE TYPE OF SURVEY PERFORMED AND THE MAPPED FEATURES DEPICTED HEREON ARE IN ACCORDANCE WITH THE REQUIREMENTS OF A PROPERTY LOCATION SURVEY.
- PROPERTY LINES, AS THEY ARE DEPICTED HEREON, PRESENT PROFESSIONAL OPINIONS THAT PERTAIN TO AN "INDEPENDENT RESURVEY". THIS MAP PRESENTS THE RESULTS OF MEASUREMENTS WHICH WERE MADE UPON THE GROUND IN ACCORDANCE WITH THE ACCURACY STANDARDS OF A CLASS A-2 SURVEY.
- THIS MAP AND SURVEY WERE PREPARED FOR CM DEVELOPMENT TEAM, LLC. TO BE USED IN MATTERS THAT RELATE TO AS-BUILT CONDITIONS. USE OF THIS MAP FOR OTHER PURPOSES OR BY OTHER PARTIES IS NOT AUTHORIZED OR VALID.
- NO DECLARATION IS EXPRESSED OR IMPLIED BY THIS MAP OR COPIES THEREOF UNLESS IT BEARS THE IMPRESSION TYPE SEAL AND ORIGINAL LIVE SEAL AND ORIGINAL LIVE SIGNATURE OF THE SURVEYOR WHOSE NAME AND REGISTRATION NUMBER APPEAR BELOW. ANY CHANGES MADE TO THIS PLAN WITHOUT THE KNOWLEDGE OF THE SIGNERS INVALIDATES THESE DECLARATIONS.

TO THE BEST OF MY KNOWLEDGE AND BELIEF THIS MAP IS SUBSTANTIALLY CORRECT AS NOTED HEREON.

PETER D. FLYNN CT.L.S. #8792 DATE


NOT VALID UNLESS ORIGINAL SIGNATURE, LIVE STAMP, & RAISED SEAL ARE AFFIXED.

FLYNN & CYR LAND SURVEYING LLC
376 PELHAM CROSS HIGHWAY 686-7866
MIDDLETOWN, CONNECTICUT 06457



Flynn Land Surveying
Original Ink
Drawing on Mylar

BUILDING DETAIL

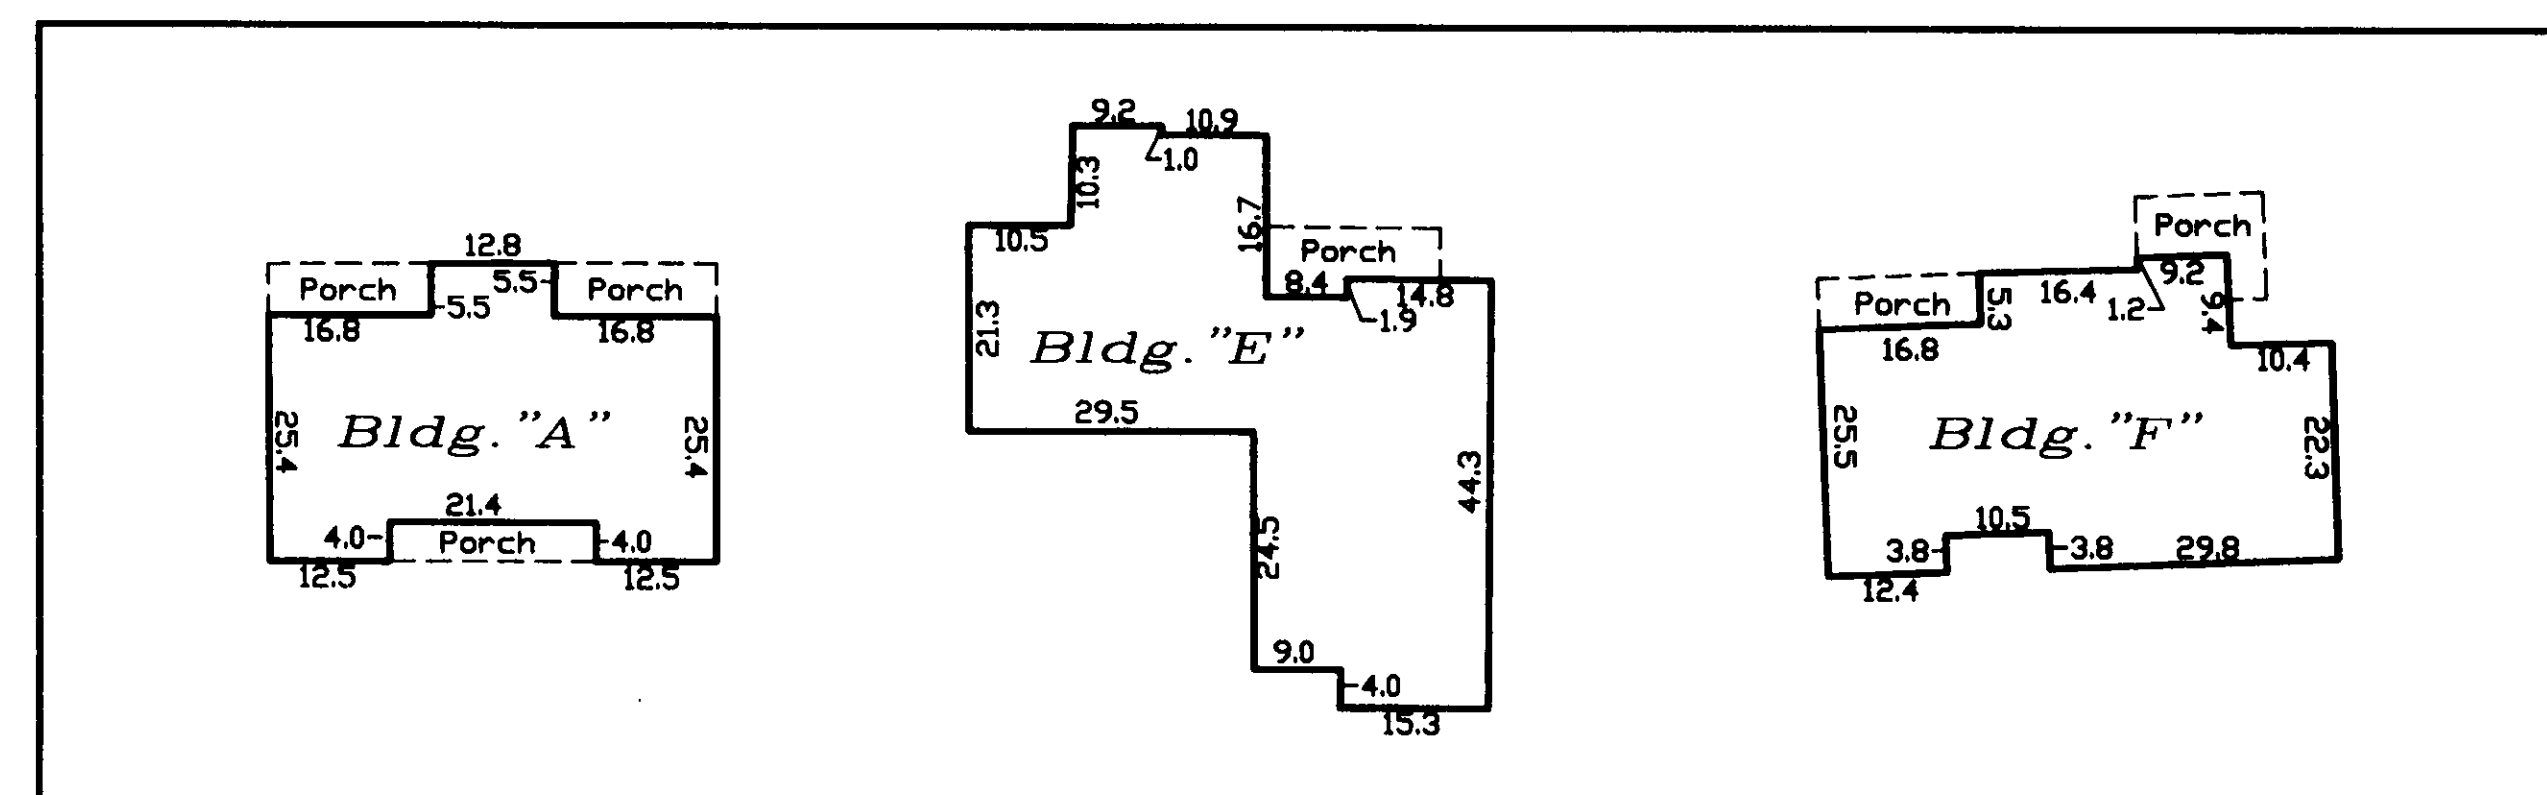


THE PORTION OF HAMPTON STREET SHOWN ON THIS MAP IS AN ESTABLISHED PUBLIC STREET OF THE CITY OF HARTFORD.

Diane A. Robert

AS-BUILT SURVEY OF
HARRIET BEECHER STOWE VILLAGE
PROPERTY OF
HOUSING AUTHORITY OF
THE CITY OF HARTFORD
PREPARED FOR
CM DEVELOPMENT TEAM, LLC
HAMPTON STREET
HARTFORD, CONNECTICUT
SCALE 1"=20' JUNE 23, 2003
SHEET NO. 4

GRAPHIC SCALE

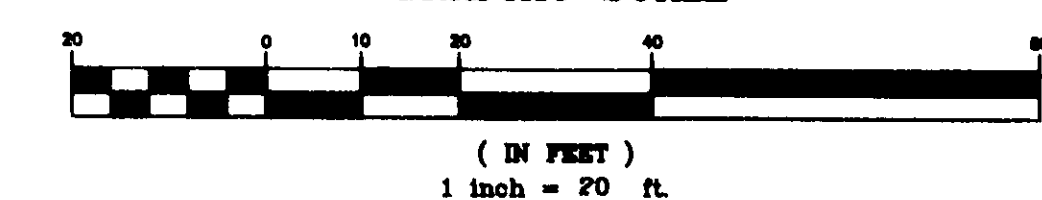

#2602-4