

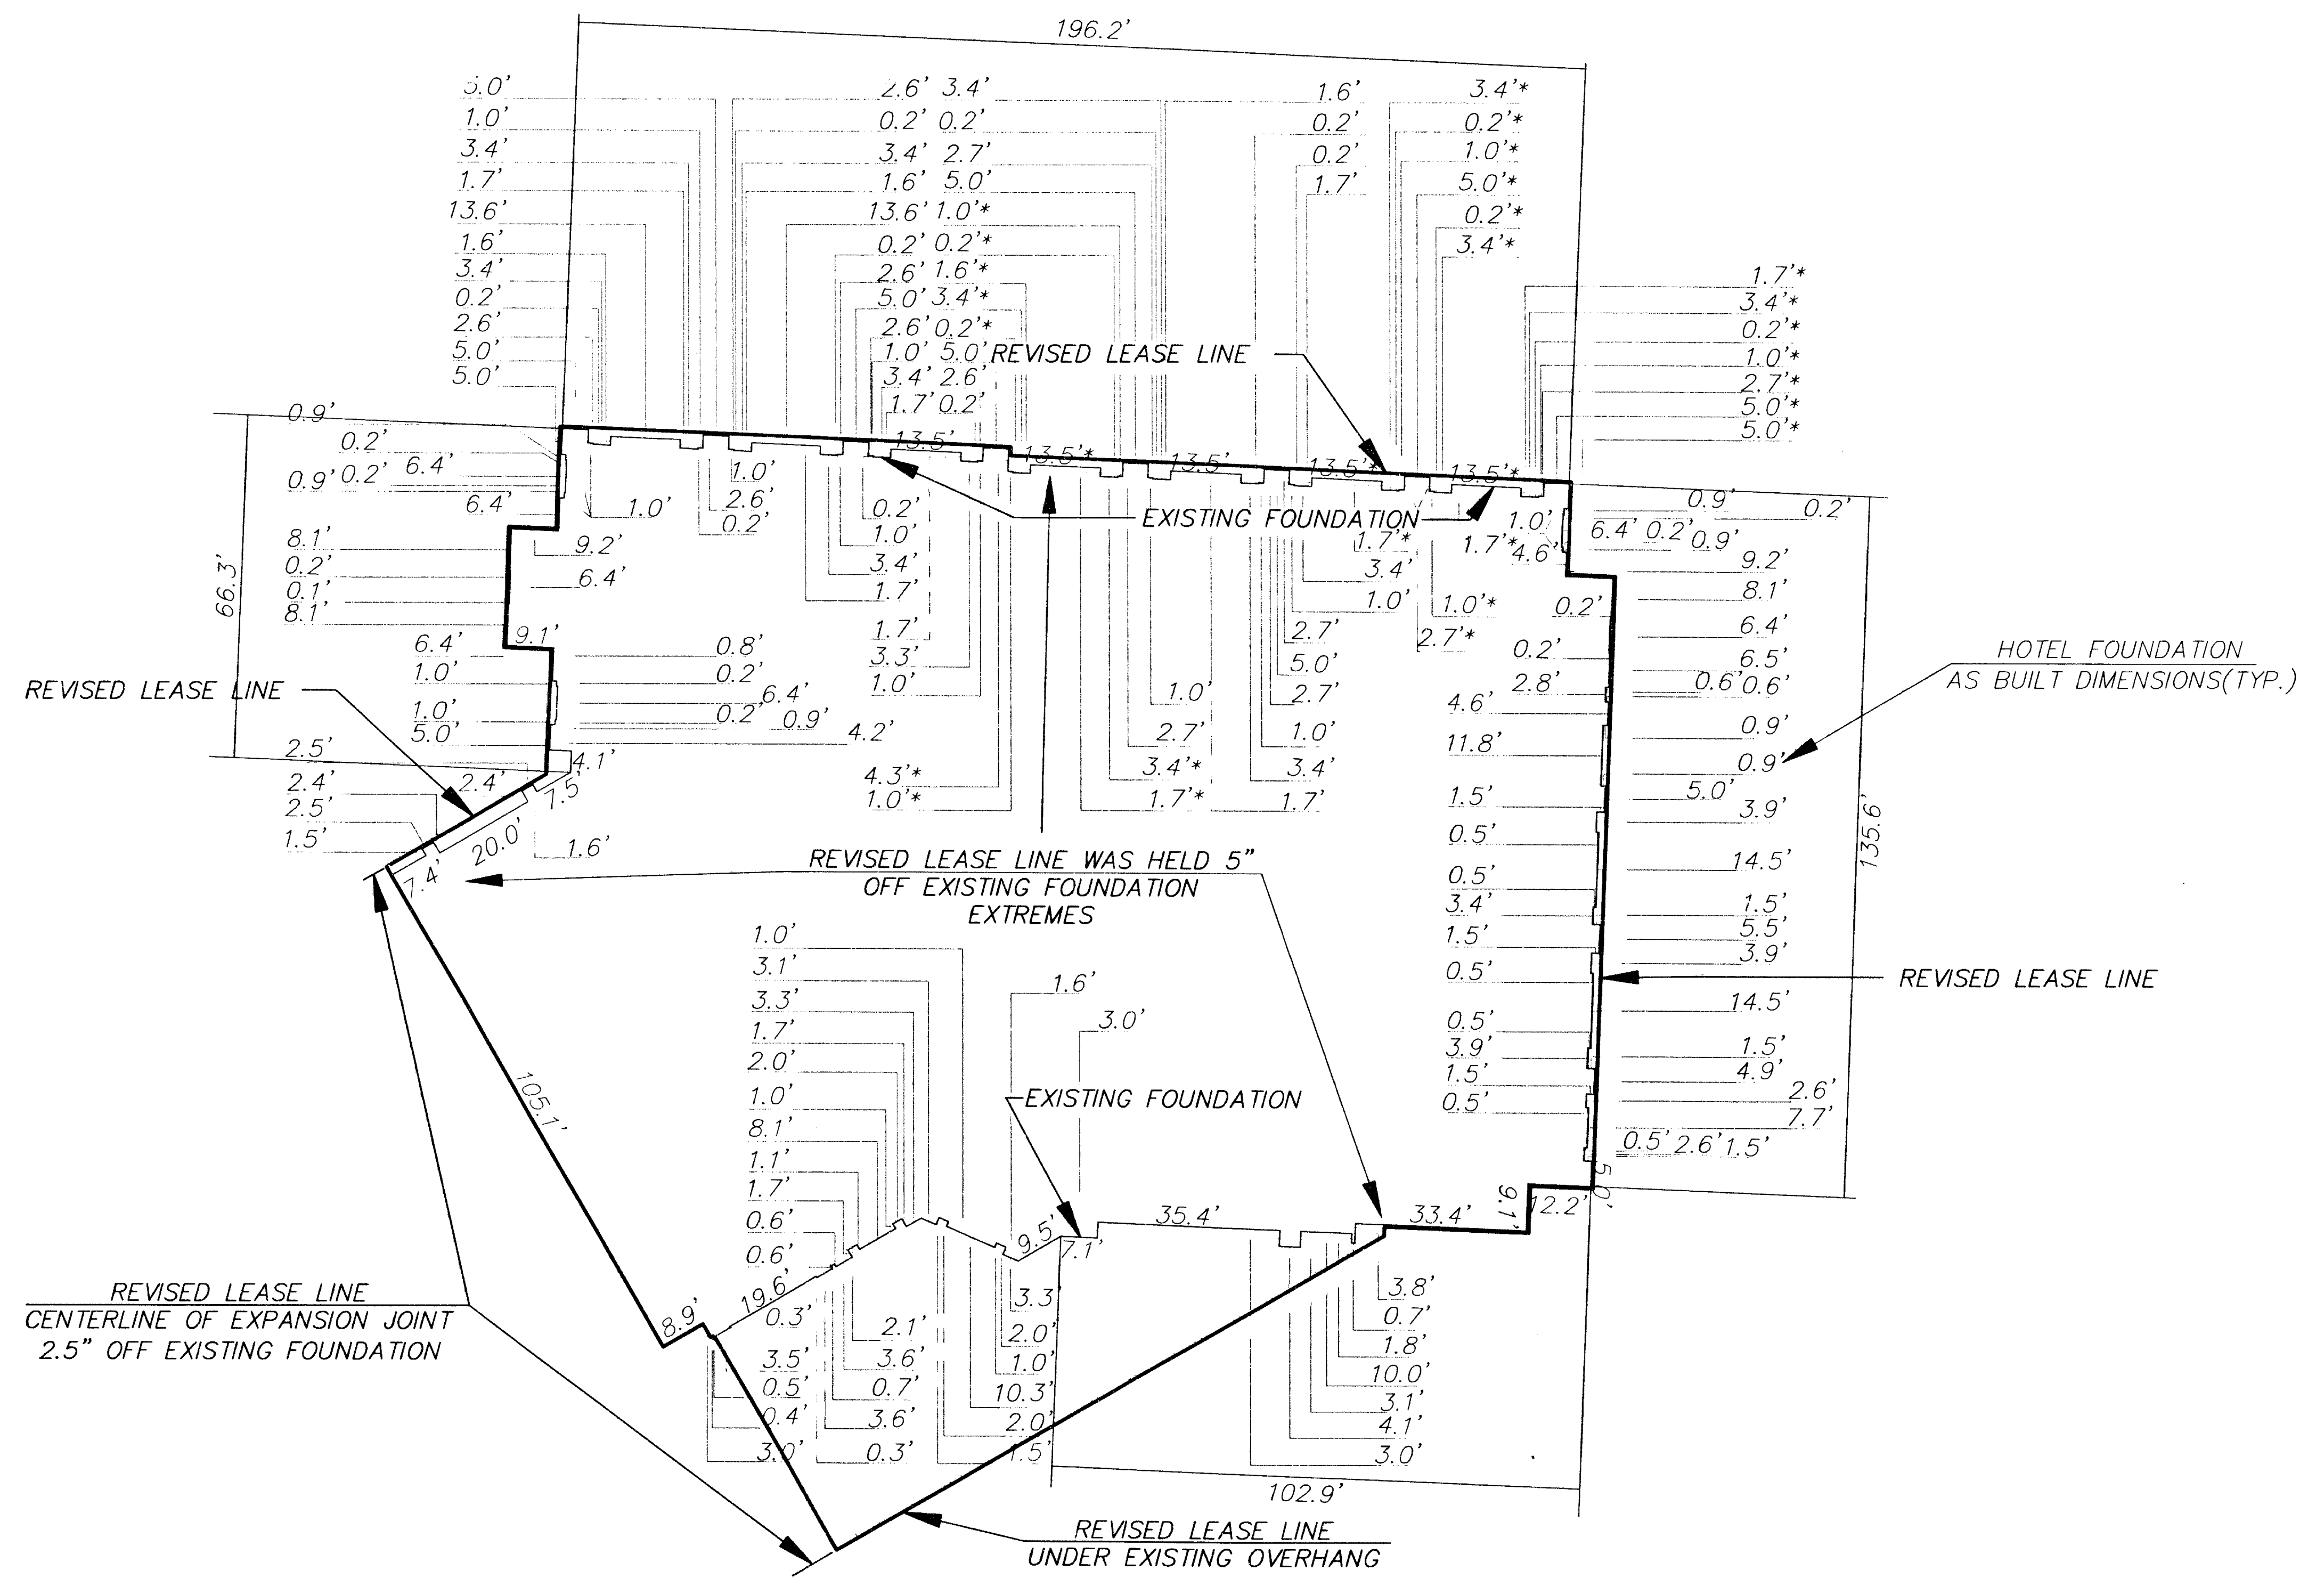


#2782

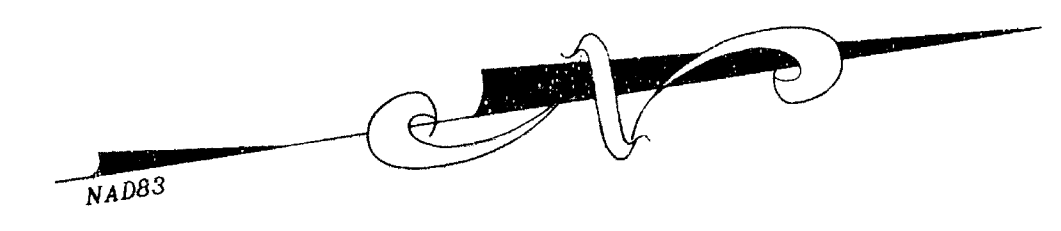

1.7' = DIMENSION NOT FIELD MEASURED
BECAUSE FOUNDATION OBSCURED BY
ONGOING CONSTRUCTION ACTIVITIES.

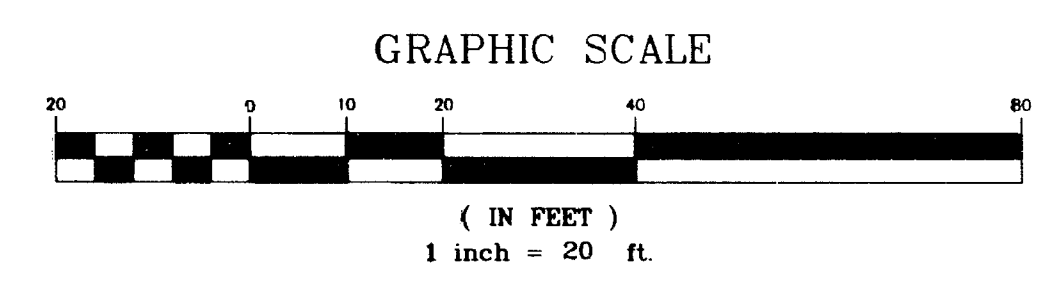


THIS MAP REPRODUCED BY
ORIGINAL PLOT DRAWING
ON POLY-ETHYLENE FILM
REPRODUCED BY
F.A. HESKEITH & ASSOC. INC.
EAST GRAFTON, CT

HOTEL FOUNDATION AS BUILT DETAIL SHEET/
ALTA/ACSM LAND TITLE SURVEY

ADRIAEN'S LANDING
Hartford, Connecticut

Phone (860) 855-9000
Fax (860) 844-9000
e-mail heskeith@aol.com

F. A. Heskeith & Associates, Inc.
6 Creamery Brook, East Grafton, CT 06026
Civil & Traffic Engineers • Surveyors • Planners • Landscape Architects

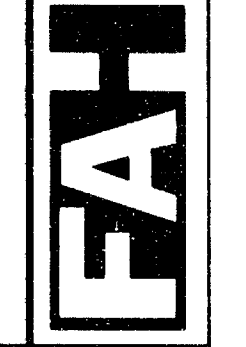


HOTEL LEASE PLAN
PREPARED FOR
STATE OF CONNECTICUT
ADRIAEN'S LANDING
HARTFORD, CONNECTICUT

Date: 09-23-01 Drawn by: CAD Job no: 96007
Scale: 1" = 20' checked by: TSH sheet no. 3 of 7

EAH-3

#2782

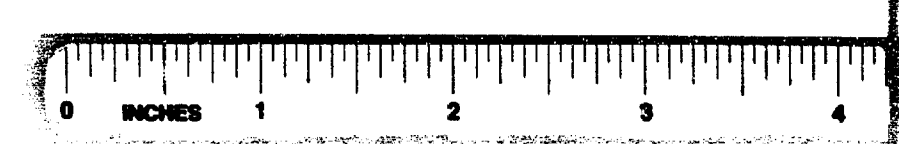

W:\ADRIAEN\HOTEL LEASEMENT\PLAN02.dwg, EAH-3, 7/12/2005 2:13:39 PM