

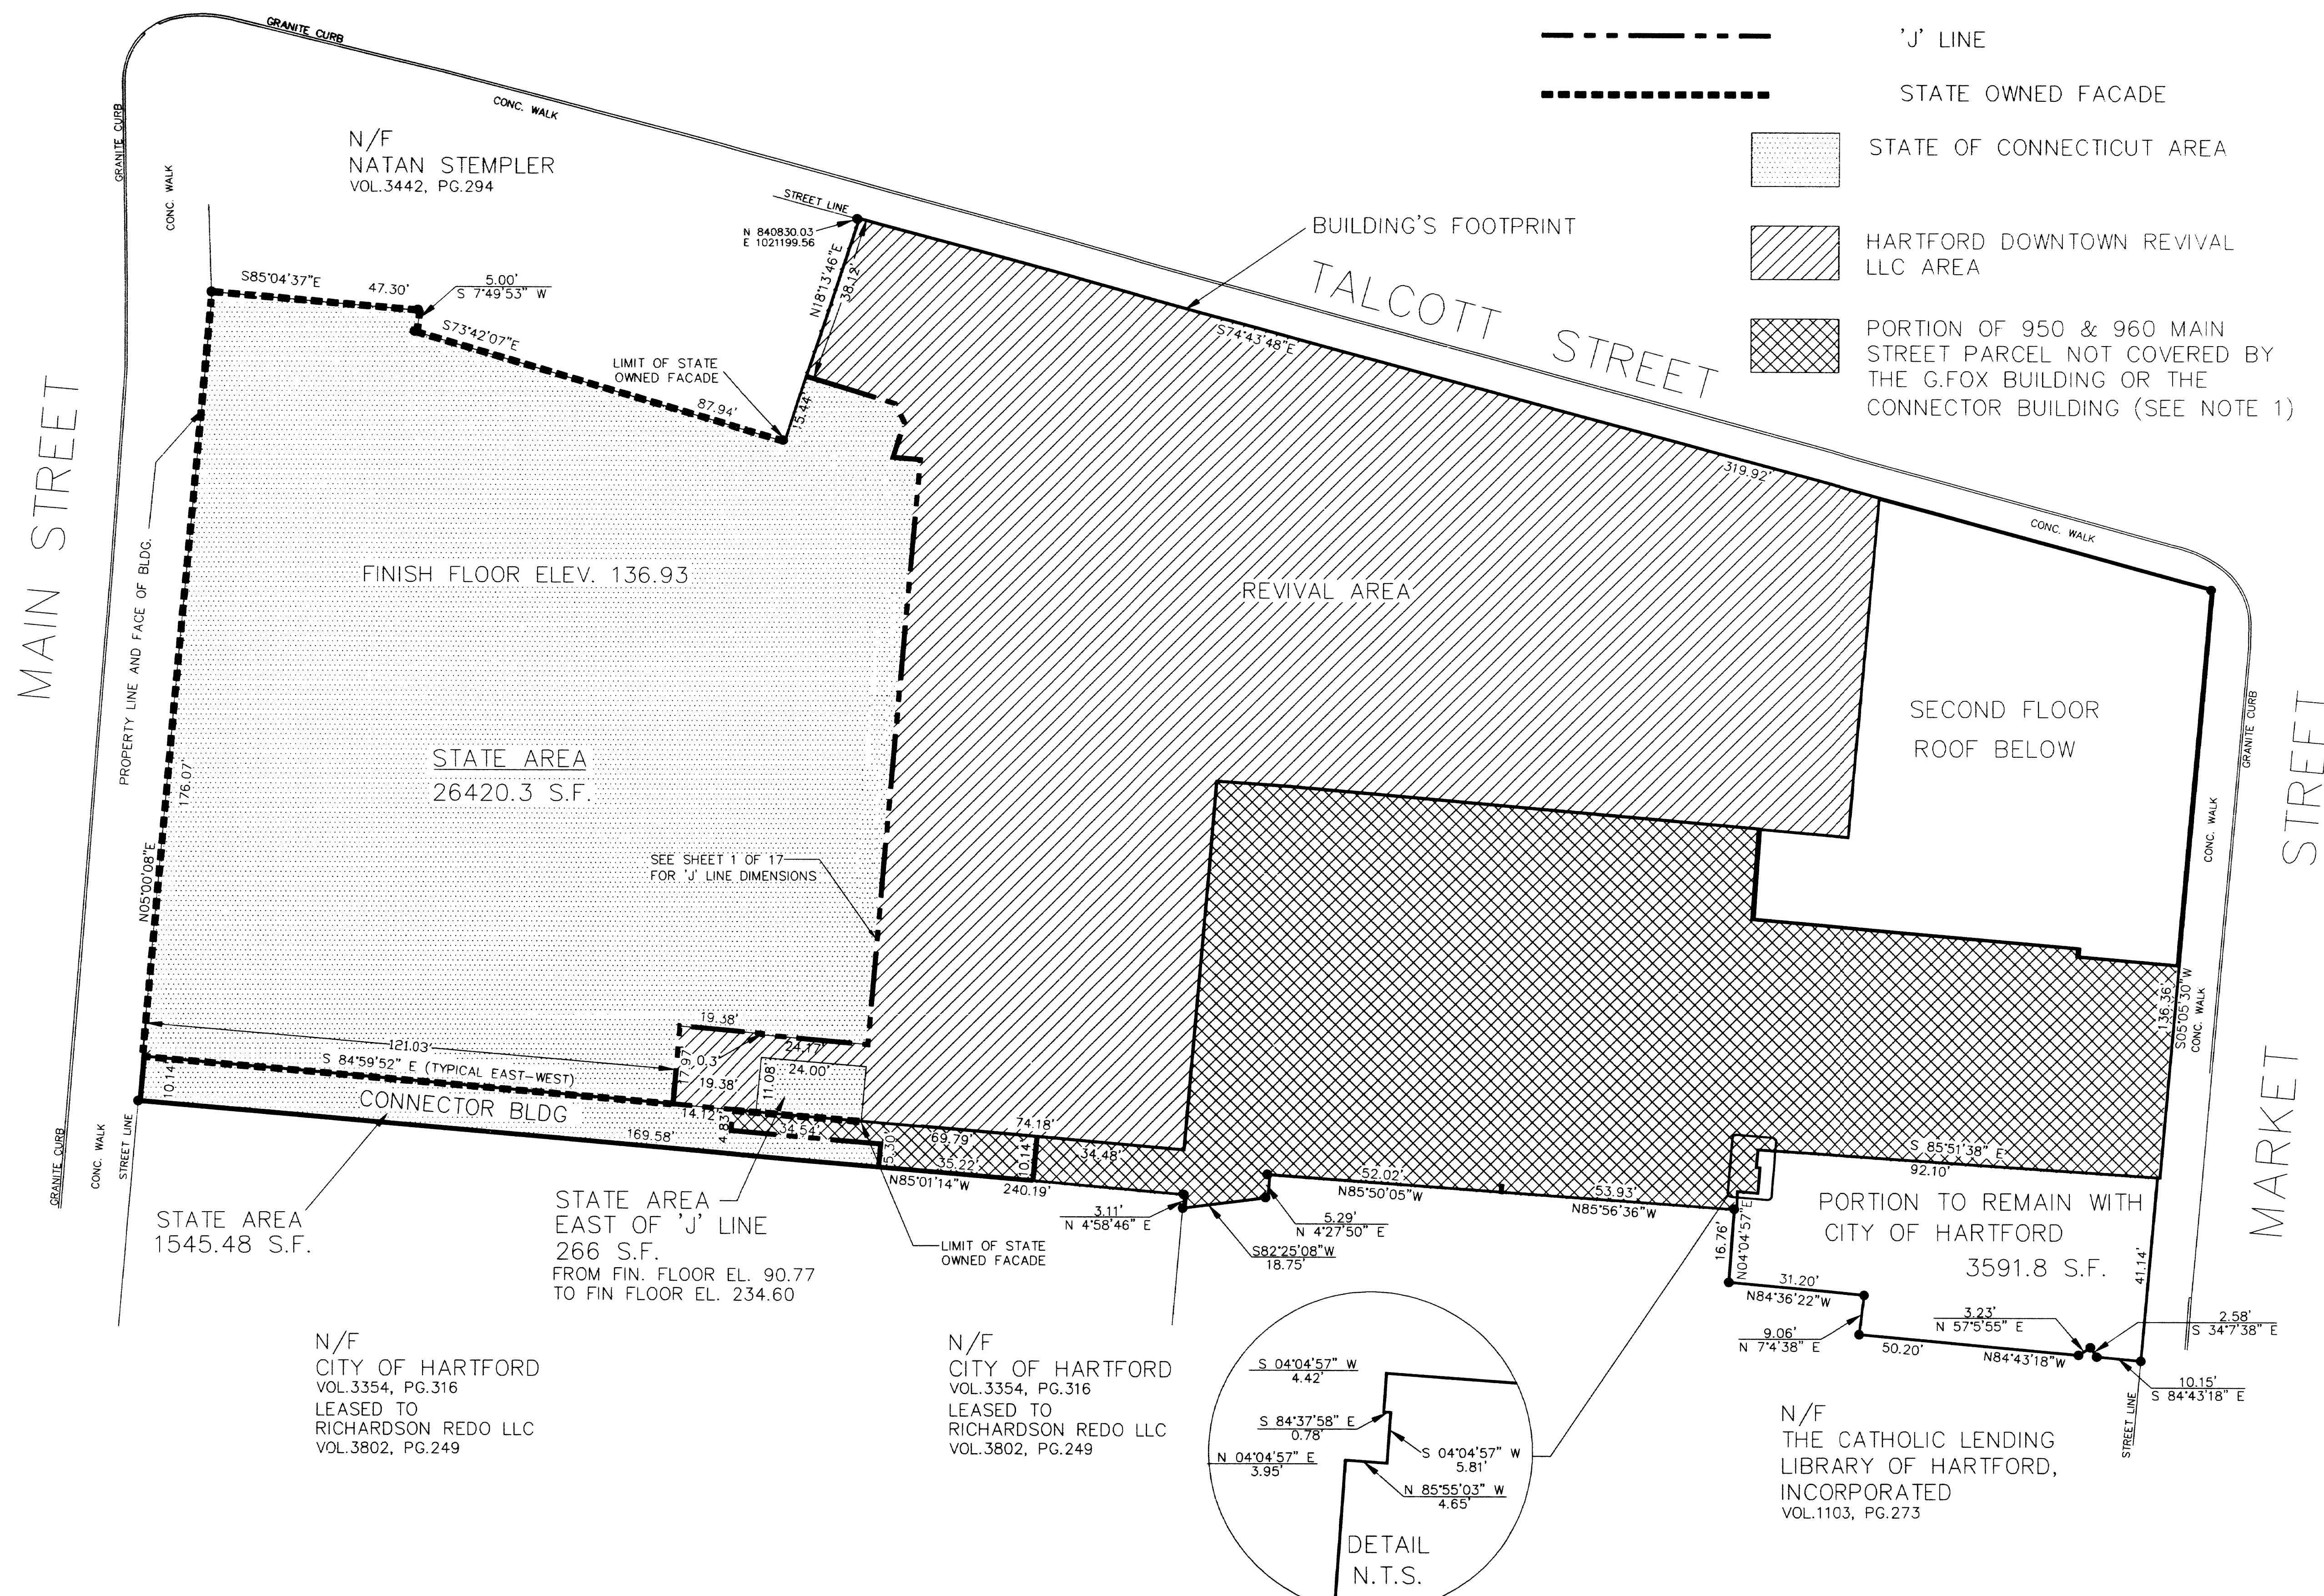


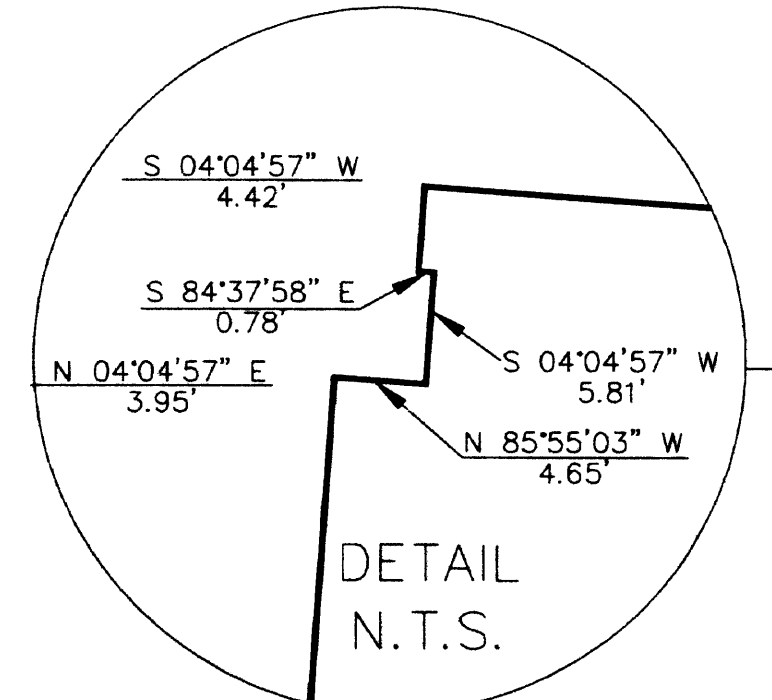

MAP REFERENCES AND NOTES: SEE SHEET 1

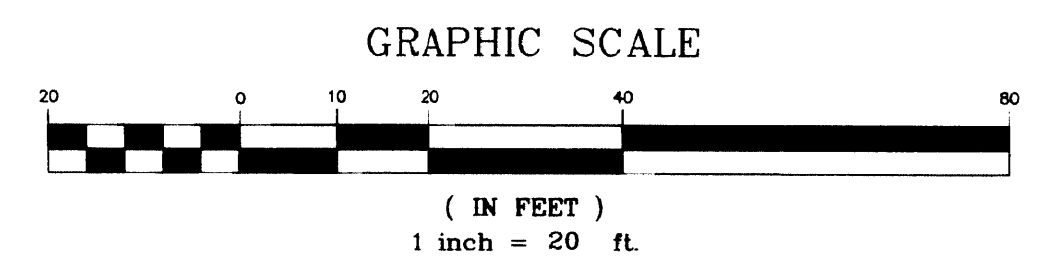

THIS MAP IS VALID ONLY IF IT BEARS THE ORIGINAL SIGNATURE AND EMBOSSED SEAL OF THE SURVEYOR.

I hereby certify to (i) CapitalSource Finance LLC, (ii) Deutsche Banc Mortgage Capital, L.L.C., (iii) Chevron TGL, Inc., (iv) First American Title Insurance Company, (v) Hartford Downtown Revival, LLC, (vi) HDR Office Holdings SPE, LLC, (vii) State of Connecticut, and (viii) Brown Rudnick Berlock Israels LLP.

THIS SURVEY AND MAP HAS BEEN PREPARED IN ACCORDANCE WITH SECTIONS 20-300b-1 THROUGH 20-300b-20 OF THE REGULATIONS OF CONNECTICUT STATE AGENCIES- "STANDARDS FOR SURVEYS AND MAPS IN THE STATE OF CONNECTICUT" AS ENDORSED BY THE CONNECTICUT ASSOCIATION OF LAND SURVEYORS, INC. IT IS AN ORIGINAL SURVEY BASED ON A RESURVEY CONFORMING TO HORIZONTAL ACCURACY CLASS A-2. TO MY KNOWLEDGE AND BELIEF, THIS MAP IS SUBSTANTIALLY CORRECT AS NOTED HEREON.

Carmen Giuliano NO. 15769
CARMEN GIULIANO L.S. DATE LICENSE NO.



GENERAL LOCATION SURVEY/ AS-BUILT PLAN
G. FOX BUILDING
950 & 960 MAIN STREET
HARTFORD, CONNECTICUT

PREPARED BY:
L-C ASSOCIATES INC.
1960 SILAS DEANE HIGHWAY
ROCKY HILL, CT 06067

DATE: JULY 26, 06 SCALE: 1"=20' SHEET 9 OF 17

THIS MAP PRODUCED BY ORIGINAL INK DRAWING ON POLY FILM OR LINEN
PRODUCED BY CARMEN GIULIANO, L.S. SOUTH GLASTONBURY, CT

