


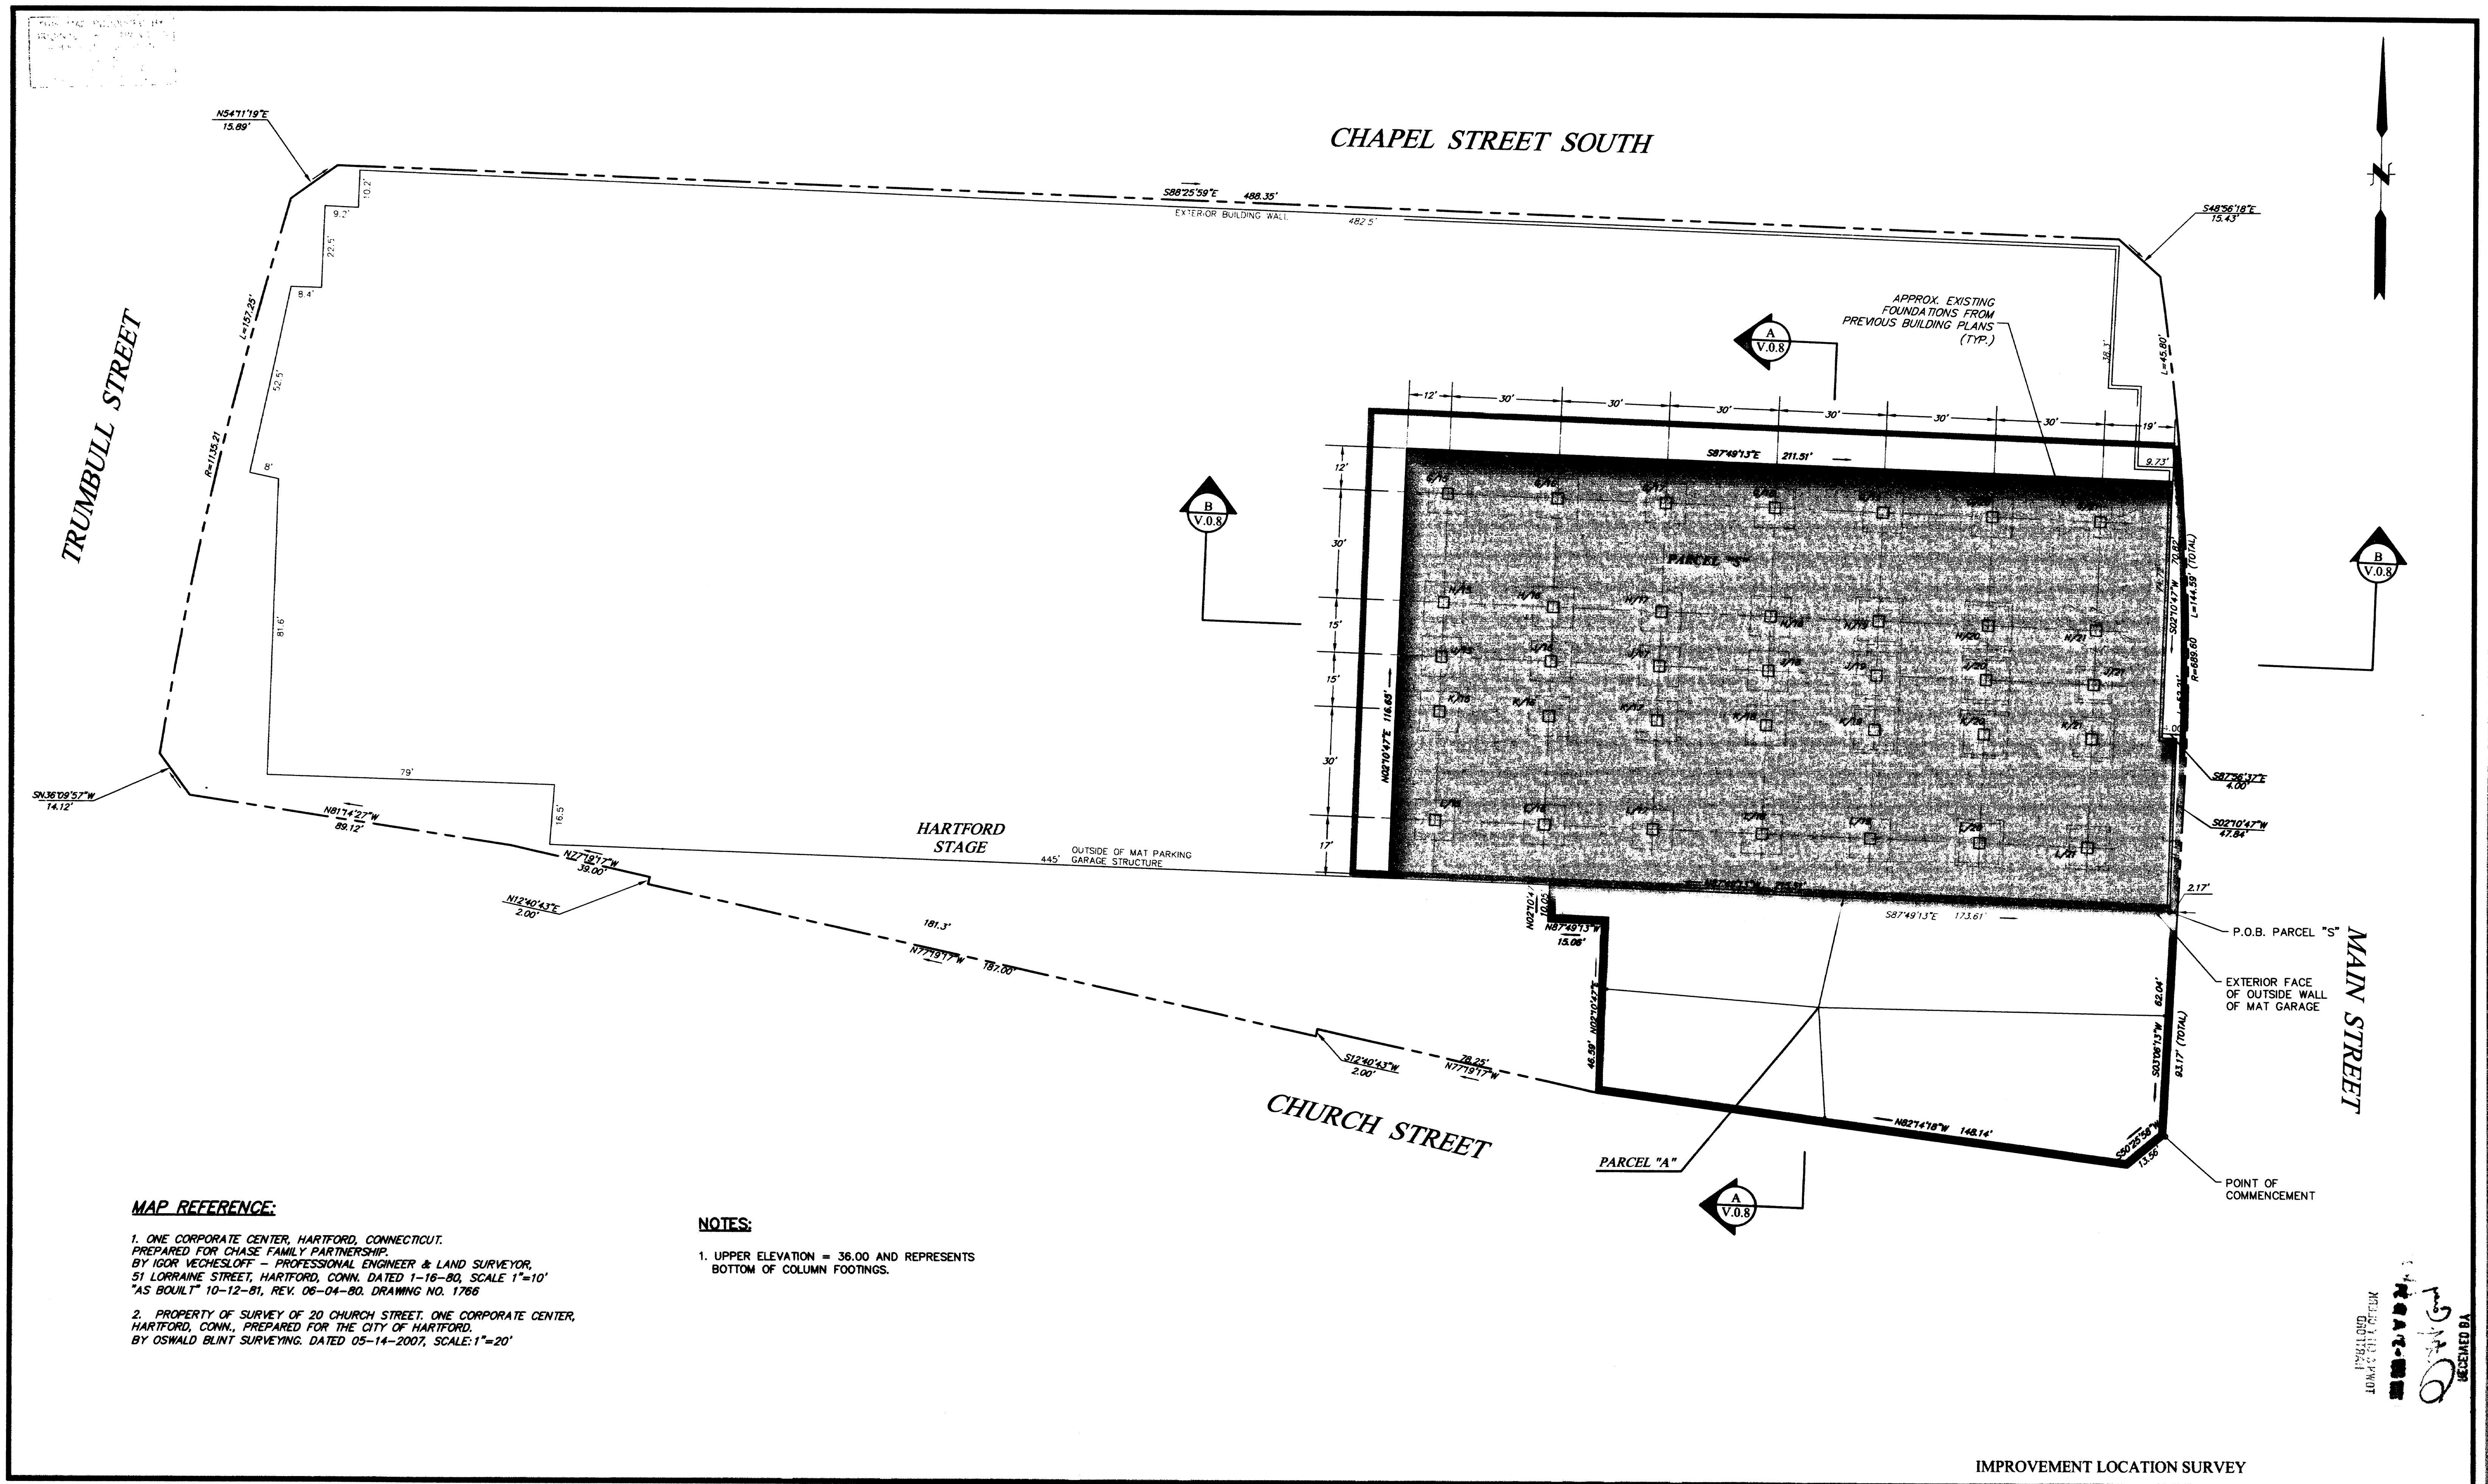

MAP REFERENCE:

1. ONE CORPORATE CENTER, HARTFORD, CONNECTICUT. PREPARED FOR CHASE FAMILY PARTNERSHIP. BY IGOR VECHESLOFF - PROFESSIONAL ENGINEER & LAND SURVEYOR. 51 LORRAINE STREET, HARTFORD, CONN. DATED 1-16-80, SCALE 1"=10' "AS BUILT" 10-12-81, REV. 06-04-80. DRAWING NO. 1766
2. PROPERTY OF SURVEY OF 20 CHURCH STREET, ONE CORPORATE CENTER, HARTFORD, CONN., PREPARED FOR THE CITY OF HARTFORD. BY OSWALD BLINT SURVEYING. DATED 05-14-2007, SCALE: 1"=20'


NOTES:

1. UPPER ELEVATION = 36.00 AND REPRESENTS BOTTOM OF COLUMN FOOTINGS.

IMPROVEMENT LOCATION SURVEY

REVISIONS		DESCRIPTION	DATE	BY
1.				
No.	DATE	DESCRIPTION	DATE	BY

PROJ. MANAGER:	SEAL
CHIEF DESIGNER:	
REVIEWED BY:	
DATE	

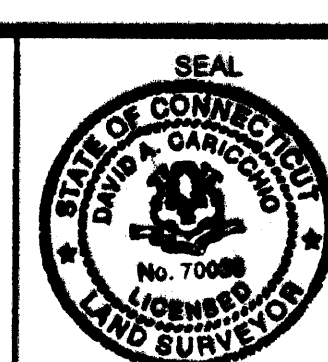

TO MY KNOWLEDGE AND BELIEF, THESE MAPS ARE SUBSTANTIALLY CORRECT AS NOTED HEREON.

David A. Caricchio

DAVID A. CARICCHIO LICENSE No. 70036

SCALE:	HORIZ.: 1" = 20'
	VERT.:
DATUM:	HORIZ.:
	VERT.:
GRAPHIC SCALE	



FUSS & O'NEILL
Disciplines to Deliver

146 HARTFORD RD MANCHESTER, CT 06040 860.646.2469

20 CHURCH STREET
SUB-FOUNDATION PLAN
PREPARED FOR
THE CITY OF HARTFORD

MAIN ST., CHURCH ST. & CHAPEL ST. SOUTH HARTFORD, CT

PROJ. No.: 1997279.C80
DATE: AUG. 29, 2008

V.0.7

RECEIVED
AUG 29 2008
CITY OF HARTFORD
ENGINEERING DEPARTMENT