
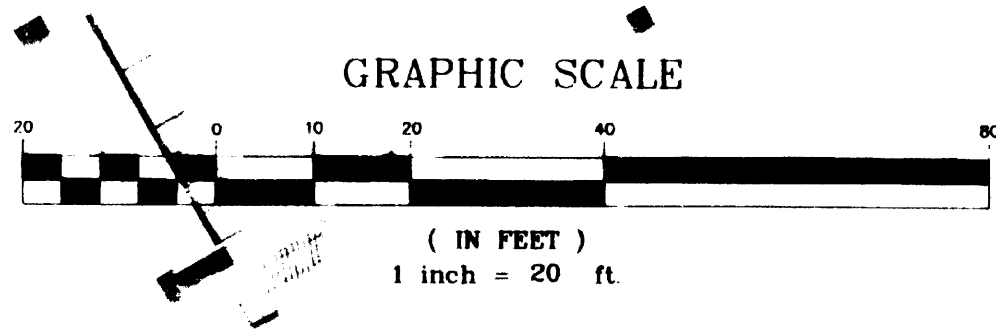
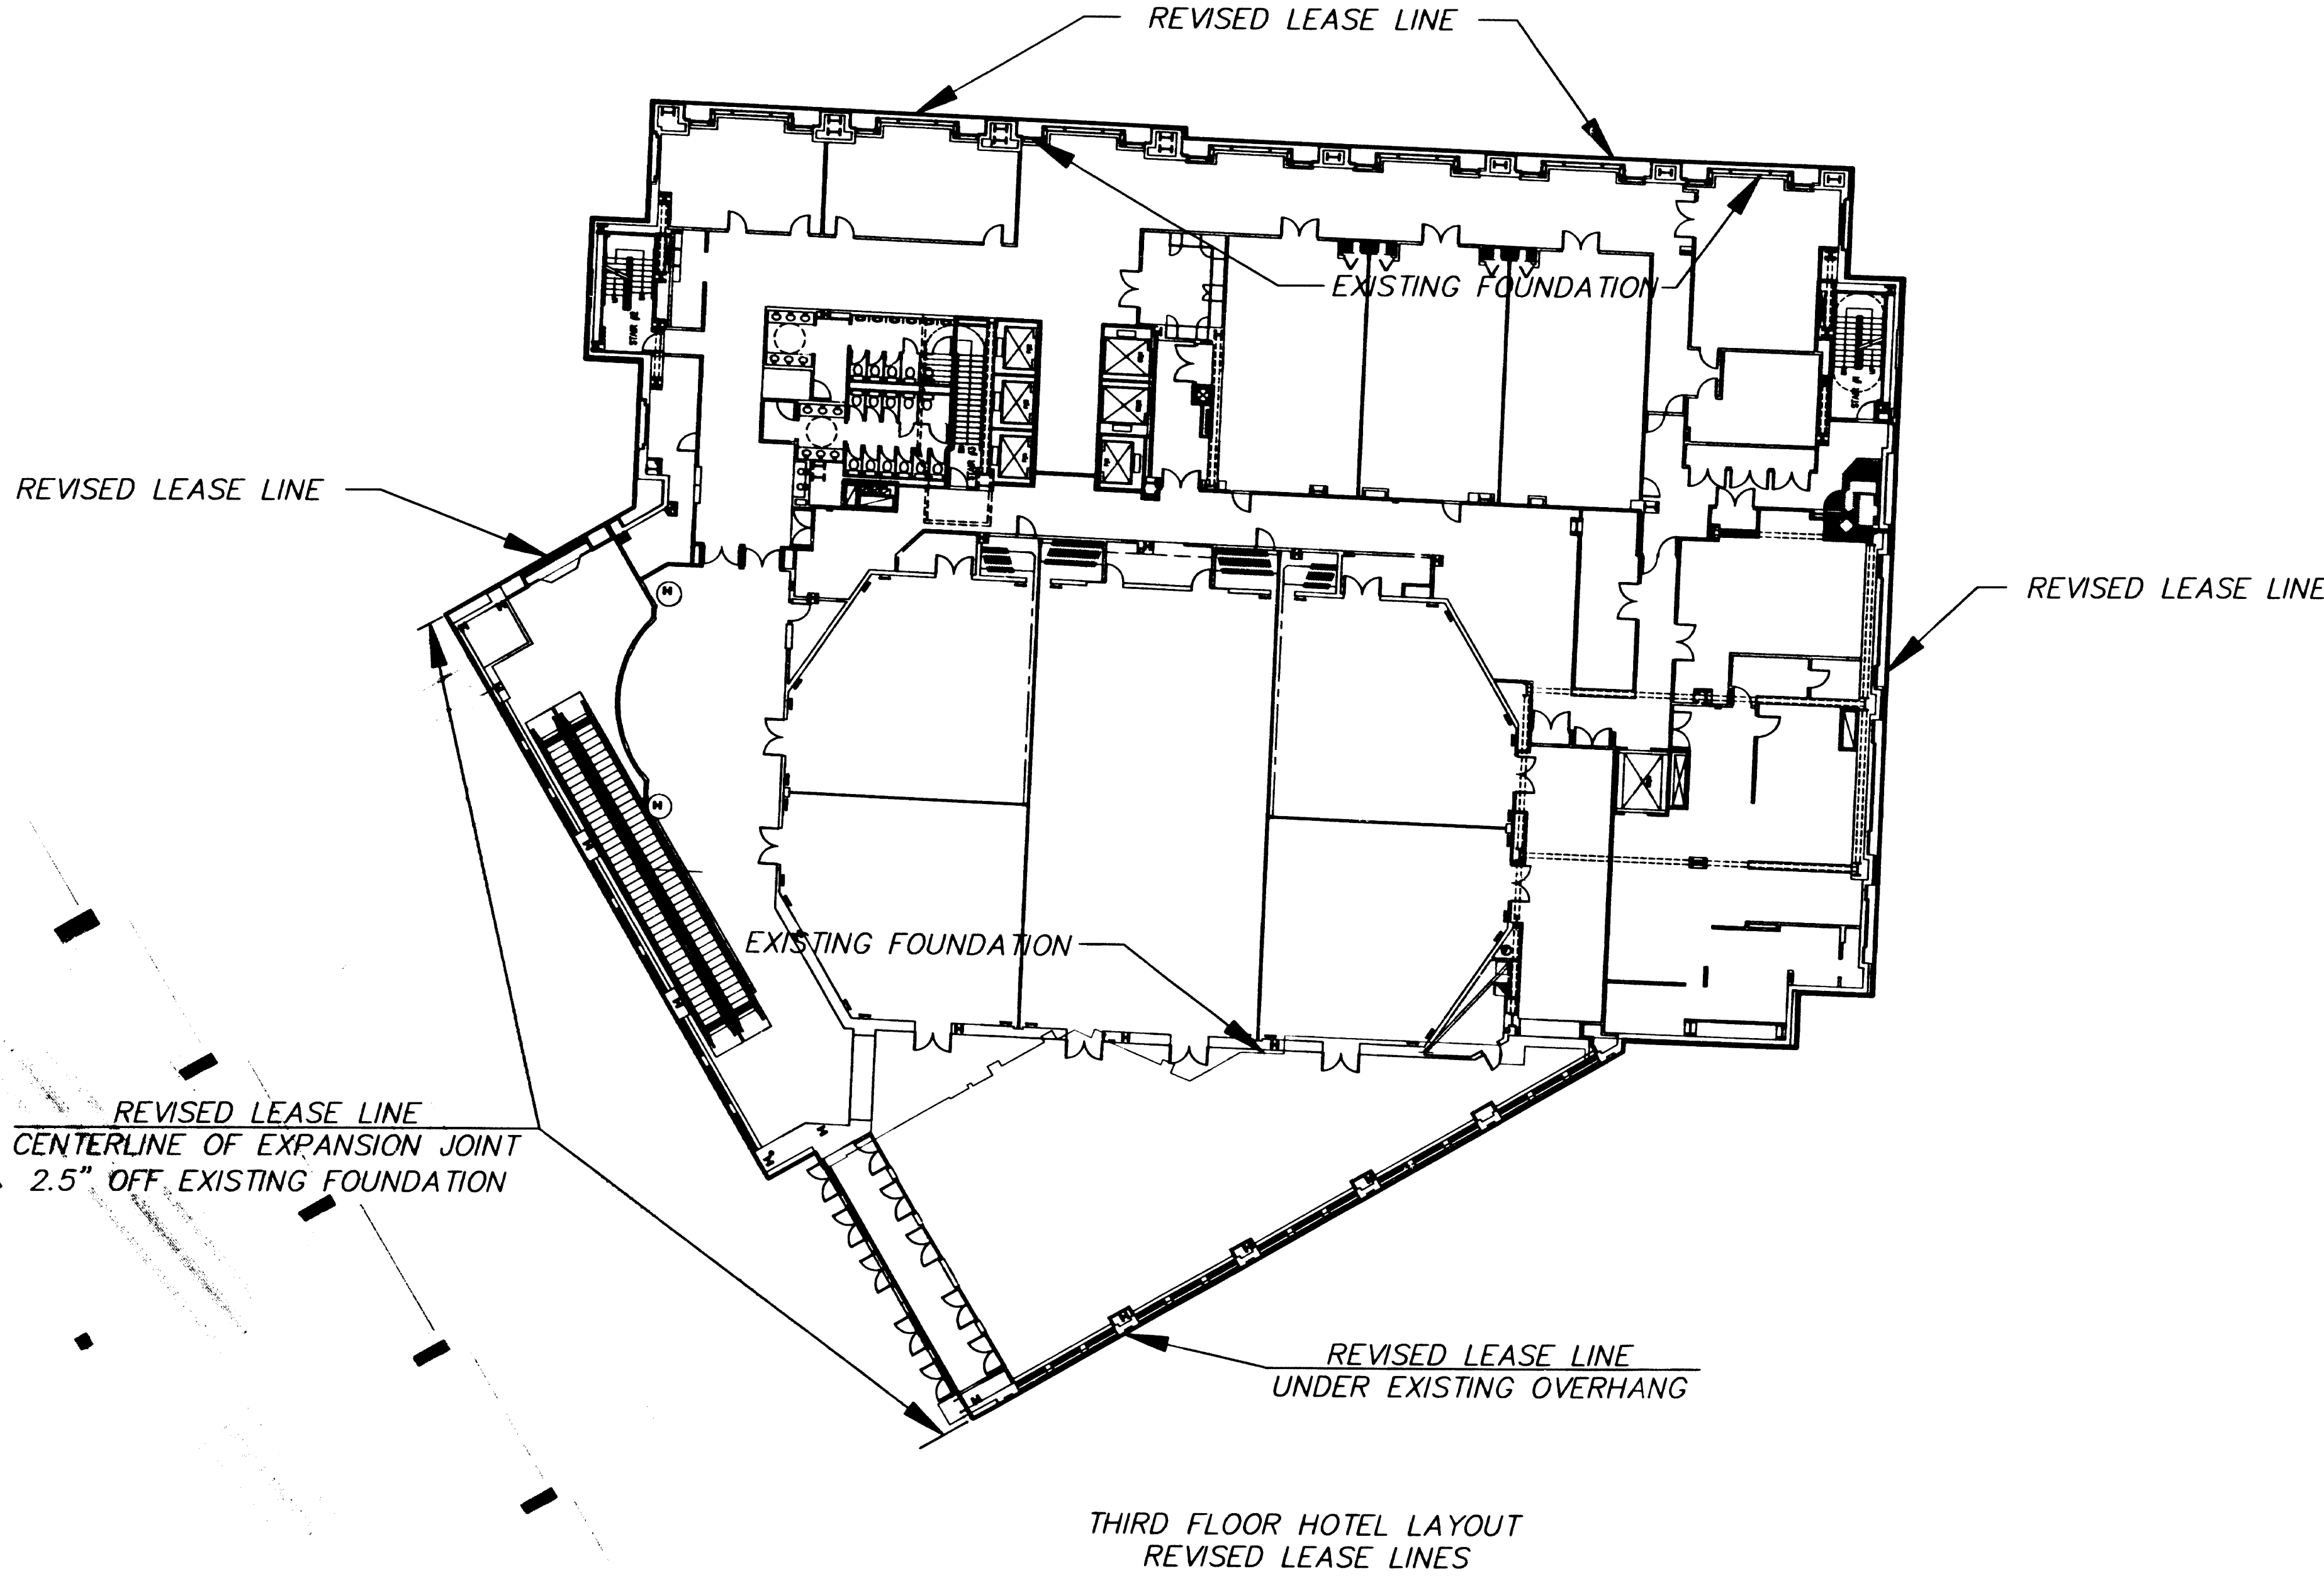


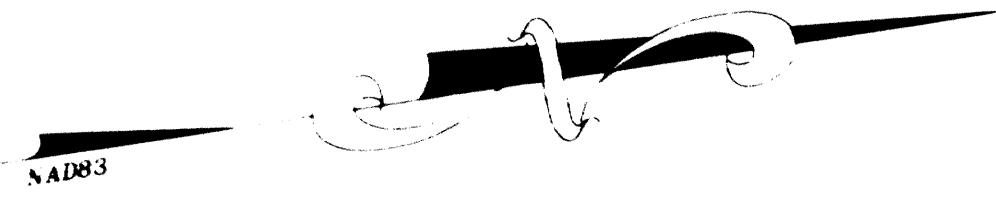

TOWN & CITY CLERK
HARTFORD
2007 JUL 31 P 1:15
[Signature]

THIRD FLOOR HOTEL LAYOUT

HOTEL LEASE PLAN
PREPARED FOR

STATE OF CONNECTICUT
ADRIAEN'S LANDING

HARTFORD, CONNECTICUT

DATE: 09-23-01 DRAWN BY: CAO JOB NO. 96007

SCALE: 1" = 20' CHECKED BY: TSH SHEET NO. 7 OF 7

REVISIONS:

NO.	DATE	DESCRIPTION
1	03-07-02	LEASE AREAS
2	03-21-02	REVISED LEASE - NEW HOTEL
3	06-11-02	ADD SHEET 2 OF 2
4	07-09-02	REVISED LEASE AREA
5	08-11-02	ADD PHOTOM DETAIL AREA
6	10-04-02	CORRECT DIMENSION
7	12-24-02	FINALIZE
8	07-31-03	MISC.

NO.	DATE	CLIENT COMMENTS
9	03-07-03	ADD 2nd FLOOR
10	05-30-03	ADD 2nd FLOOR
11	06-11-03	ADD 2nd FLOOR
12	06-24-03	REVISE HOTEL FIRST/SECOND FLOOR
13	08-04-03	REVISE HOTEL LAND/CERTIFICATION
14	09-11-03	NOTE THIS SHEET
15	01-20-05	HOTEL AS BUILT/SHEET 3
16	02-14-05	ADD UTILITIES
17	02-17-05	SHEET 4
18	02-21-05	SHEETS 5 & 7 - REV. LEASE AREAS

NO.	DATE	REVISIONS
19	12-08-06	REVISE HOTEL FIRST & SECOND FLOOR
20	02-20-08	NO CHANGES THIS SHEET
21		
22		
23		
24		
25		
26		
27		
28		
29		
30		

ADRIAEN'S LANDING
Hartford, Connecticut

F. A. Hesketh & Associates, Inc.
6 Creamery Brook, East Granby, CT 06026
Civil & Traffic Engineers • Surveyors • Planners • Landscape Architects

