
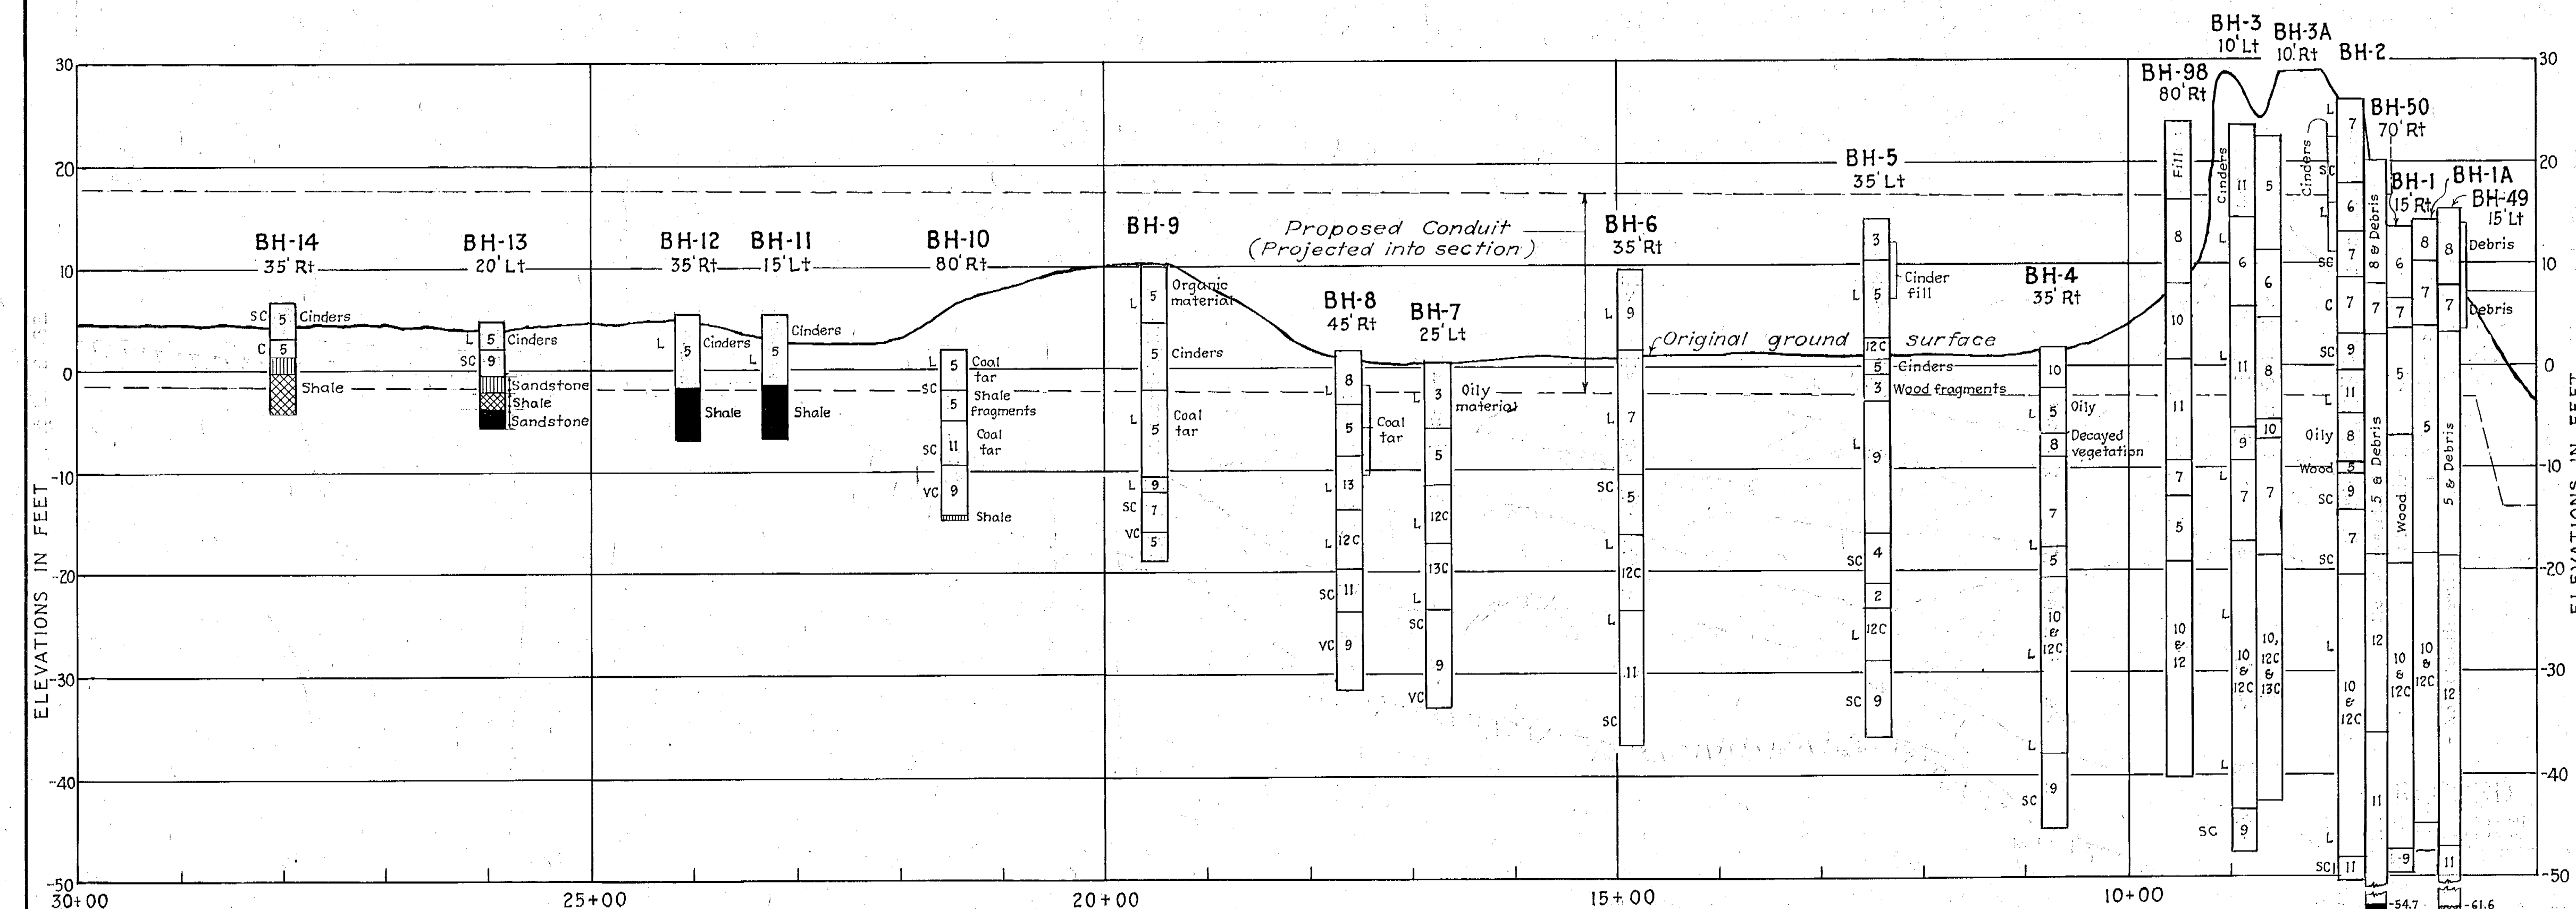


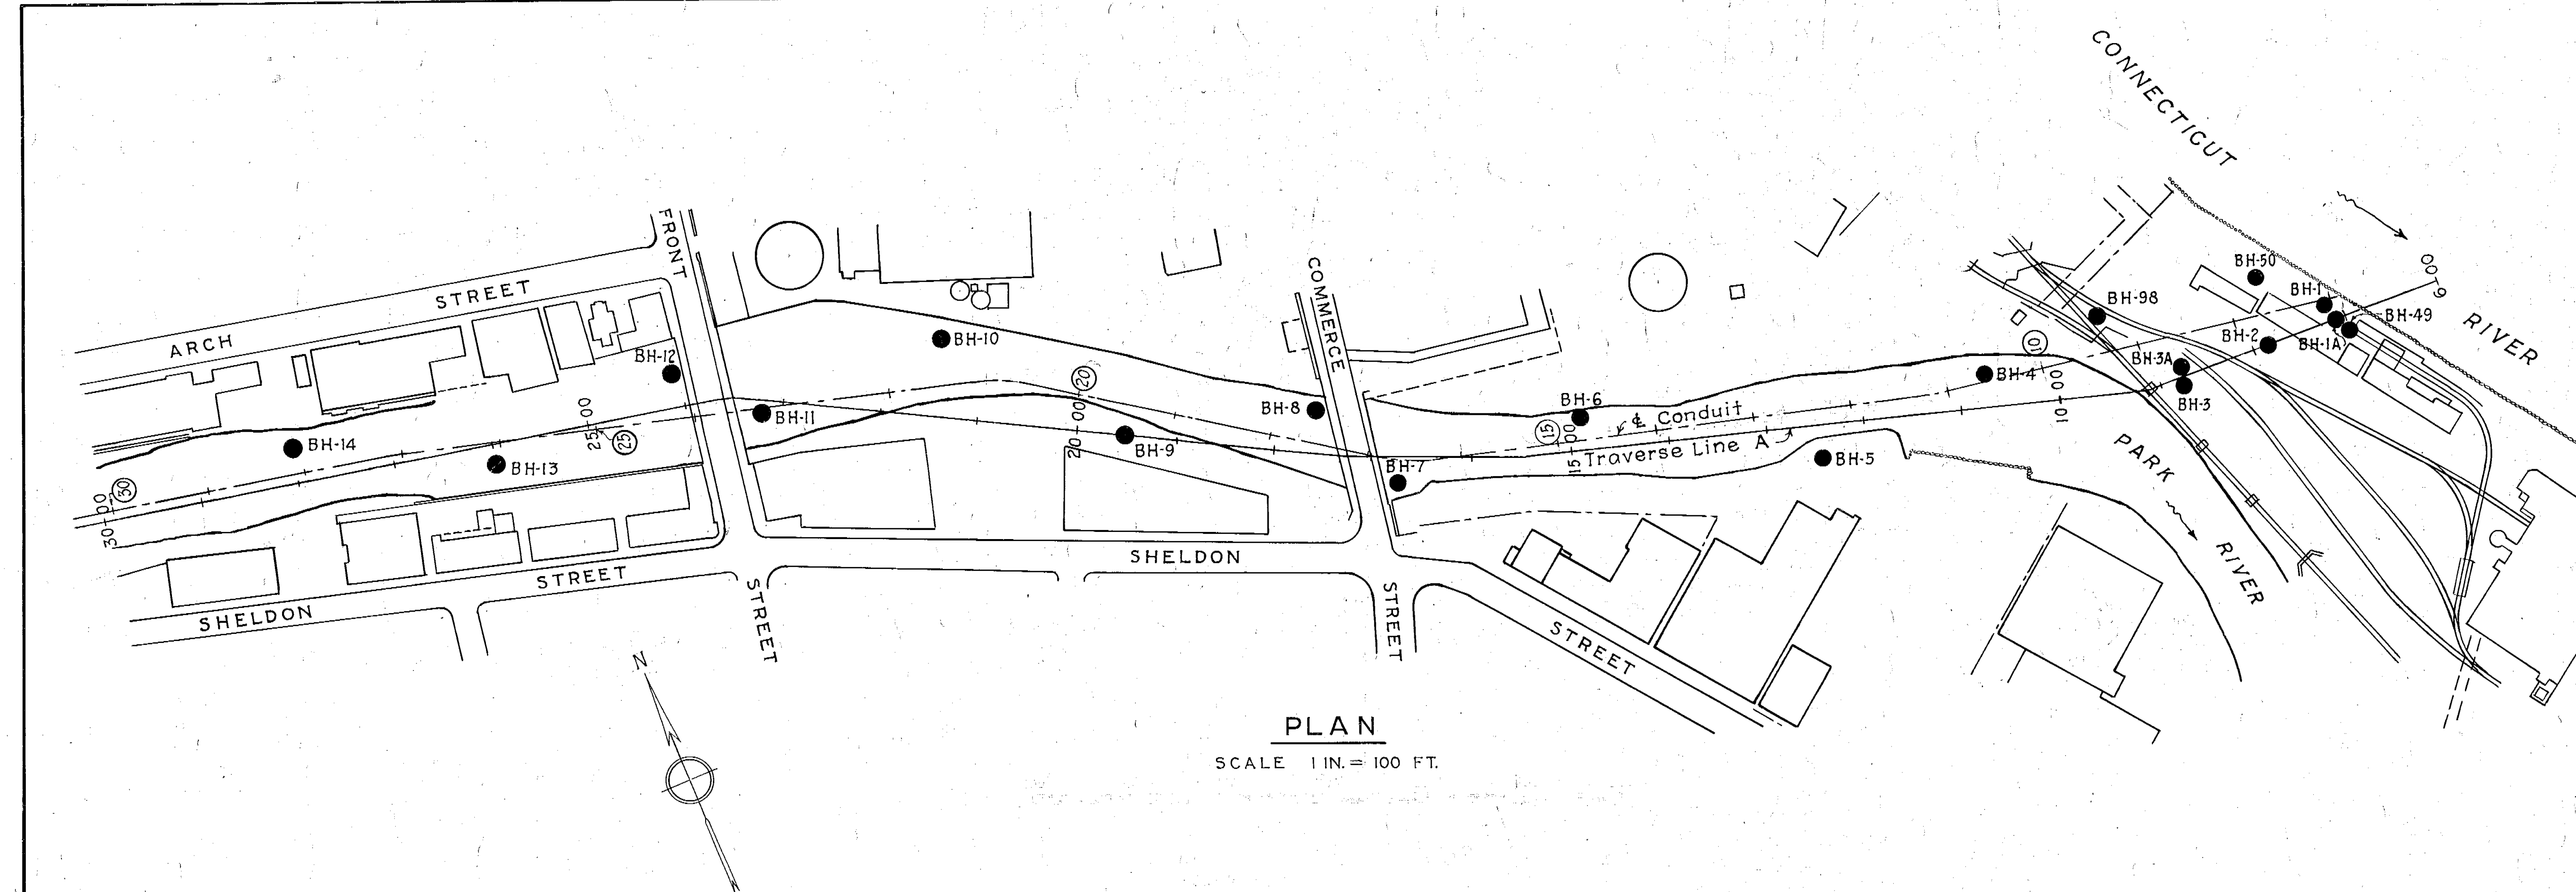

(Stations are not the same as the stations of the ϕ of the conduit.)

METCALF & EDDY
ENGINEERS
BOSTON, MASS.

KEY	DATE	REVISION (Indicated by Δ)	REV. BY	CK. BY	AP. BY
	12-31-45	As built.			

NOTES:
For general notes, legend and description of soil classes, see "Subsurface Explorations No. 2".
Classes 10 and 12c indicated in bore hole records generally occur in alternating bands, having thin layers of fine clay interbedded with thicker layers of silt.
Elevations refer to Mean Sea Level Datum

RECORD
DRAWINGS

CONNECTICUT RIVER FLOOD CONTROL	
PARK RIVER CONDUIT	
HARTFORD, CONN.	
SUBSURFACE EXPLORATIONS NO. 1	
CONNECTICUT RIVER	CONNECTICUT
IN 48 SHEETS	SHEET NO. 5
SCALE 1" = 100'	
U.S. ENGINEER OFFICE PROVIDENCE, R.I. MAY 1940	
REVIEWED: Frank B. Ballou SENIOR GEOLOGIST HEAD, GEOLOGY SECTION	APPROVED: J. B. Burns PRINCIPAL ENGINEER CHIEF F.C. ENGINEERING DIV.
SUBMITTED: Metcalf & Eddy BOSTON, MASS.	APPROVED: J. B. Burns COL. CORPS OF ENGINEERS DISTRICT ENGINEER
FILE NO. CT-2-1286	