
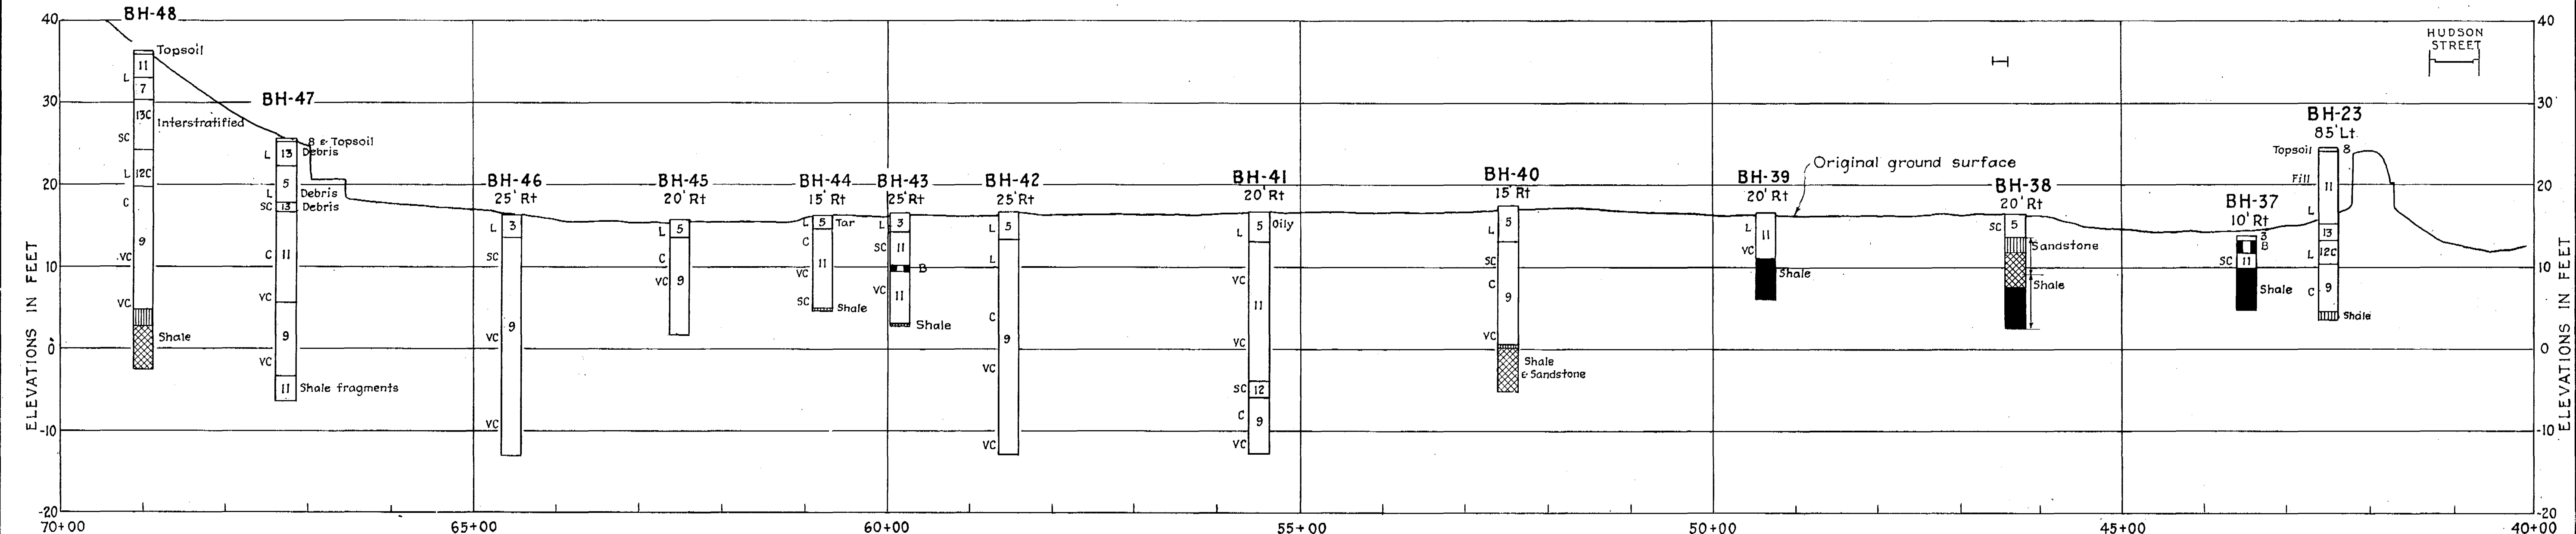


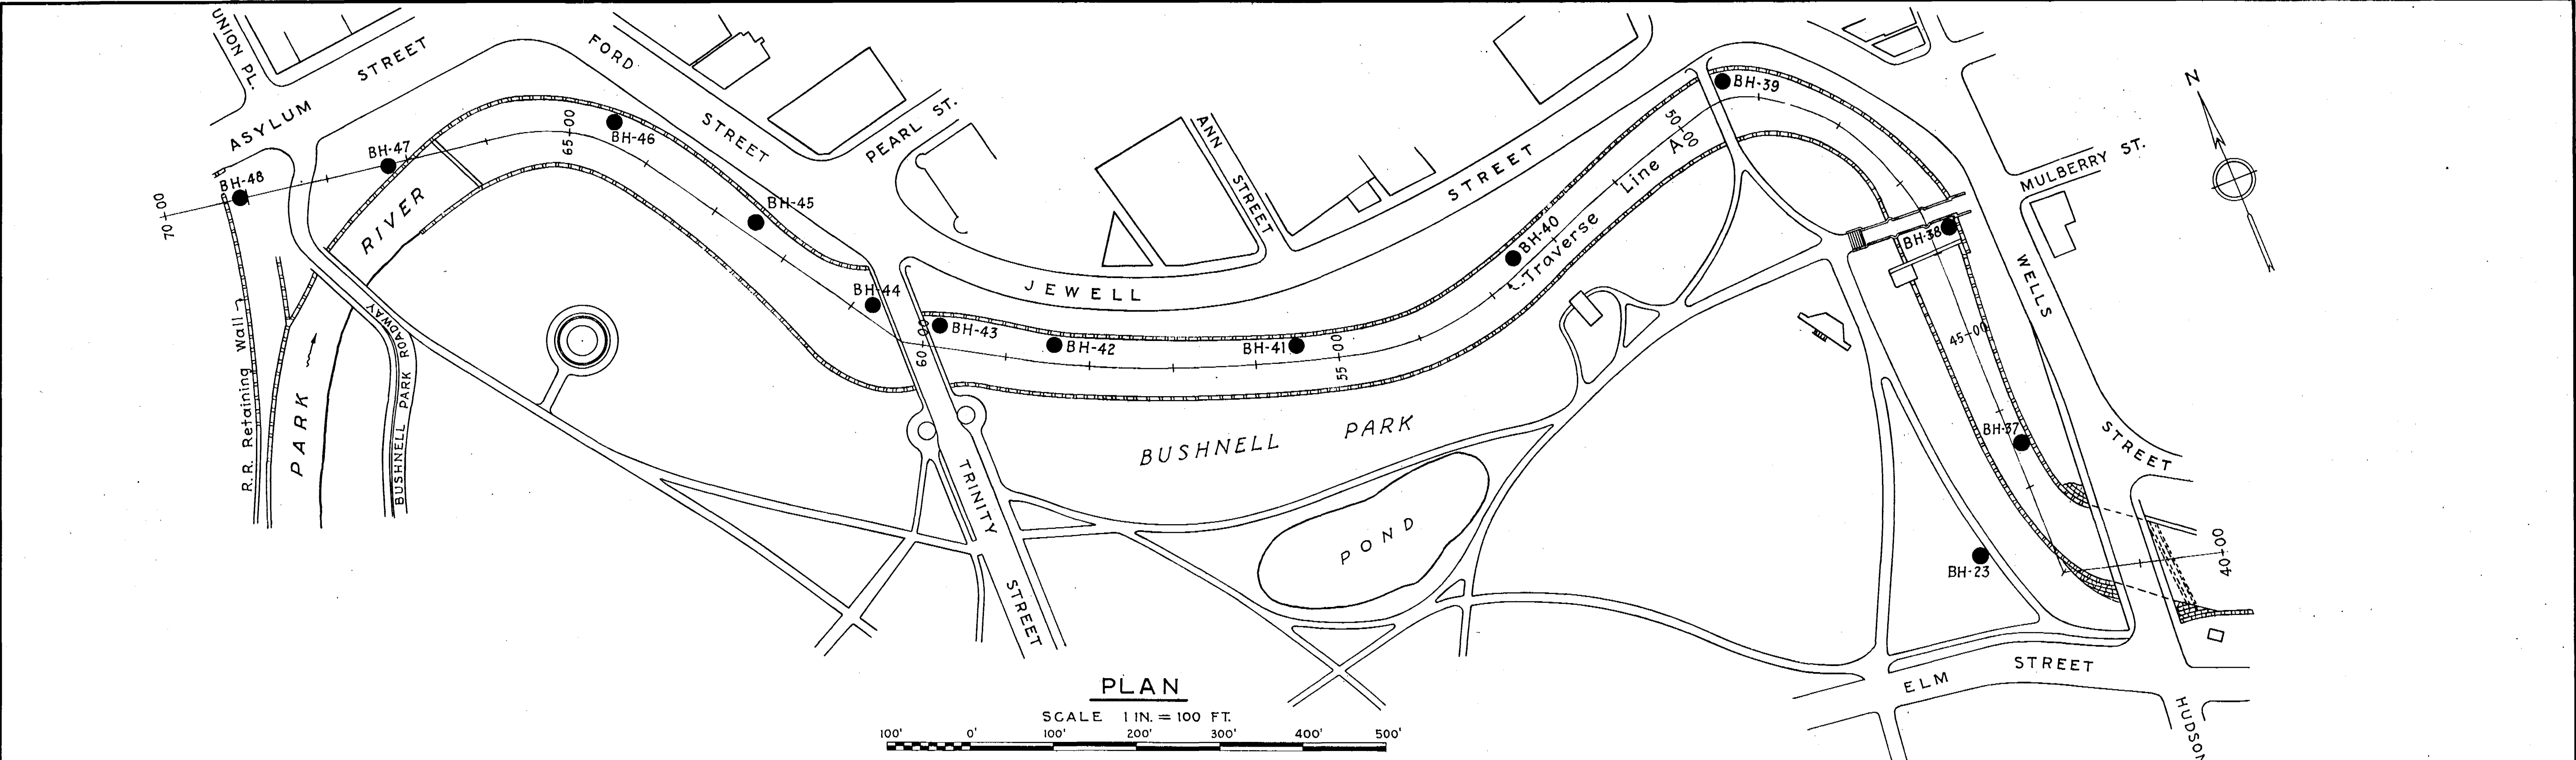

NOTES:
For general notes, legend and description of soil classes see "Subsurface Explorations No. 2."
Elevations refer to Mean Sea Level Datum

BORINGS
PROFILE ALONG TRAVERSE LINE A
(Stations are not the same as the stations of the Φ of the conduit.)

METCALF & EDDY
ENGINEERS
BOSTON, MASS.

KEY	DATE	REVISION (Indicated by Δ)	REV. BY	CK. BY	AP. BY
	12-31-45	As built.			

CONNECTICUT RIVER FLOOD CONTROL		
PARK RIVER CONDUIT		
HARTFORD, CONN.		
SUBSURFACE EXPLORATIONS NO. 3		
CONNECTICUT RIVER	CONNECTICUT	
IN 48 SHEETS	SCALE 1" = 100'	SHEET NO. 7
U.S. ENGINEER OFFICE PROVIDENCE, R.I. MAY 1940		
REVIEWED: H. B. Eddy SENIOR GEOLOGIST HEAD GEOLOGY SECTION	APPROVED: J. S. Dumas PRINCIPAL ENGINEER CHIEF E.C. ENGINEERING DIV.	APPROVED: J. S. Dumas LT. COL. CORPS OF ENGINEERS DISTRICT ENGINEER
SUBMITTED: J. S. Dumas METCALF & EDDY BOSTON, MASS.		FILE NO. CT-2-1288