

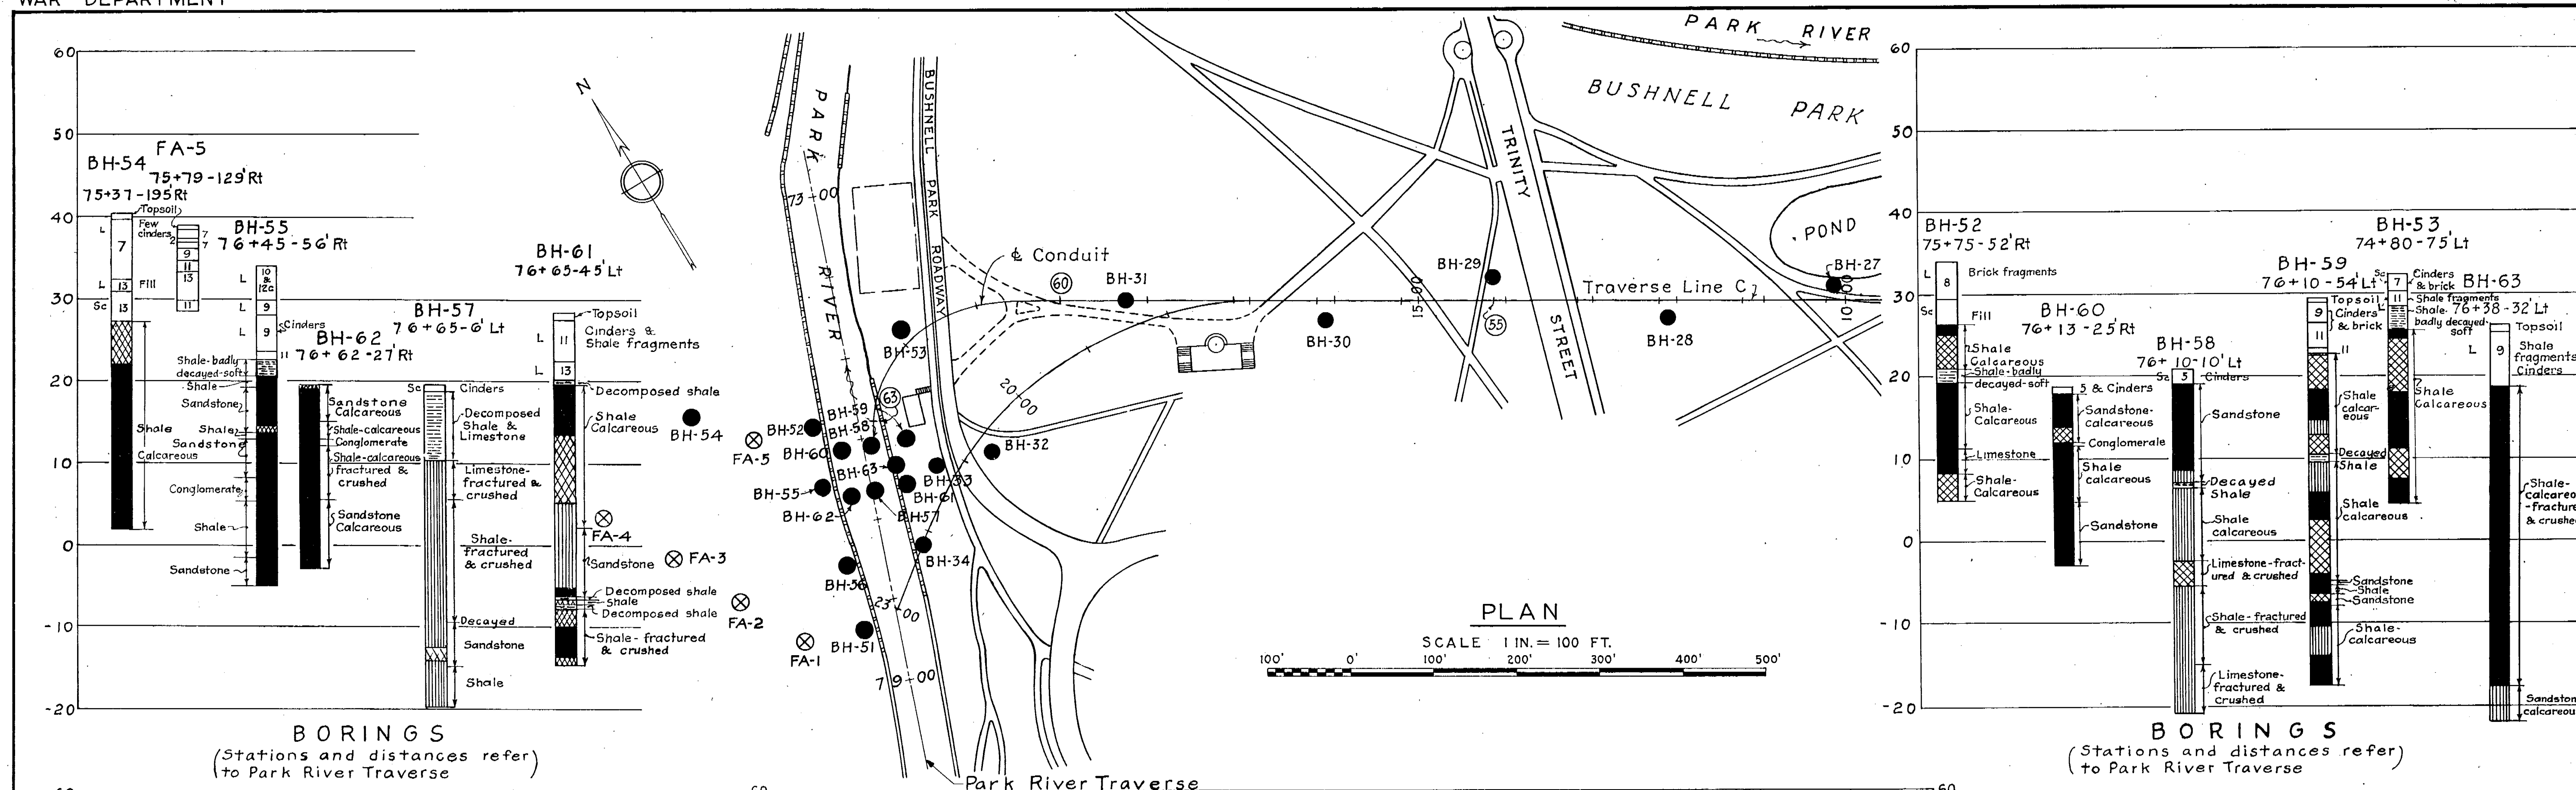


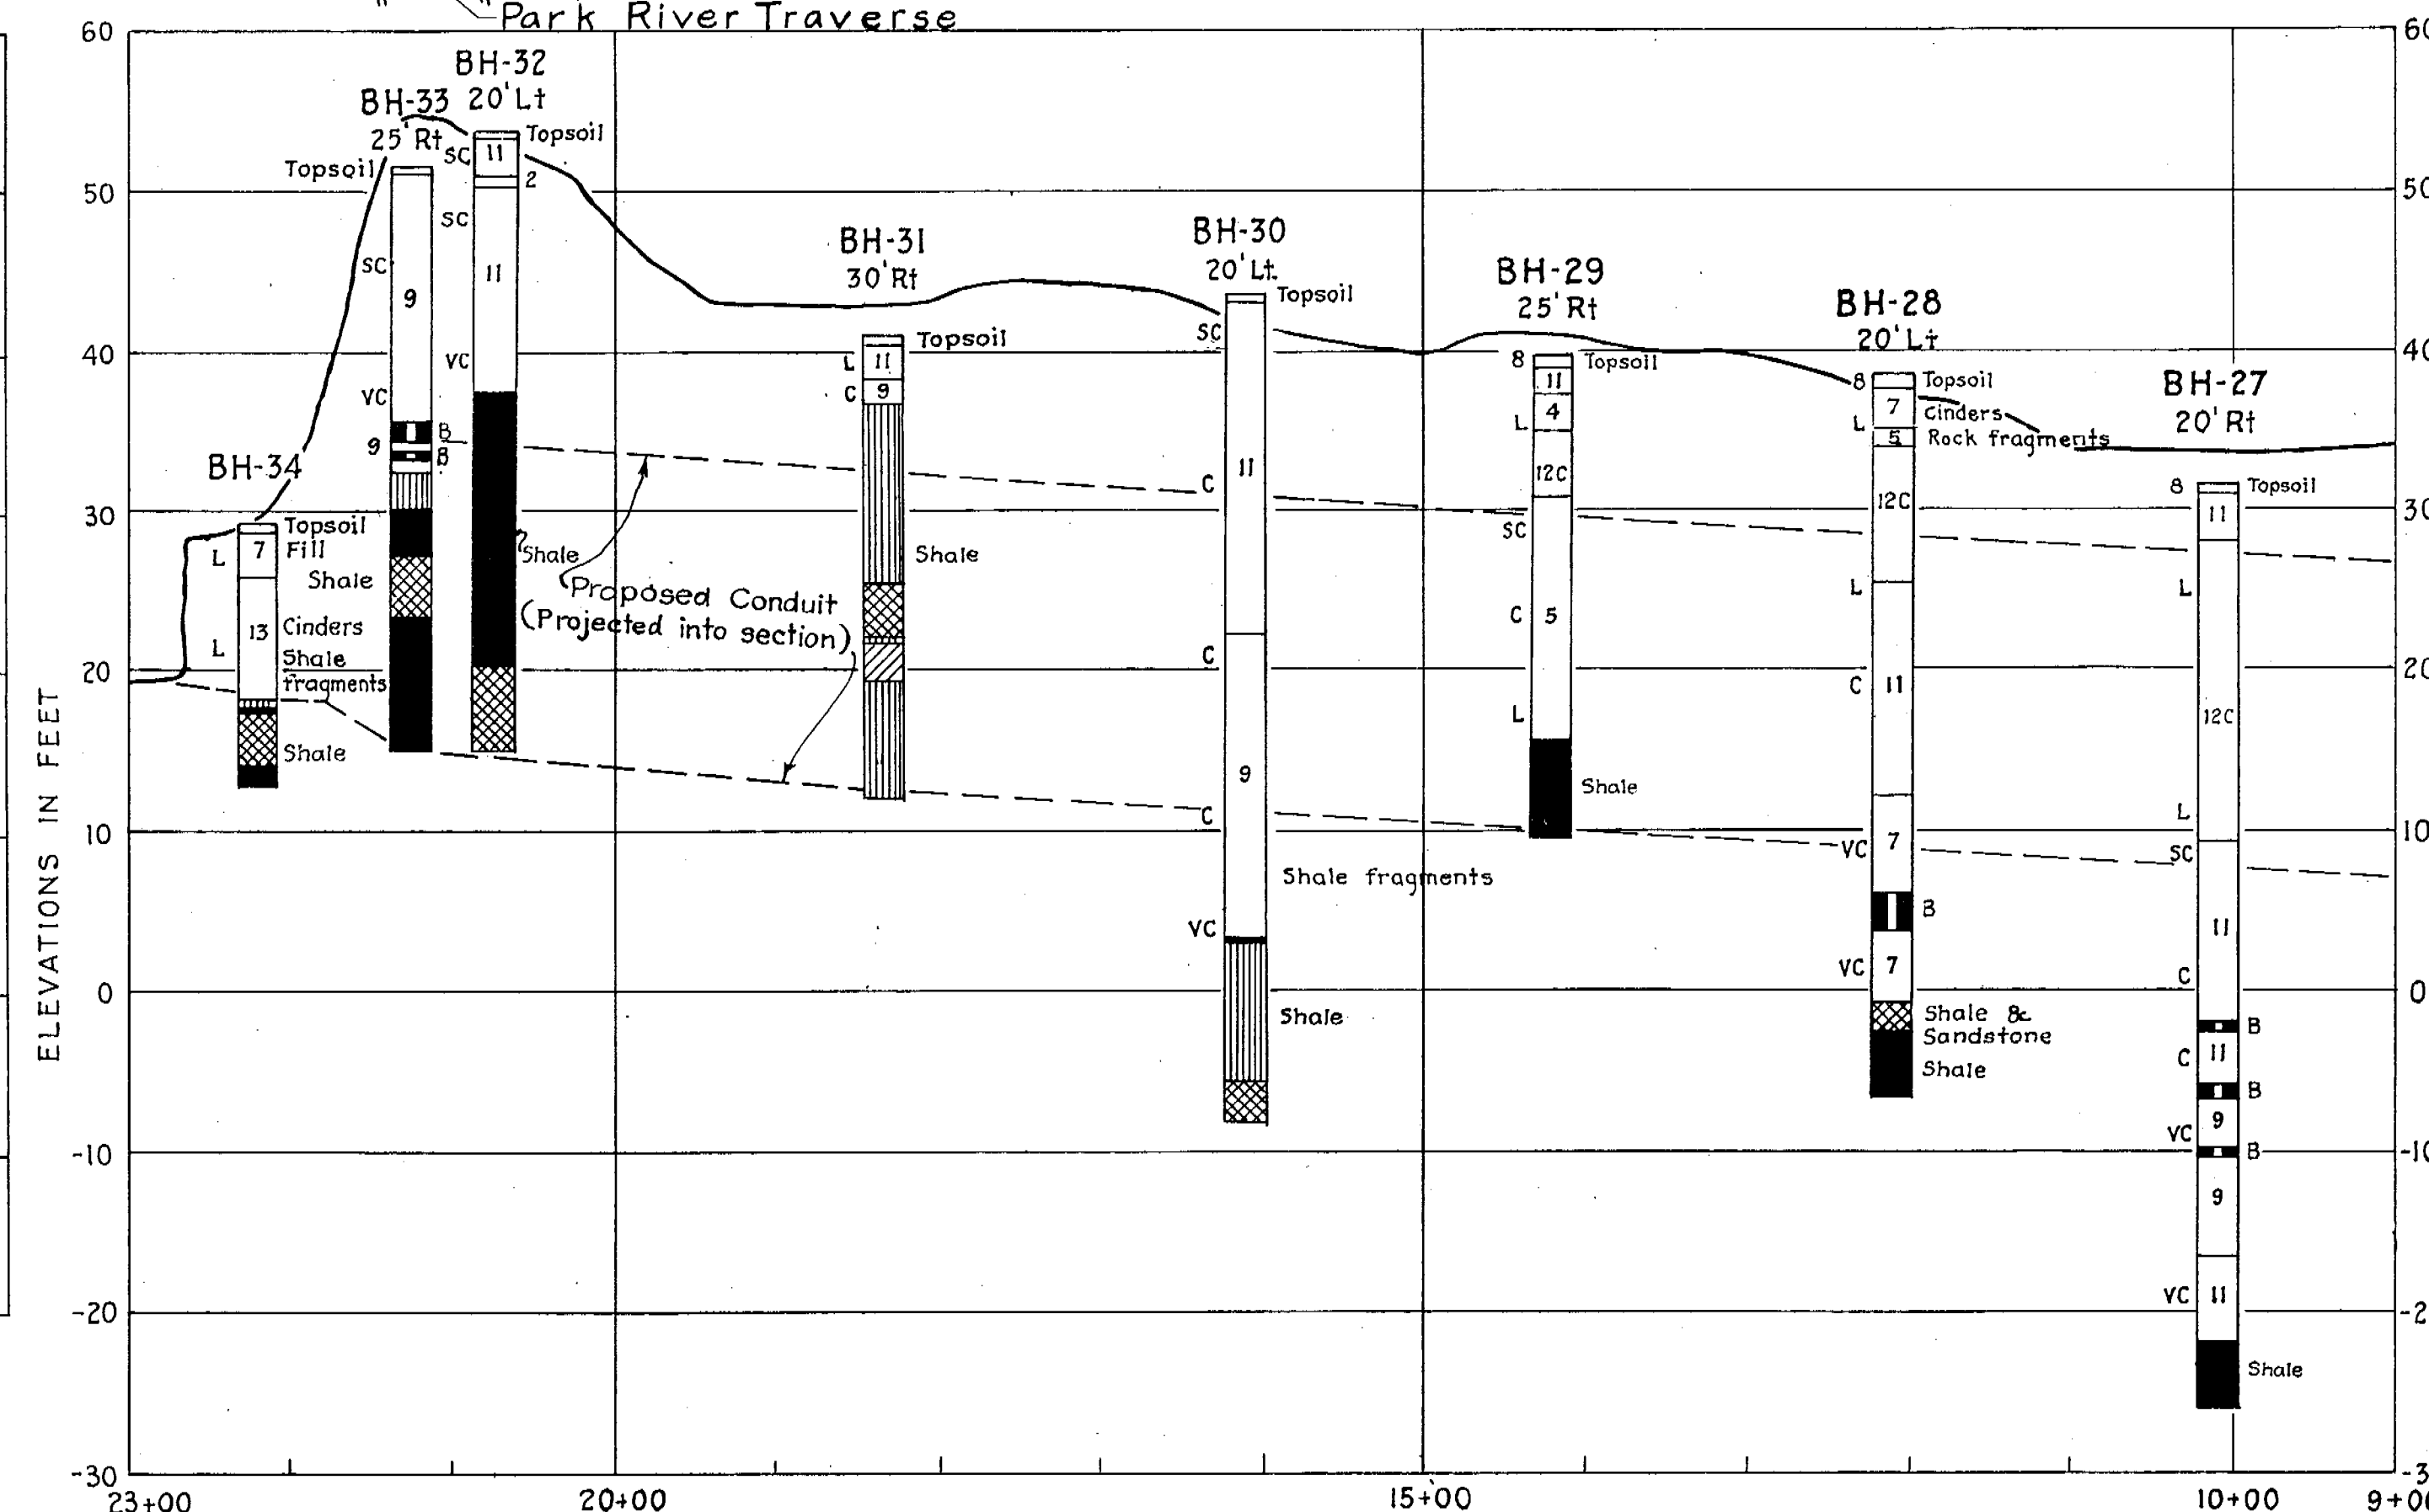

NOTES:
For general notes, legend and description of soil classes, see "Subsurface Explorations No. 2."
⊗ FA indicates foundation auger boring.
Elevations refer to Mean Sea Level Datum.

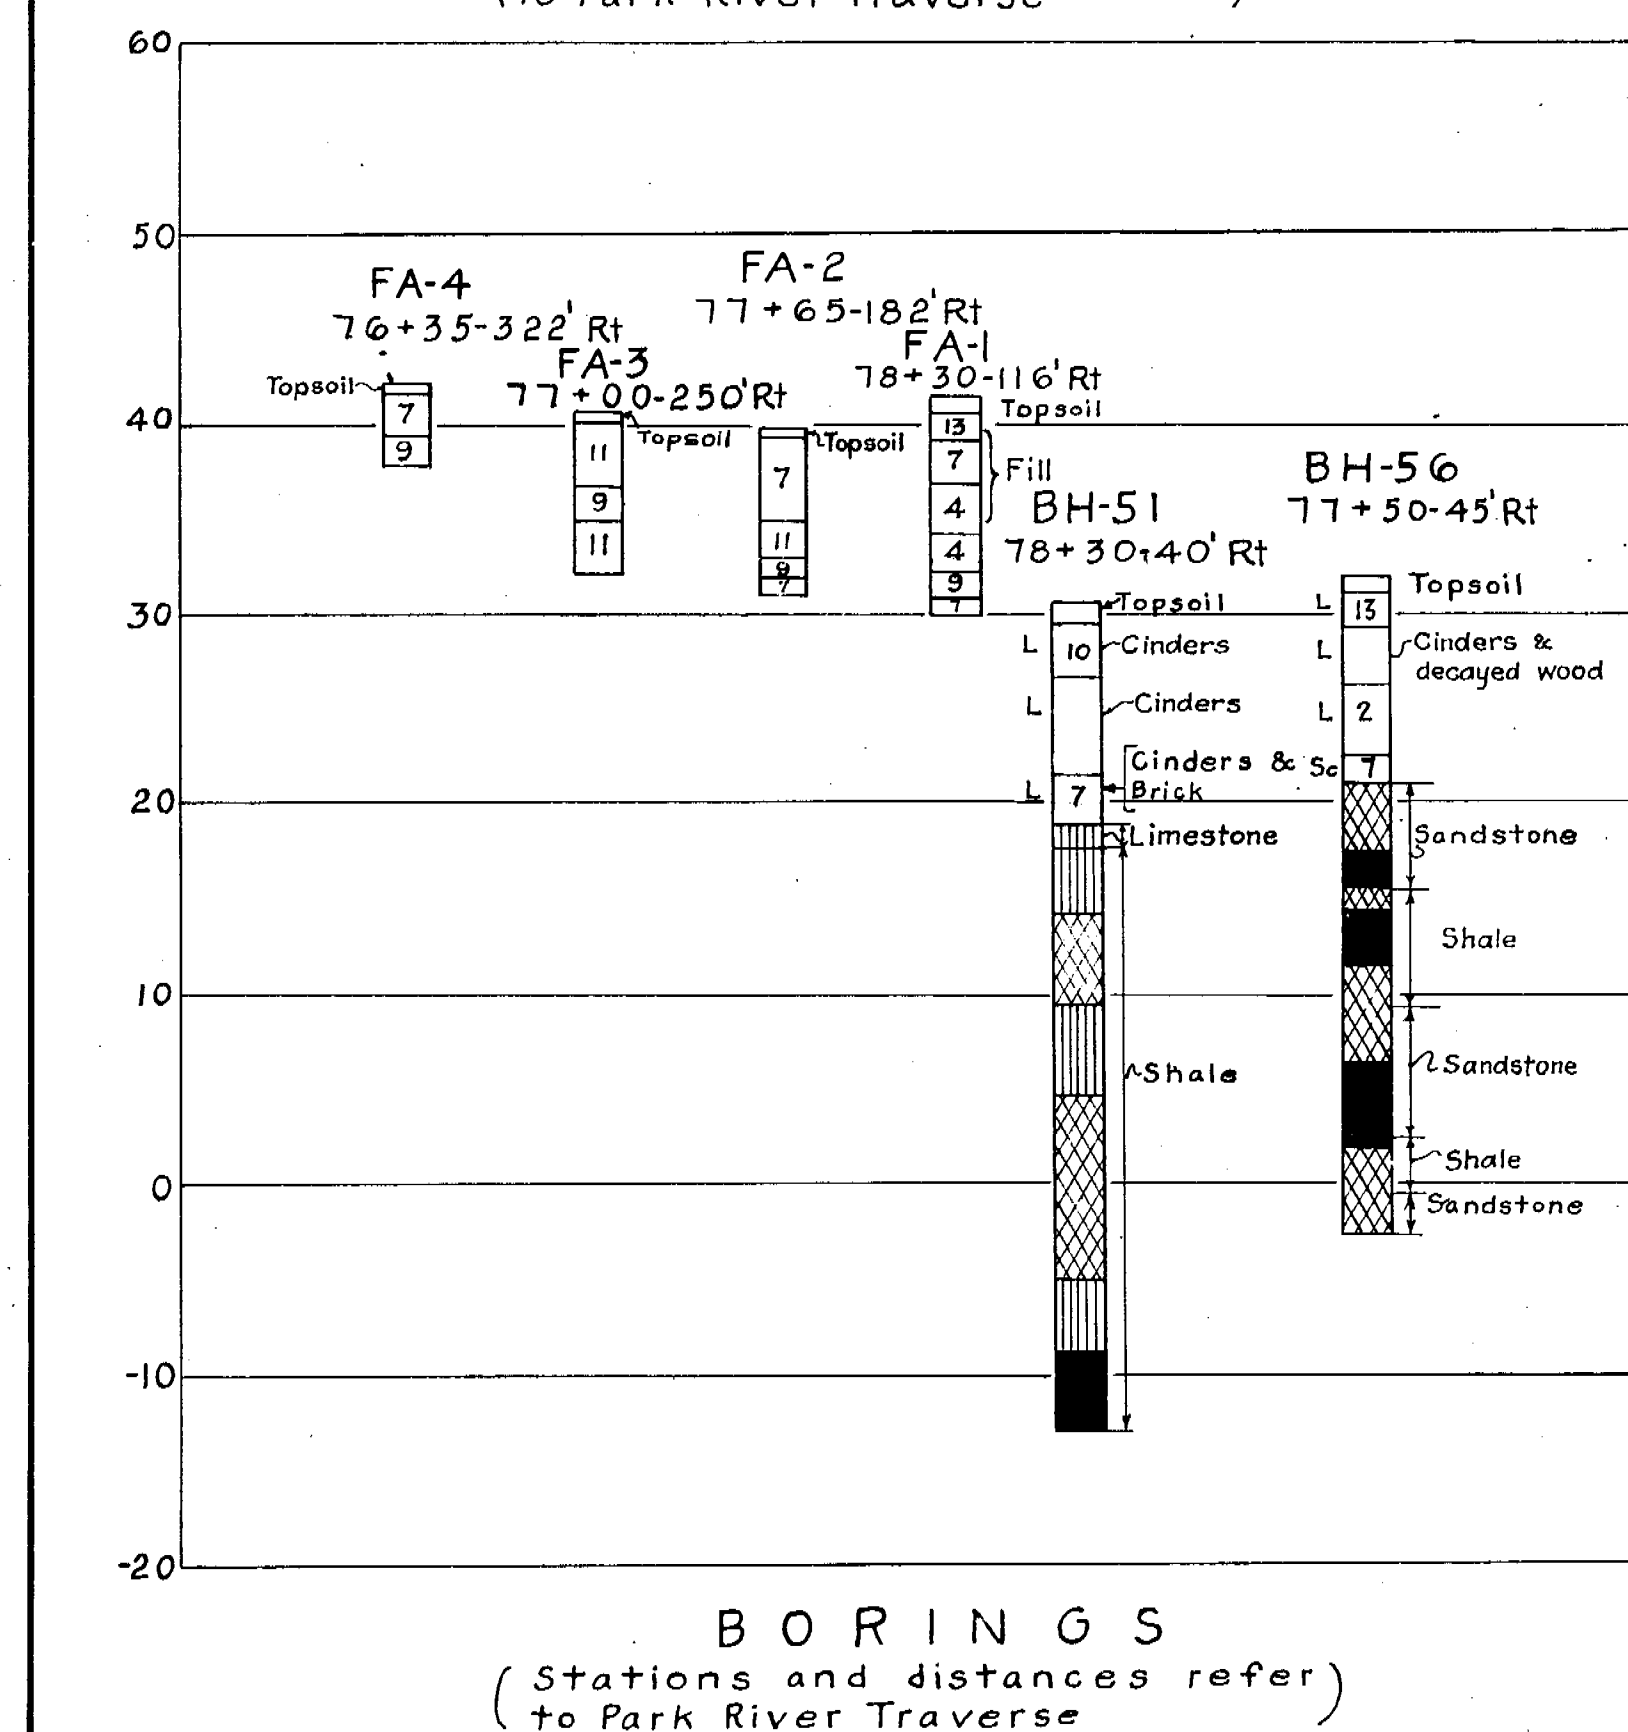

BORINGS
PROFILE ALONG TRAVERSE LINE C

METCALF & EDDY
ENGINEERS
BOSTON, MASS.

(Stations are not the same as the stations of the & of the conduit.)

KEY	DATE	REVISION (Indicated by Δ)	REV. BY	CK. BY	AP. BY
	12-31-45	As built.			

CONNECTICUT RIVER FLOOD CONTROL			
PARK RIVER CONDUIT			
HARTFORD, CONN.			
SUBSURFACE EXPLORATIONS NO. 4			
CONNECTICUT RIVER		CONNECTICUT	
IN 48 SHEETS		SCALE 1" = 100'	
SHEET NO. 8		SHEET NO. 8	
U.S. ENGINEER OFFICE PROVIDENCE, R.I. MAY 1940			
REVIEWED: SENIOR GEOLOGIST HEAD, GEOLOGY SECTION	APPROVAL RECOMMENDED: PRINCIPAL ENGINEER CHIEF E.C. ENGINEERING DIV.	APPROVED: DISTRICT ENGINEER	
SUBMITTED: METCALF & EDDY BOSTON, MASS.	(PARTNER)	DRAWN BY: E.S.B. TRACED BY: E.S.B. CHECKED BY: P.W.T.	FILE NO. CT-2-1289