



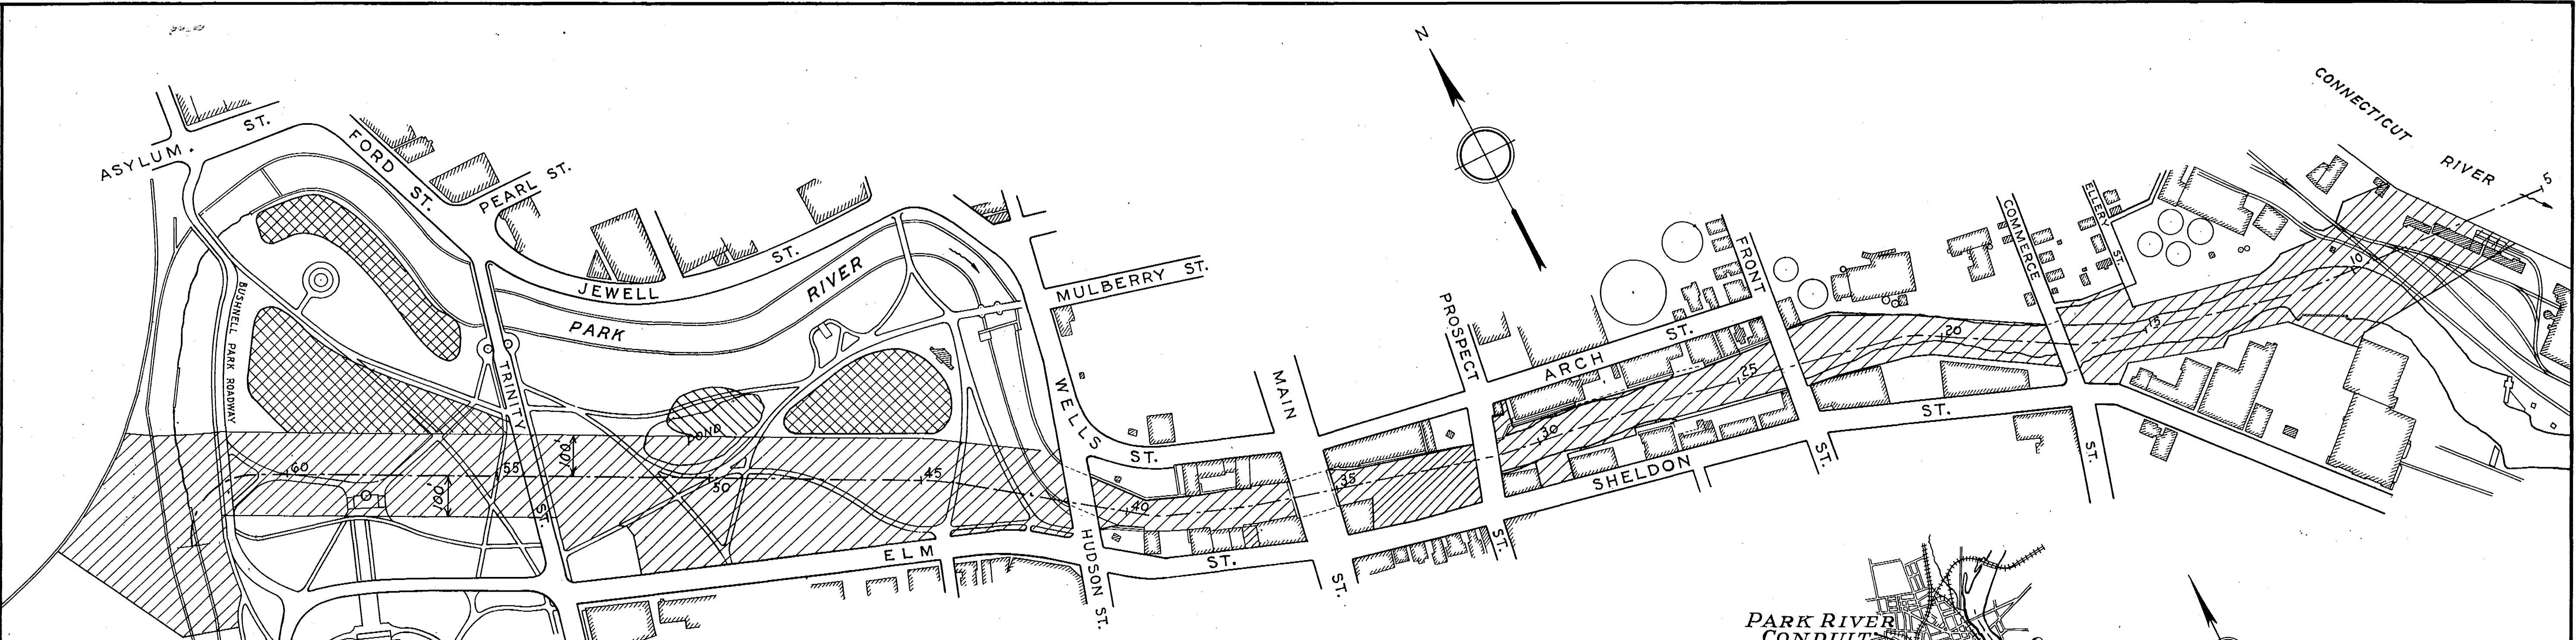

PLAN
SCALE: 1" = 200'

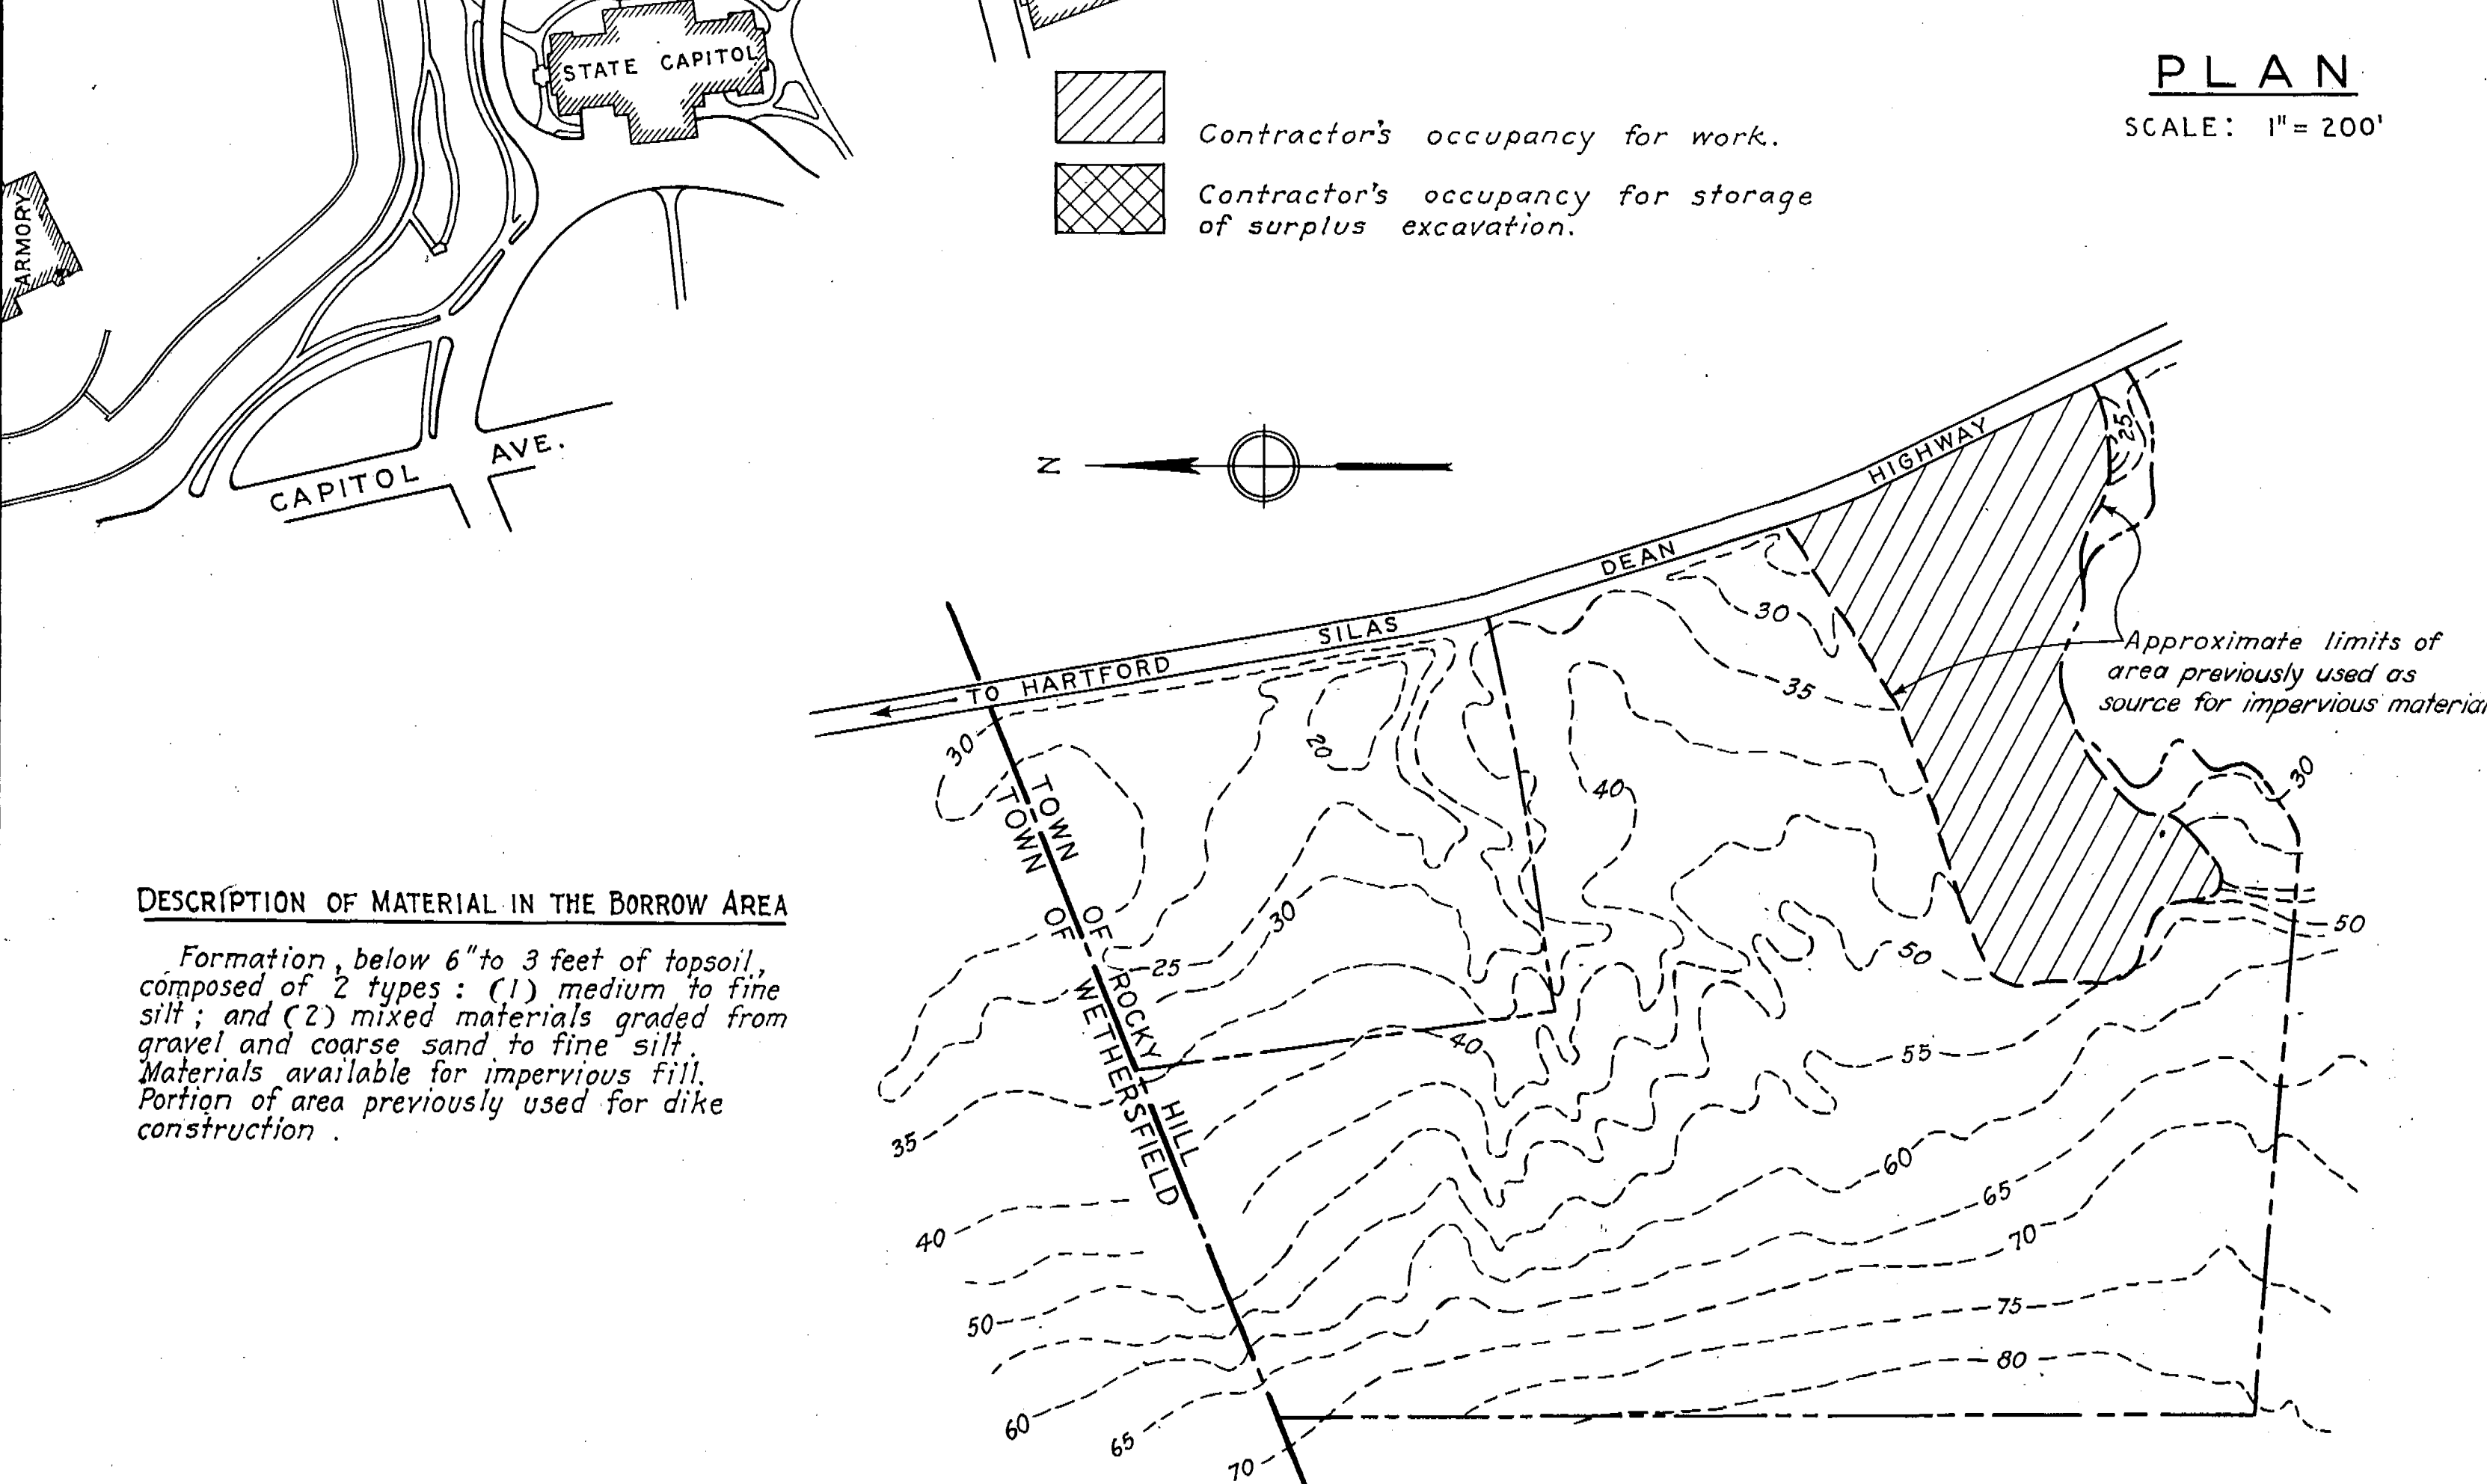


BORROW AREA H
SCALE: 1" = 200'

DESCRIPTION OF MATERIAL IN THE BORROW AREA

Formation, below 6" to 3 feet of topsoil, composed of 2 types: (1) medium to fine silt; and (2) mixed materials graded from gravel and coarse sand to fine silt. Materials available for impervious fill. Portion of area previously used for dike construction.

METCALF & EDDY
ENGINEERS
BOSTON, MASS.

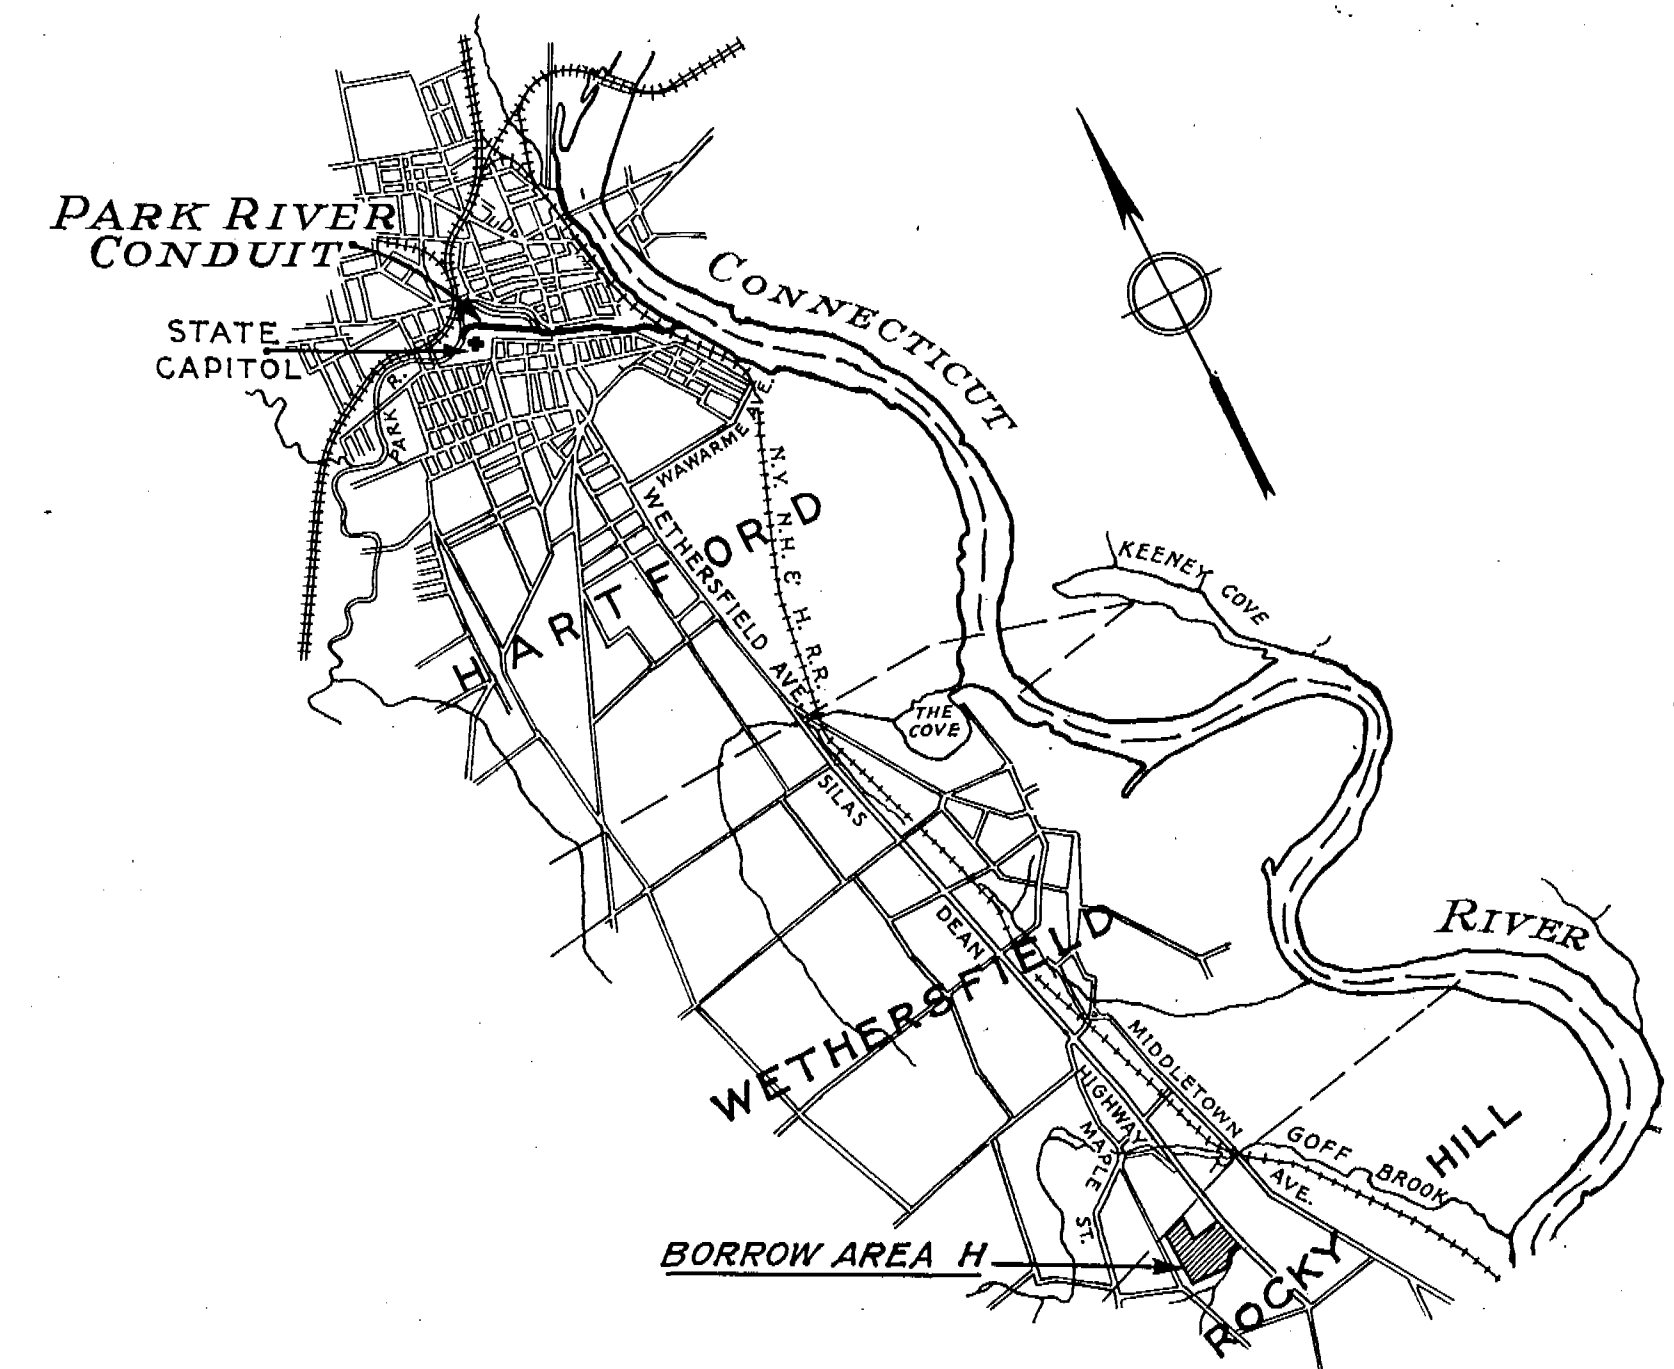

LOCATION MAP
SCALE: 1 IN. = 1 MI.

CONNECTICUT RIVER FLOOD CONTROL			
PARK RIVER CONDUIT			
HARTFORD, CONN.			
CONTRACTORS WORK AREAS			
CONNECTICUT RIVER		CONNECTICUT	
IN 48 SHEETS		SCALE: 1 IN. = 200 FT. SHEET NO. 9	
U.S. ENGINEER OFFICE PROVIDENCE, R.I. MAY 1940			
REVIEWED: H.W. Hamer ENGINEER DESIGN SECTION	APPROVAL RECOMMENDED: H.W. Hamer PRINCIPAL ENGINEER CHIEF E.C. ENGINEERING DIV.	APPROVED: H.W. Hamer LTCOL. CORPS OF ENGINEERS DISTRICT ENGINEER	
SUBMITTED: H.W. Hamer METCALF & EDDY BOSTON, MASS.	(PARTNER)	DRAWN BY: H.C.T. TRACED BY: H.C.T. CHECKED BY: P.W.T.	FILE NO. CT-4-2607

KEY	DATE	REVISION (Indicated by Δ)	REV. BY	CK. BY	AP. BY
	12-31-45	As built.			