



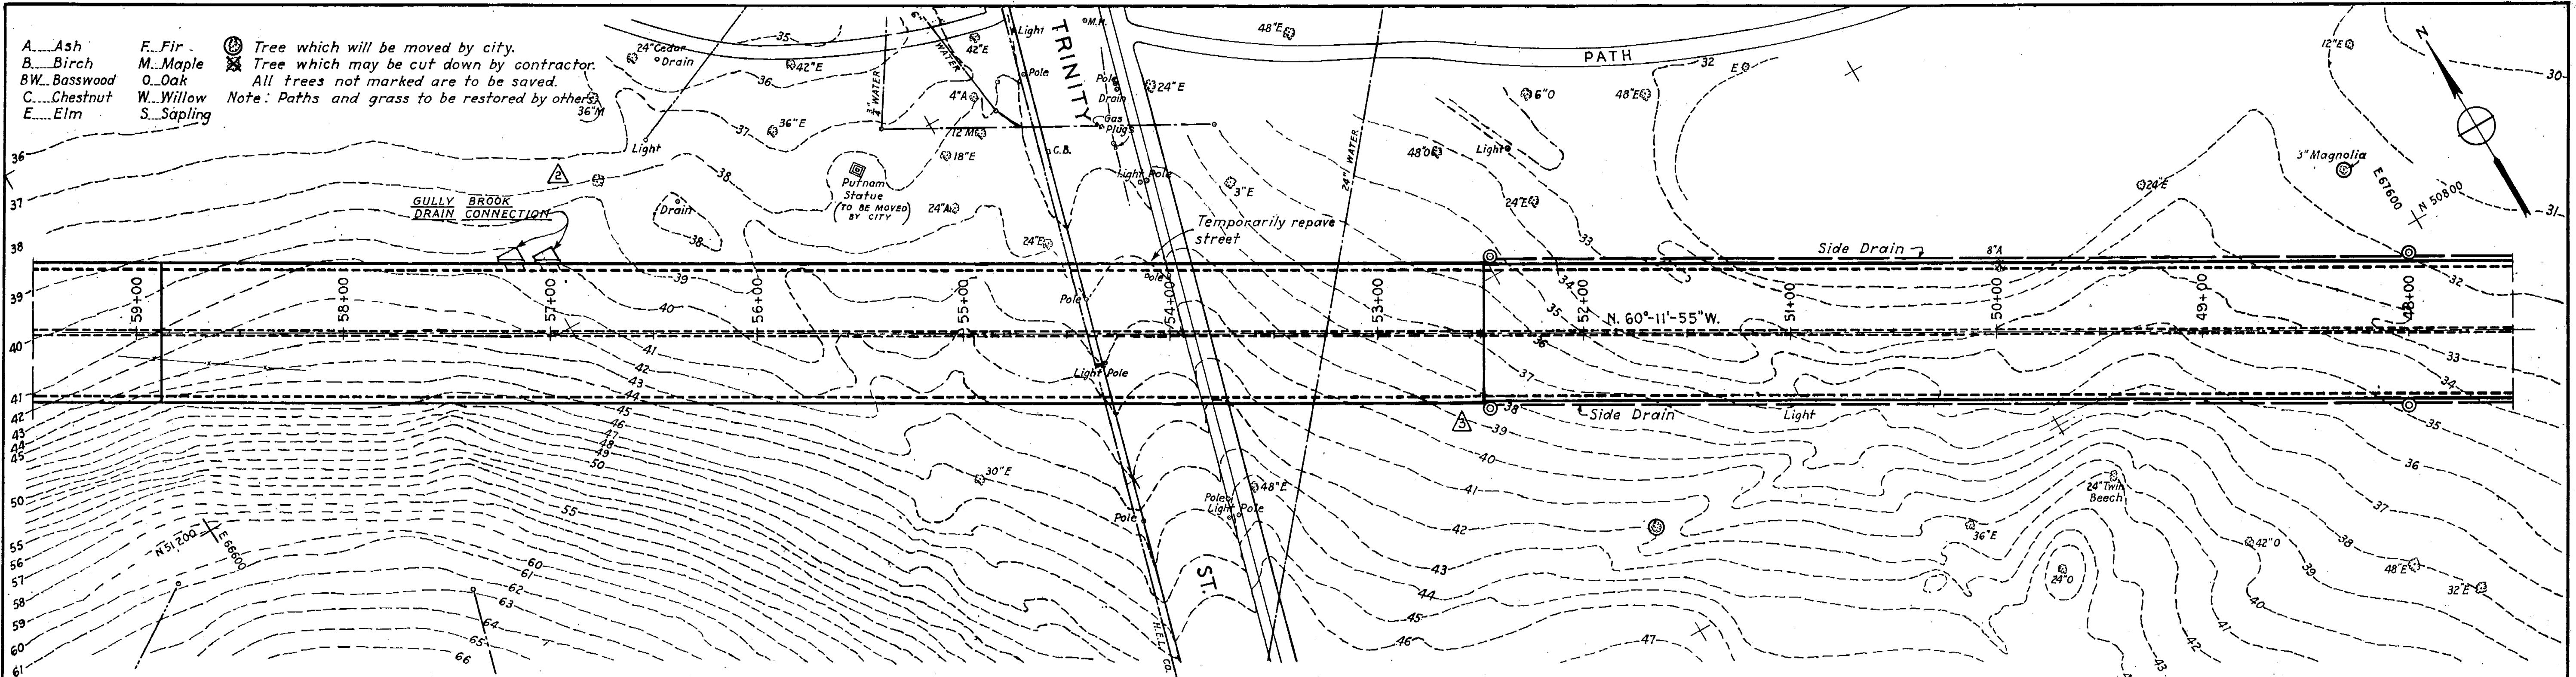

PLAN

SCALE 1"=40'

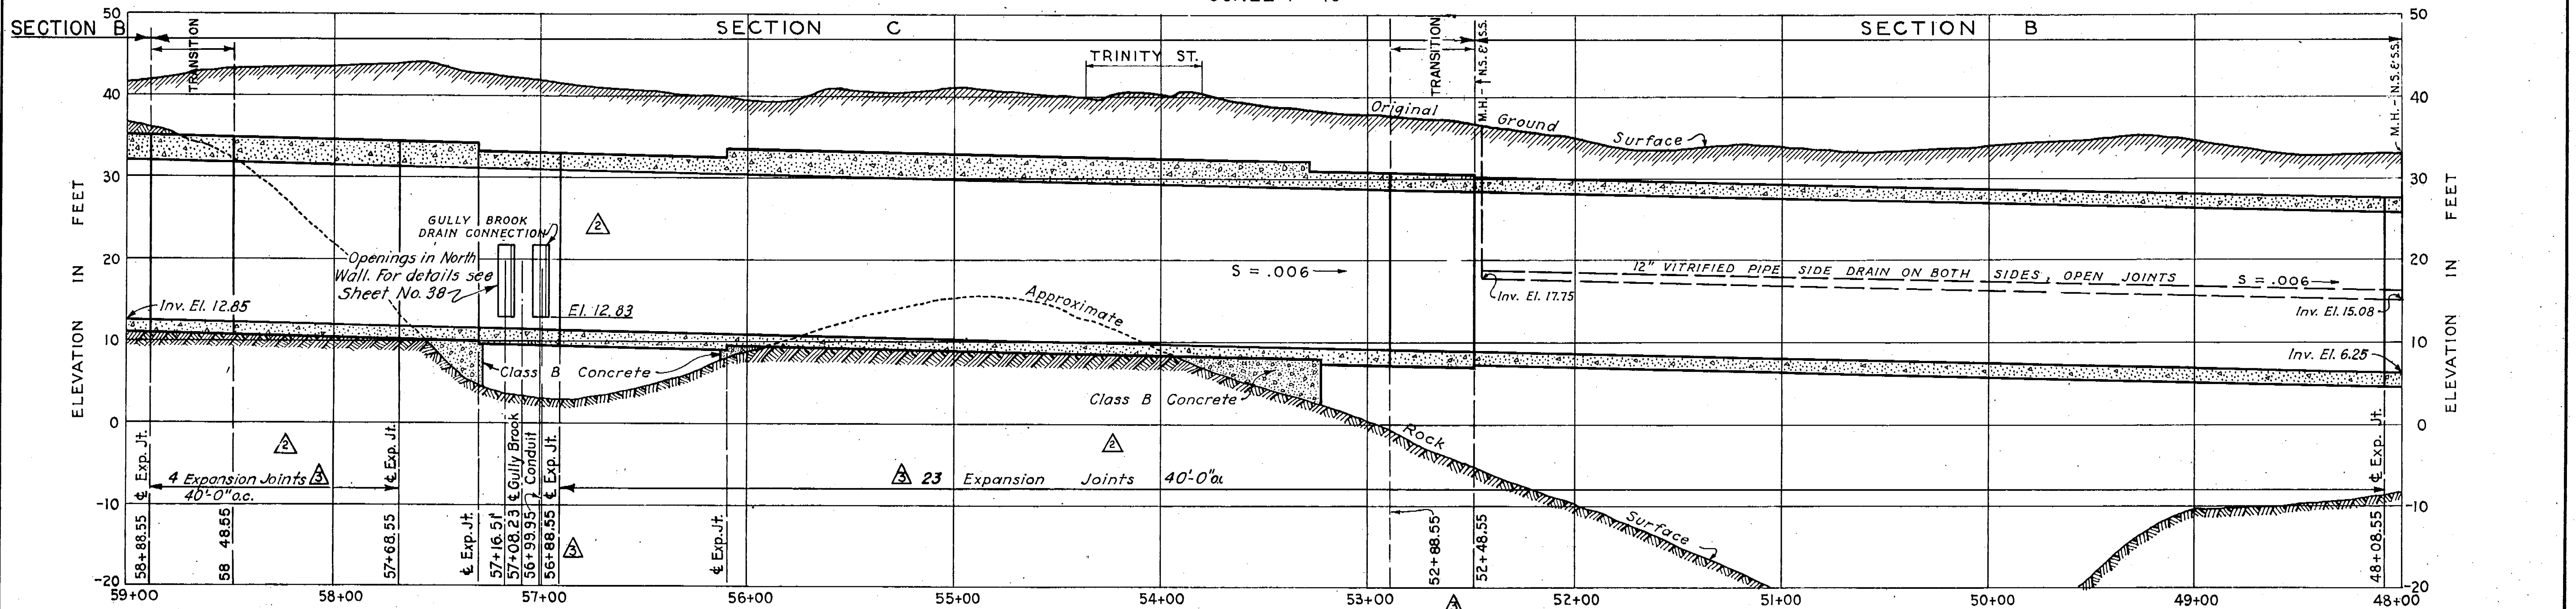

PROFILE

SCALE HOR. 1"=40'
VERT. 1"=10'

NOTES
For general notes applying to details shown on this sheet, see Sheet No. 10.
See legend on Sheet No. 10.
For detail of treatment at earth-rock junction see Sheet No. 36.

CONNECTICUT RIVER FLOOD CONTROL
PARK RIVER CONDUIT
HARTFORD, CONN.

PLAN AND PROFILE NO. 5

CONNECTICUT RIVER CONNECTICUT
IN 48 SHEETS SCALE 1 IN. = 40 FT. SHEET NO. 14
U.S. ENGINEER OFFICE PROVIDENCE, R.I. MAY 1940

REVIEWED: *[Signature]* APPROVAL RECOMMENDED: *[Signature]* APPROVED: *[Signature]*
F.C. DESIGN SECTION PRINCIPAL ENGINEER LT. COL. CORPS OF ENGINEERS DISTRICT ENGINEER
SUBMITTED: *[Signature]* (PARTNER) DRAWN BY: H.C.T. FILE NO. CT-4-2612
METCALF & EDDY TRACED BY: H.C.T.
BOSTON, MASS. CHECKED BY: F.A.

METCALF & EDDY
ENGINEERS
BOSTON, MASS.

12-31-45	As built revisions			
2-17-41	Transitions and opening changed	✓	✓	218
11-22-40	Openings and Exp. Joints	P.C.H.	K.B.N.	248
KEY	DATE	REVISION (indicated by Δ)	REV. BY	CK. BY