
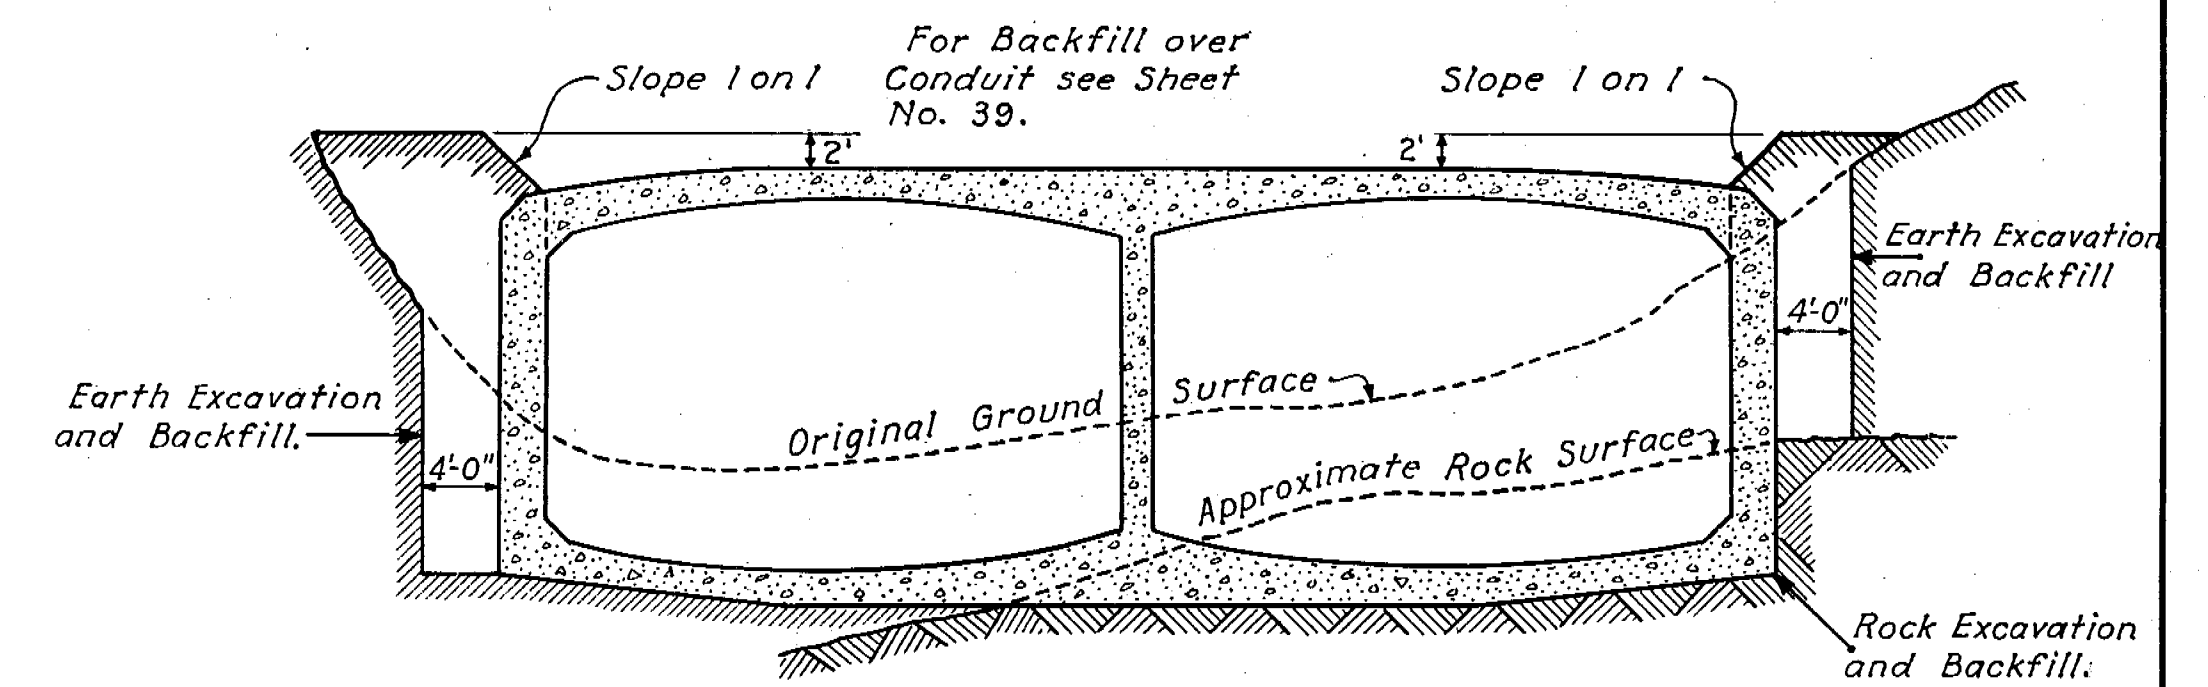 




SCALE 1" = 10'

A horizontal graphic scale bar. It is divided into two main sections. The left section, from 0 to 10 feet, has a black and white checkerboard pattern. The right section, from 10 to 20 feet, is solid black. Tick marks are present at 0, 10, and 20 feet. The text "SCALE 1\" = 10'" is centered above the bar.

PROFILE $\triangle 5$
SCALE HOR. 1" = 40'
VERT. 1" = 10'

PLAN AND PROFILE NO. 6

U.S. ENGINEER OFFICE PROVIDENCE, R.I. MAY 1940

F.C. DESIGN SECTION		CHIEF F.C. ENGINEERING DIV.	DISTRICT ENGINEER
SUBMITTED: <i>Arthur L. Shaw</i> METCALF & EDDY BOSTON, MASS.		(PARTNER) DRAWN BY: H.C.T. TRACED BY: H.C.T. CHECKED BY: P.W.T.	FILE NO. CT-4-2613

	12-31-45	As built revisions			
Δ	7-10-41	Embankment and Conduit grades changed	E.D.C.	J.C.S.	23B
Δ	11-22-40	Expansion Joint and Note	R.C.H.	J.C.S.	28B
KEY	DATE	REVISION (Indicated by Δ)	REV.	CK BY	AR BY

NOTES
For general notes applying to details shown on this sheet, see Sheet No. 10.
See legend on Sheet No. 10.
The center wall of Section B between Stations 59+38.55 and 62+48.55 is to be 24" thick instead of 22".
Radius of curves and details of inlet may be modified as the result of pending model tests.