



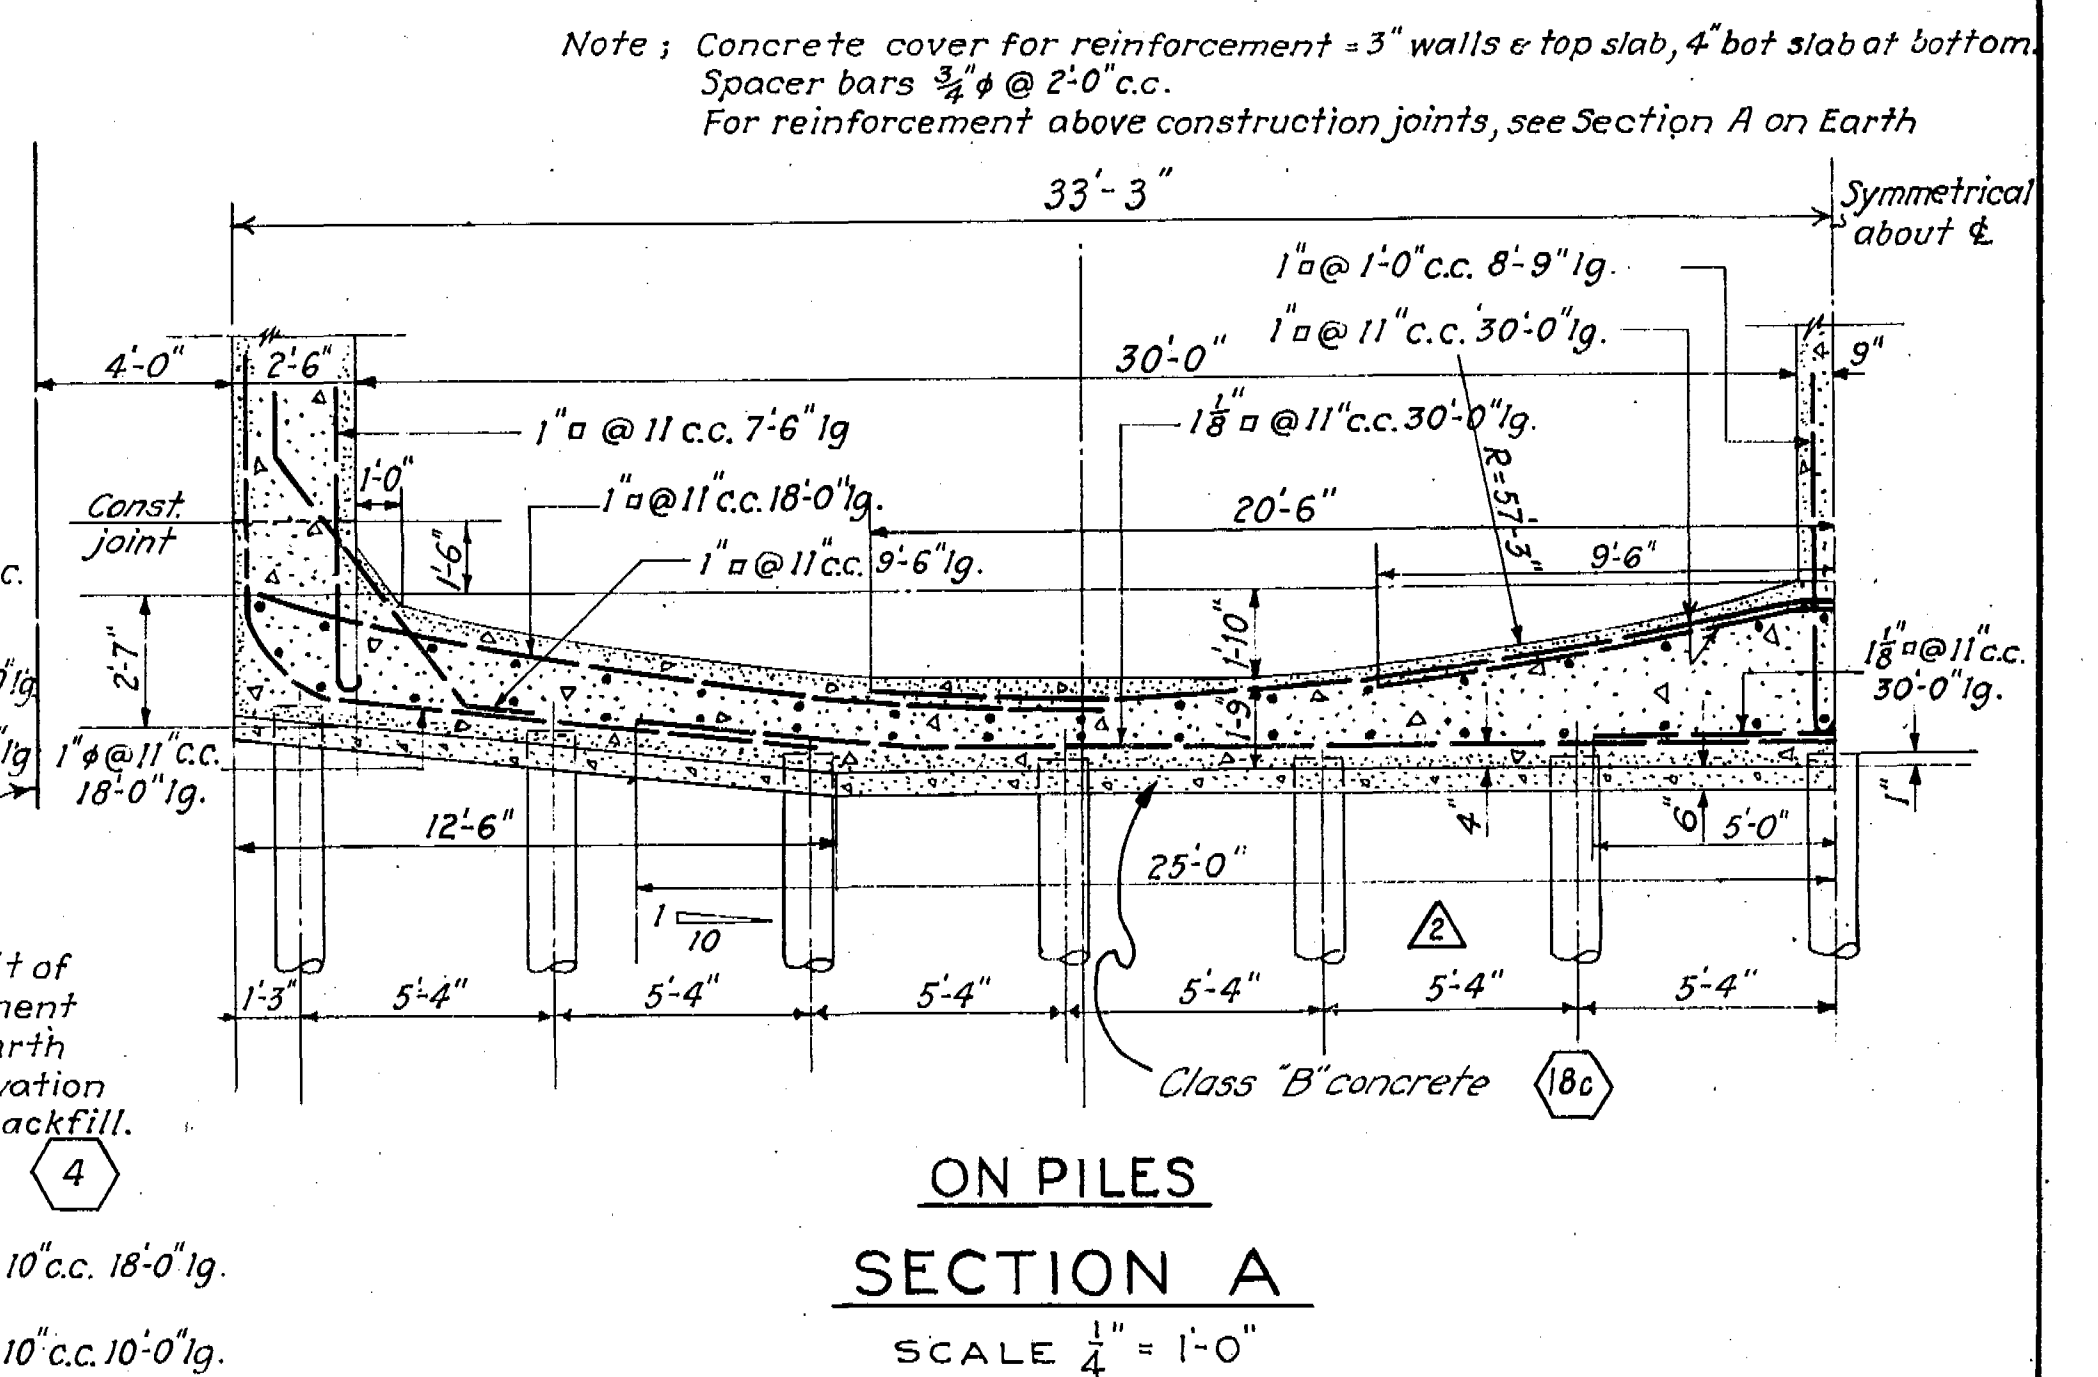

ON PILES
SECTION A
SCALE $\frac{1}{4}'' = 1'-0''$

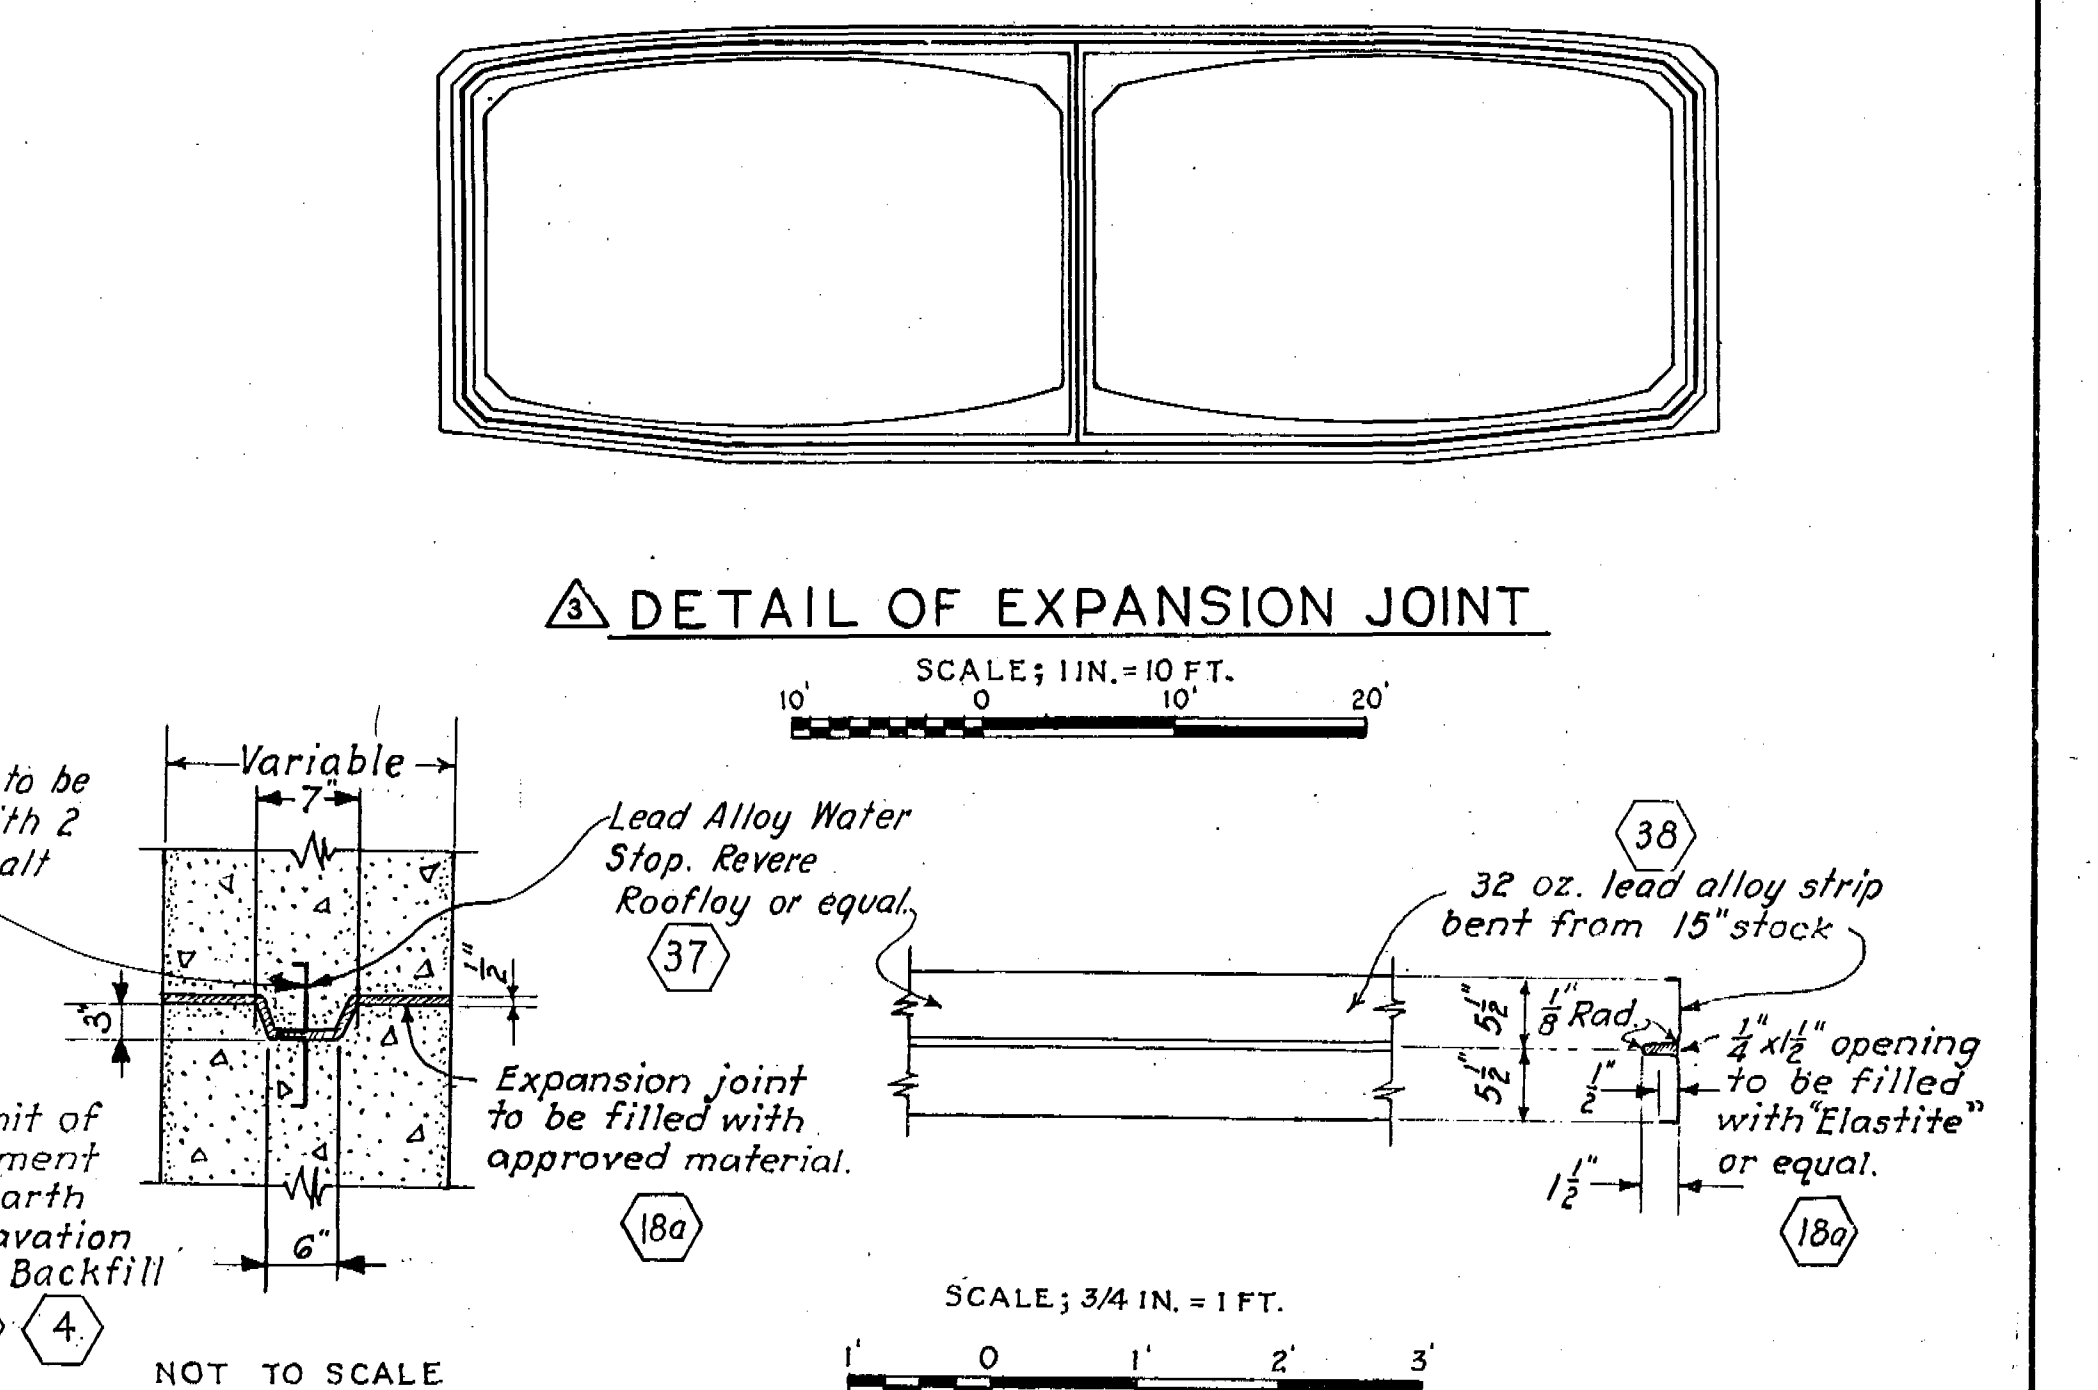

9 DETAIL OF EXPANSION JOINT AND WATER STOP

	12-31-45	As built revisions			
⚠	2-17-41	Top center wall fillet added.	ICD	MAJ	JM
⚠	7-14-42	Water stop revised.	E.P.C.	ICD	JM
⚠	11-22-40	Class "B" concrete Sect A and Notes	ICD	K.B.N.	JM
KEY	DATE	REVISION (Indicated by Δ)	REV. BY	CK. BY	AP. BY

METCALF & EDDY
 BOSTON, MASS.