


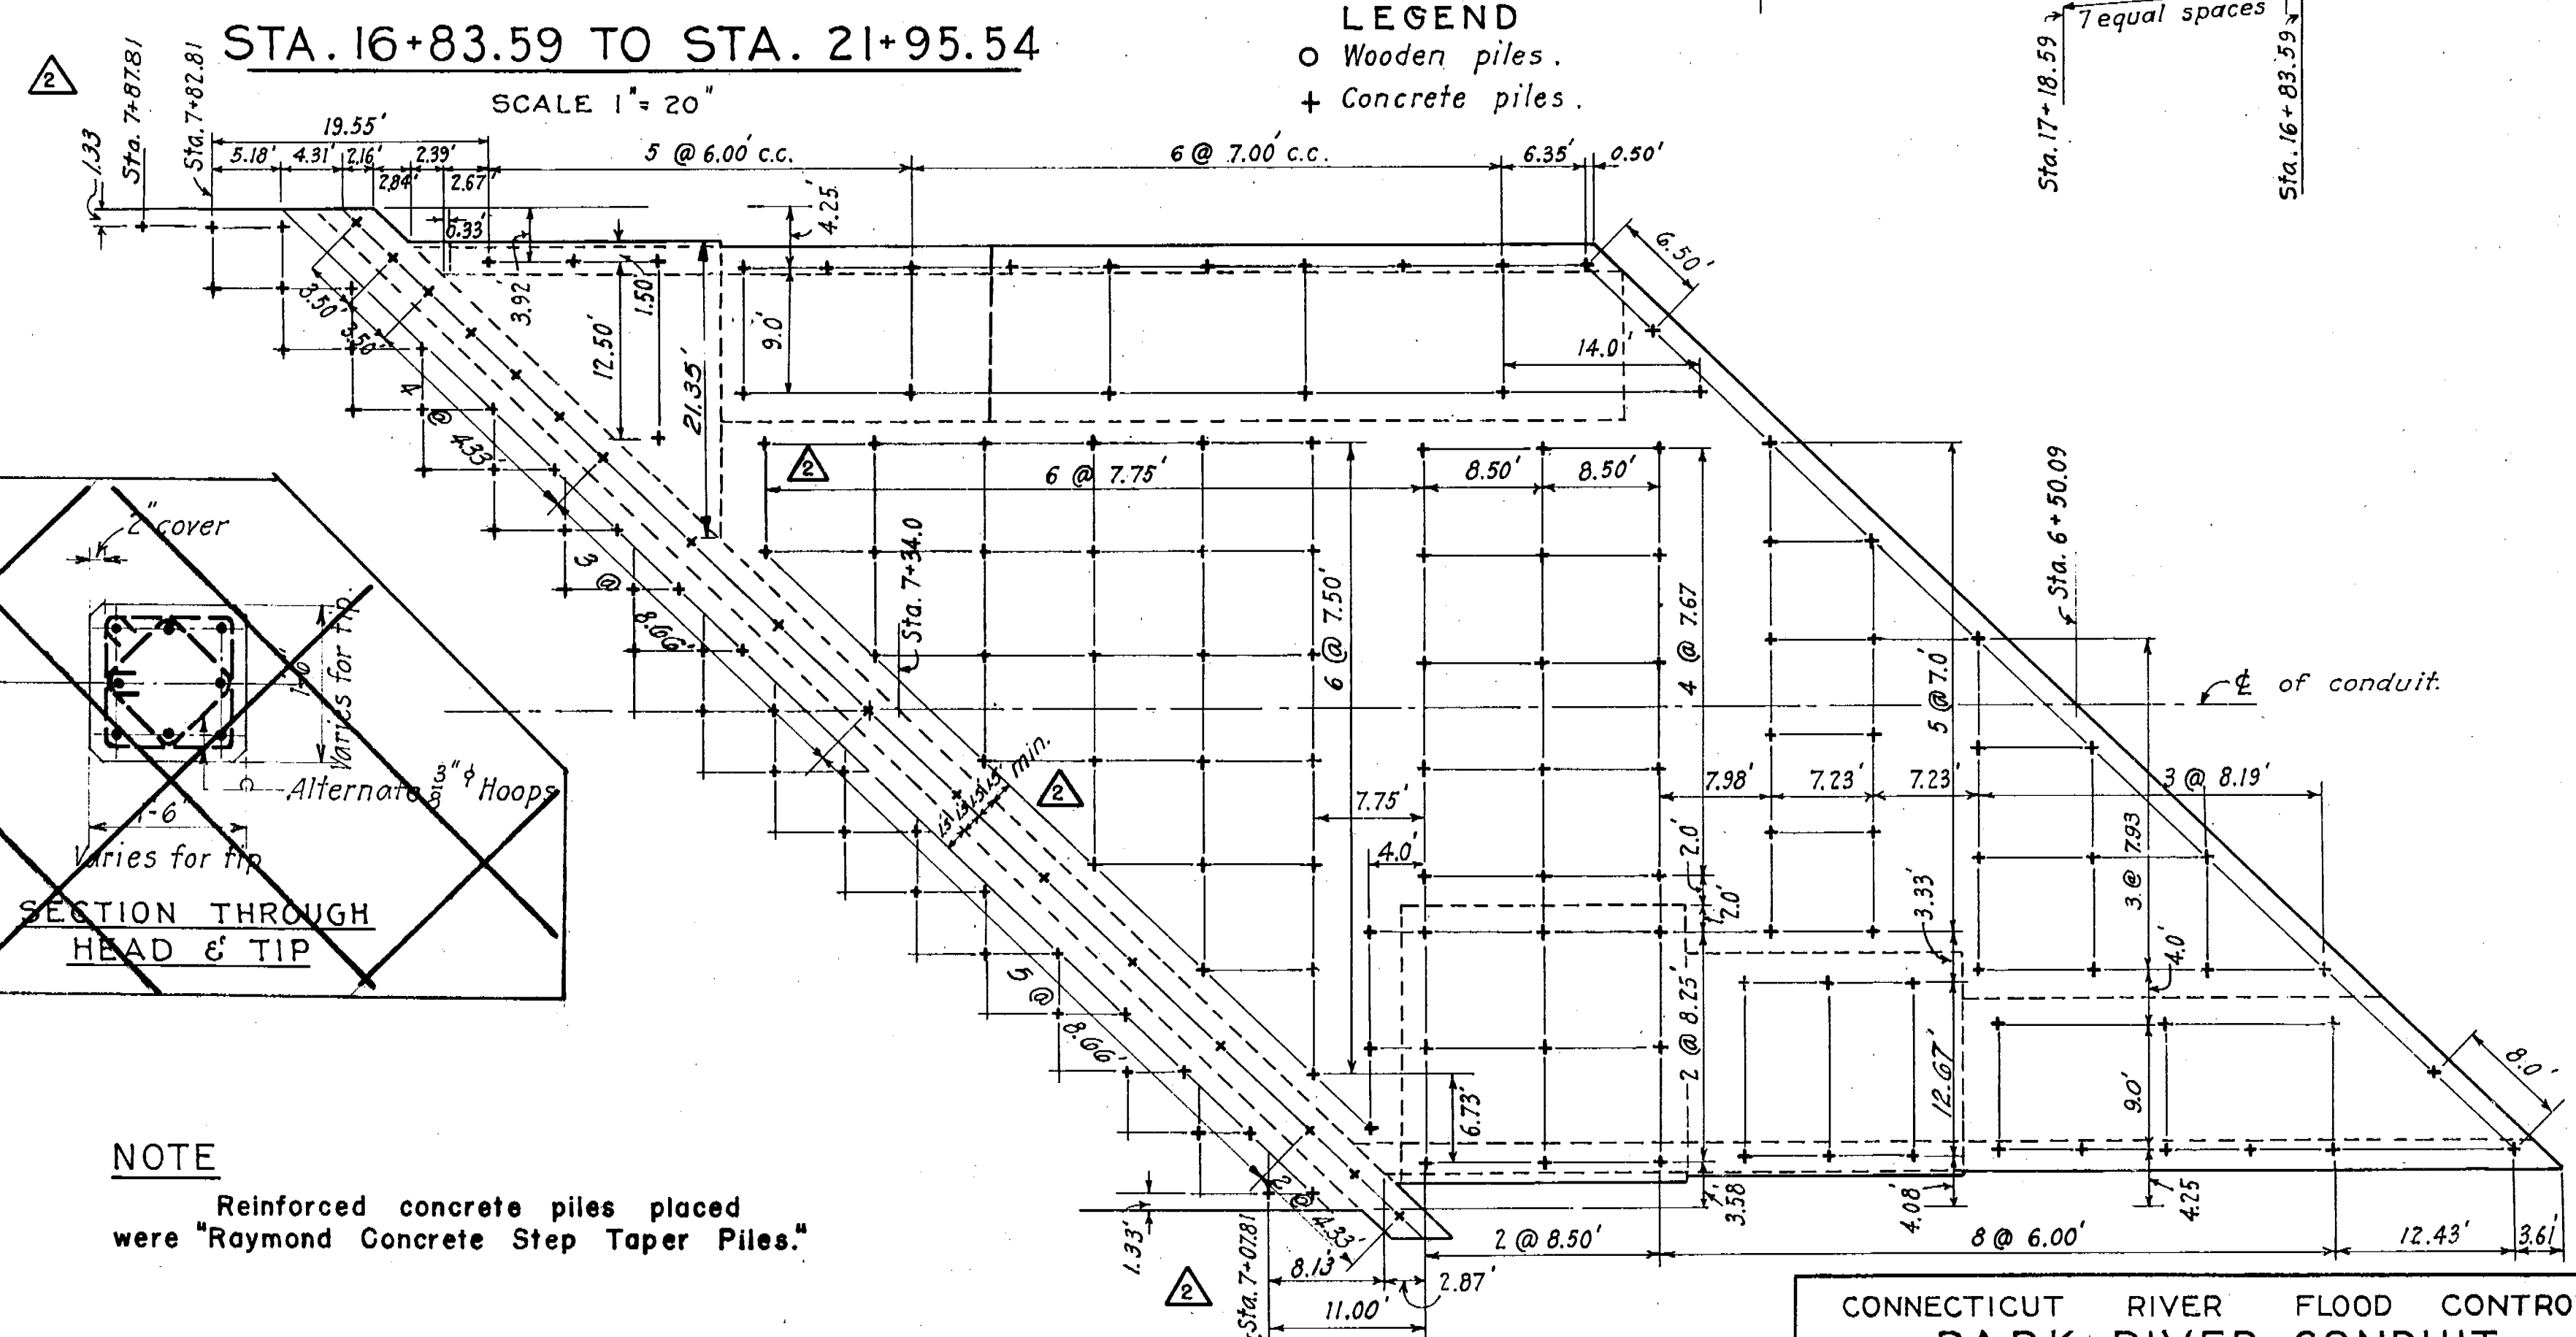

PILE LENGTH IN FEET	LONGITUD. REINFORC.
20	$8 - 5/8"$
25	$8 - 5/8"$
30	$8 - 5/8"$
35	$8 - 3/4"$
40	$8 - 3/4"$
45	$8 - 7/8"$
50	$8 - 7/8"$


NOTES:

For lengths between those shown, use bars indicated for next higher length.

In handling piles from horizontal position, attach slings at two points at $\frac{1}{3}$ the length from each end.

Spiral reinforcement of approved size and spacing may be substituted for the hoops shown.

PILE LOCATION AT OUTLET

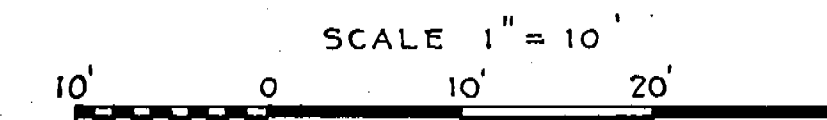

	12-31-45	As built revisions							
Ⓔ	11-22-40	Dimensions changed			P.C.H.	K.B.N.	782		
KEY	DATE	REVISION (Indicated by Δ)	REV. BY	CK. BY	AP. BY				

CONNECTICUT RIVER		FLOOD CONTROL	
PARK RIVER CONDUIT			
HARTFORD, CONN.			
PILING NO. 2			
CONNECTICUT RIVER		CONNECTICUT	
IN 48 SHEETS. SCALE, 1 IN. = 20 FT. SHEET NO. 19			
			
U.S. ENGINEERING OFFICE PROVIDENCE, R.I.		MAY 1940	
REVIEWED: <i>W. S. Hauer</i> ENGINEER P.C. DESIGN SECTION	APPROVAL RECOMMENDED: <i>W. S. Hauer</i> PRINCIPAL ENGINEER CHIEF P.C. ENGINEERING DIV.	APPROVED: <i>W. S. Hauer</i> LT. COL. CORPS OF ENGINEERS DISTRICT ENGINEER	
SUBMITTED: <i>William L. Eddy</i> METCALF & EDDY BOSTON, MASS.	(PARTNER)	DRAWN BY: F.F. TRACED BY: C.W.R. CHECKED BY: F.W.T.	FILE NO. CT-4-2617