



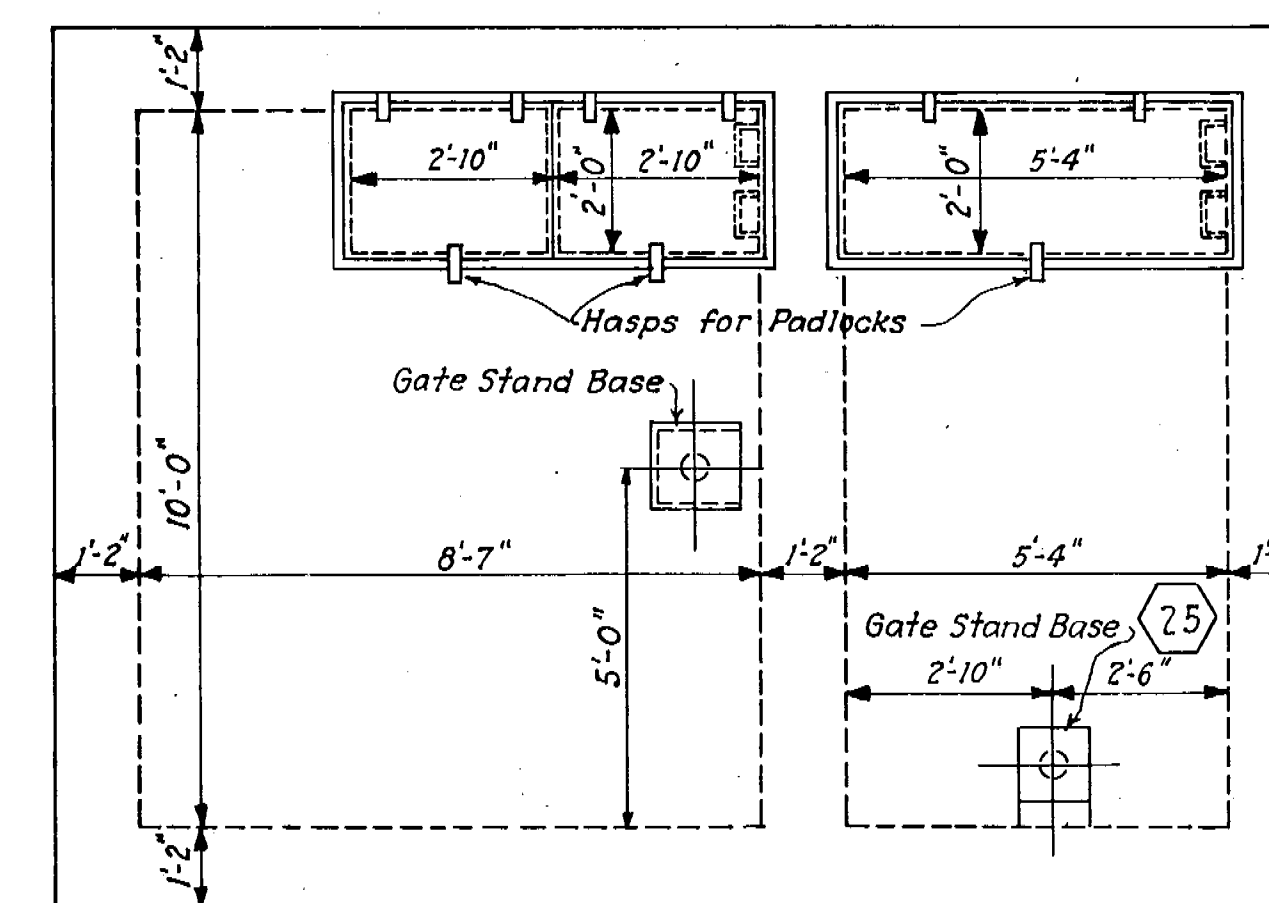


SCALE $3/8" = 1'-0"$


SCALE $3/8" = 1'-0"$

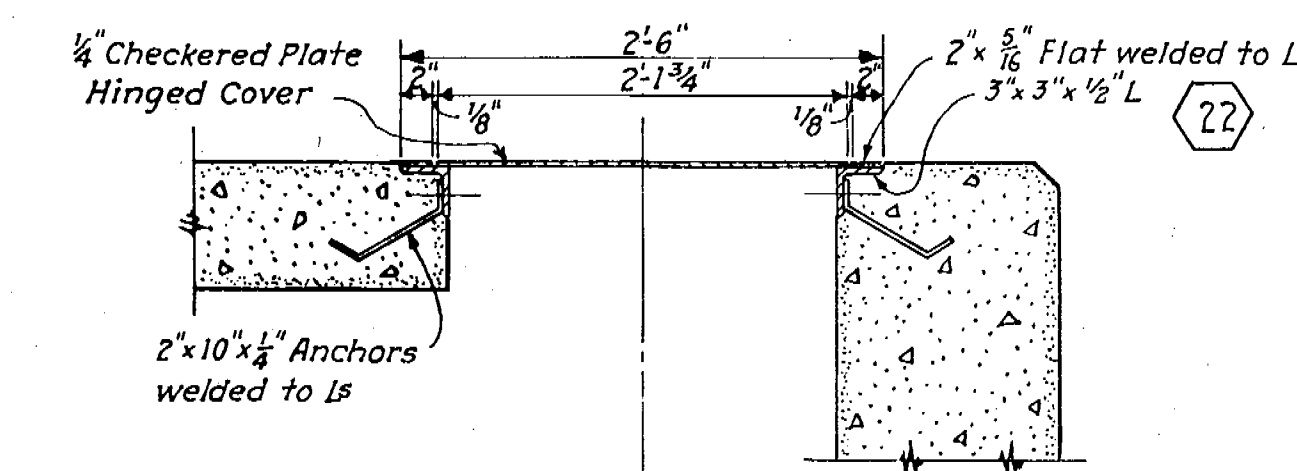


SCALE 1" = 1'-0"

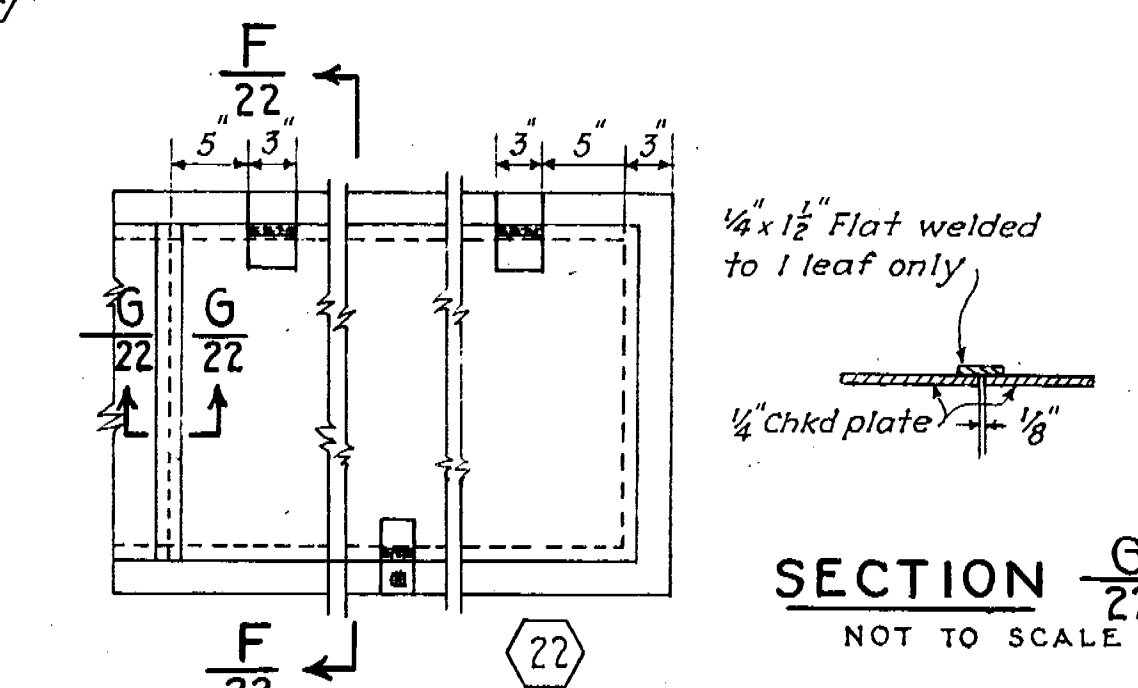

SCALE 1" = 1'-0"

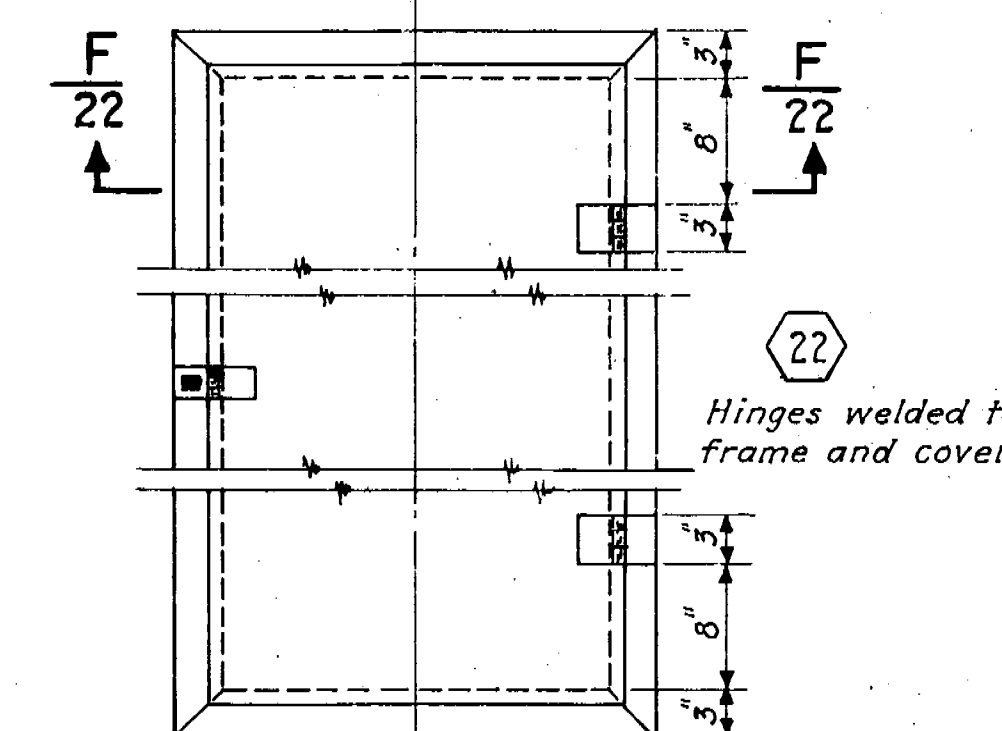

SCALE; 1 IN. = 1 FT.

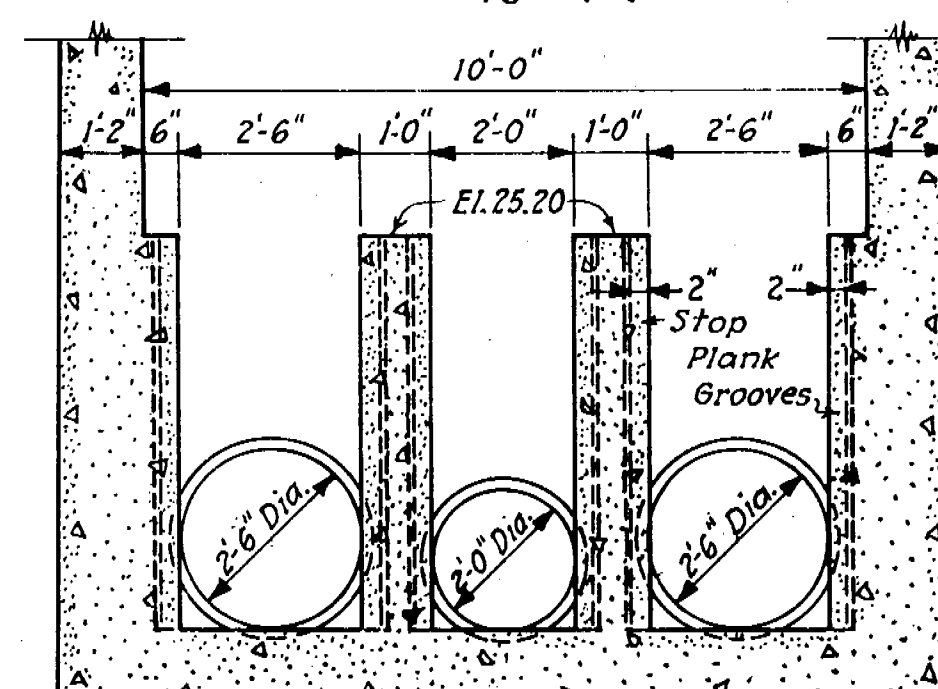

SECTION $\frac{E}{22}$
SCALE $3/8" = 1'-0"$

	12-31-45	As built			
Ⓐ	4-22-42	Delete special bell details	E.P.H.	GC	783
Ⓐ	2-17-41	Grout recess added.	J.C.S.	FW	783
KEY	DATE	REVISION (Indicated by Δ)	REV. BY	CK. BY	AP. BY

REVIEWED BY: <u>W. J. Homan</u> ... ENGINEER F.C. DESIGN SECTION		APPROVAL RECOMMENDED: <u>W. J. Homan</u> ... PRINCIPAL ENGINEER CHIEF F.C. ENGINEERING DIV.		APPROVED: <u>W. J. Homan</u> ... COL. CORPS OF ENGINEERS DISTRICT ENGINEER		
SUBMITTED BY: <u>William L. Homan</u> ... METCALF & EDDY BOSTON, MASS.			(PARTNER)		DRAWN BY: ERM TRACED BY: ESB CHECKED BY: <u>W. J. Homan</u>	
FILE NO. CT-4-2620						