




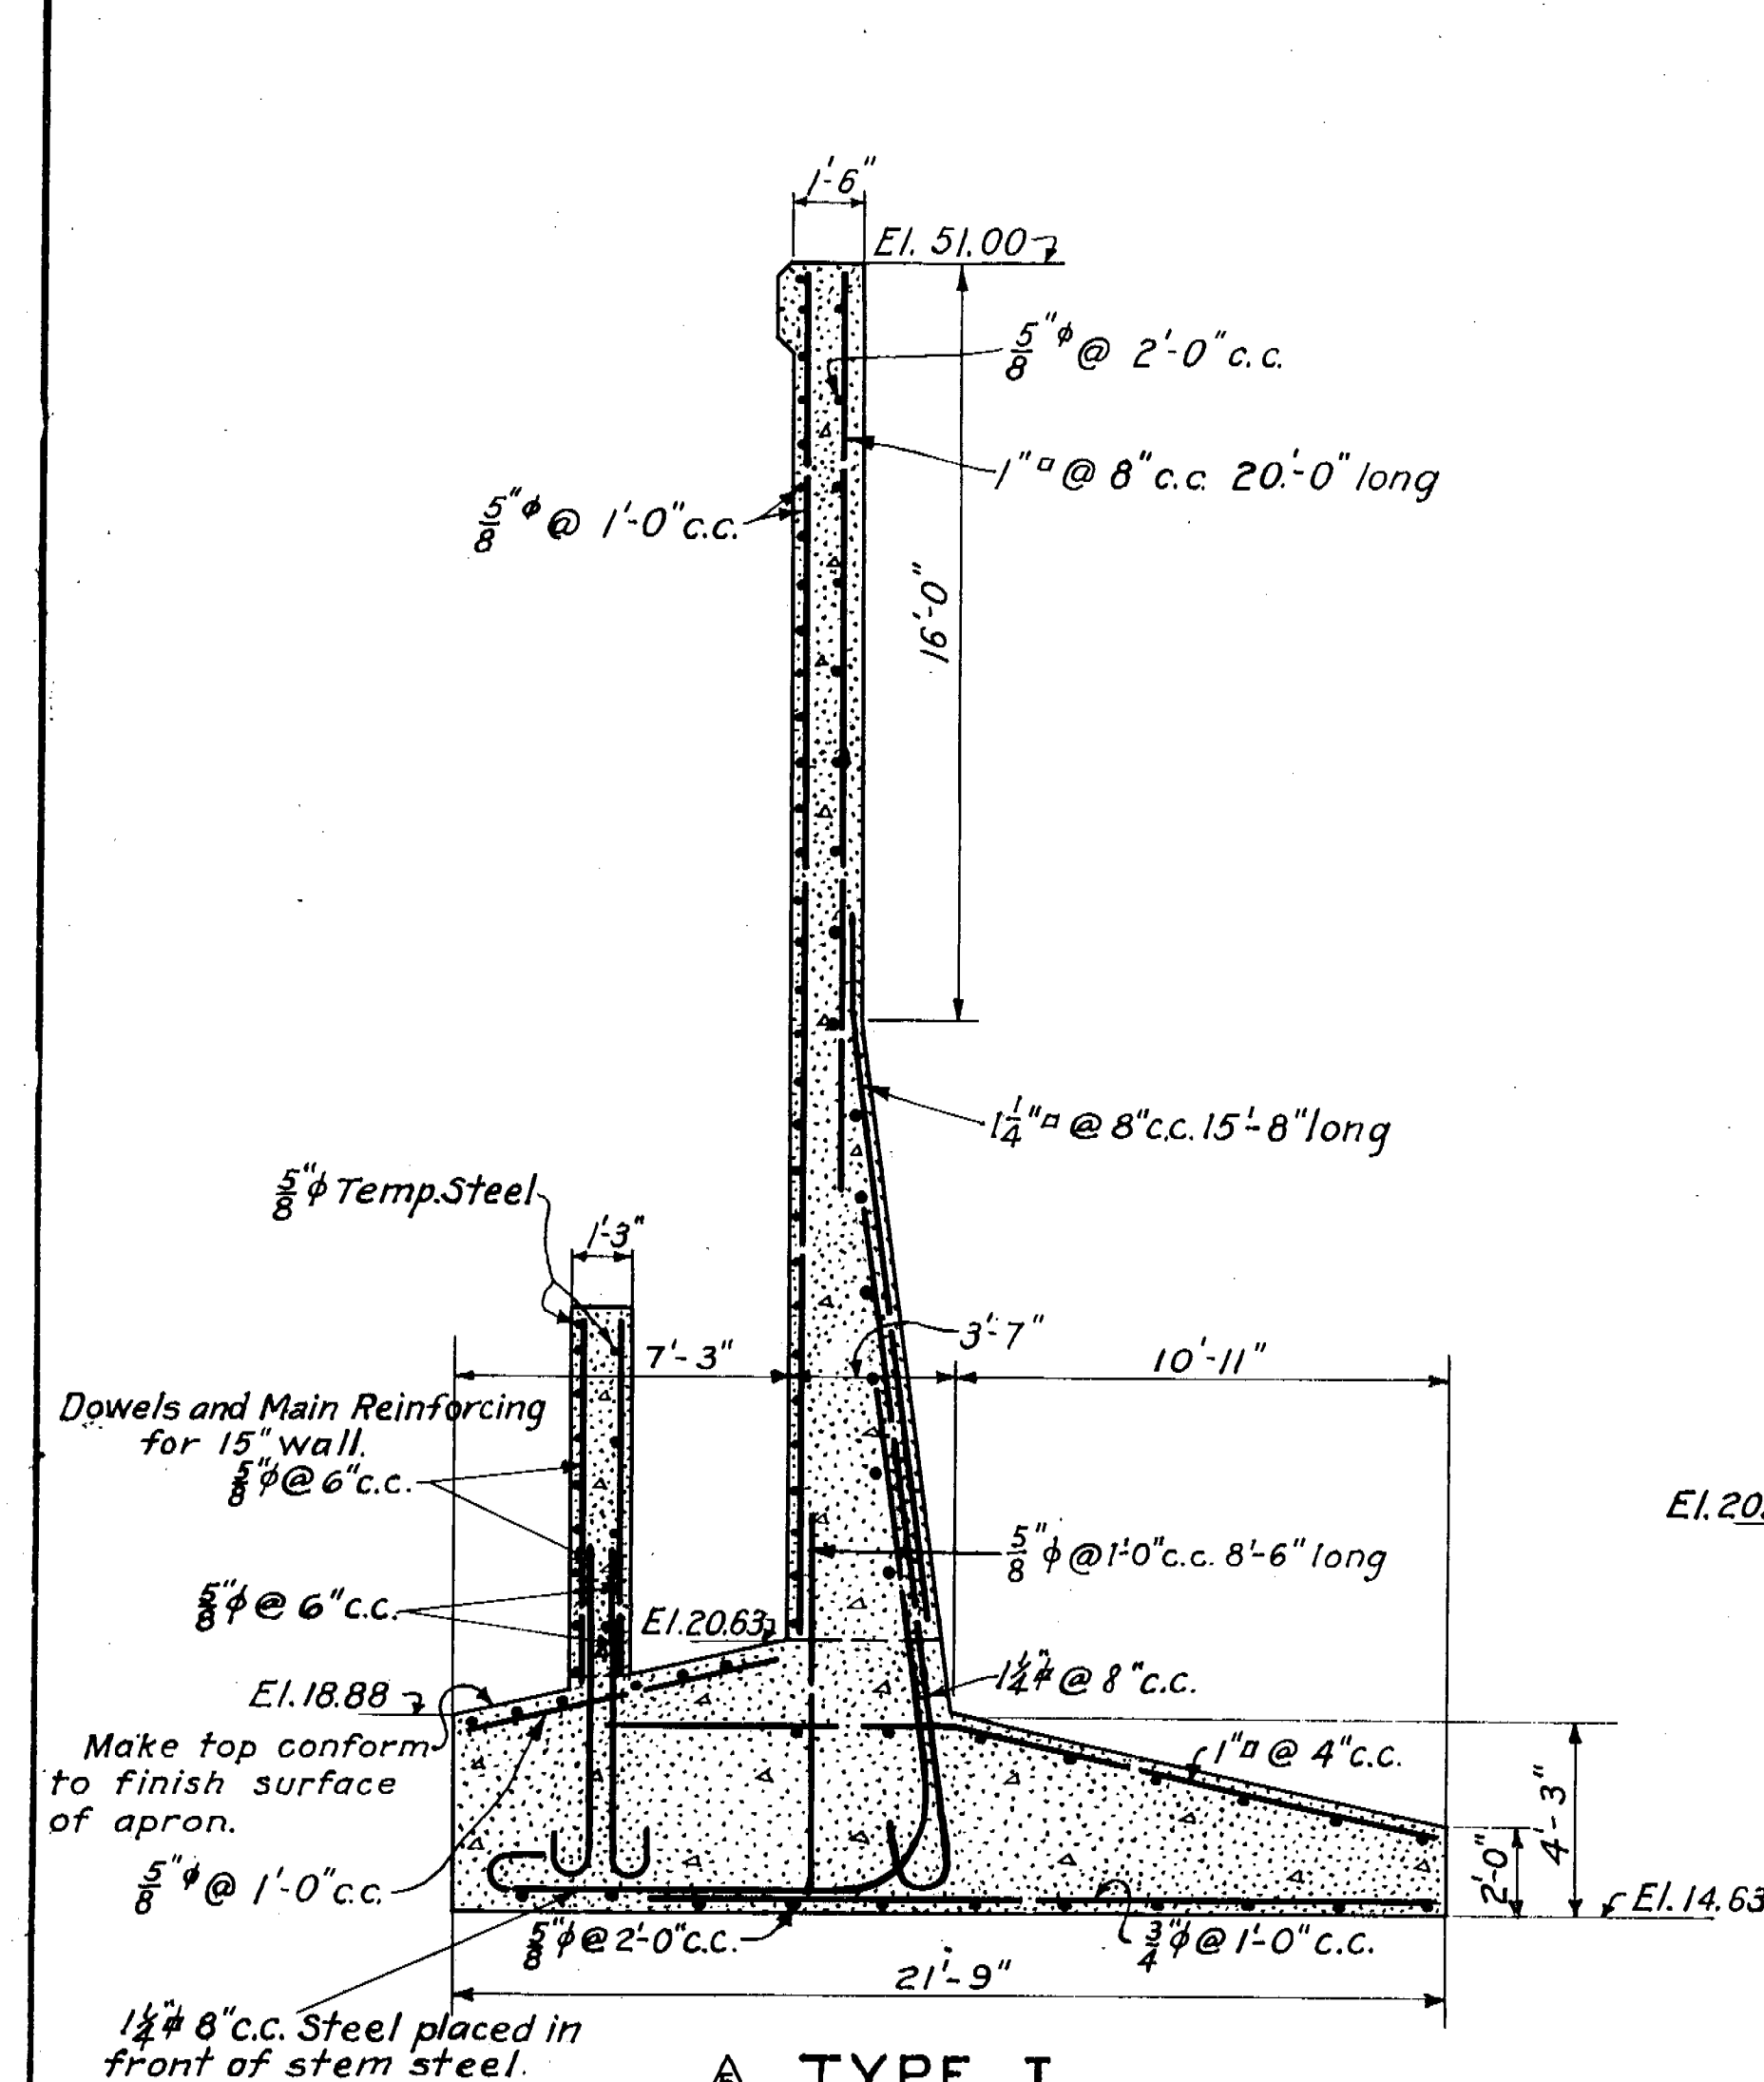


TYPE I

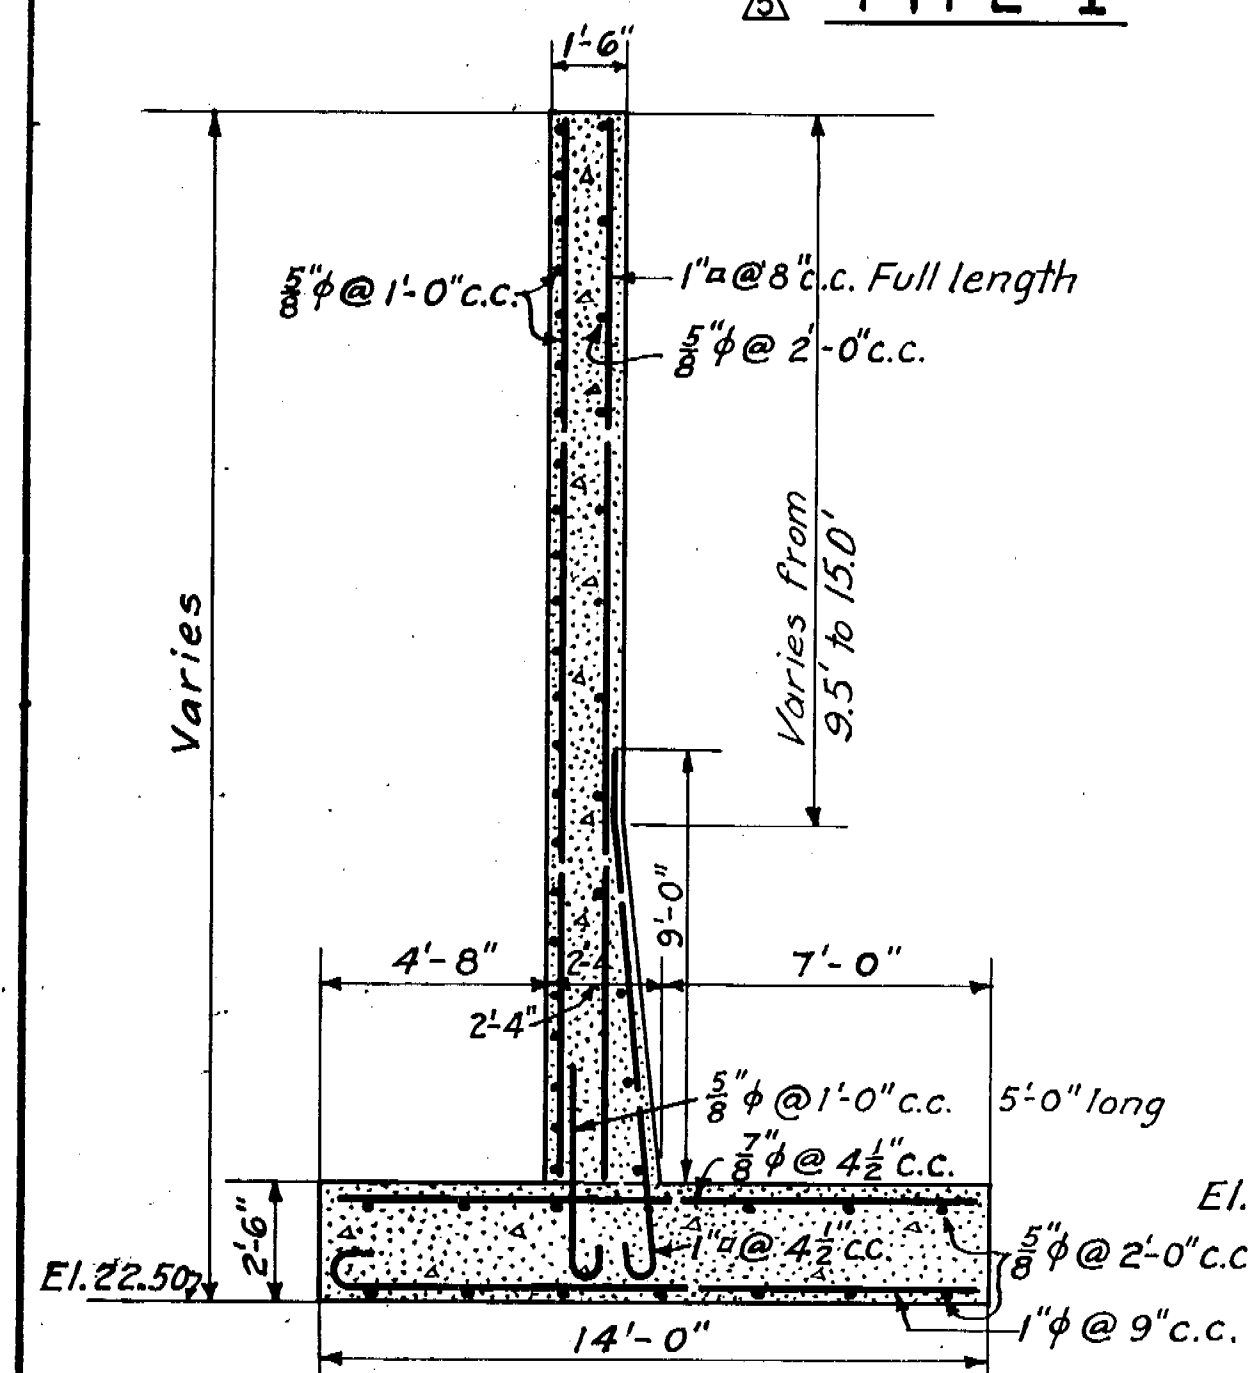


TYPE V

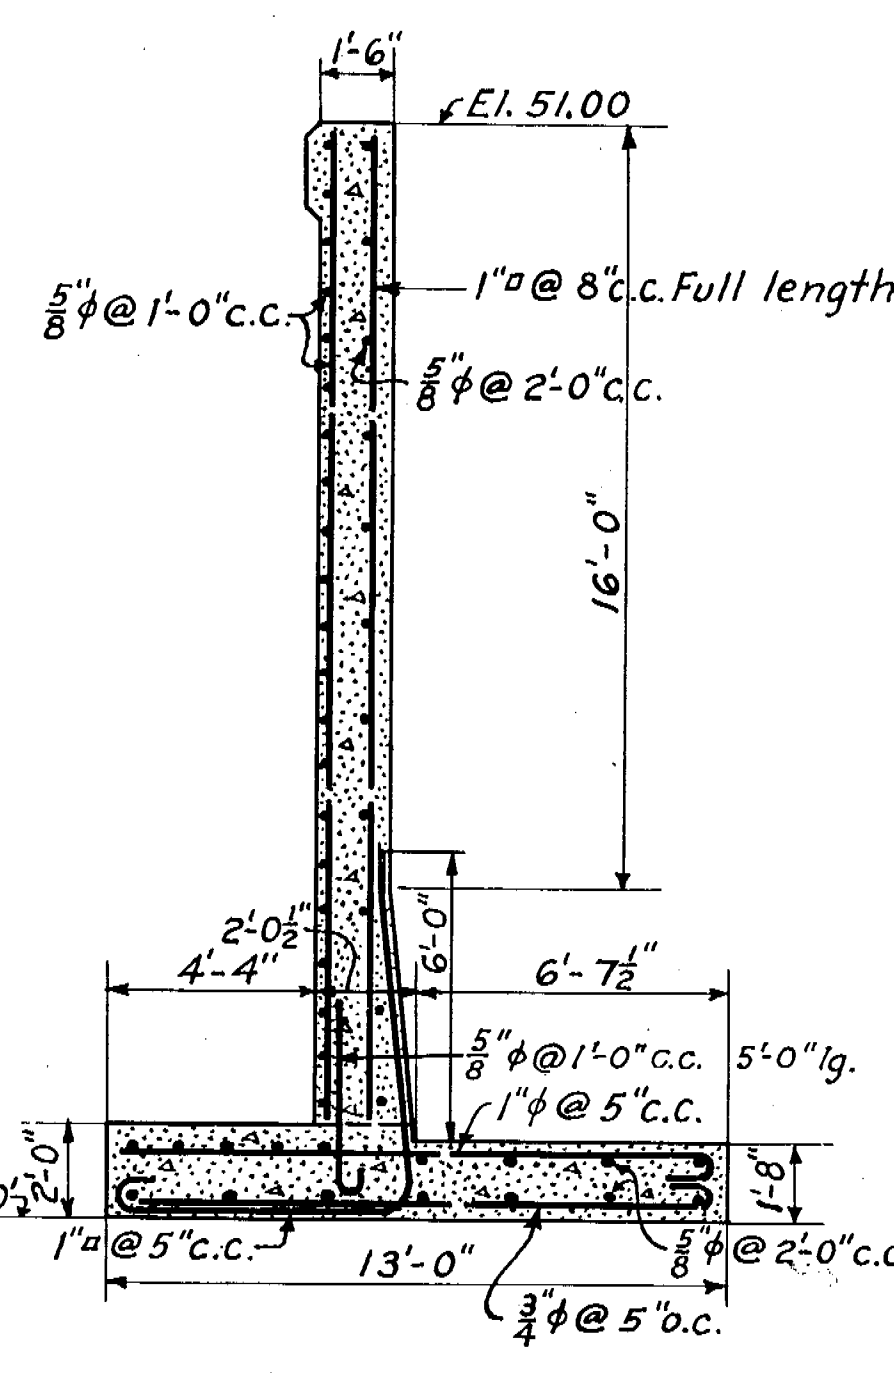

TYPE III

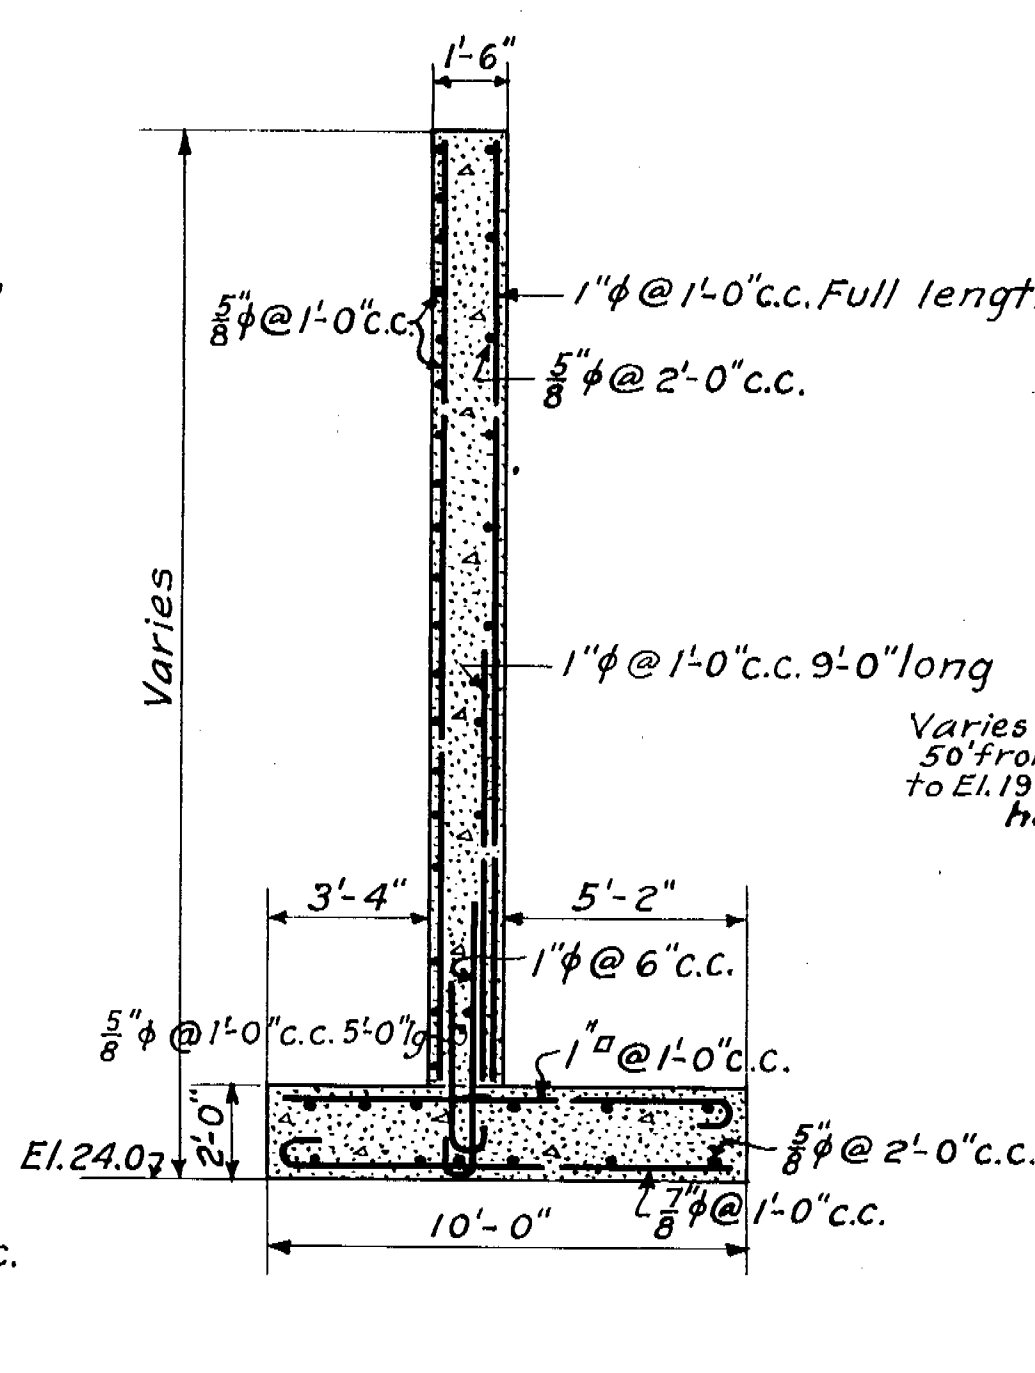


TYPE VI

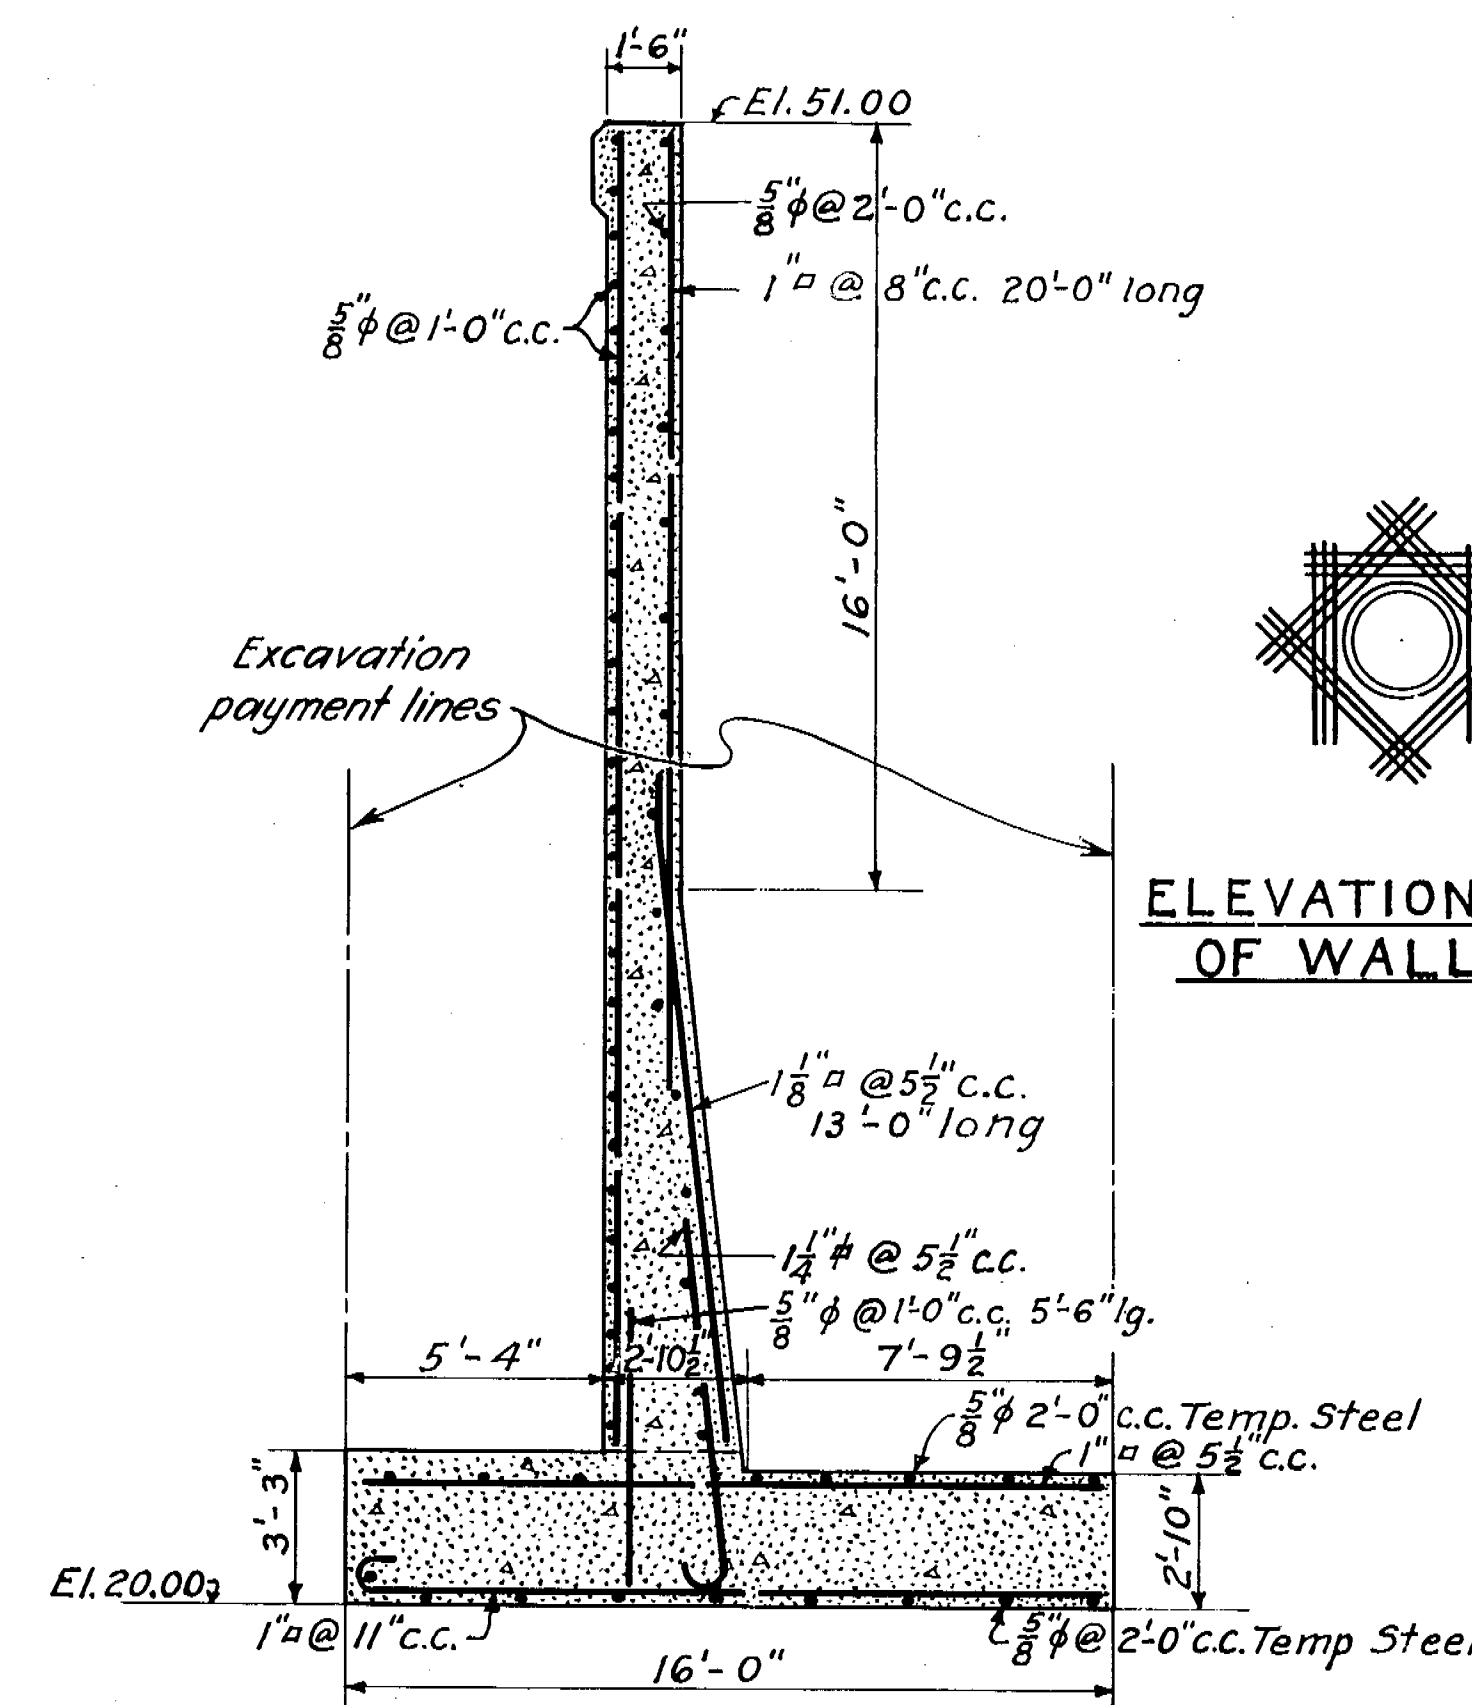


TYPE IV


ELEVATION - EARTH SIDE OF WALL AT PIPE

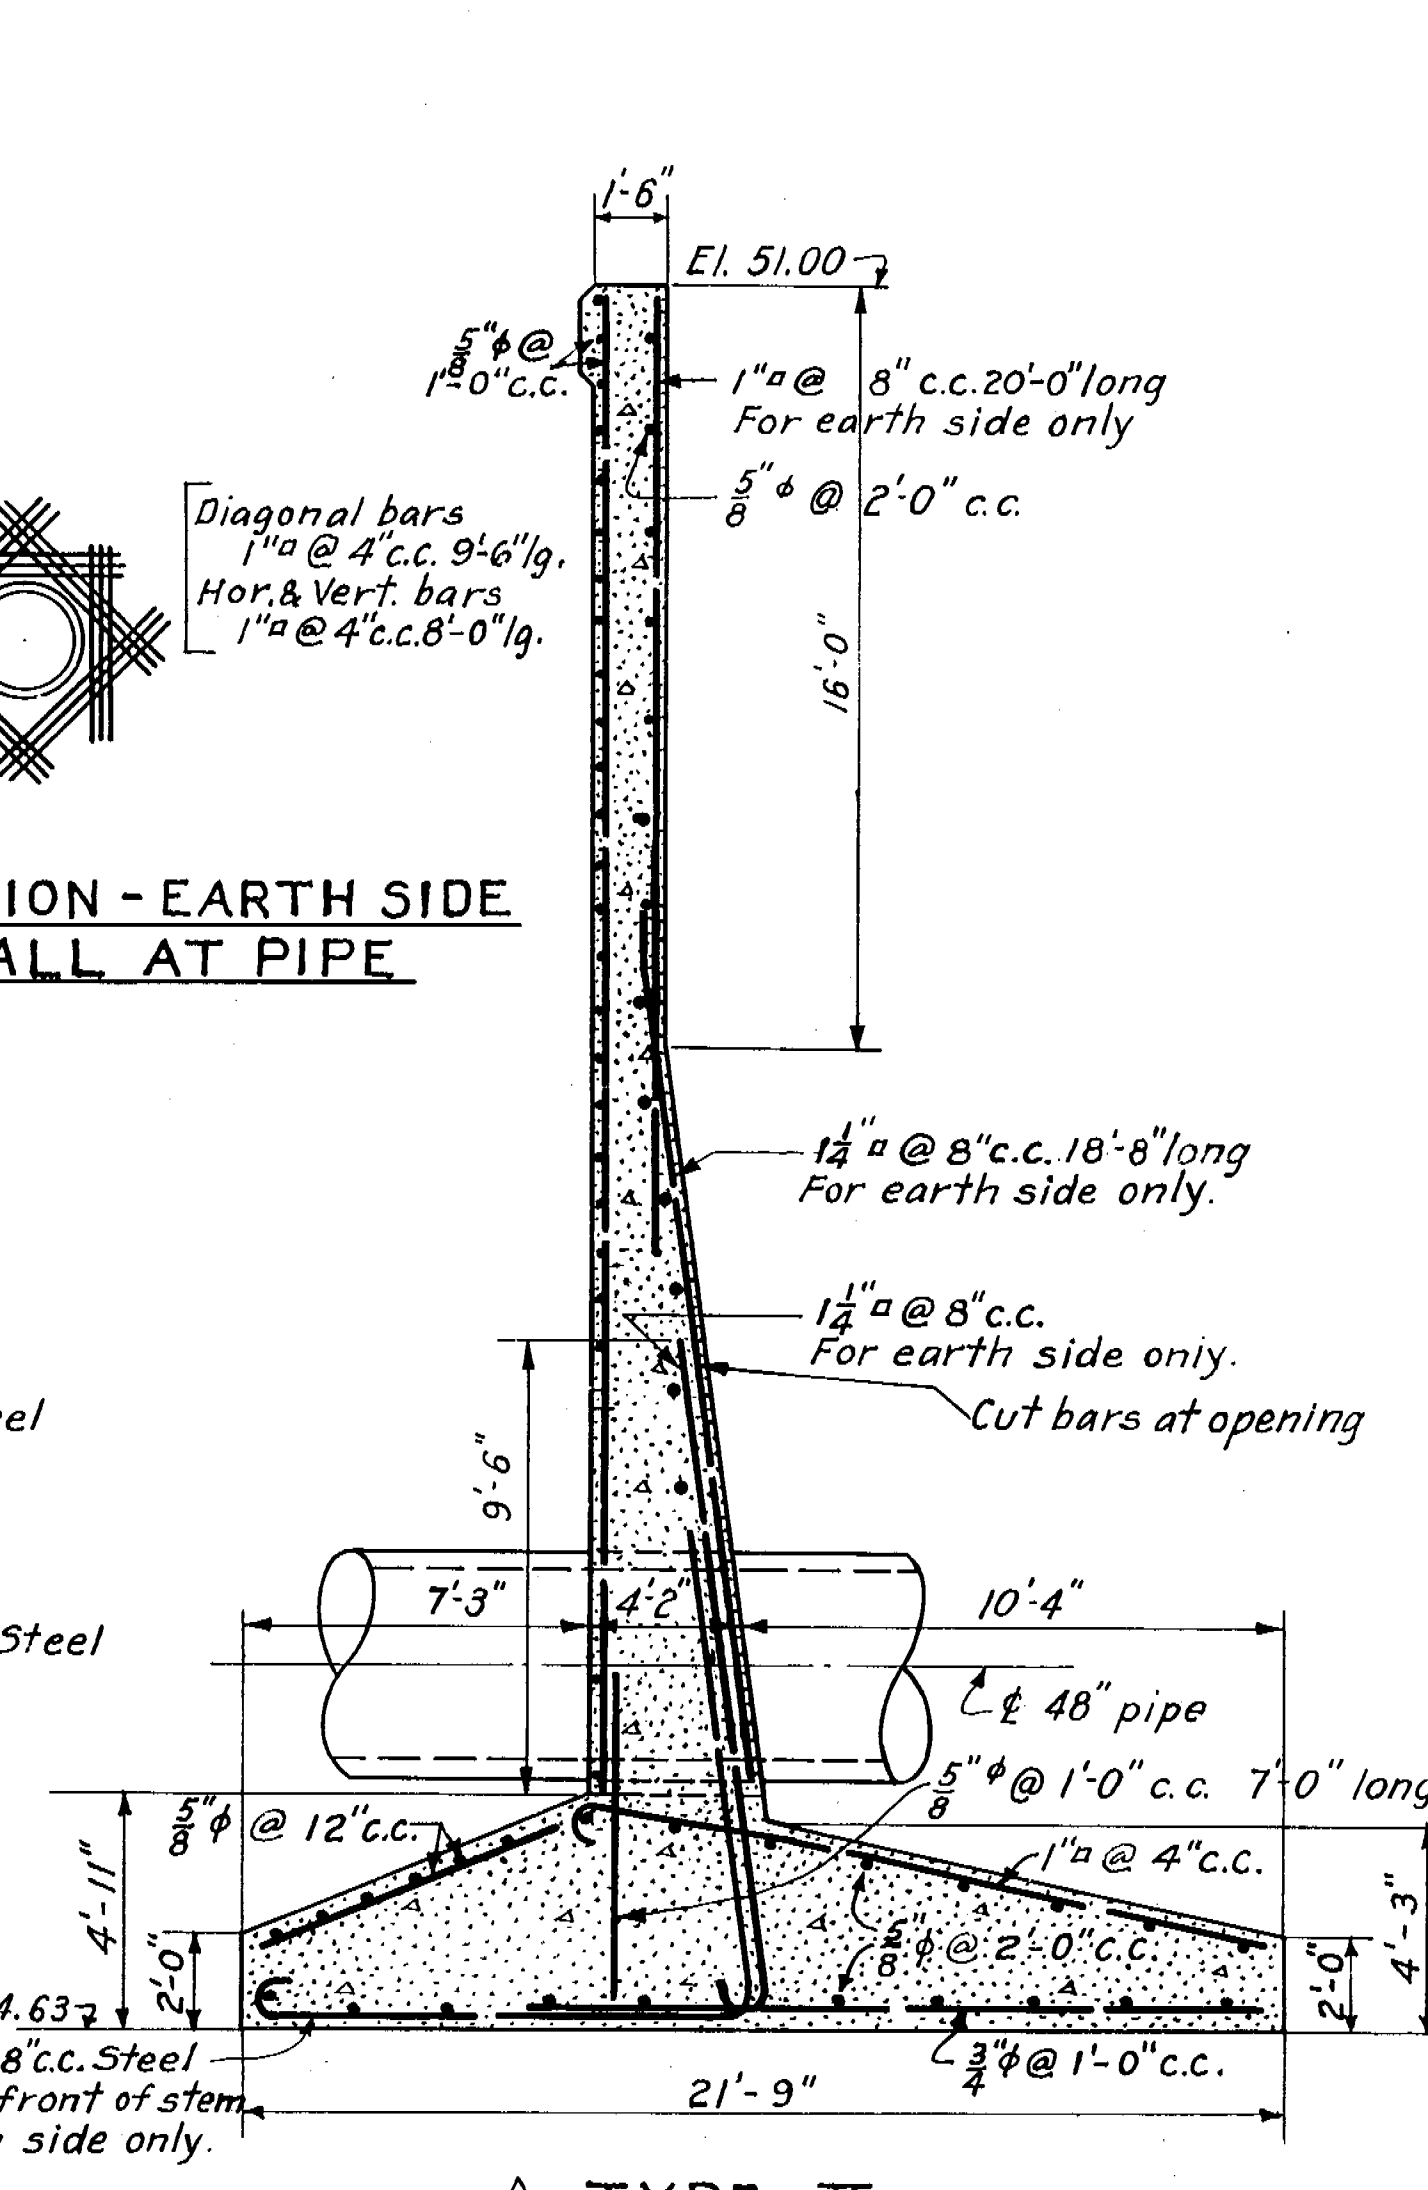

TYPE II

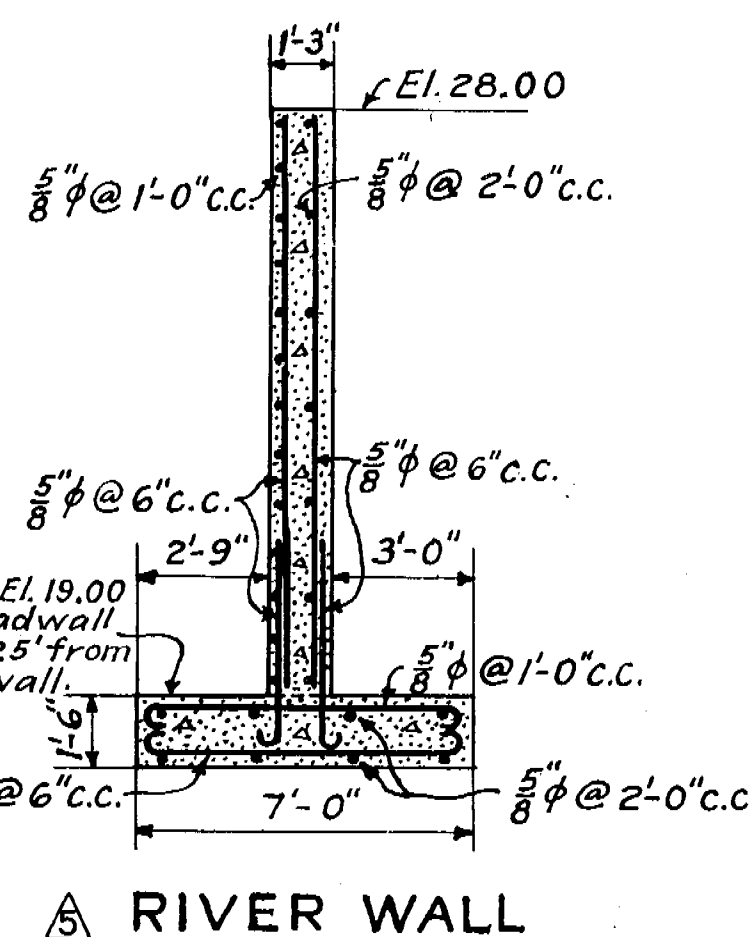

RIVER WALL

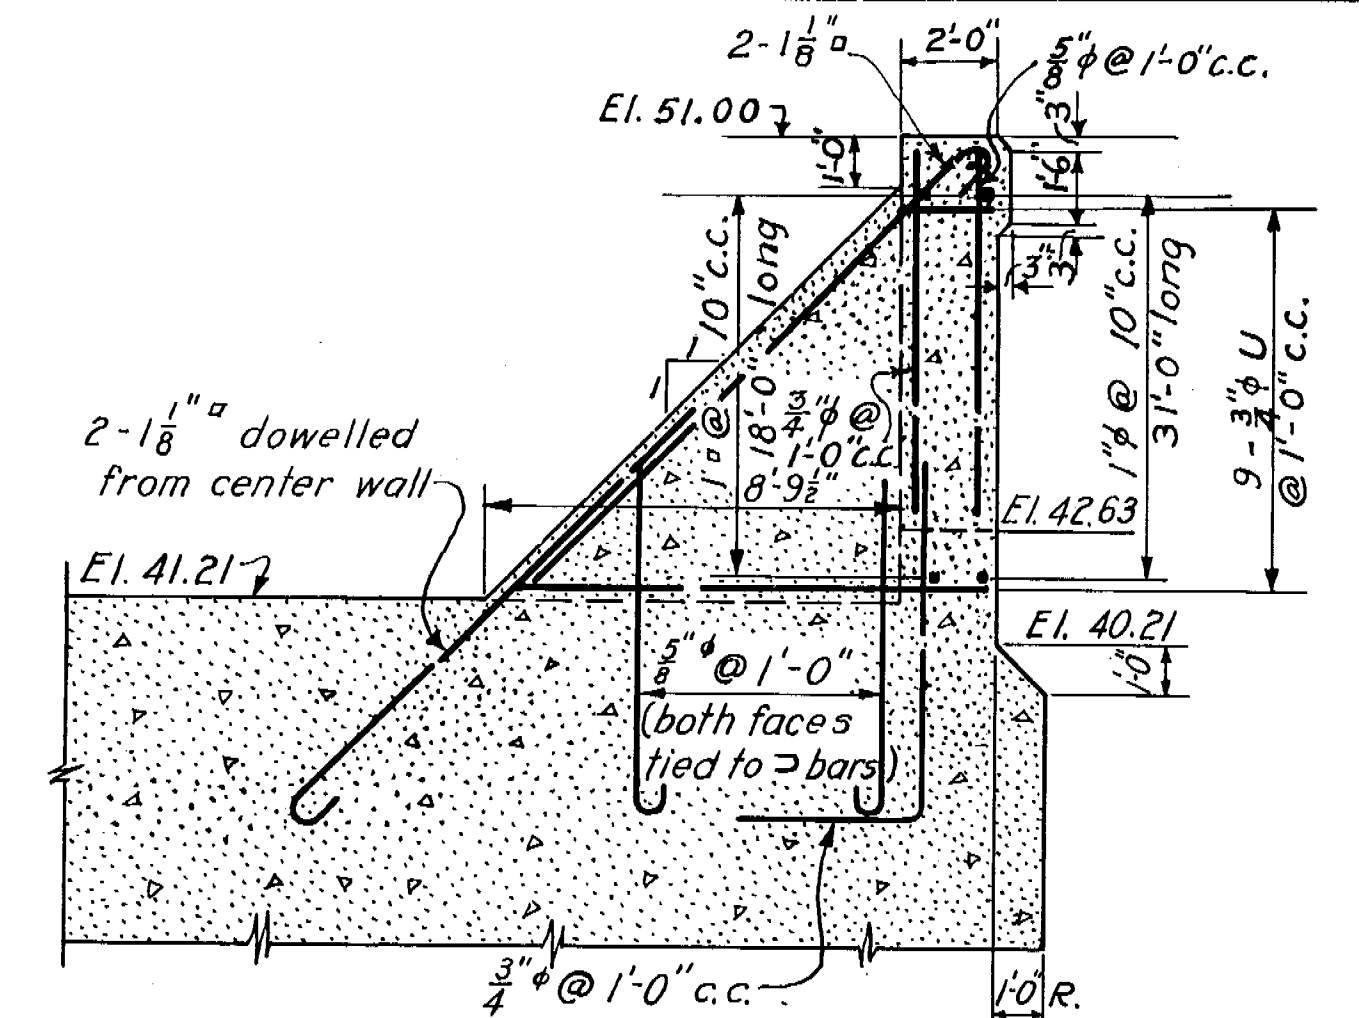

HEADWALL SECTION A-28

SECTION THROUGH INLET ARCH

SECTION B-28

NOTES
For location of types see Sheet No. 20.

METCALF & EDDY
ENGINEERS
BOSTON, MASS.

KEY	DATE	REVISION (Indicated by Δ)	REV. BY	CK. BY	AP. BY
Δ	12-31-45	As built revisions			
Δ	7-10-41	Wall base changed.	J.P.C.	J.S.	J.P.B.

CONNECTICUT RIVER FLOOD CONTROL PARK RIVER CONDUIT HARTFORD, CONN.			
INLET STRUCTURE WALL REINFORCEMENT NO. 1			
CONNECTICUT RIVER		CONNECTICUT	
IN 48 SHEETS		SCALE: 1/4" = 1' FT.	
SHEET NO. 27			
U.S. ENGINEER OFFICE PROVIDENCE, R.I. MAY 1940			
REVIEWED: P.C. DESIGN SECTION	APPROVAL RECOMMENDED: PRINCIPAL ENGINEER CHIEF F.C. ENGINEERING DIV.	APPROVED: DISTRICT ENGINEER	
SUBMITTED: METCALF & EDDY BOSTON, MASS.	DRAWN BY: FAN TRACED BY: W.H.F. CHECKED BY: G.W.T.	FILE NO. CT-4-2625	