



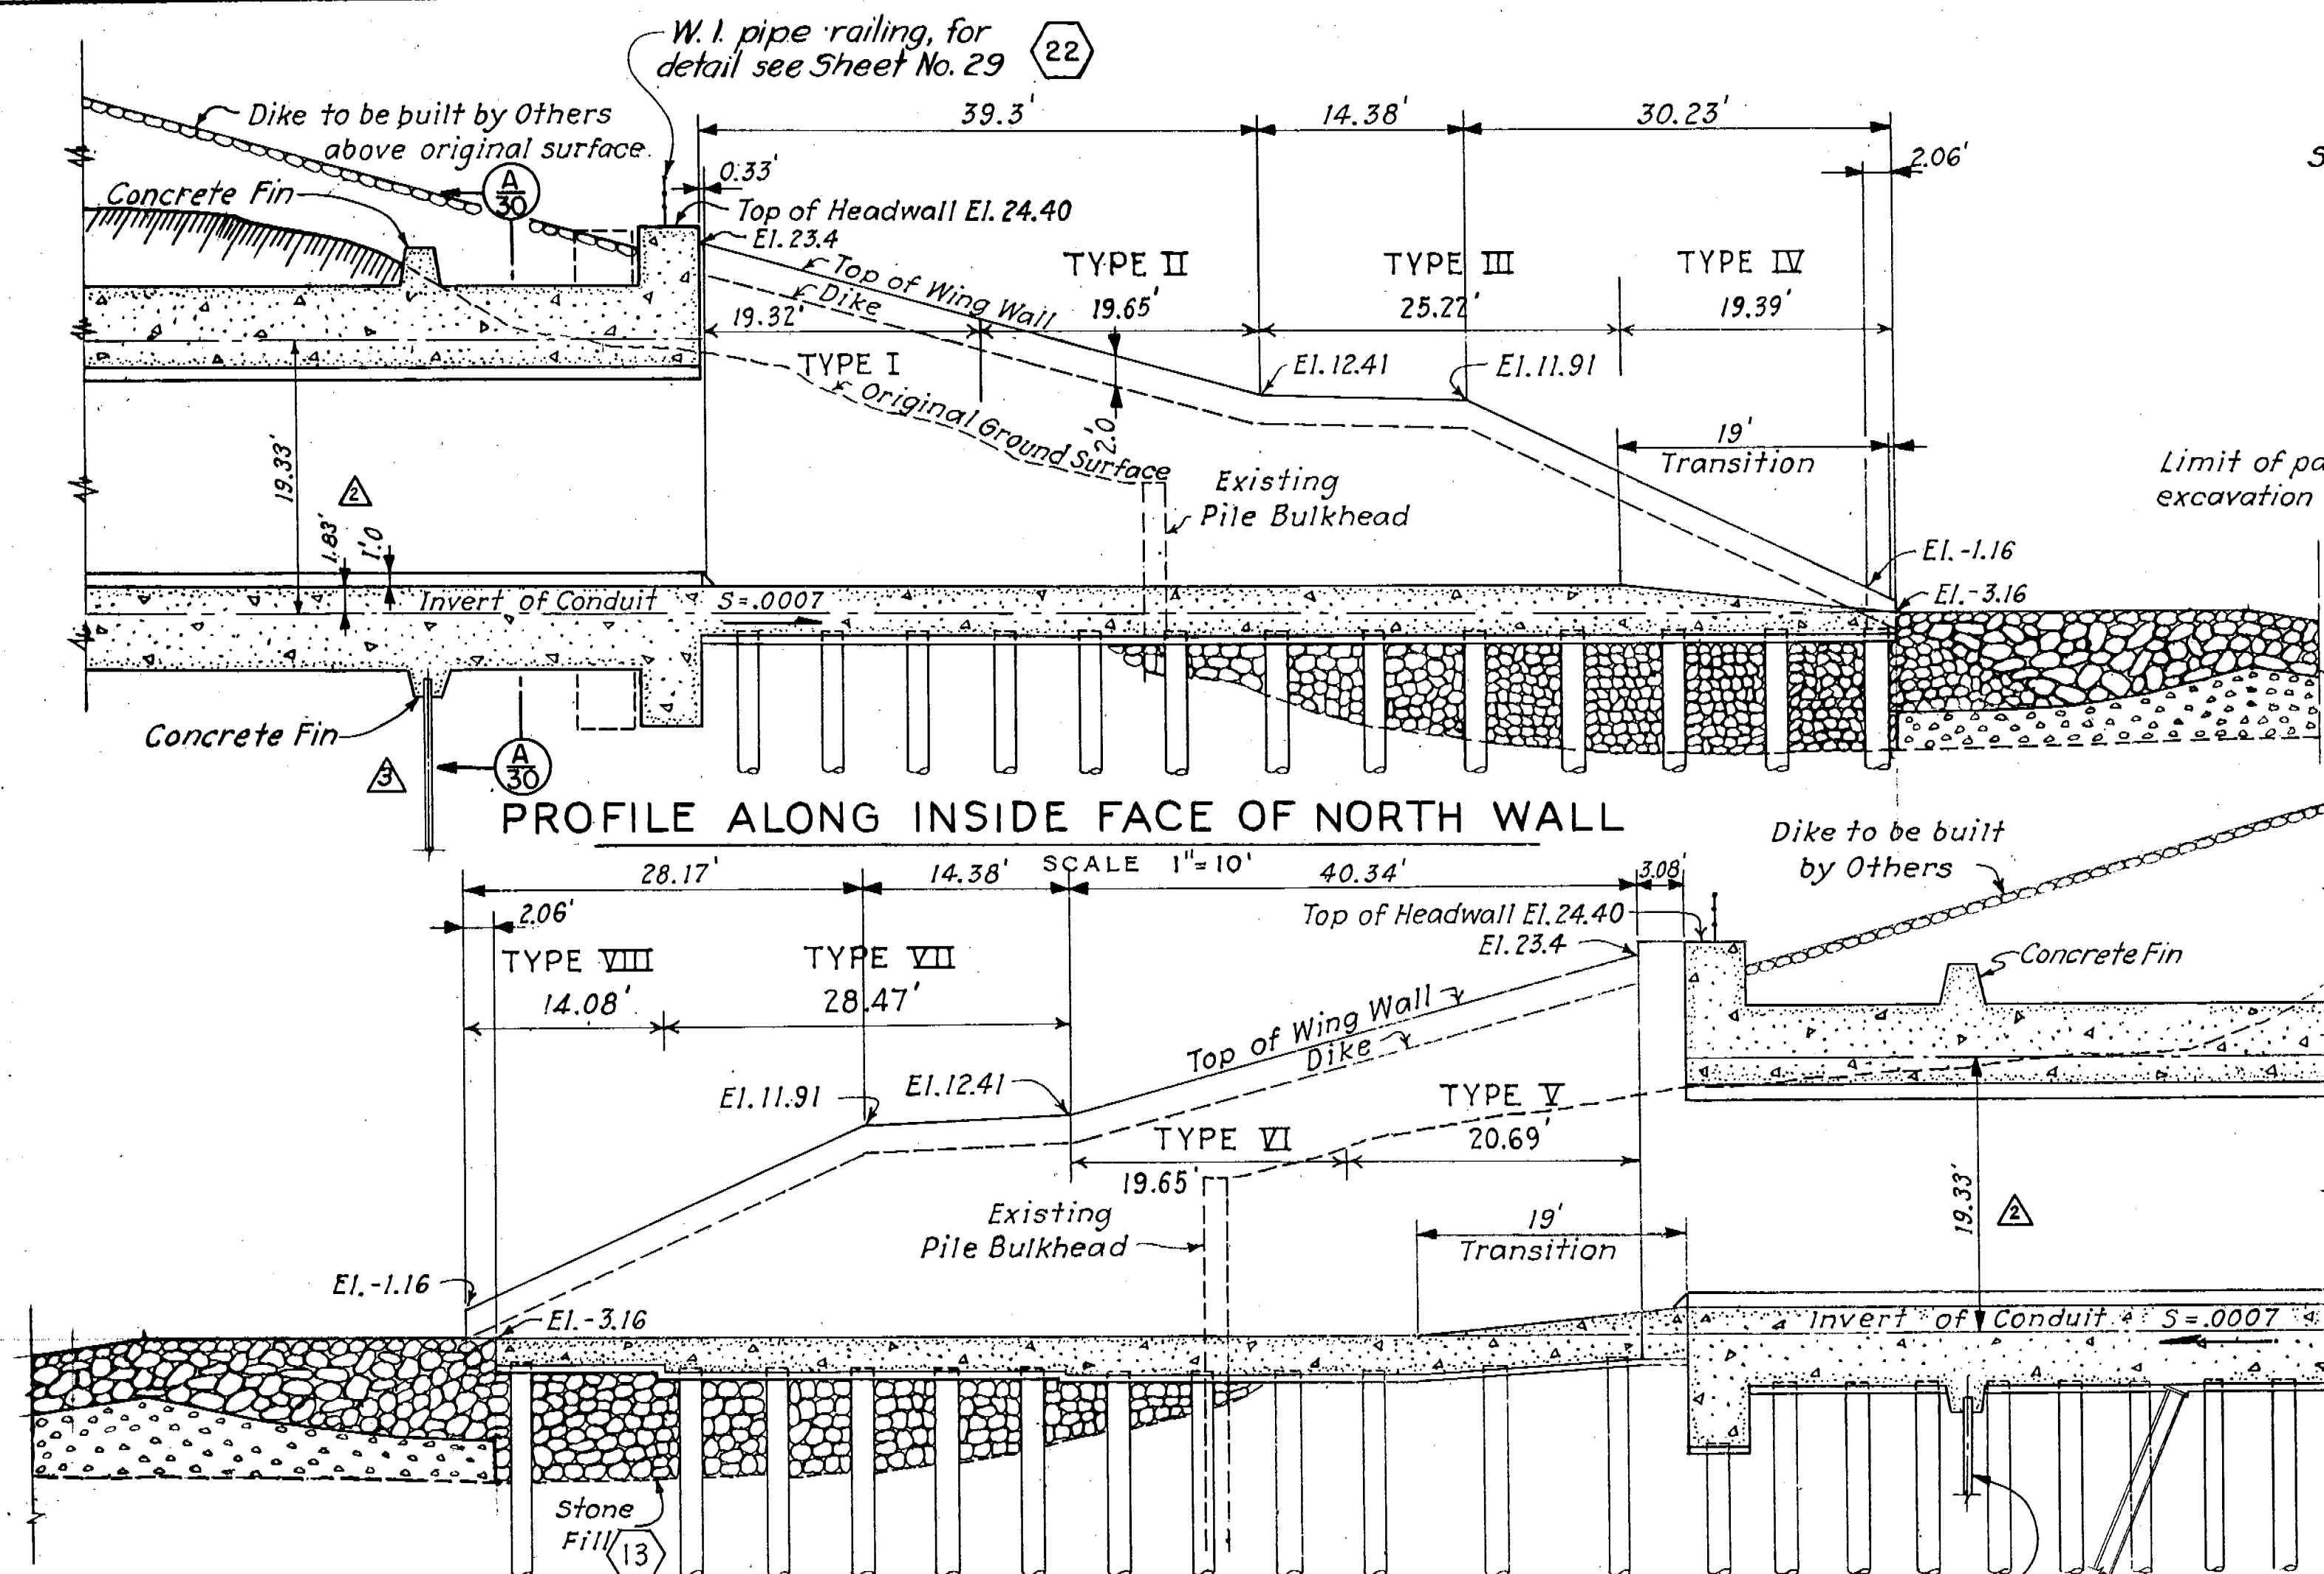

PROFILE ALONG INSIDE FACE OF NORTH WALL

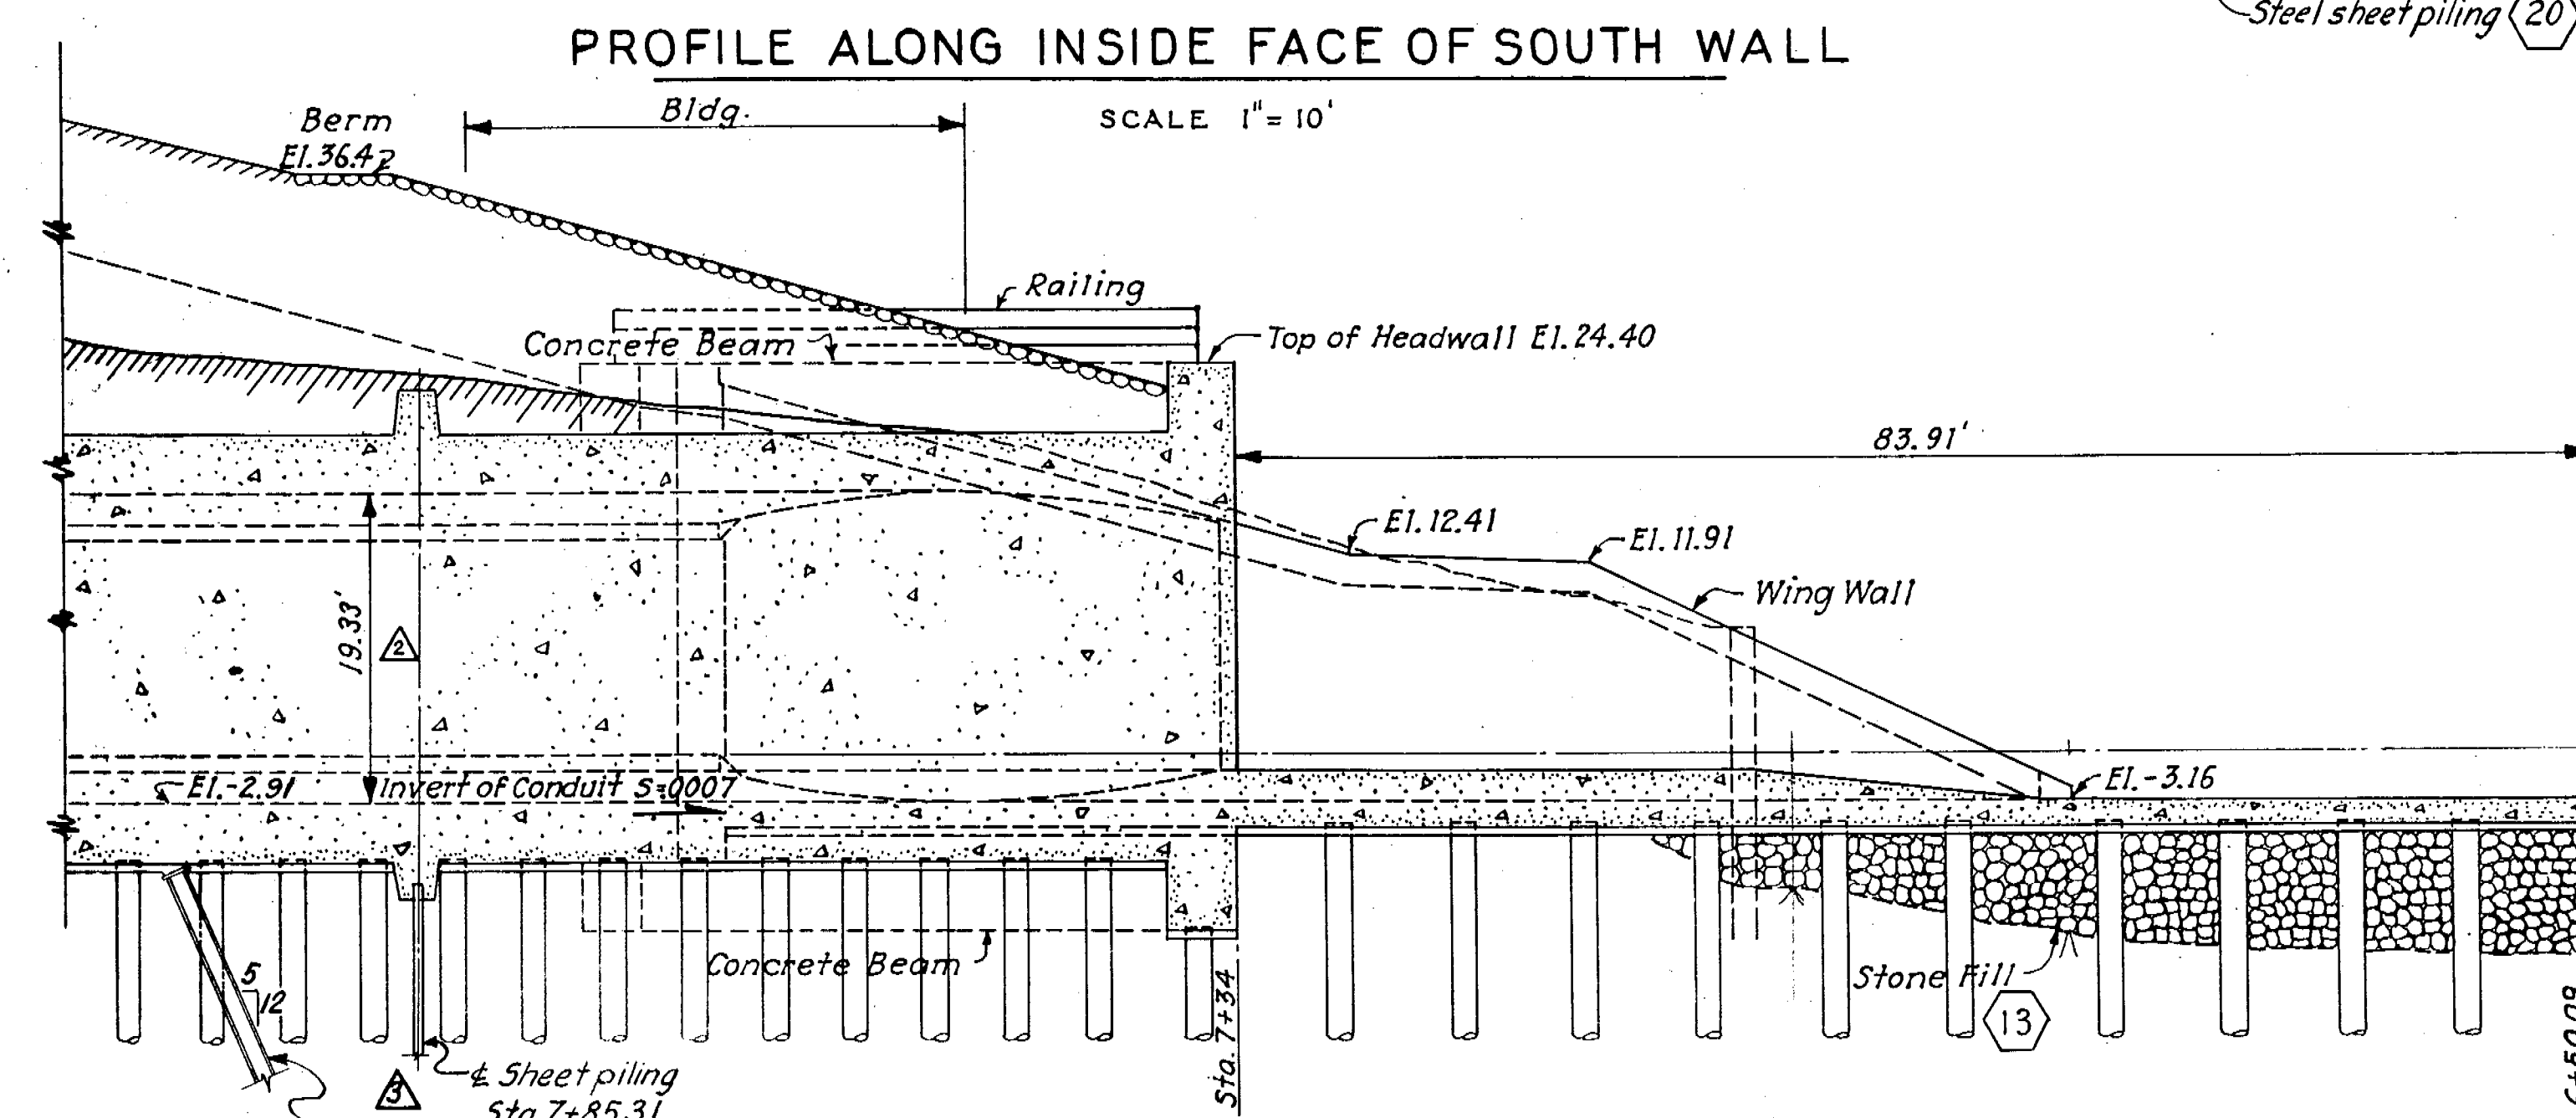


PROFILE ALONG INSIDE FACE OF SOUTH WALL



PROFILE ALONG & OF CONDUIT

METCALF & EDDY
ENGINEERS
BOSTON, MASS.

SCALE 1" = 10'

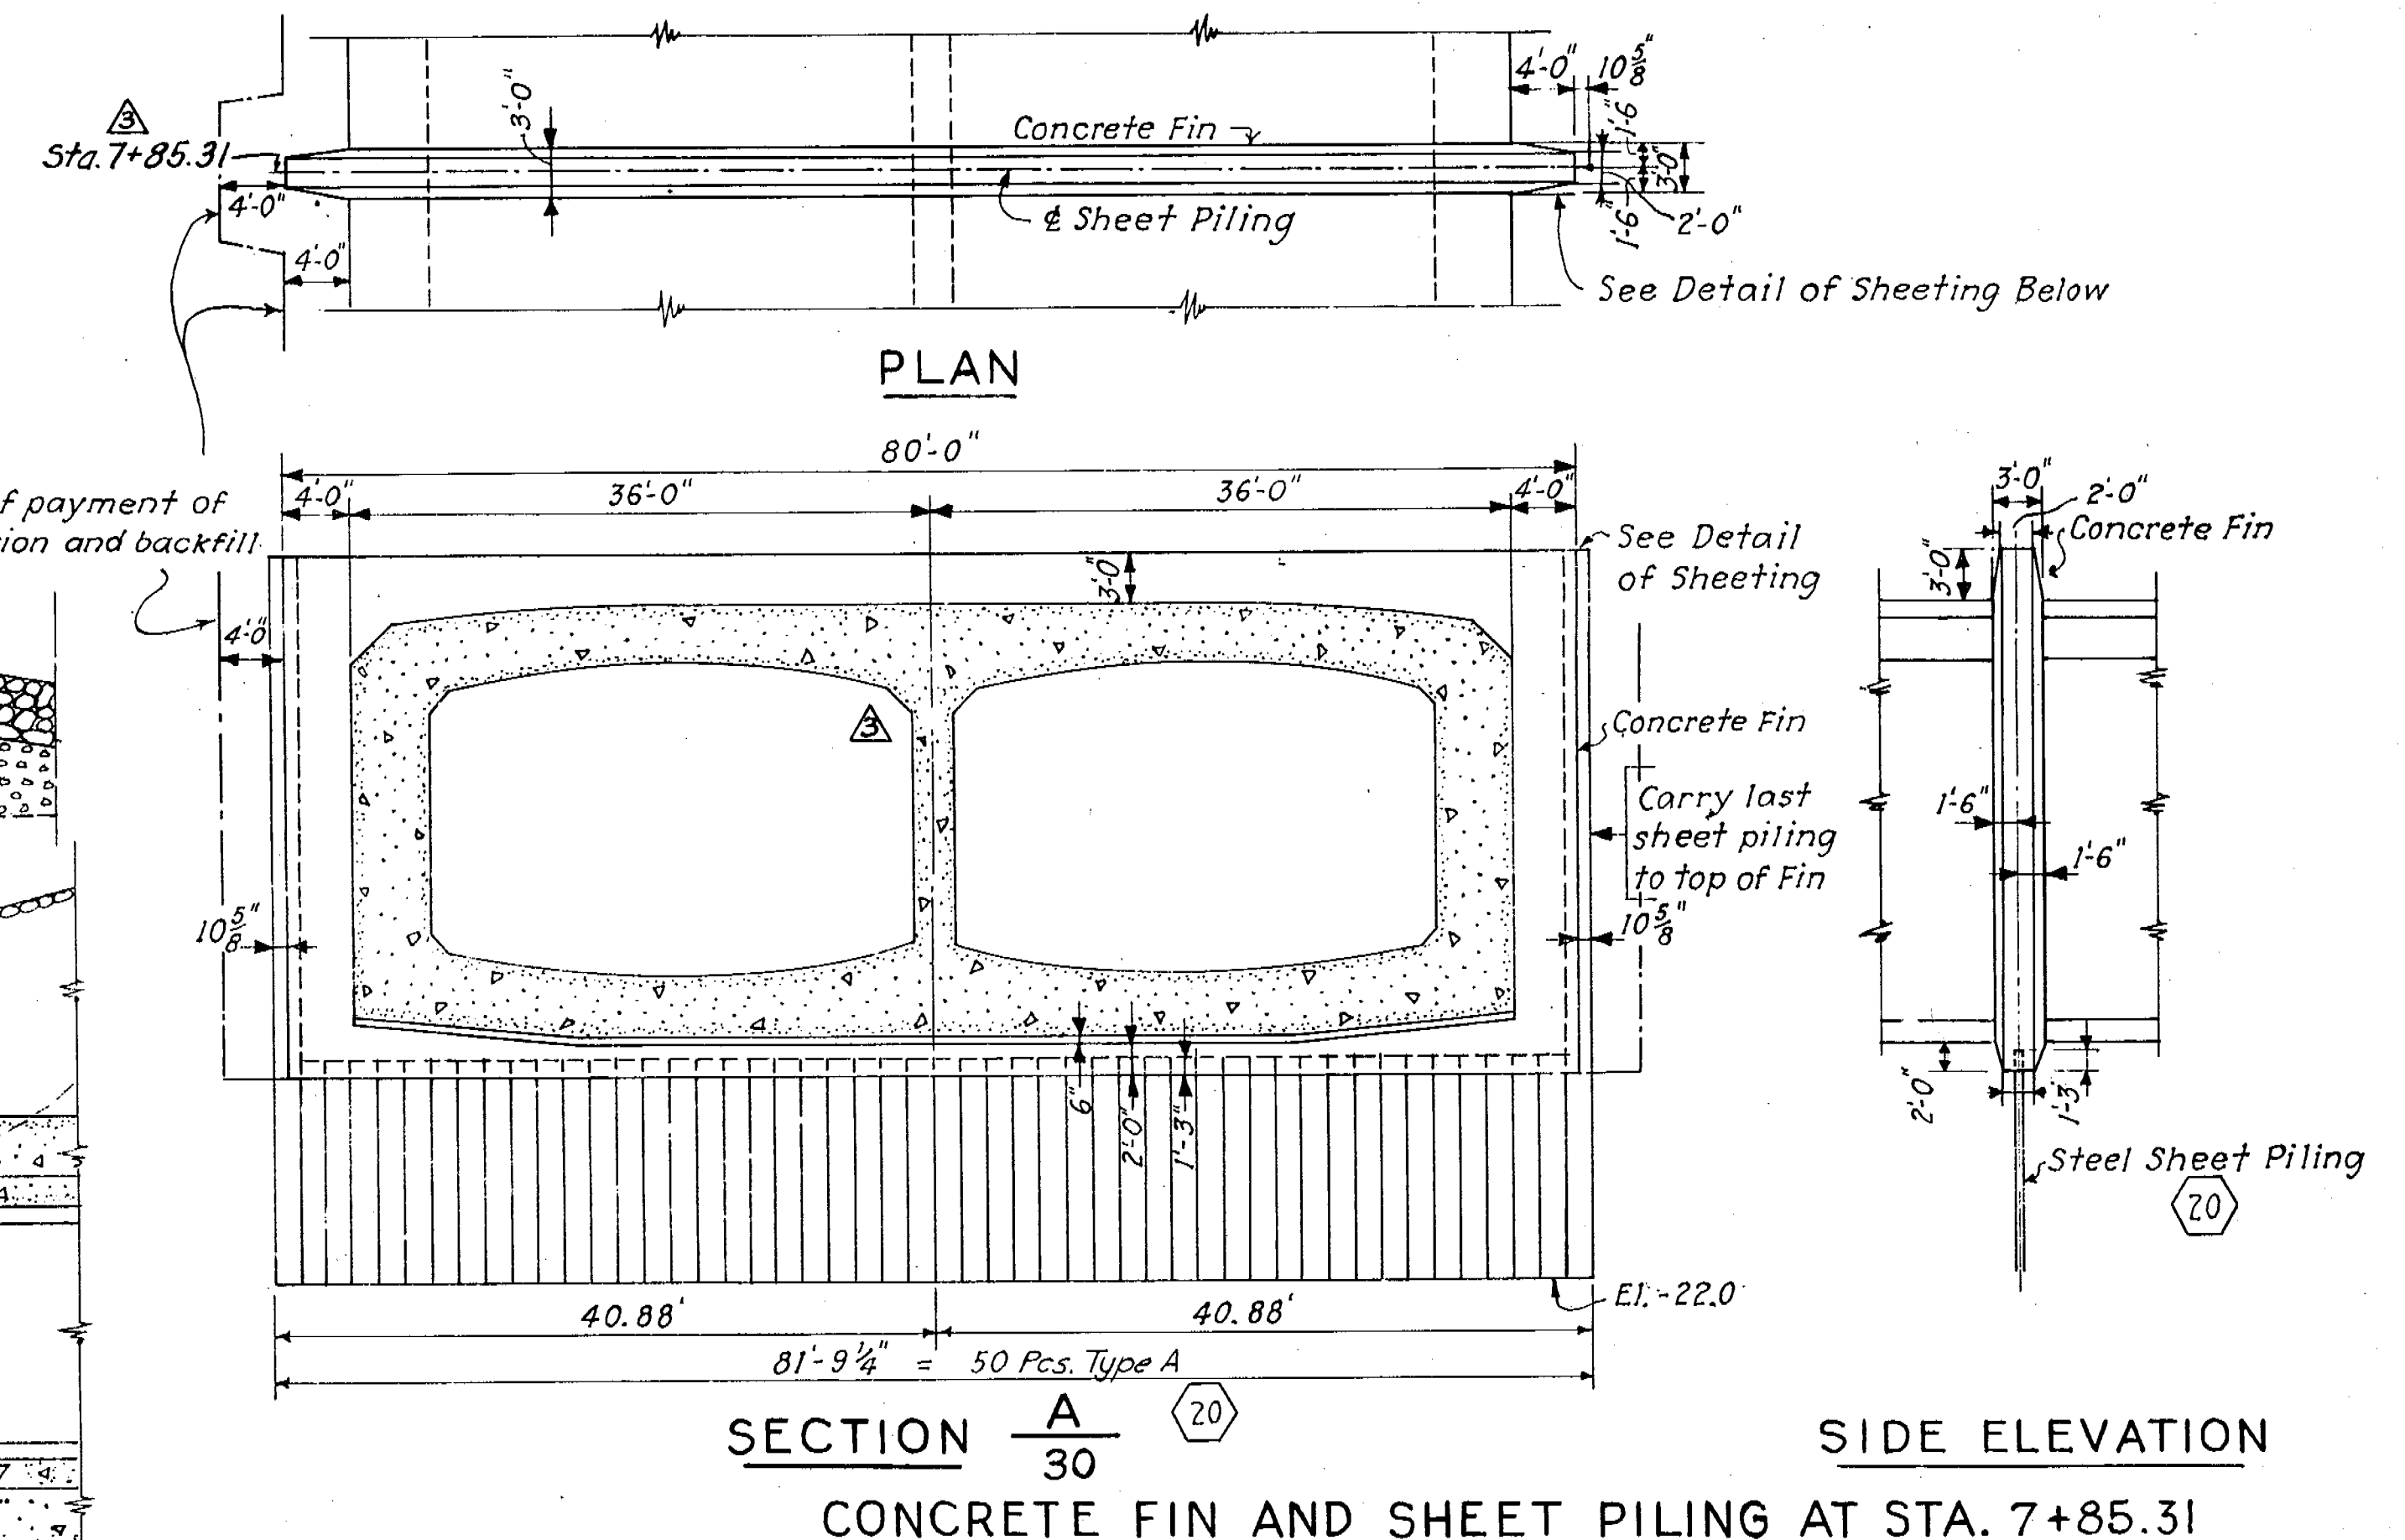
SECTION A
30

SIDE ELEVATION

CONCRETE FIN AND SHEET PILING AT STA. 7+85.31

NOTE:

Fins at Sta. 8+45.3 and Sta. 8+90.3 are the same as at Sta. 7+85.31 except the steel sheet piling is omitted.

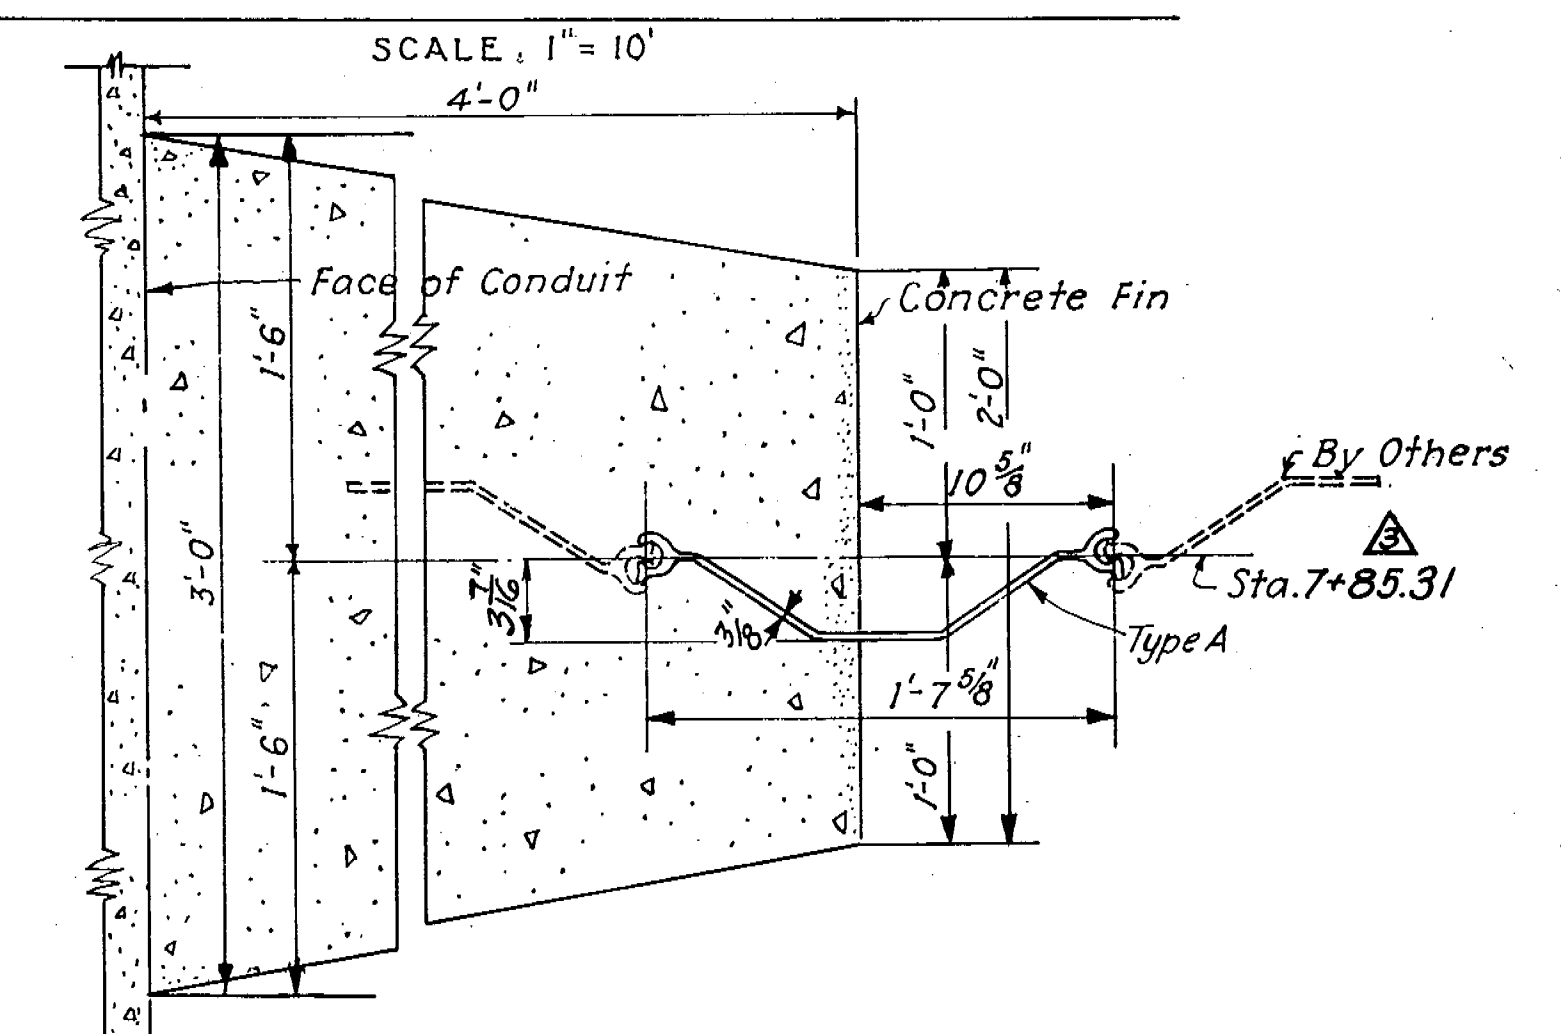

DETAIL OF SHEETING

SCALE: 1 1/2" = 1 FT.

CONNECTICUT RIVER FLOOD CONTROL
PARK RIVER CONDUIT
HARTFORD, CONN.
OUTLET STRUCTURE
DETAILS NO. 1

CONNECTICUT RIVER CONNECTICUT
IN 48 SHEETS SCALE: 1 IN. = 10 FT. SHEET NO. 30

U.S. ENGINEER OFFICE PROVIDENCE, R.I. MAY 1940

REVIEWED: APPROVAL RECOMMENDED: APPROVED:
P.C.H. P.C.H. P.C.H.
F.C. DESIGN SECTION CHIEF F.C. ENGINEERING DIV. DISTRICT ENGINEER

SUBMITTED: METCALF & EDDY BOSTON, MASS. (PARTNER) TRACED BY: E.S.B. CHECKED BY: J.M.T.

FILE NO. CT-4-2628

12-31-45	As built revisions	RCN	IN	MB
2-17-41	Batter piles added	P.C.H.	K.B.N.	MB
11-22-40	Dimensions changed	P.C.H.	K.B.N.	MB
KEY	DATE	REVISION (Indicated by Δ)	REV. BY	CK. BY