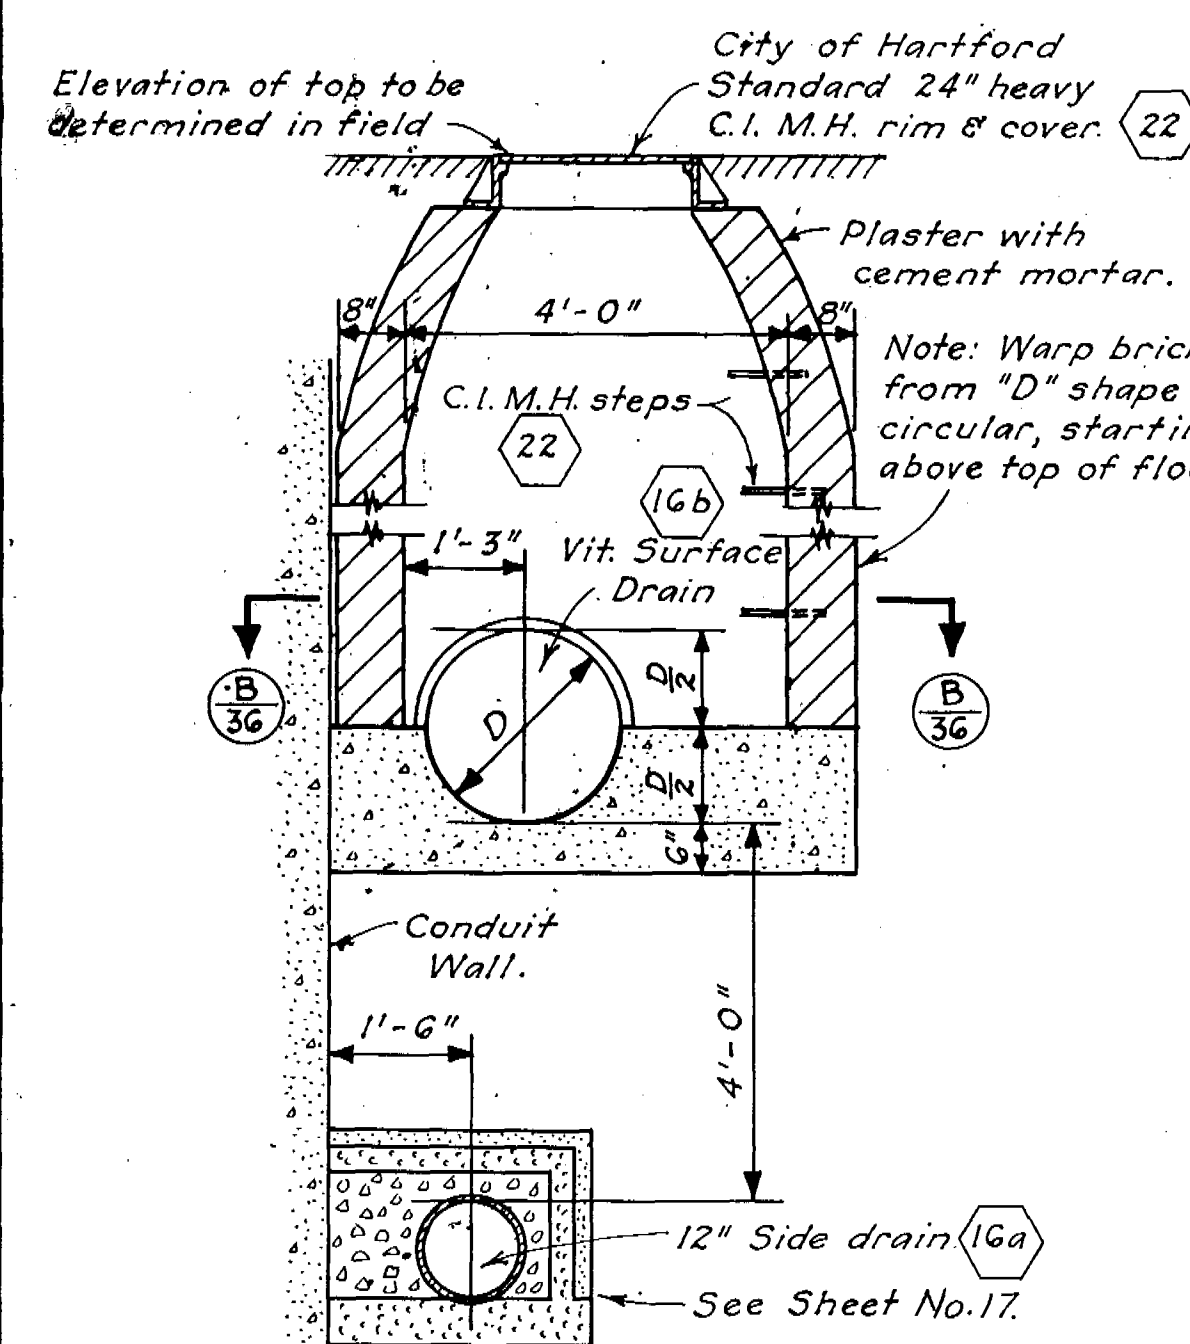
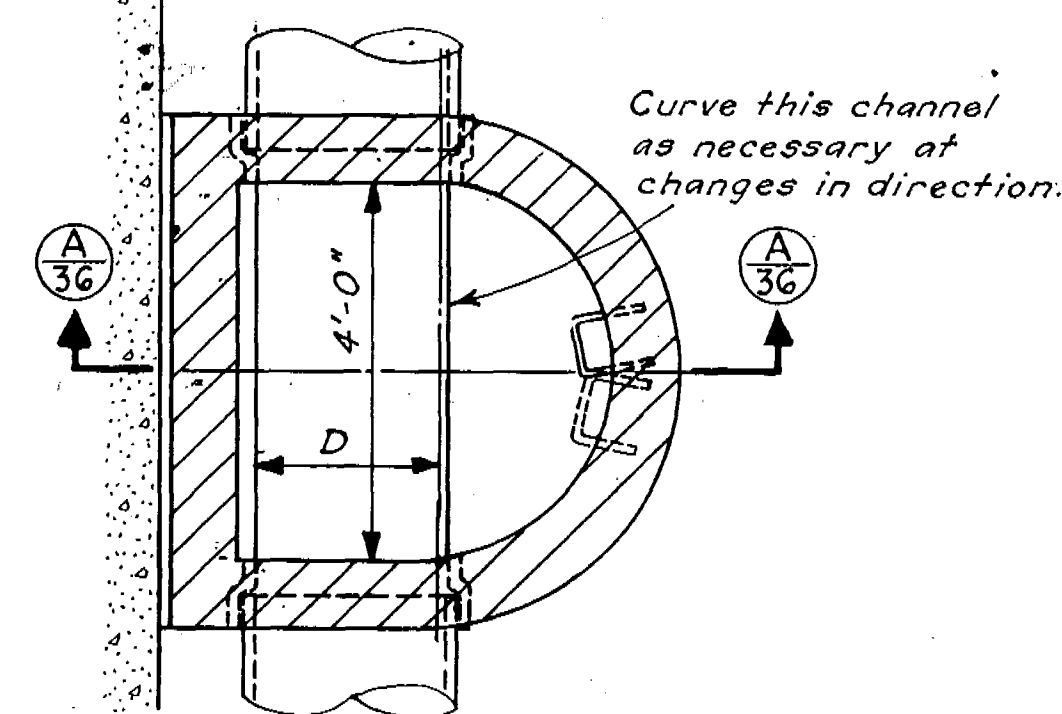
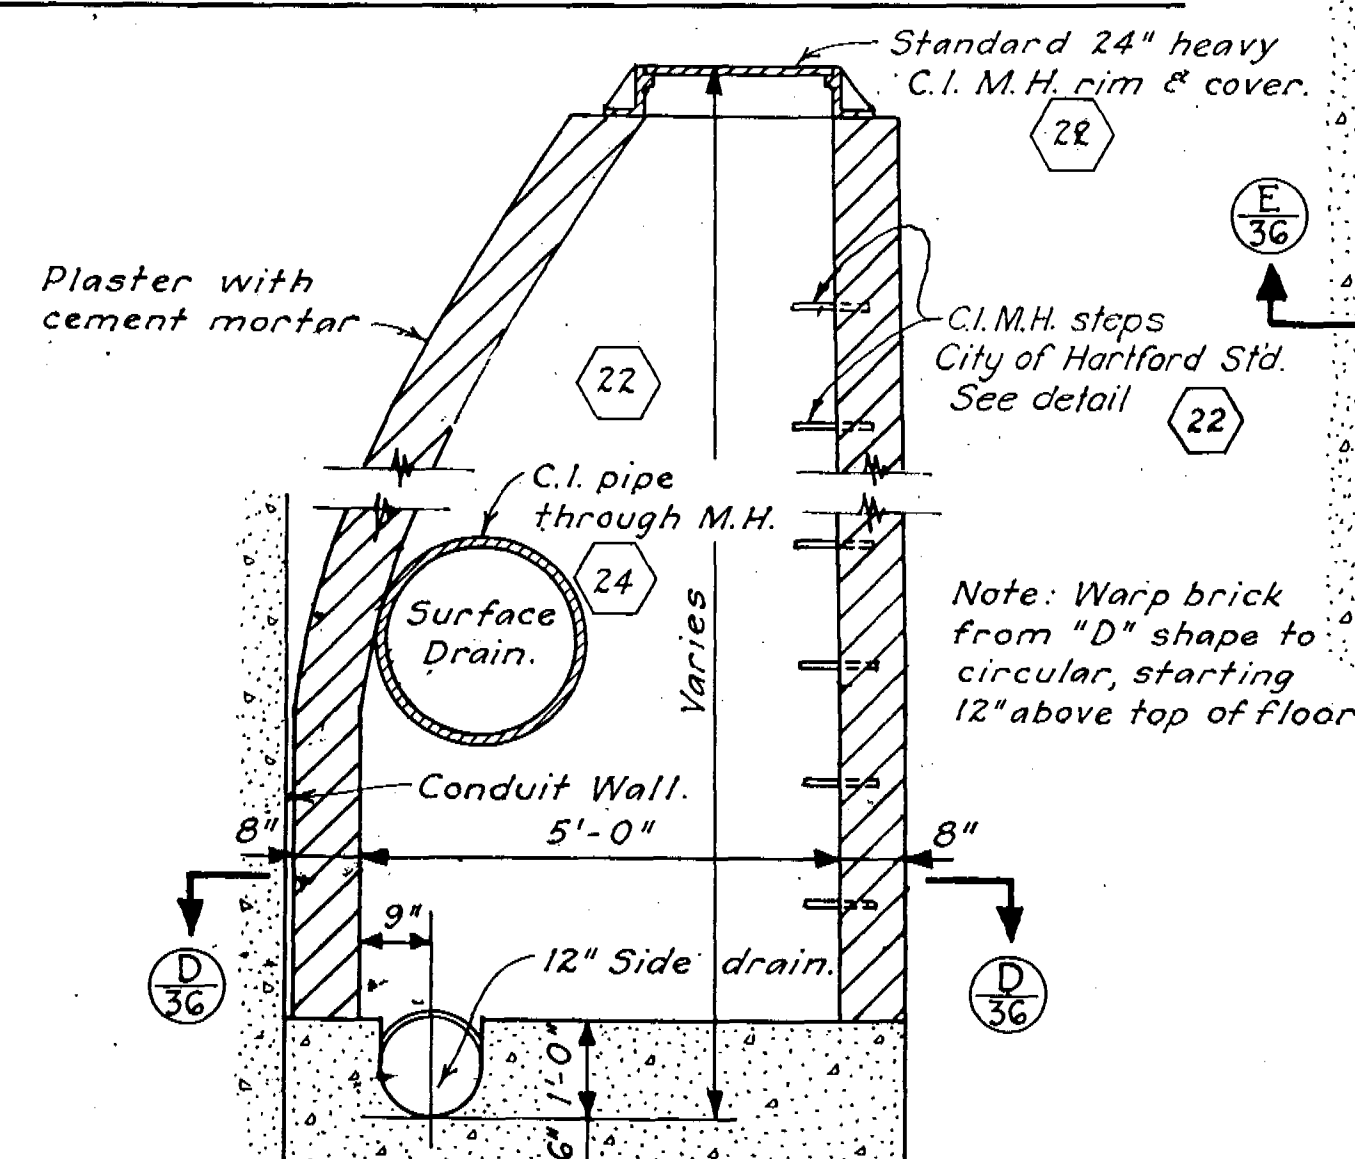
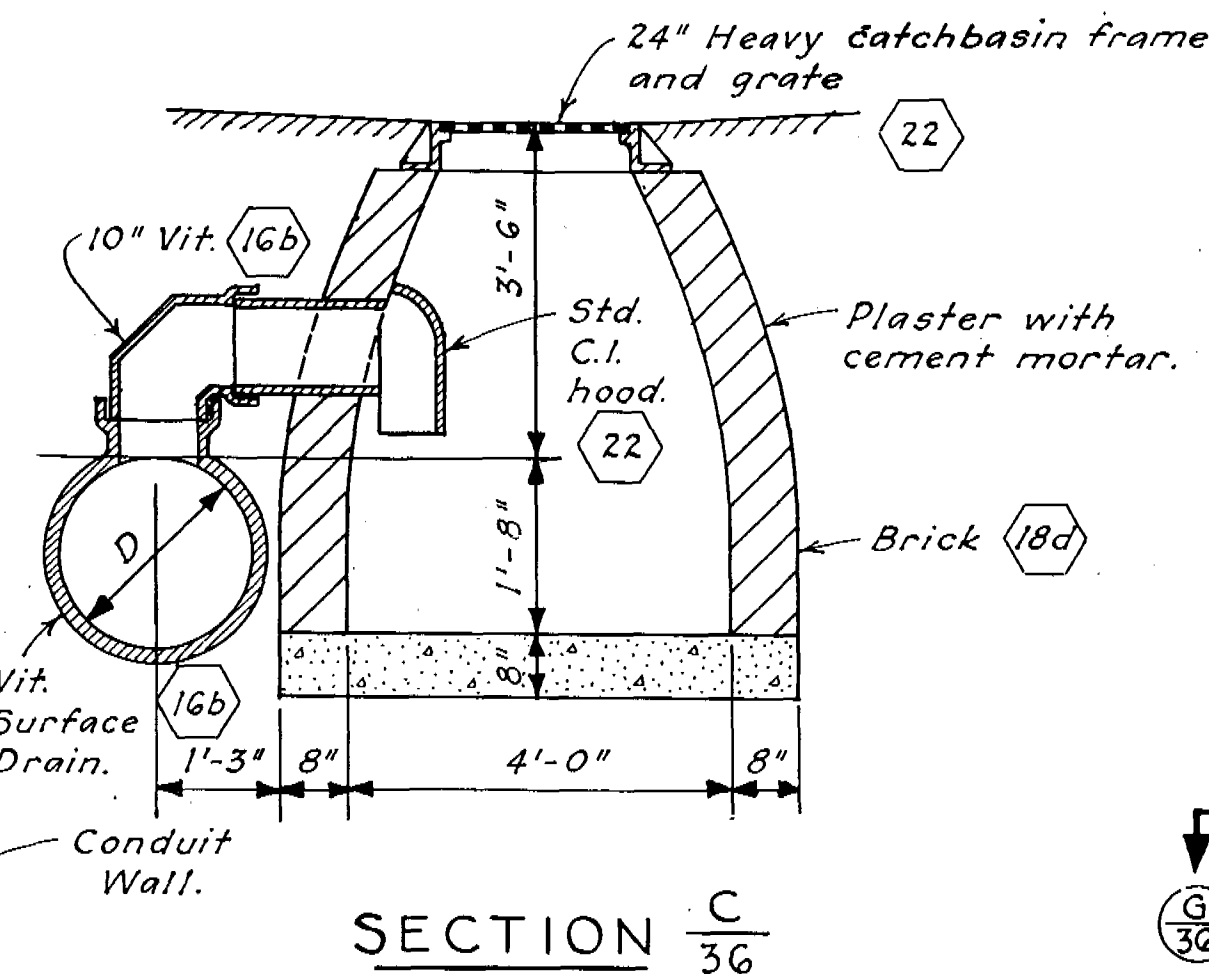
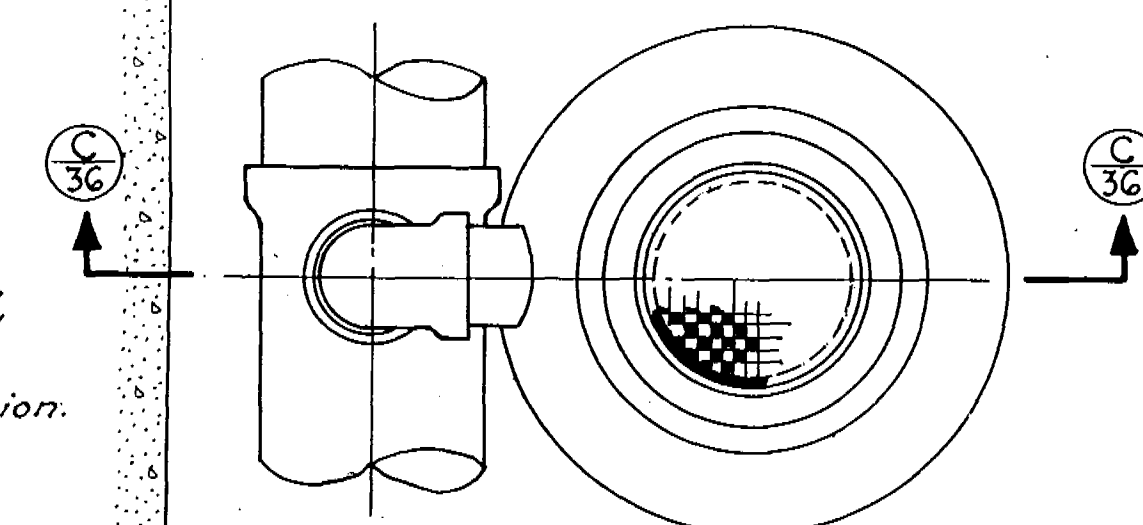
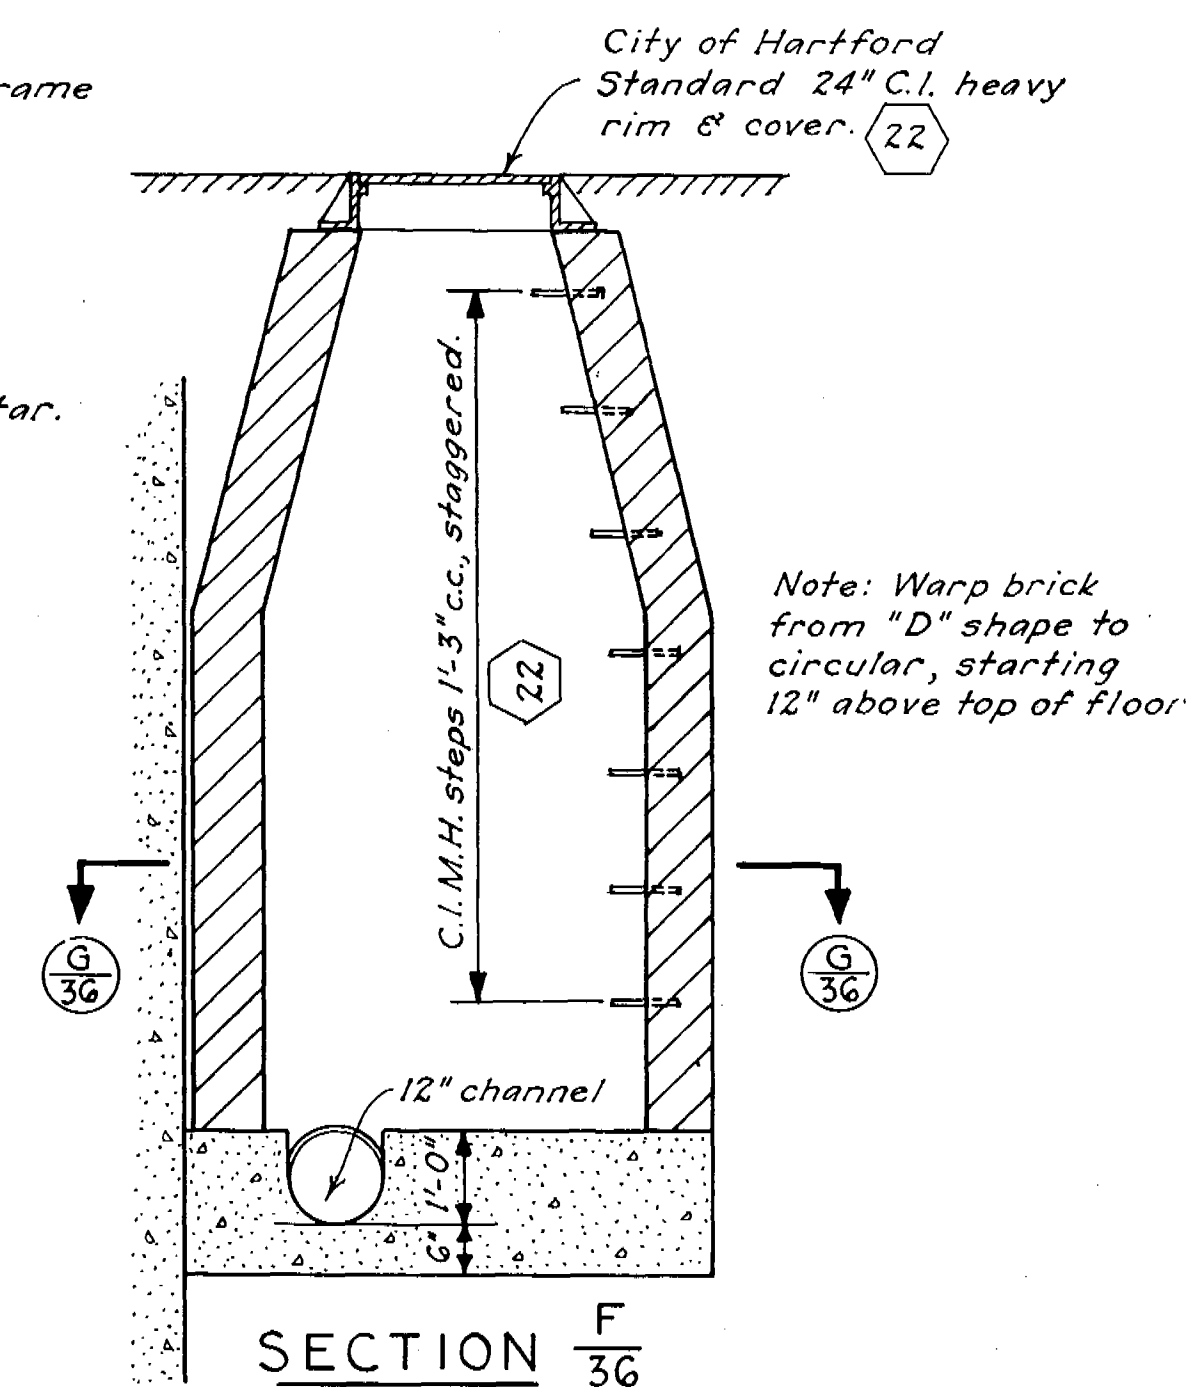
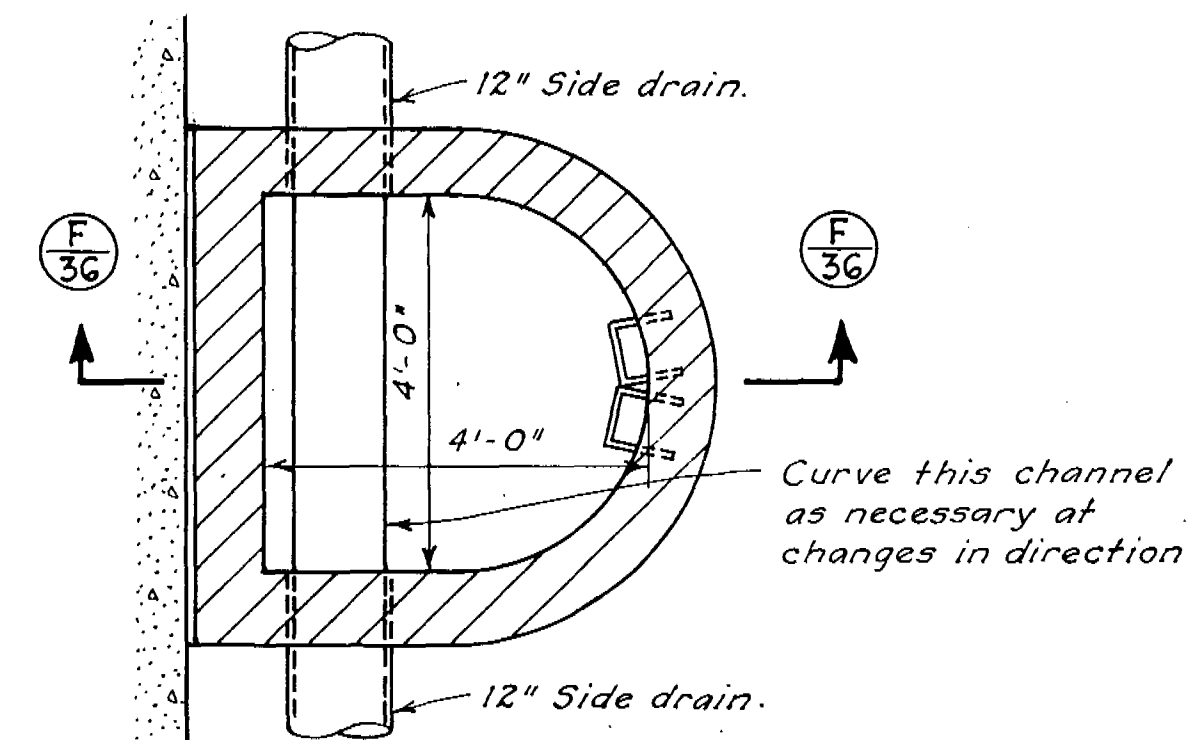


SECTION $\frac{A}{36}$ SECTION $\frac{B}{36}$


TYPICAL SURFACE DRAIN MANHOLE

SECTION $\frac{C}{36}$




TYPICAL MANHOLE FOR SIDE & SURFACE DRAIN

SECTION $\frac{D}{36}$ PLAN
TYPICAL CATCHBASINSECTION $\frac{E}{36}$ SECTION $\frac{F}{36}$

TYPICAL SIDE DRAIN MANHOLE

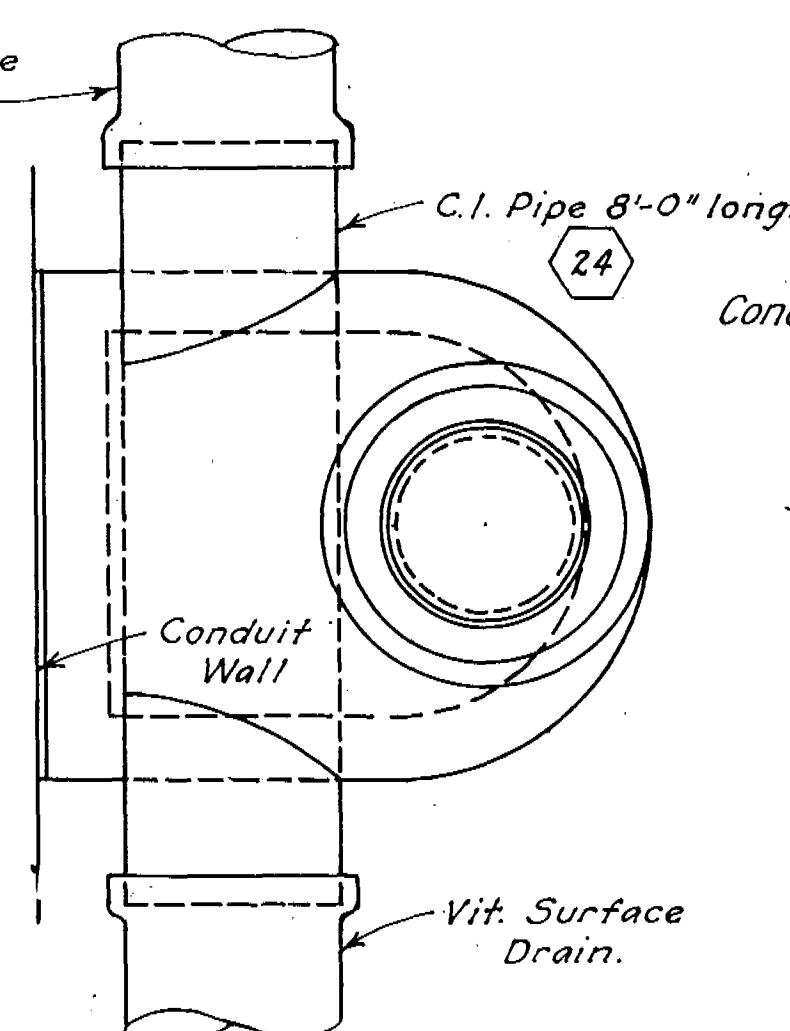

PLAN AT TOP

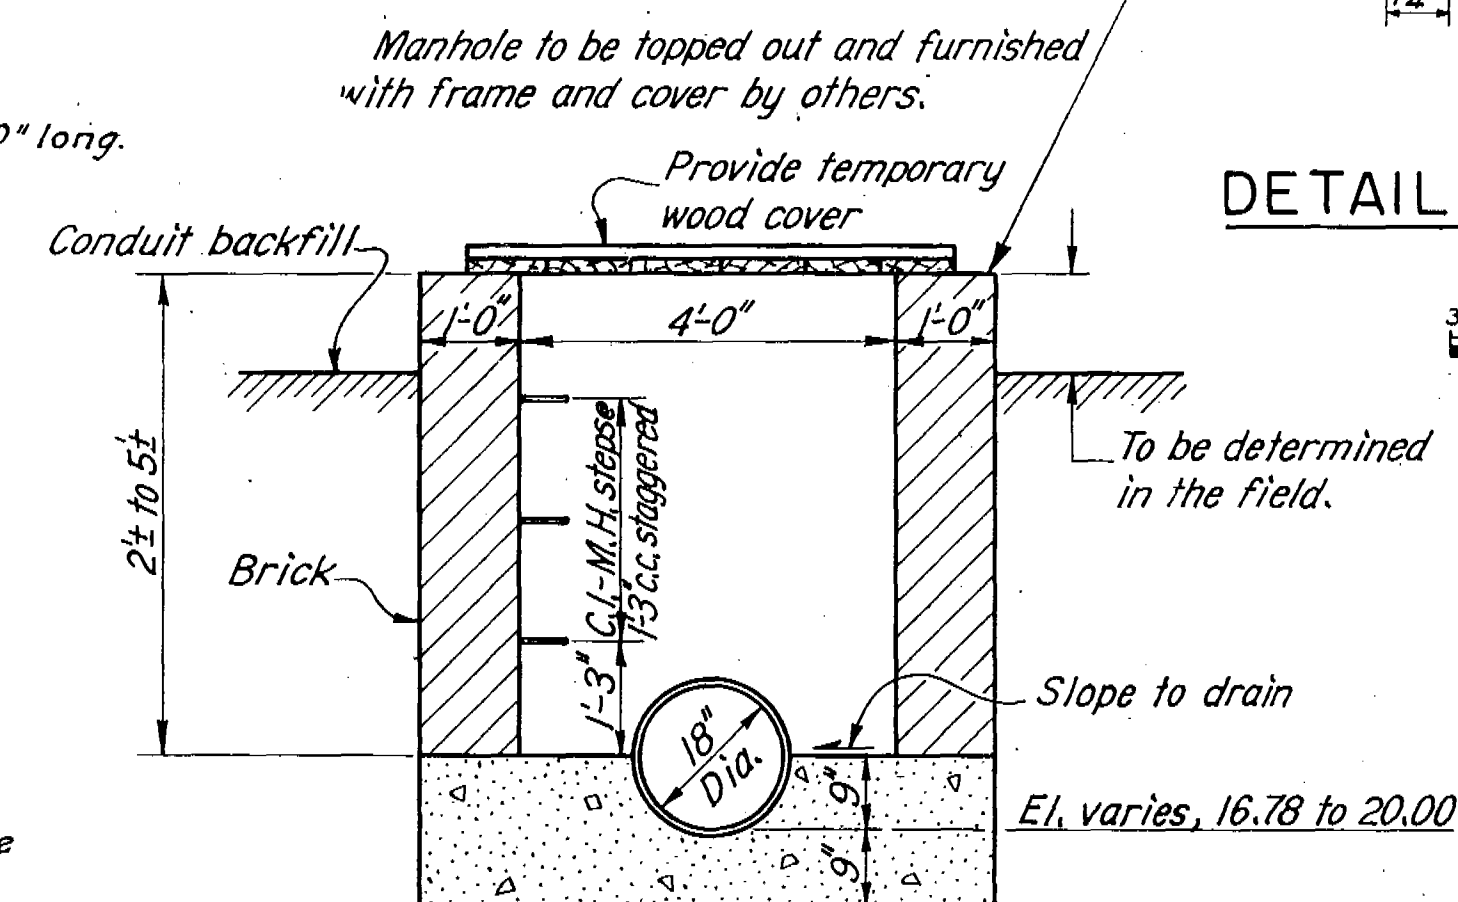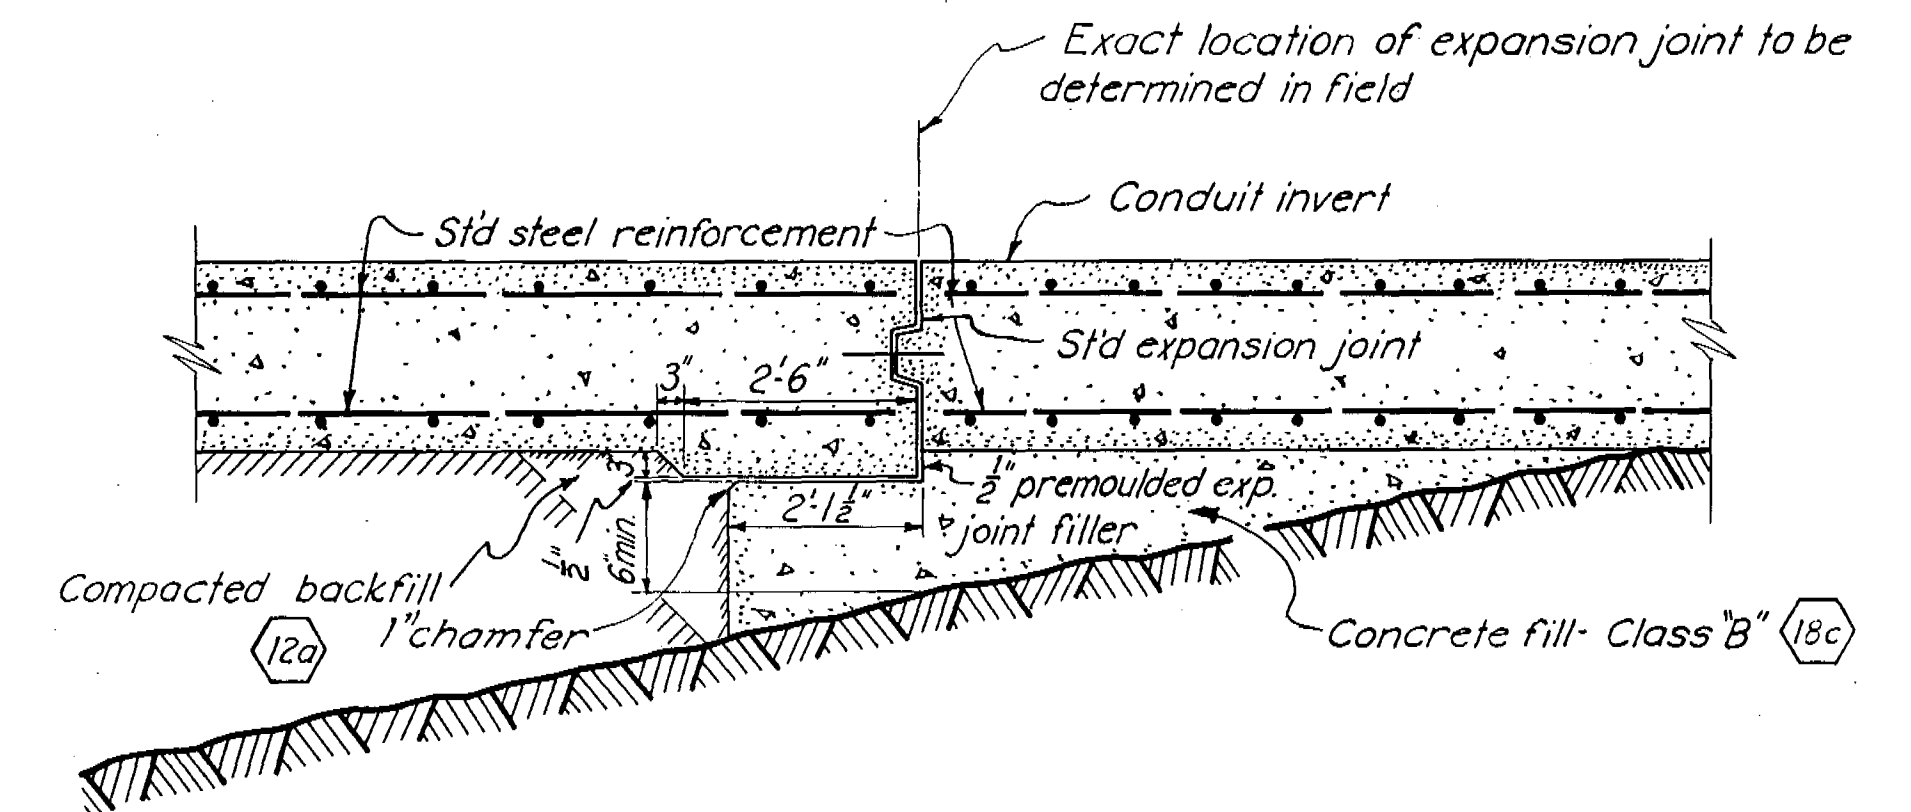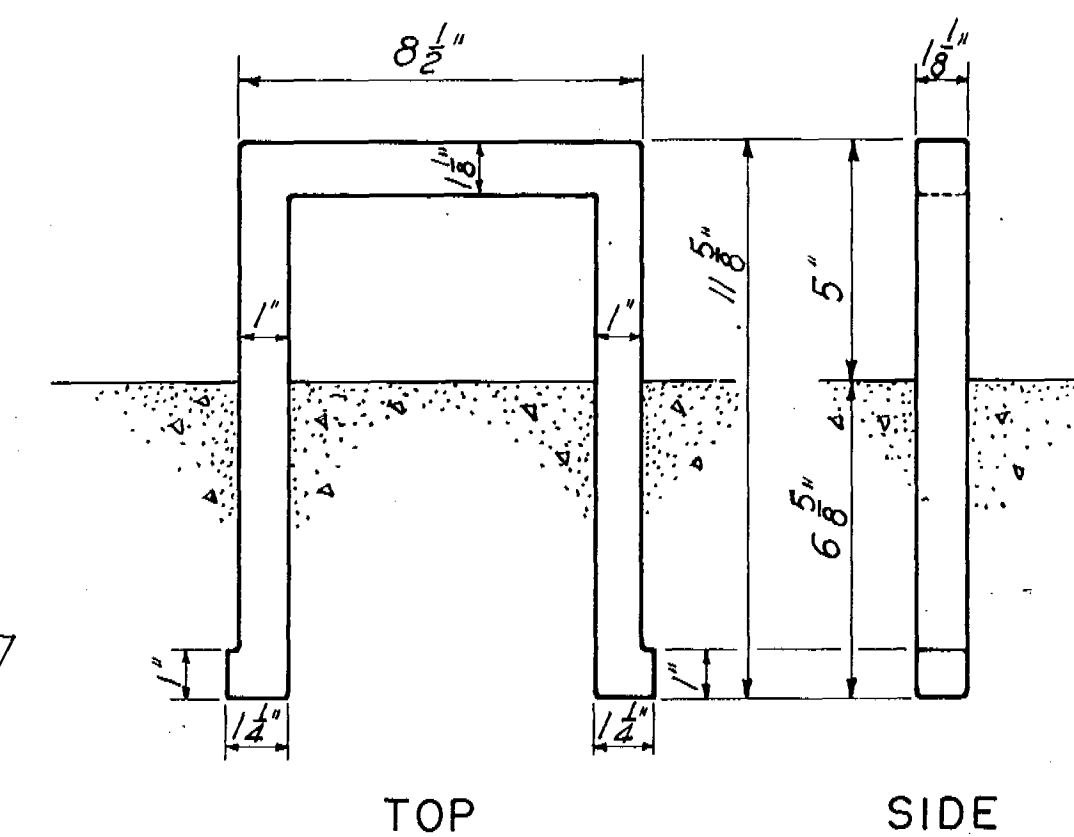
TYPICAL CIRCULAR SURFACE DRAIN MANHOLE
EAST OF COMMERCE STREETTYPICAL TREATMENT OF FOUNDATION AT JUNCTION OF
CONDUIT SECTIONS ON EARTH AND ROCKSCALE: $\frac{1}{2}$ " = 1'-0"

DETAIL OF C.I. MANHOLE STEP

SCALE: 3" = 1'-0"

METCALF & EDDY
ENGINEERS
BOSTON, MASS.

KEY	DATE	REVISION (indicated by Δ)	REV. BY	CK. BY	AP. BY
	12-31-45	As built revisions			
Δ	10-28-41	Manhole detail added	P.C.#	JCS	W.D.

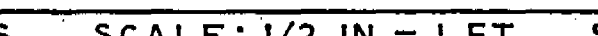CONNECTICUT RIVER FLOOD CONTROL PARK RIVER CONDUIT HARTFORD, CONN. DRAIN MANHOLES AND CATCHBASINS			
CONNECTICUT RIVER		CONNECTICUT	
IN 48 SHEETS		SHEET NO. 36	
SCALE: 1/2 IN. = 1 FT.			
			
U.S. ENGINEER OFFICE PROVIDENCE, R.I.		MAY 1940	
REVIEWED: <i>M.W. Hamer</i> ENGINEER F.C. DESIGN SECTION	APPROVAL RECOMMENDED: <i>J.S. Lawrence</i> PRINCIPAL ENGINEER CHIEF F.C. ENGINEERING DIV.	APPROVED: <i>J.S. Lawrence</i> LT. COL. CORPS OF ENGINEERS DISTRICT ENGINEER	
SUBMITTED: <i>Arthur L. Shaw</i> METCALF & EDDY BOSTON, MASS.	(PARTNER)	DRAWN BY: A.R.S. TRACED BY: E.F.M. CHECKED BY: J.M.	FILE NO. CT-4-2634