
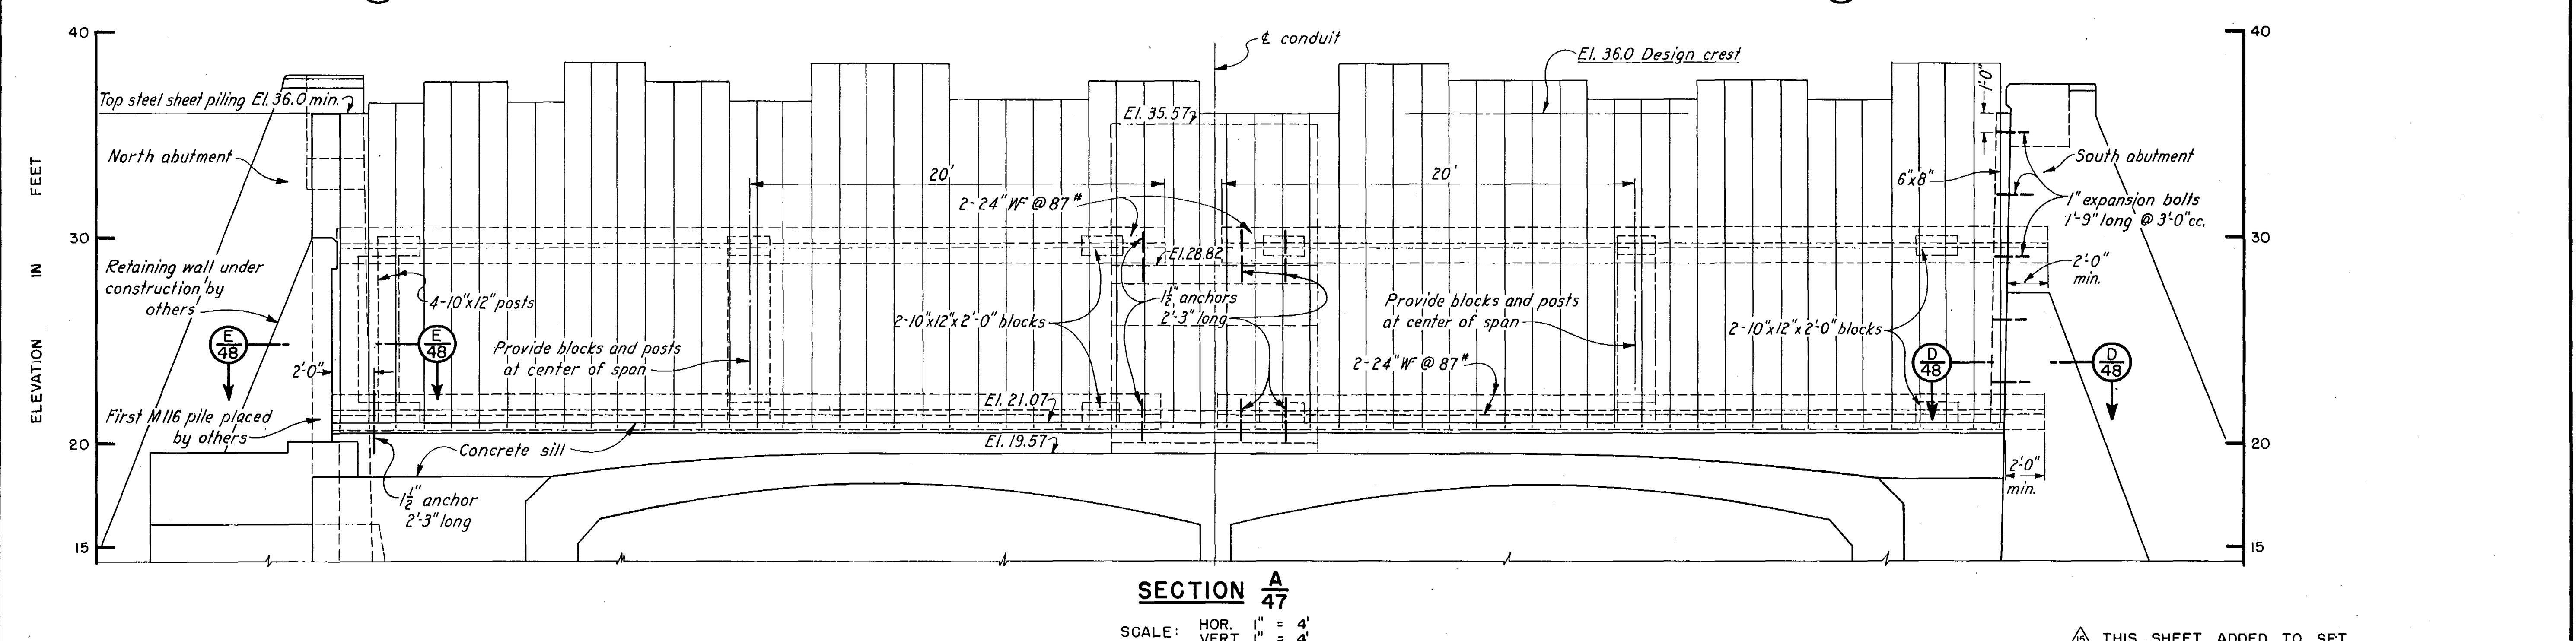


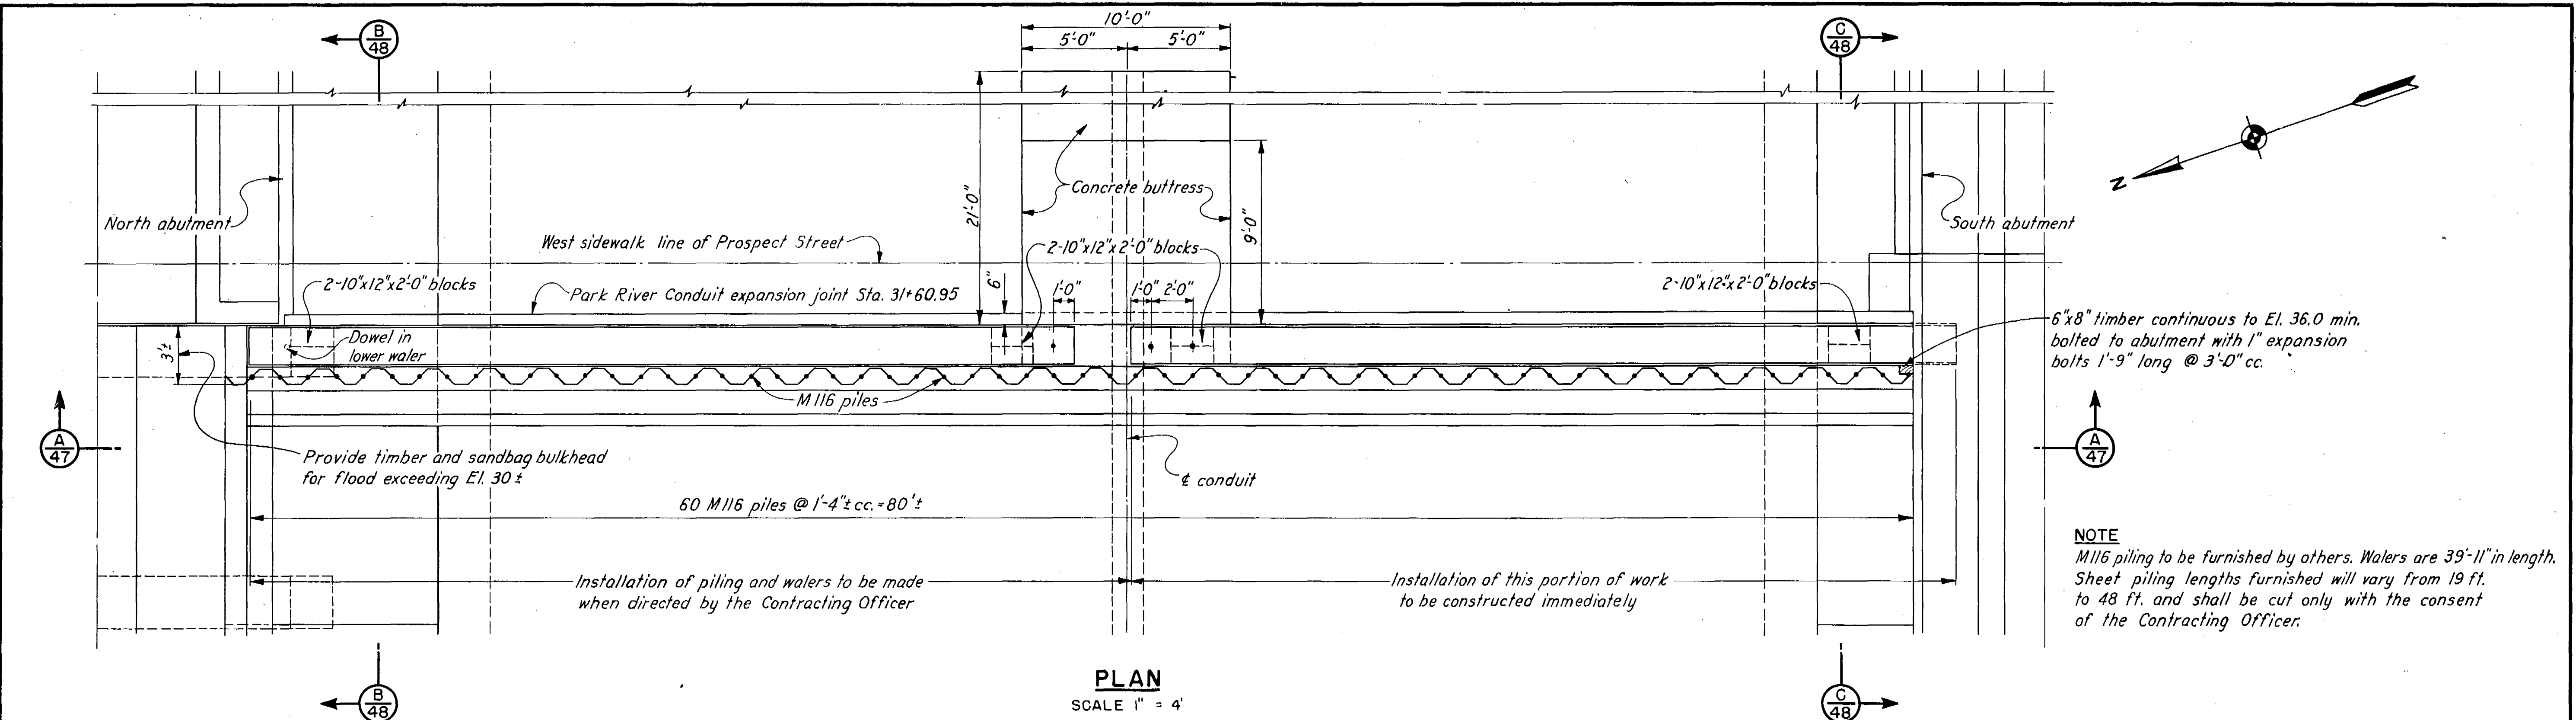

NOTES
Elevations refer to Mean Sea Level datum.
M116 piles to be furnished by others.
Bolt every other pile to top water. Bolt every fourth pile to bottom water.
All concrete shown will be class "A"

THIS SHEET ADDED TO SET.

CONNECTICUT RIVER FLOOD CONTROL
PARK RIVER CONDUIT
HARTFORD, CONN.

TEMPORARY SHEET PILE BULKHEAD AT
PROSPECT STREET - PLAN AND SECTION

CONNECTICUT RIVER IN 48 SHEETS SCALE 1 IN. = 4 FT. SHEET NO. 47

U.S. ENGINEER OFFICE, PROVIDENCE, R.I., MARCH 1943

SUBMITTED BY: *J. D. Sigall* SENIOR ENGINEER
DESIGN SECTION
HEAD, DESIGN SECTION

APPROVED: *J. D. Sigall* SENIOR ENGINEER
PRINCIPAL ENGINEER
CHIEF, ENGINEERING DIVISION

APPROVED: *J. D. Sigall* SENIOR ENGINEER
PRINCIPAL ENGINEER
CHIEF, ENGINEERING DIVISION

DESIGN SECTION: *E. D. Chase* ASSOC. ENGINEER
DRAWN: D. W. C.
TRACED: H. R. F.
CHECKED: *E. D. Chase*

FILE NO. CT-4-3143

KEY	DATE	REVISION (Indicated by Δ)	REV. BY	CK. BY	AP. BY
	12-31-45	As built			