




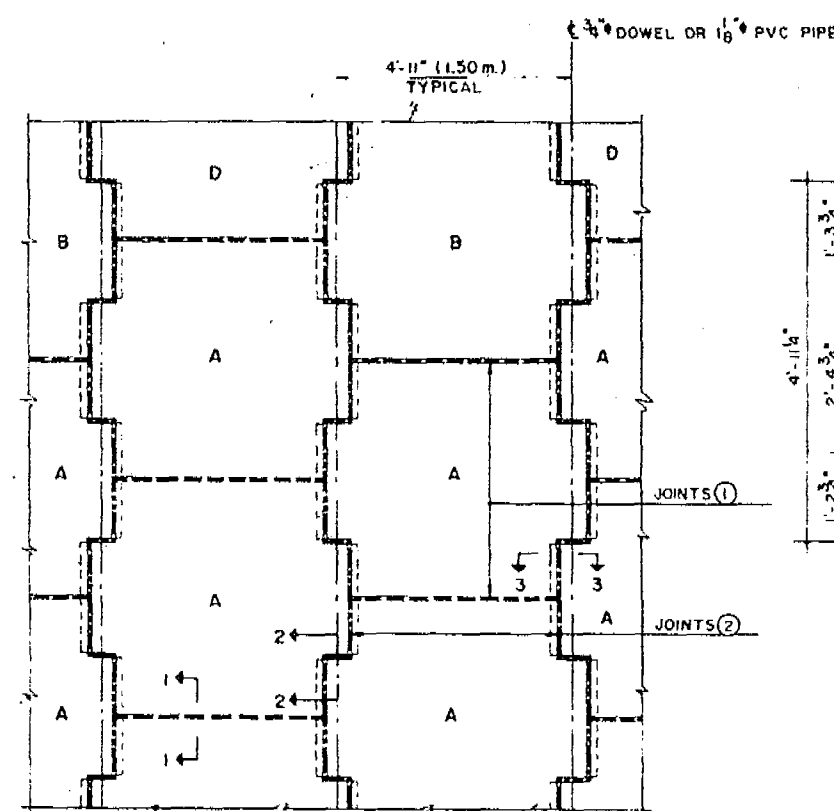

TYPICAL PANEL LAYOUT
SCALE 1/2" = 1'-0"

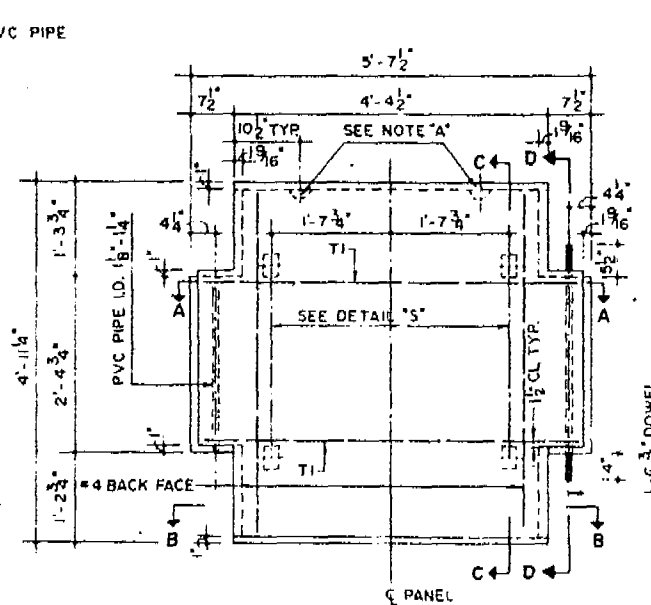


PANEL TYPE A & B
FRONT VIEW

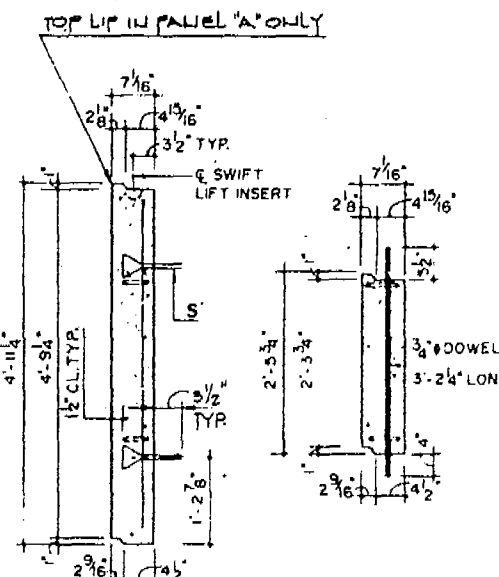


SECTION C-C

SECTION D-D

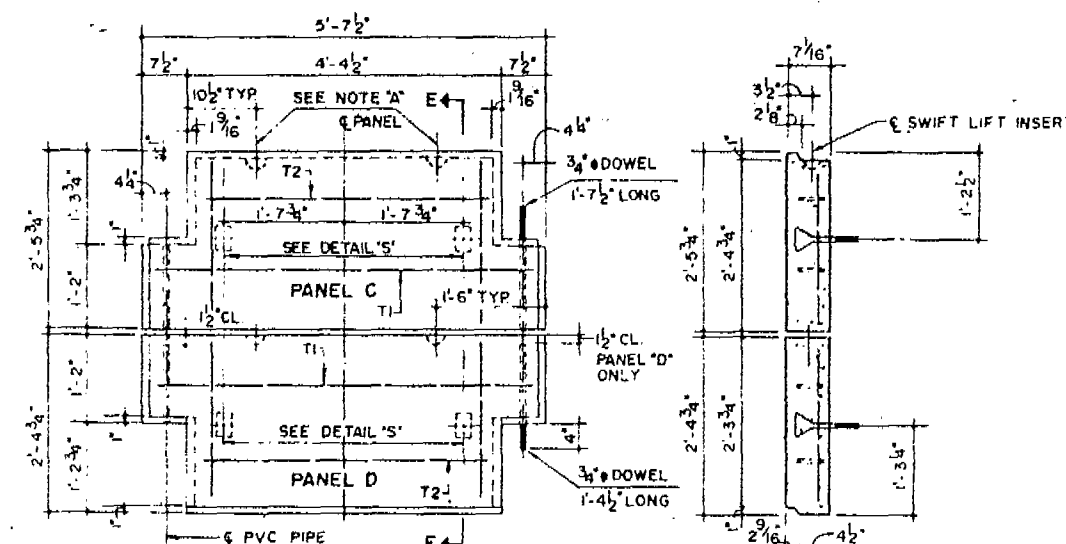


HALF PANELS C & D
FRONT VIEW


SECTION E-E

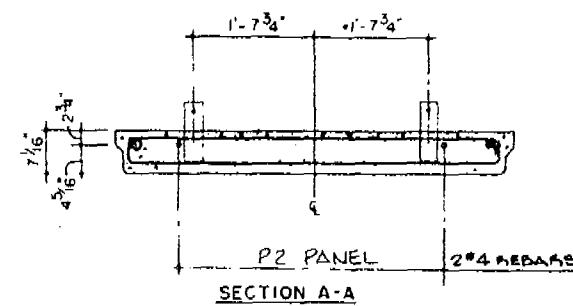


SECTION A-A

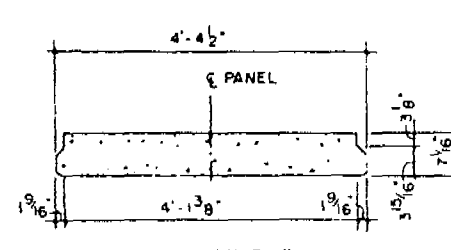

SECTION B-B

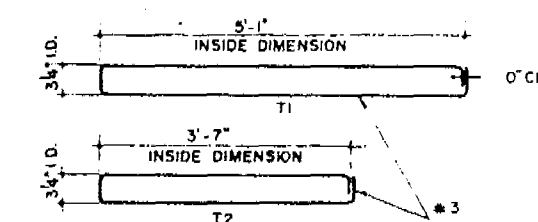


STIRRUP DETAILS
NOT TO SCALE

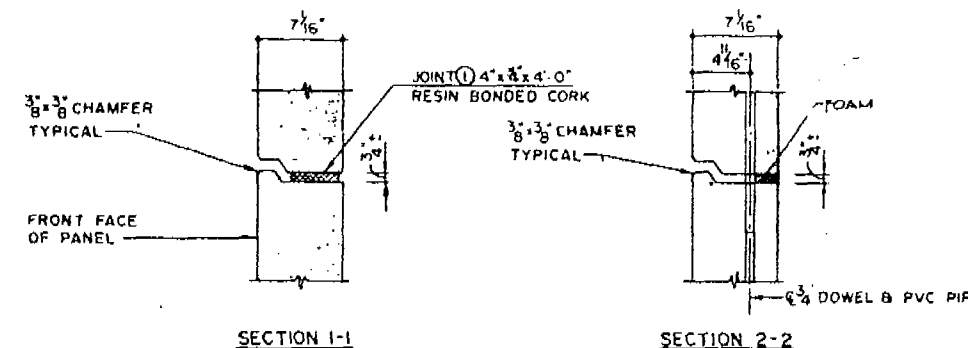


SECTION 1-1


SECTION 2-2

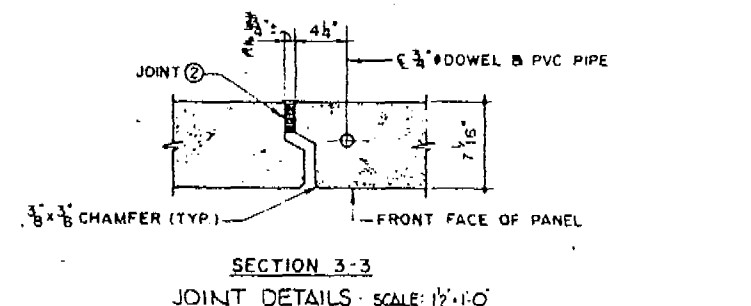


SECTION 3-3

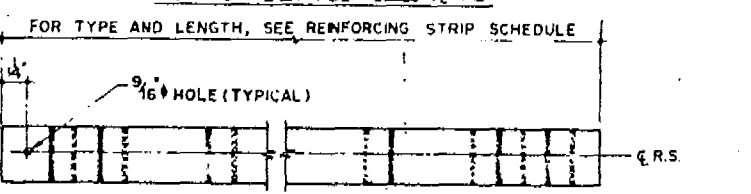

DETAIL OF REINFORCING STRIP
NOT TO SCALE

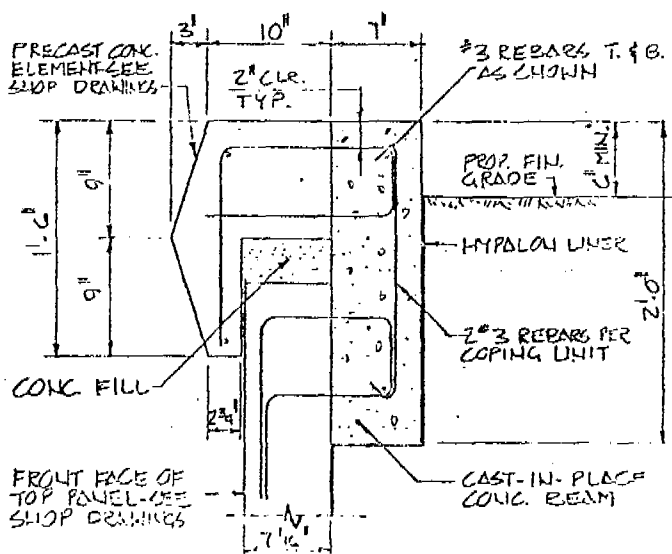

TYPICAL COPING DETAIL
SCALE 1/2" = 1'-0"

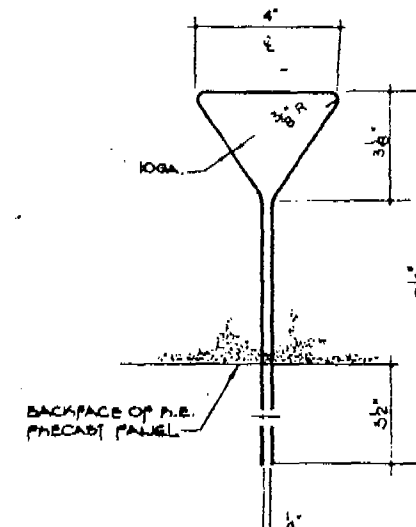



TIE STRIP DETAIL 'S'
NOT TO SCALE

PANEL SURFACE AREA	
TYPE	SQ. FT.
A	24.2
D	24.2
C	12.1
D	12.1

NOTE 'A'
ONE TON SWIFT LIFT INSERTS 3/8" x 3/8" LONG AS MANUFACTURED BY SUPERIOR CONC. ACCESSORIES

- NOTES
1. REINFORCING BARS SHALL BE STEEL A615 GRADE 40
 2. 3/8" x 3/8" CHAMFER SHALL BE PROVIDED ON ALL EXPOSED EDGES (FRONT FACE ONLY)
 3. DETAILS NOT SHOWN WILL BE SUBMITTED AS SHOP DRAWINGS

As Built Drawing
Contract No. DACW 33-76-C-0098

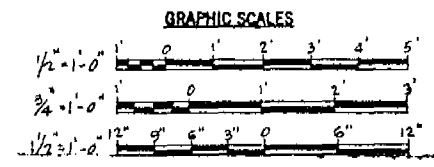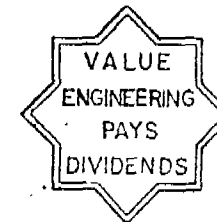

The drawing contains information proprietary to The Reinforced Earth Company, and is being furnished for the use of DEPT. OF ARMY, NEW ENGLAND DIV., CORPS OF ENGINEERS, only in connection with this project, and the information contained herein is not to be transmitted to any other organization unless specifically authorized in writing by The Reinforced Earth Company.
The Reinforced Earth Company is exclusive licensee in the United States under patents issued to Henri Vidal, and the furnishing of this drawing does not constitute an express or implied license under the Vidal patents.

REVISION		DATE	DESCRIPTION	BY
13-60-79			Corner Details and notes deleted.	BRK/ML
DEPARTMENT OF THE ARMY NEW ENGLAND DIVISION CORPS OF ENGINEERS WALTHAM, MASS.				
WATER RESOURCES DEVELOPMENT PROJECT PARK RIVER LOCAL PROTECTION BOX CONDUIT AT SECTION 9 EAST FLOOD WALL DETAILS NO. 2				
DES. BY LBR		DR. BY LBR	EC. BY LBJ	
SUBMITTER James P. Reed		CHIEF, CIVIL ENG. SECTION		
APPROVED John P. Reed		CHIEF, ENGINEERING DIVISION		
REVIEWED John P. Reed		PROJECT MANAGER		
APPROVAL RECOMMENDED		APPROVED		
CHIEF, PROJECT BRANCH		CHIEF, ENGINEERING DIVISION		
DATE		DATE		
APRIL 1979		APRIL 1979		
SCALE AS SHOWN SPEC. NO. DACW33-76-B-0040		DRAWING NUMBER		
PAR-1		SHEET 79B		