
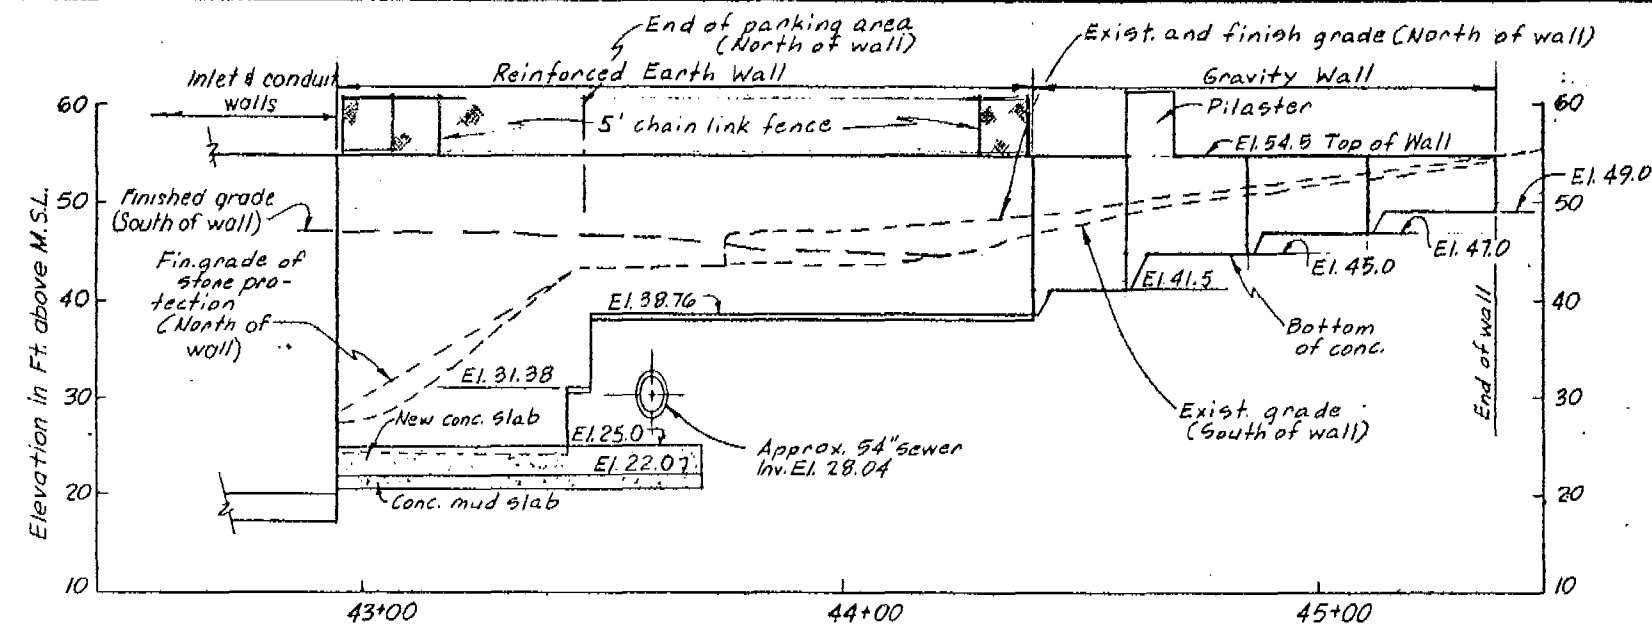
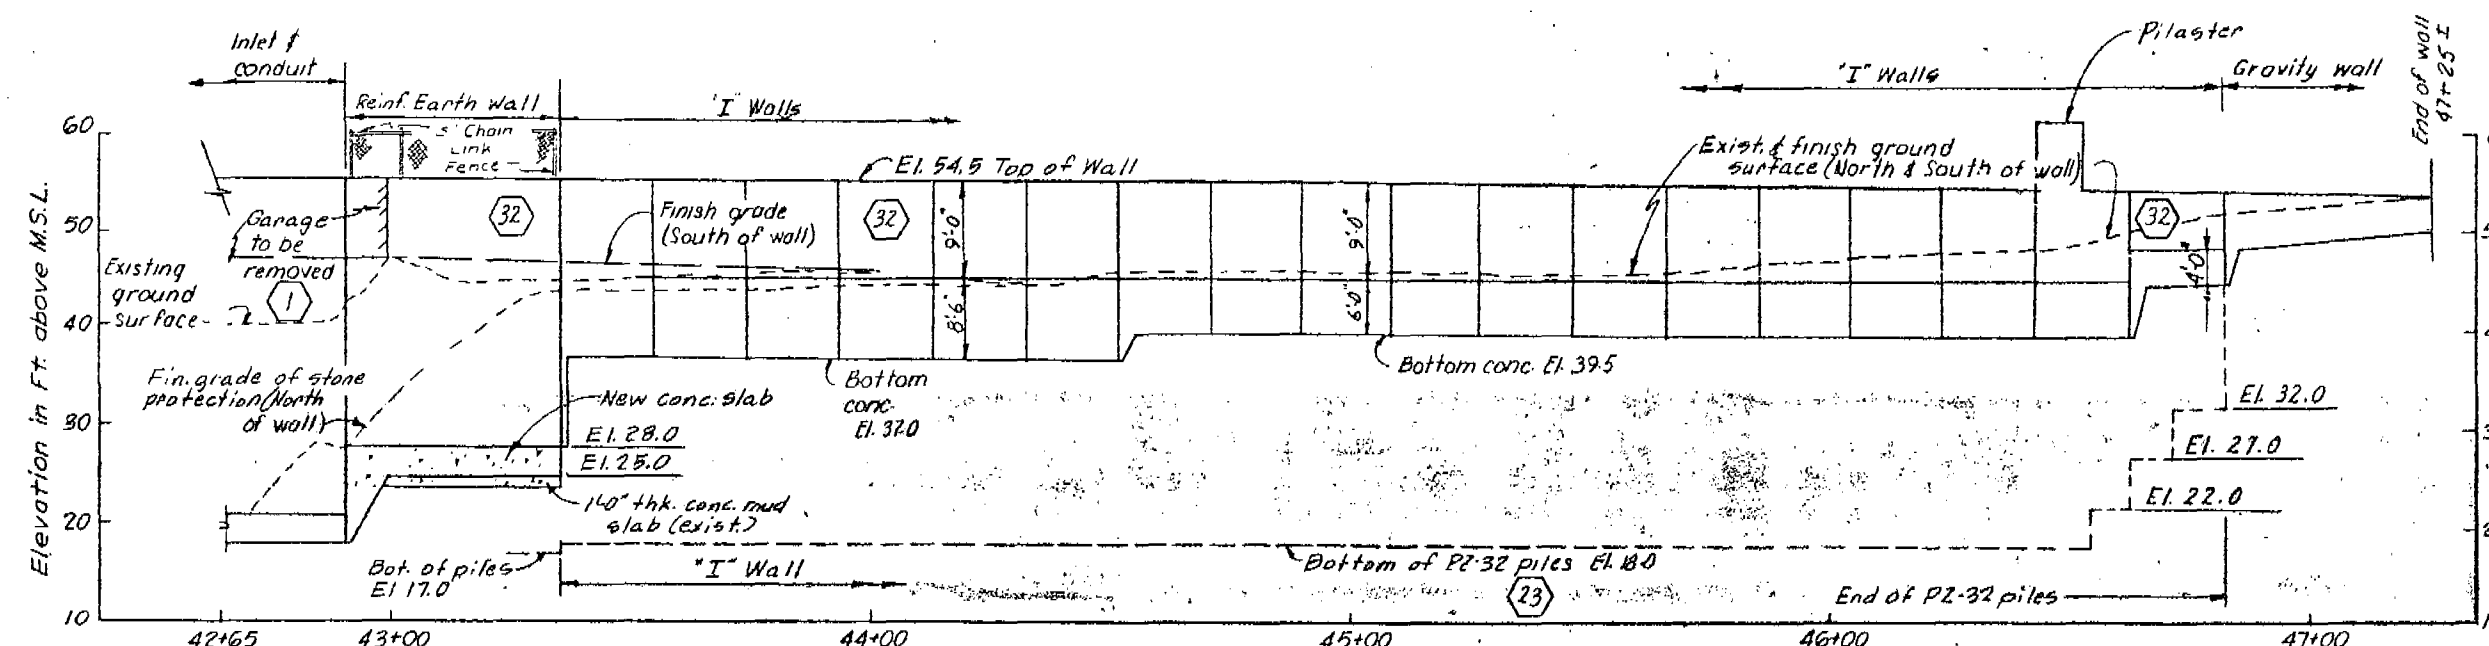


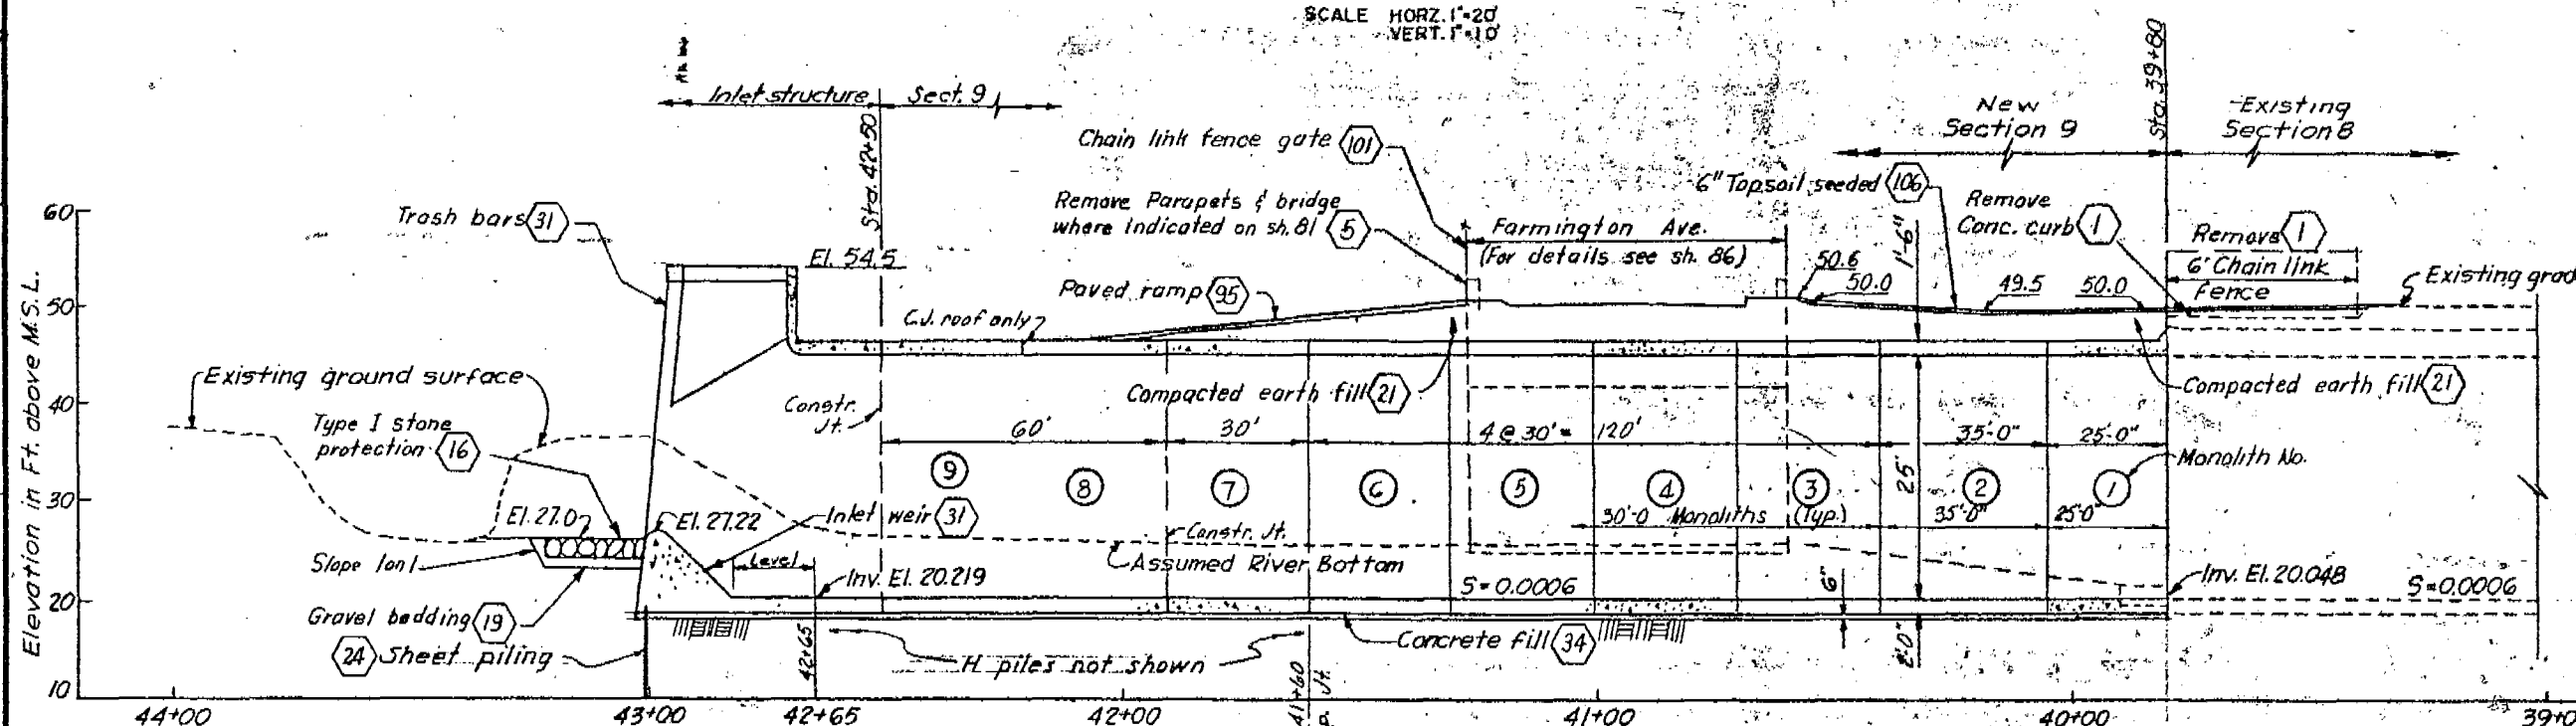



PROFILE EAST FLOOD WALL A

SCALE: HORIZ. 1"=20'
VERT. 1"=10'

PROFILE WEST FLOOD WALL A

SCALE: HORIZ. 1"=20'
VERT. 1"=10'

SECTIONAL PROFILE - SECTION 9

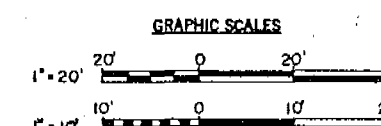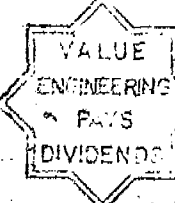SCALE: HORIZ. 1"=20'
VERT. 1"=10'

- NOTES:
1. See Sheets 79A, 79B, and 79C for Reinforced Earth Wall details.
 2. See Sheets 93 & 94 for 'I' wall and gravity wall details.
 3. For typical section of Section 9 Box Conduit See Sh. 88.
 4. For monoliths 3A and 7A dimensions varies from 6' to 12'. Refer to sheets 83 and 84.

As Built Drawing

Contract No. DACW 33-76-C-0098

REVISION	DATE	DESCRIPTION	BY
1	1/3 Jan 79	Profile West Flood Wall and note revised.	W. H. H.
2	4/16/79	Profile East Flood Wall and note revised.	W. H. H.
3	12 Jan 79	Inlet structure, Section 9 revised.	W. H. H.
4	13 Oct 77	Dimension Changed.	W. H. H.

DEPARTMENT OF THE ARMY NEW ENGLAND DIVISION CORPS OF ENGINEERS WALTHAM, MASS.			
WATER RESOURCES DEVELOPMENT PROJECT PARK RIVER LOCAL PROTECTION BOX CONDUIT AT SECTION 9 PROFILES AND SECTIONS			
DES. BY T. R.	CHK. BY J. A. P.	APP. BY I. R.	DATE MARCH 1978
PROJECT ENGINEER HARTFORD			DATE MARCH 1978
APPROVED HARTFORD			DATE MARCH 1978
SCALE AS SHOWN			SPEC. NO. DACW 33-76 B-0040
DRAWING NUMBER PAR-1			SHEET 80