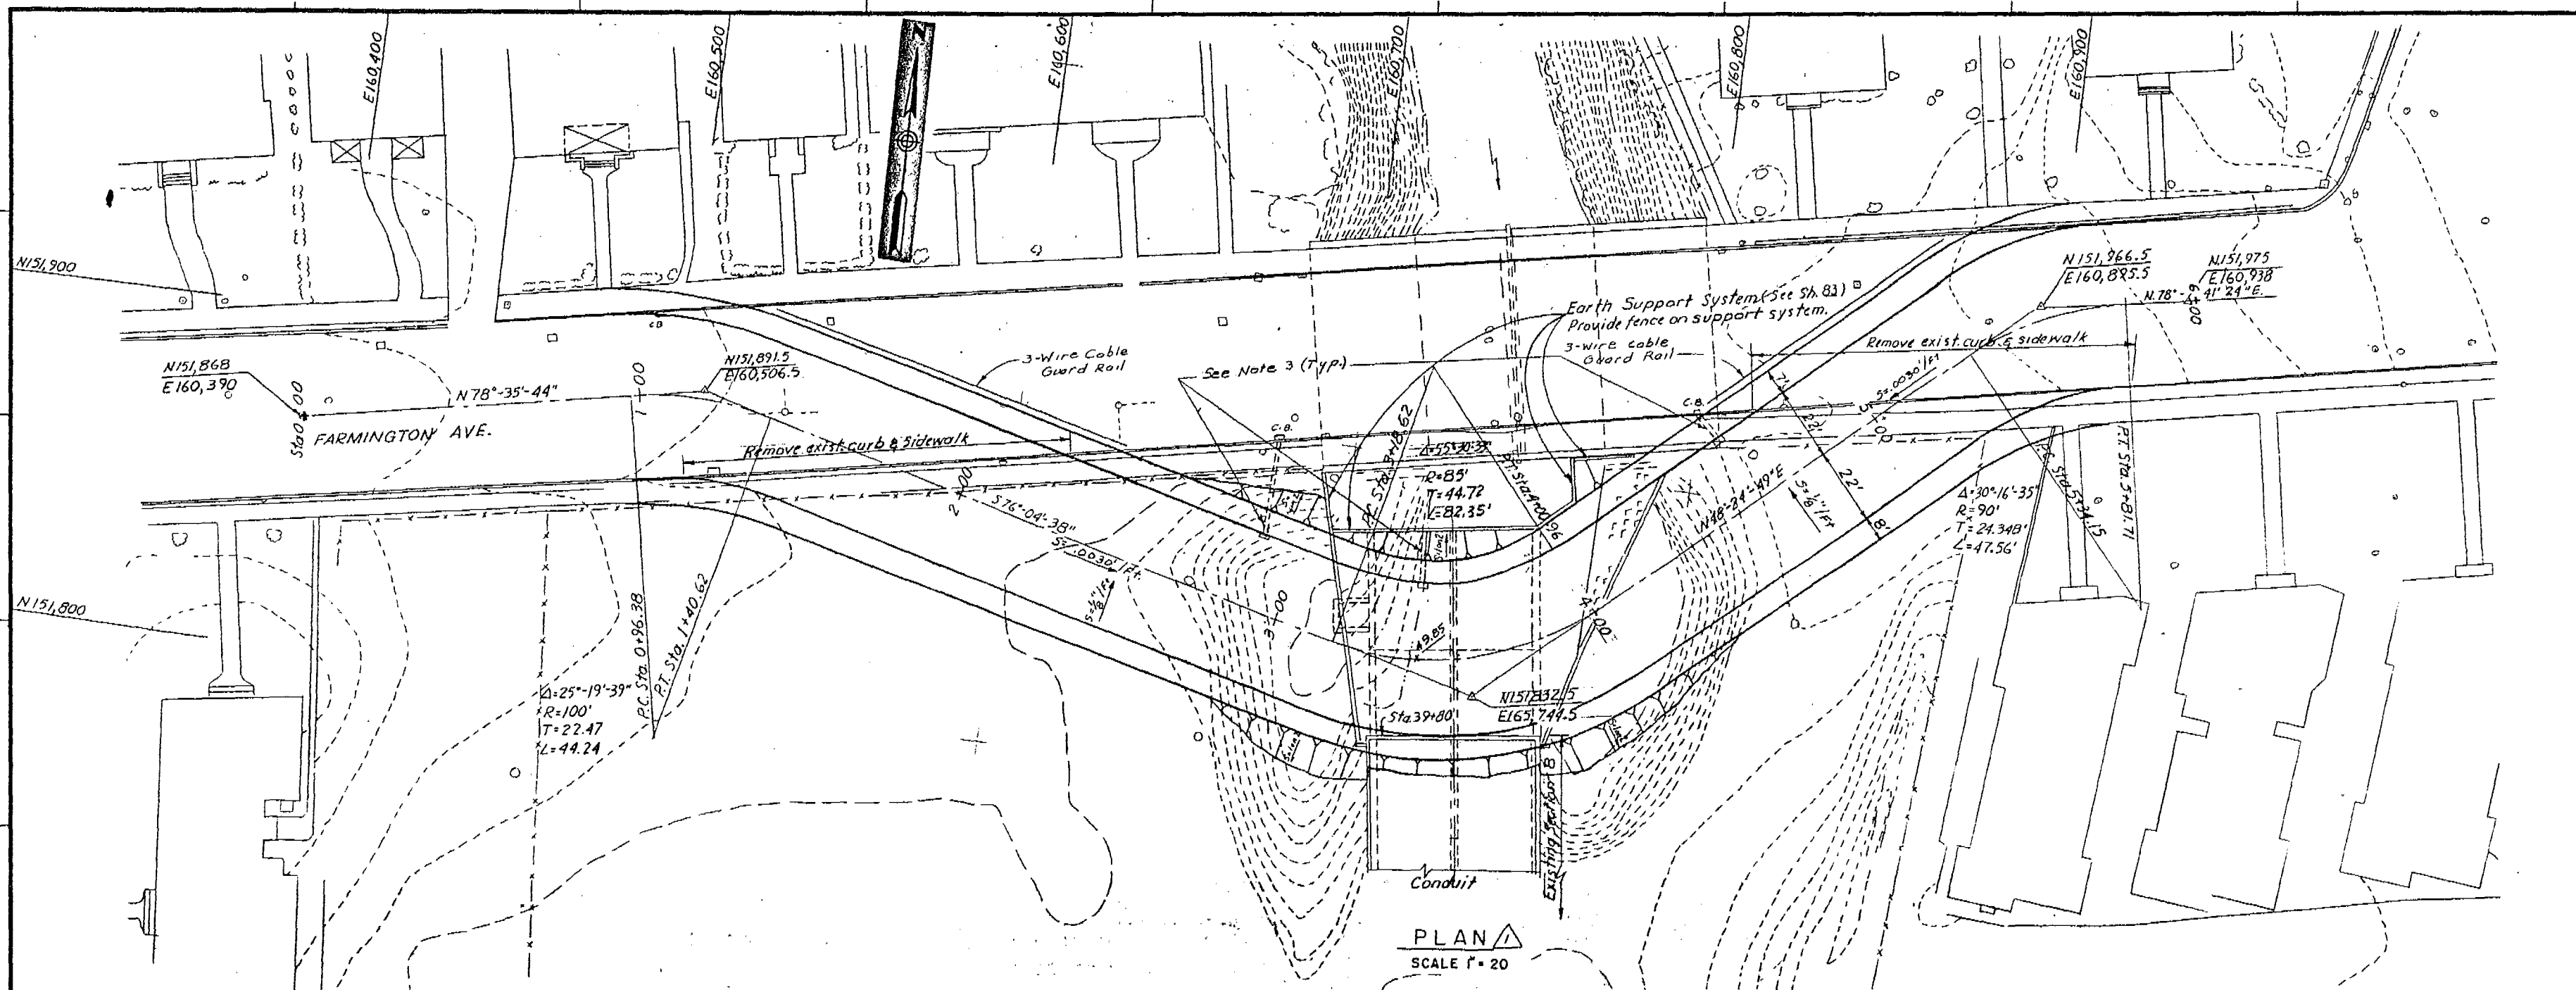




NOTES: For utilities for detour see sheet 79, 95 & 123

2. Detour pavement to be marked with two 11' East and two 11' west bound lanes. East and West lanes to be separated with a double yellow centerline the entire length of the detour. See Section 12A of the specification.



13. Provide storm water interceptors at north side of Detour and drain water to river.

As Built Drawing

Contract No. DACW 33-76-C-0098

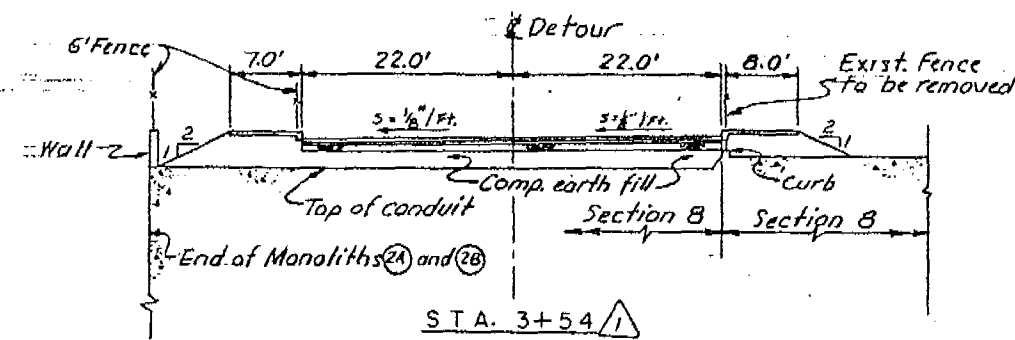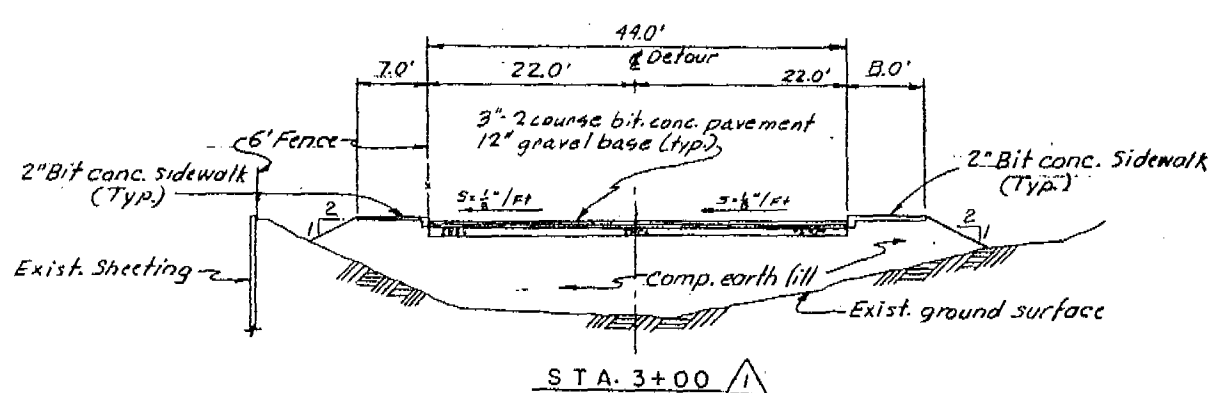

TYPICAL SECTIONS
SCALE: 1" = 10'

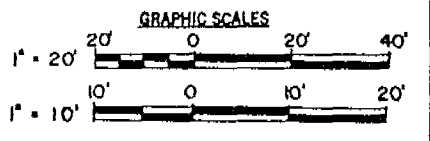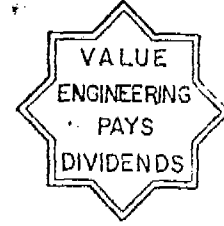[illegible]