

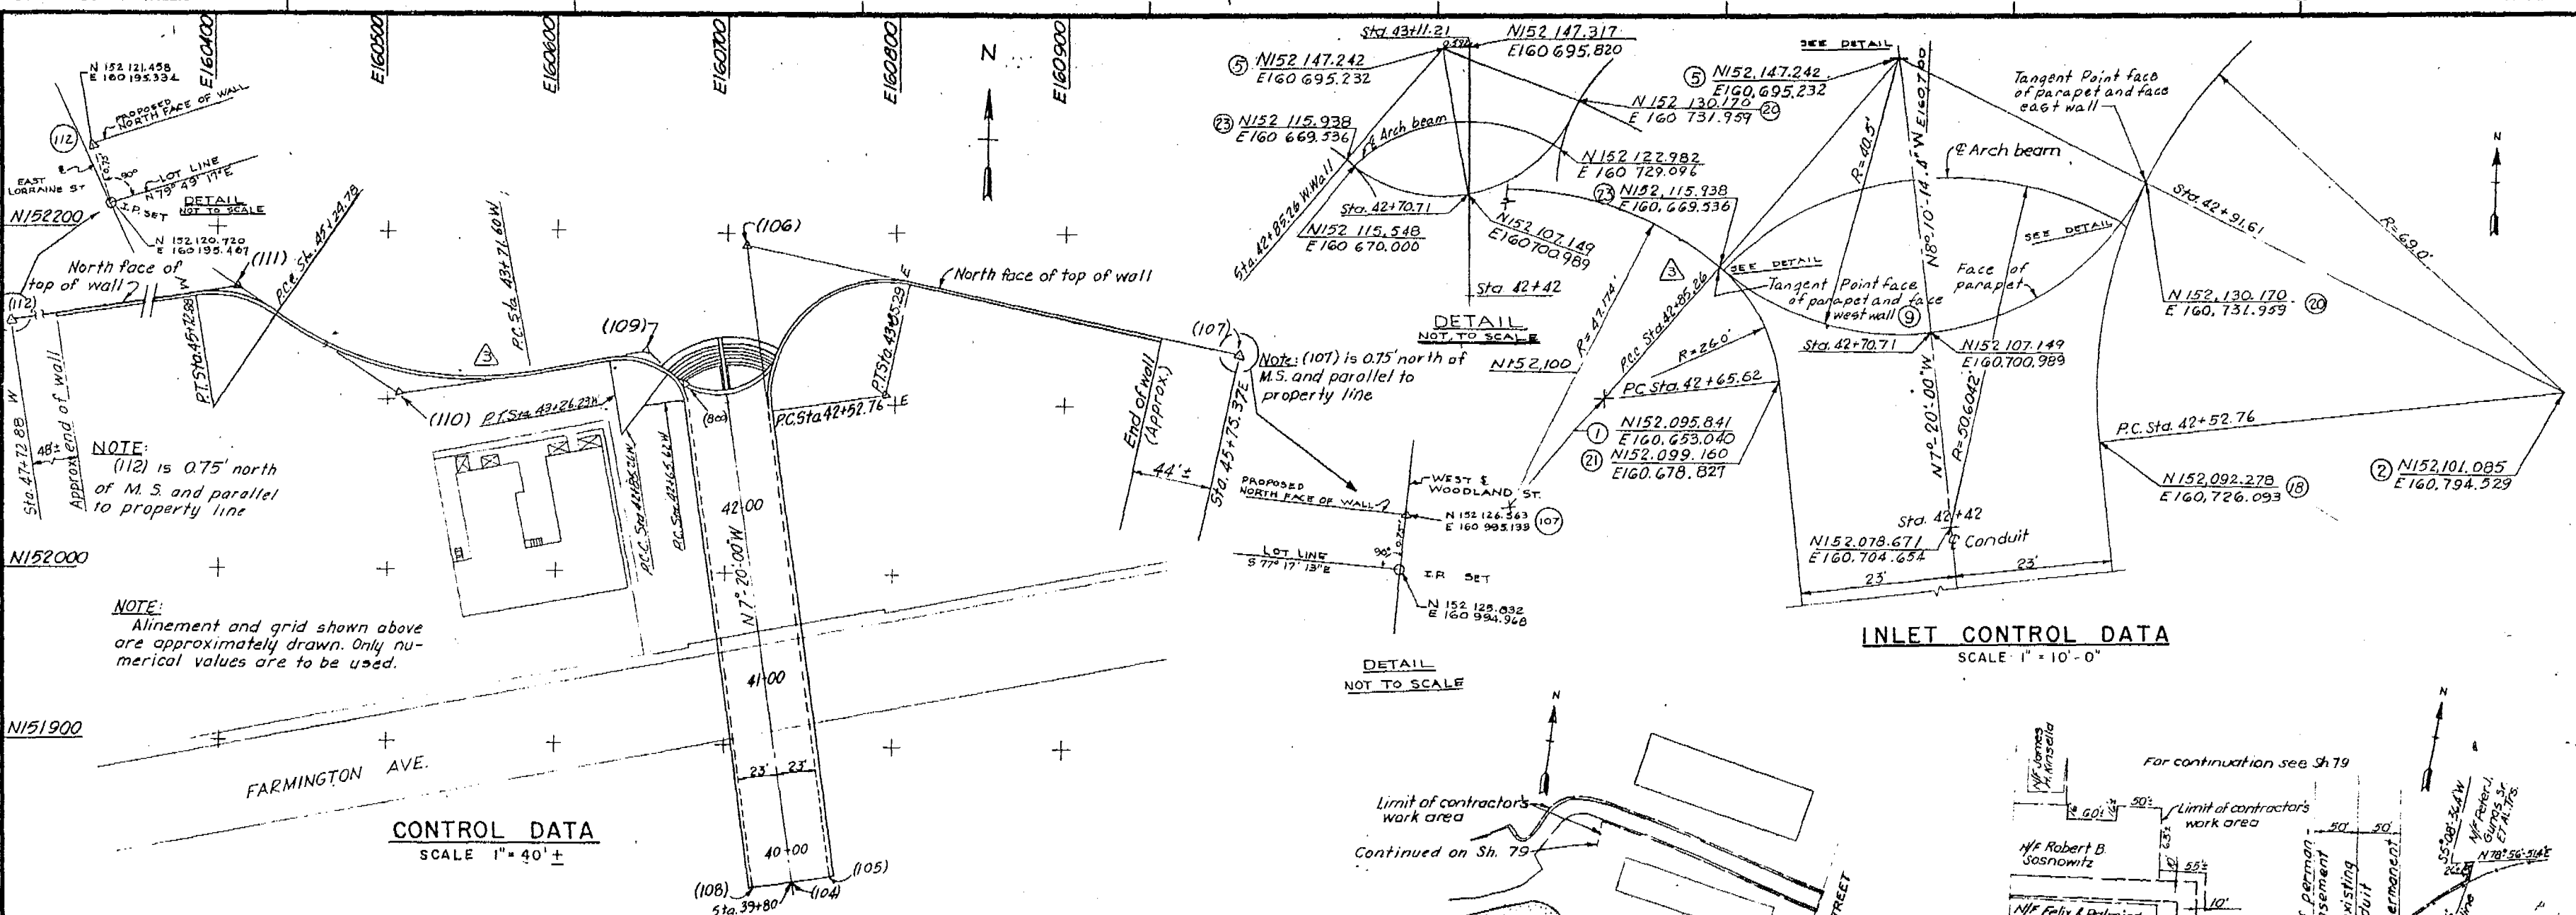
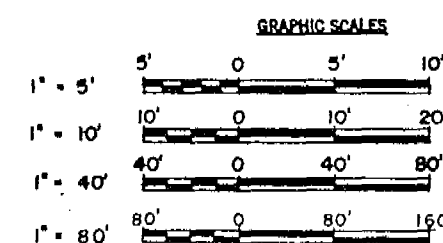


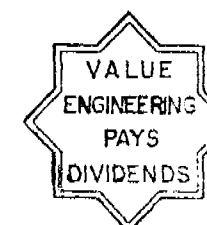

PT. NO.	NORTH	EAST	DIST.	BEARING	T	R	L.C.	Δ	P.C. Sta.	P.T. Sta.
108	151815.878	160715.284	295.934	N 7° 20' 00" W	10.317	26.0	19.643	43-17-12.1	42+65.62	42+85.26 W
109	152129.819	160652.626	32.195	N 50° 37' 11.7" W	21.878	47.17	40.970	49-45-41.4	42+85.26	43+26.23 W
110	152103.182	160507.229	147.816	S 79° 37' 06.7" W	80.569	200.00	153.183	43-53-01.5	43+71.60 W	45+24.78 W
111	152161.609	160418.963	105.852	N 58° 29' 51.7" W	26.051	65.00	49.554	43-40-71.3	45+24.78 W	45+72.89 W
112	152121.458	160195.334	227.205	S 79° 49' 16.9" W						
104	151818.570	160738.066								
105	151821.750	160760.908								
106	152130.898	160713.504	371.386	N 7° 20' 00" W	98.627	69.0	132.526	110-02-47	42+52.76 E	43+85.29 E
107	152126.563	160995.133	288.707	S 77° 17' 13" E						
*	Indicates a P.I. point									

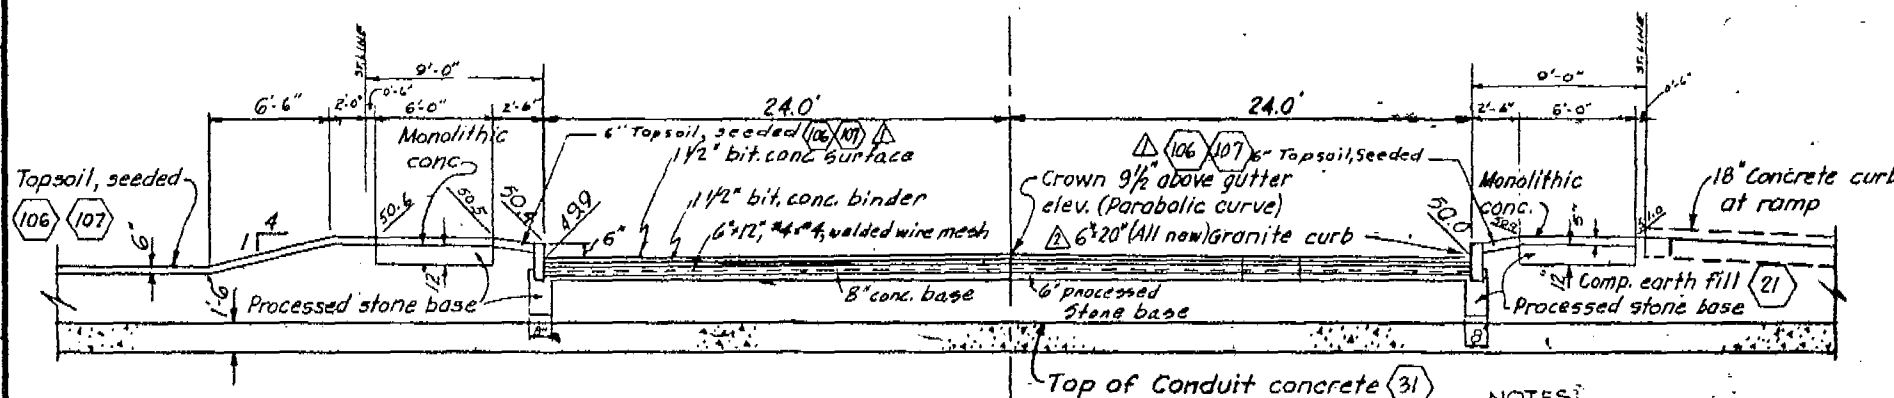

As Built Drawing

Contract No. DACW 33-76-C-0098

DES. BY I.F.R.	CHK. BY J.A.P.	APP. BY I.F.R.	DATE MARCH 1976
DEPARTMENT OF THE ARMY NEW ENGLAND DIVISION ENGINEERS WATER RESOURCES DEVELOPMENT PROJECT PARK RIVER LOCAL PROTECTION BOX CONDUIT AT SECTION 9 CONTROL DATA & MISCELLANEOUS DETAILS			
HARTFORD CONNECTICUT			
PAR-1			