



WEST SIDE

SCALE: HOR. 1"=20'
VERT. 1"=10'

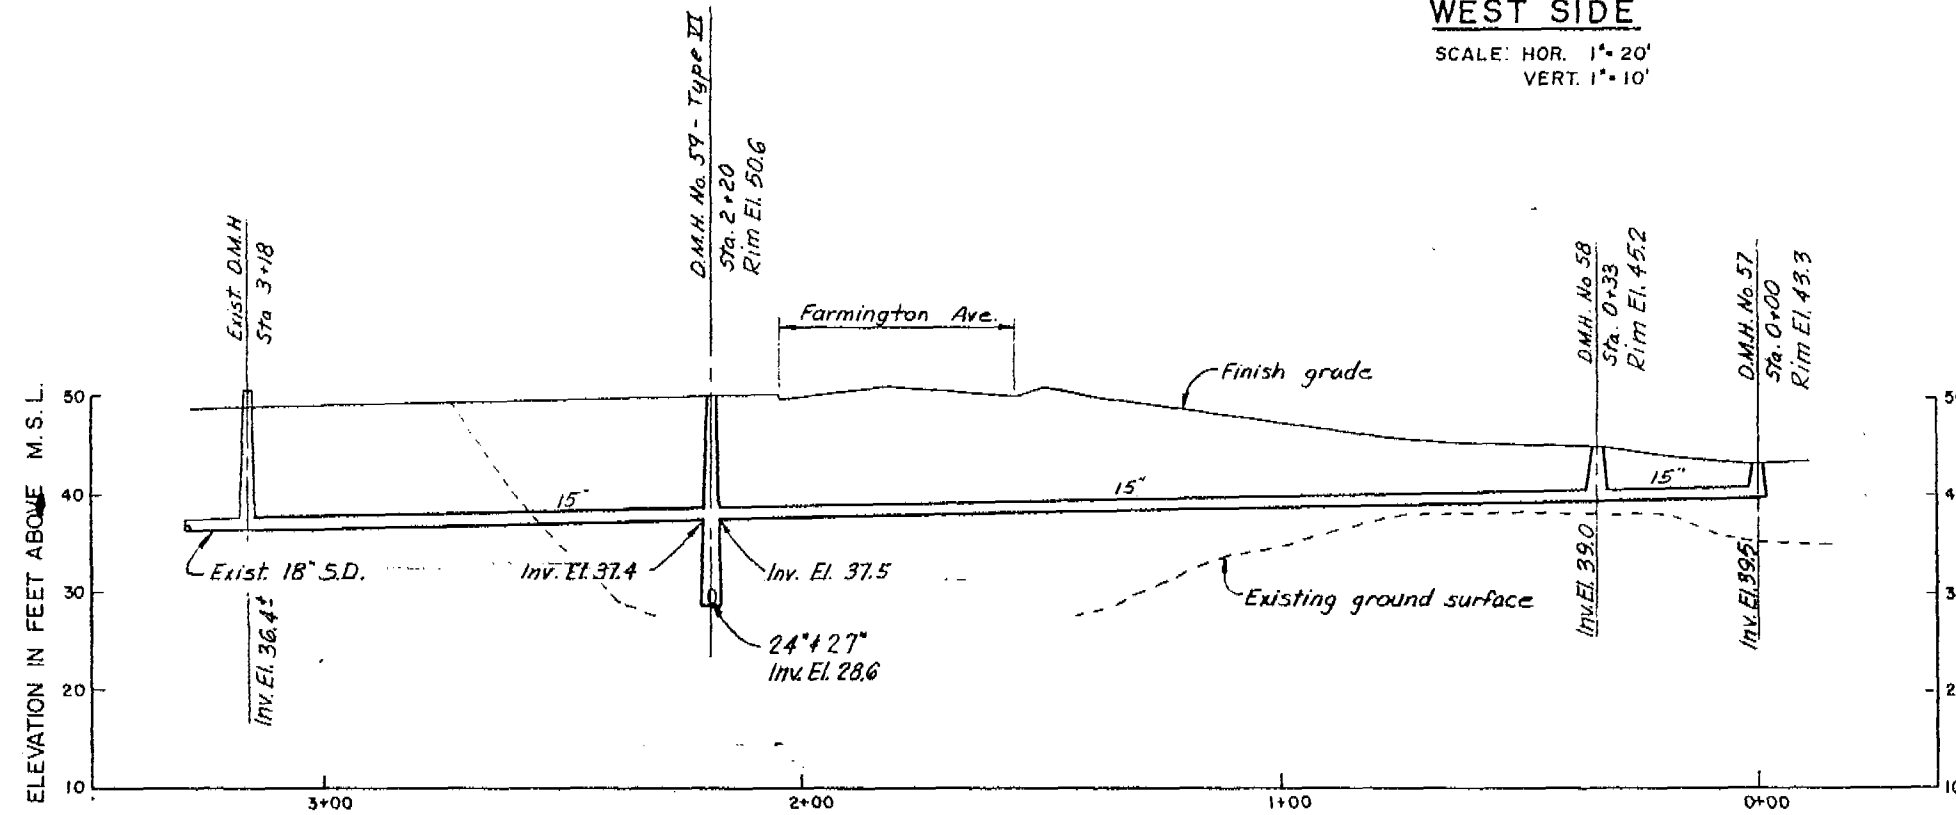

EAST SIDE

SCALE: HOR. 1"=20'
VERT. 1"=10'


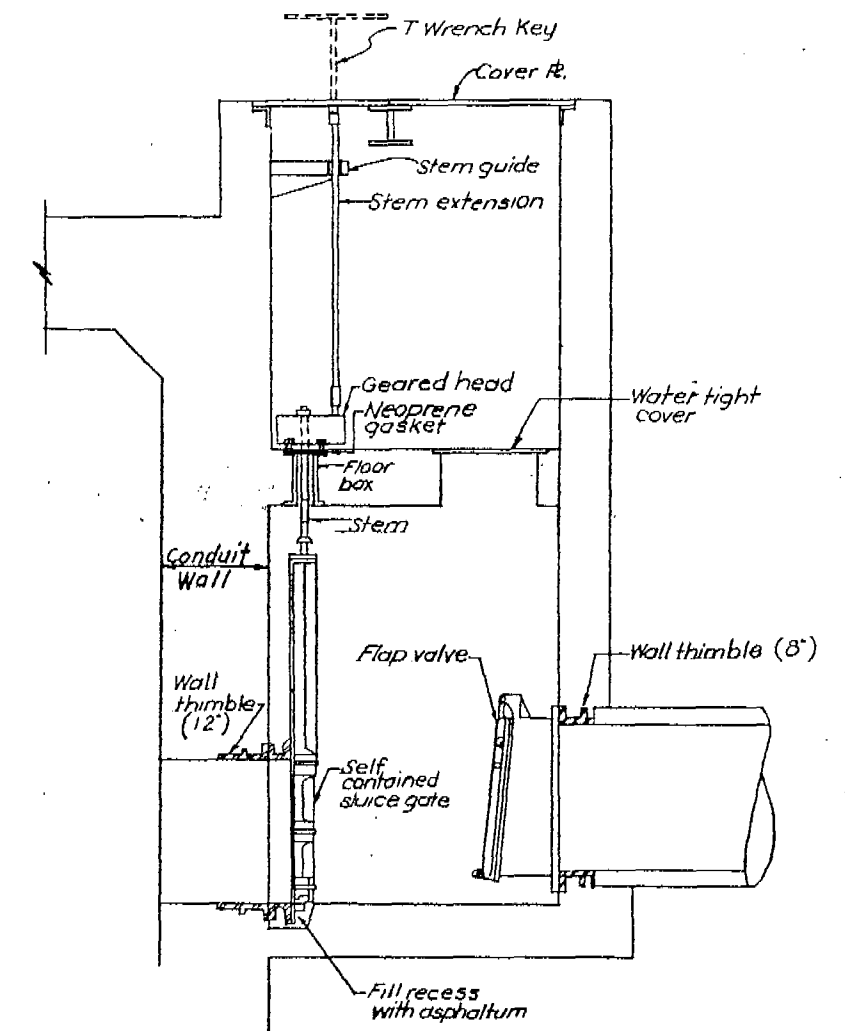


GATE CHAMBER-TYPICAL LAYOUT

NOT TO SCALE

NOTES:

1. For location of low level drains see Sheet 79.
2. All manholes shall be Type II unless otherwise noted.
3. Drain MH No. 59 changed from Type II to VI.

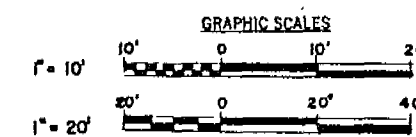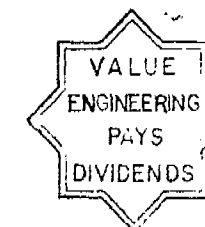

As Built Drawing

Cons. No. DACW 33-76C-0098

4-4-83 Final field corrections			
REVISION	DATE	DESCRIPTION	BY
DEPARTMENT OF THE ARMY NEW ENGLAND DIVISION CORPS OF ENGINEERS WALTHAM, MASS.			
WATER RESOURCES DEVELOPMENT PROJECT PARK RIVER LOCAL PROTECTION BOX CONDUIT AT SECTION 9 LOW LEVEL DRAINAGE PROFILES			
DES. BY W.F.	CHK. BY W.F.	HARTFORD CONNECTICUT DATE MARCH 1976	
SUBMITTED BY H. Stevens CHIEF, UTILITIES SECTION		APPROVED [Signature] CHIEF, PROJECT BRANCH	
APPROVAL RECOMMENDED [Signature] CHIEF, PROJECT BRANCH		APPROVAL RECOMMENDED [Signature] CHIEF, PROJECT BRANCH	
REVIEWED [Signature] PROJECT ENGINEER		SCALE AS SHOWN SPEC. NO. DACW33-76-B-0040 DRAWING NUMBER PAR - I	
SHEET 87			