




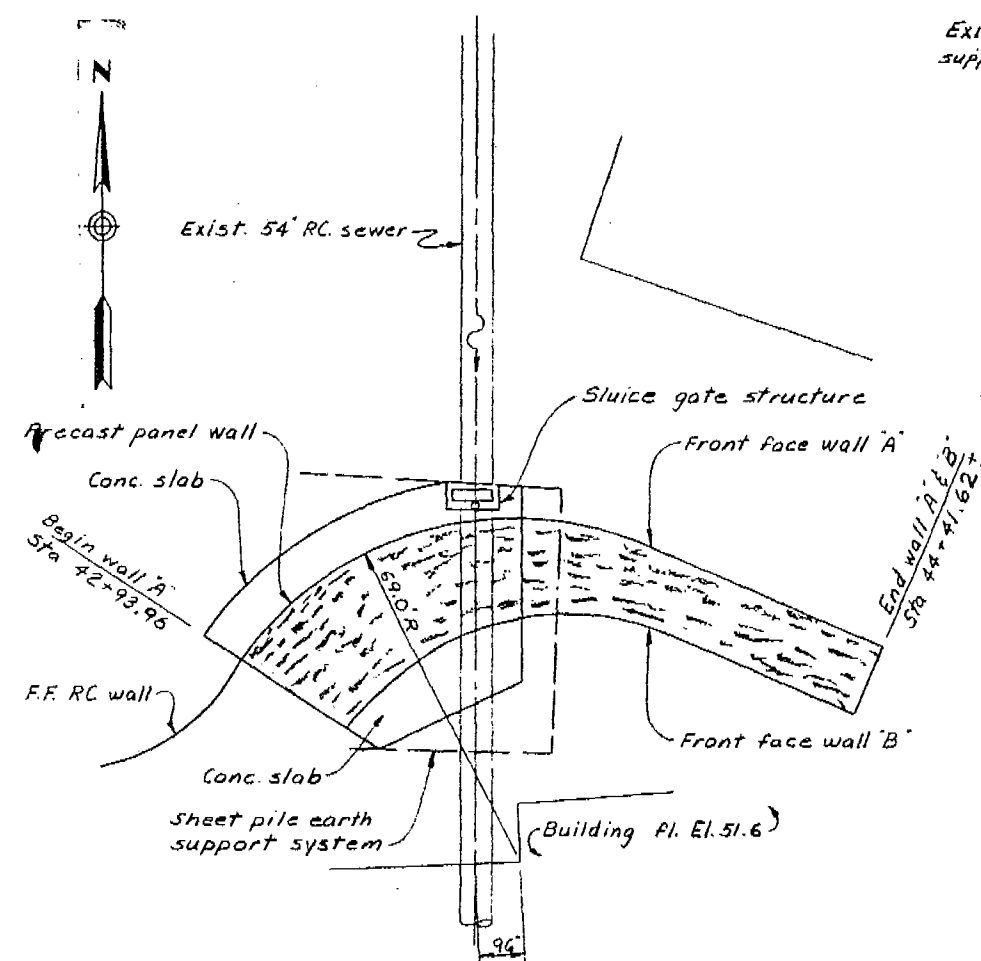


SITE PLAN
SCALE: 1" = 20'

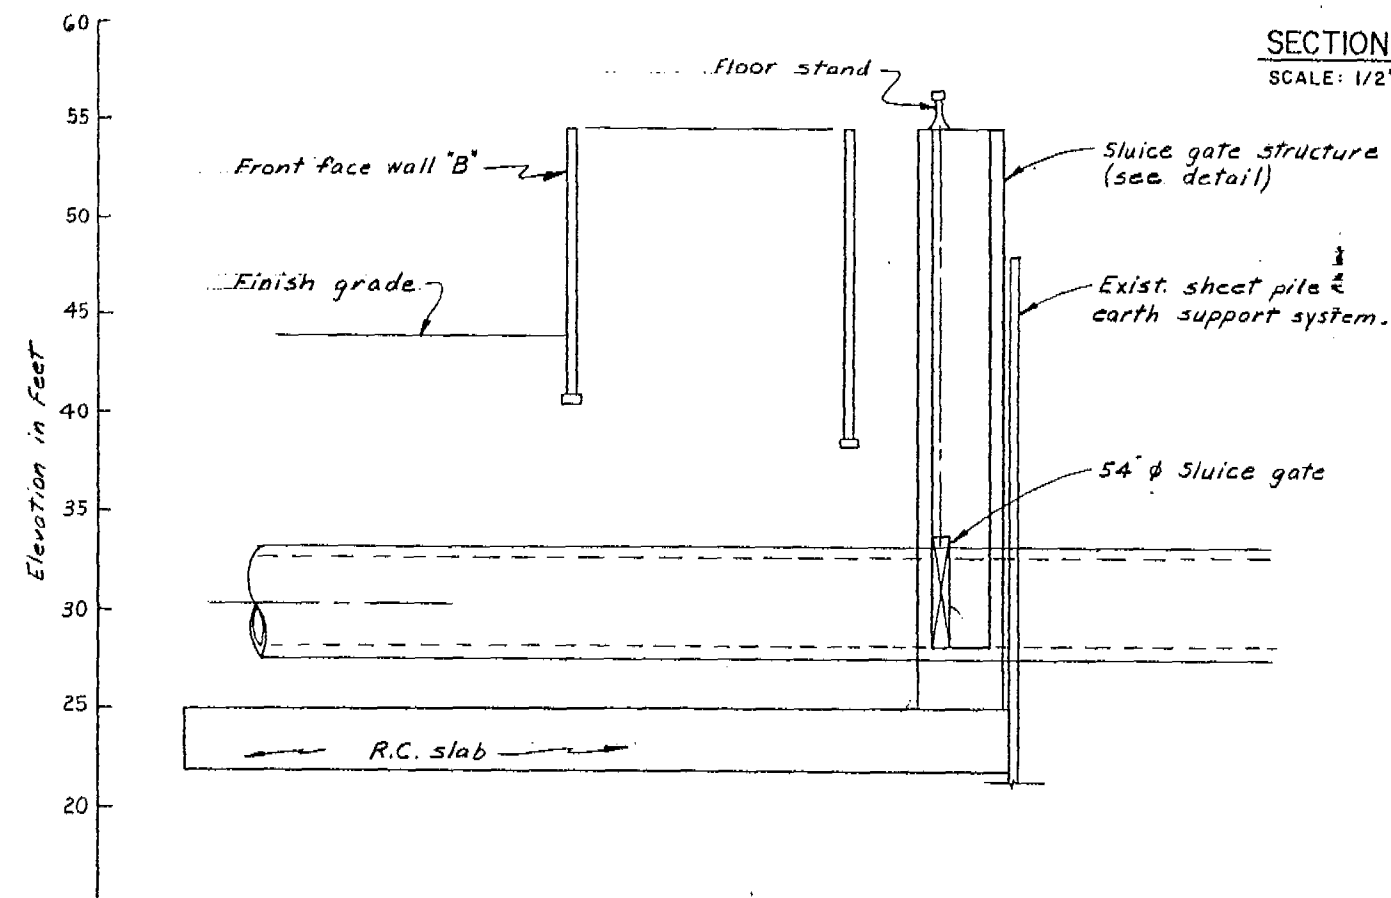


SITE ELEVATION

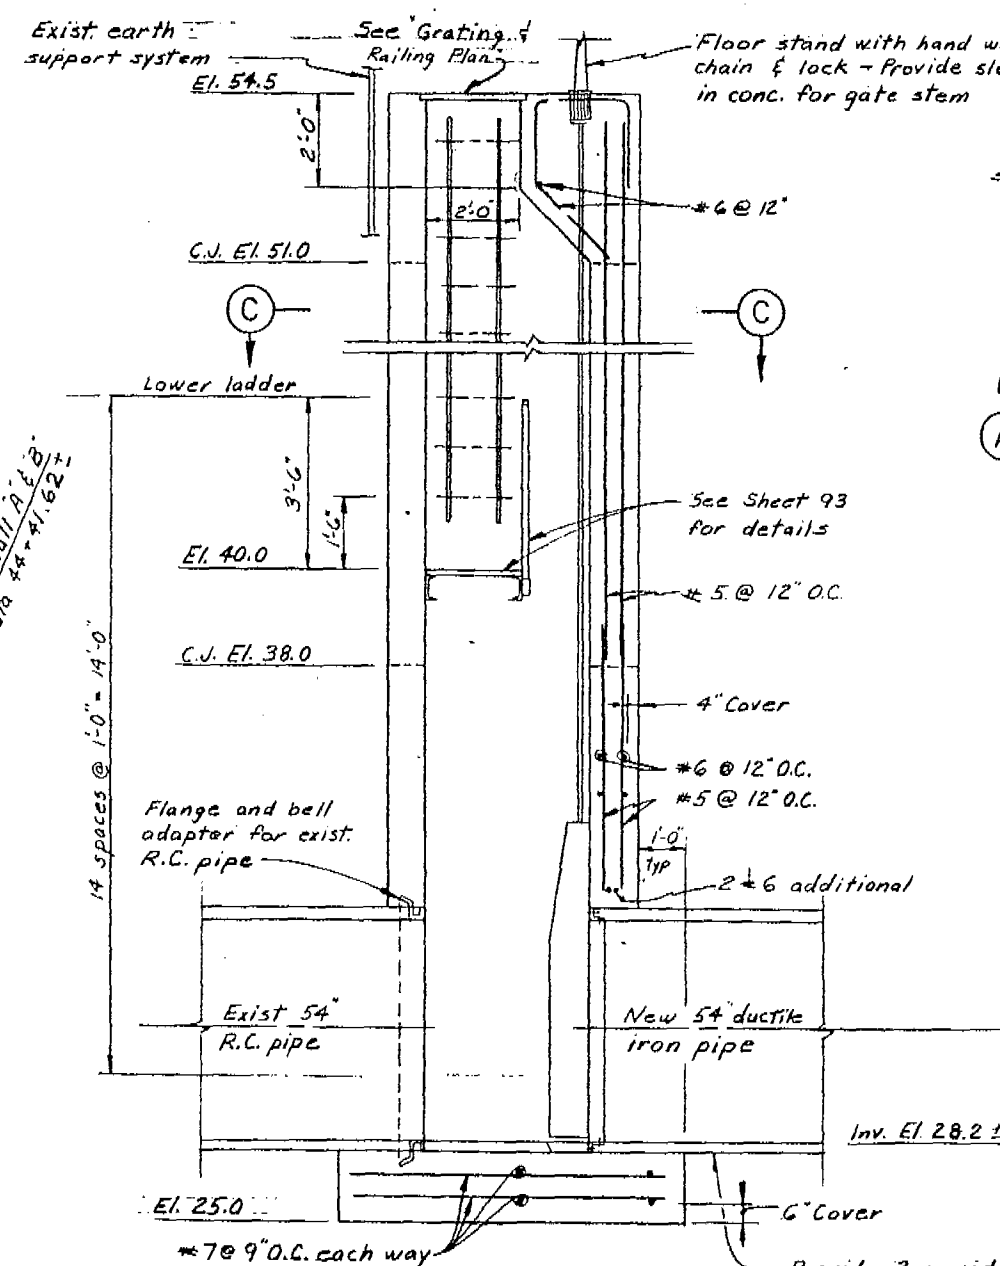


SECTION A-A
SCALE: 1/2" = 1'-0"

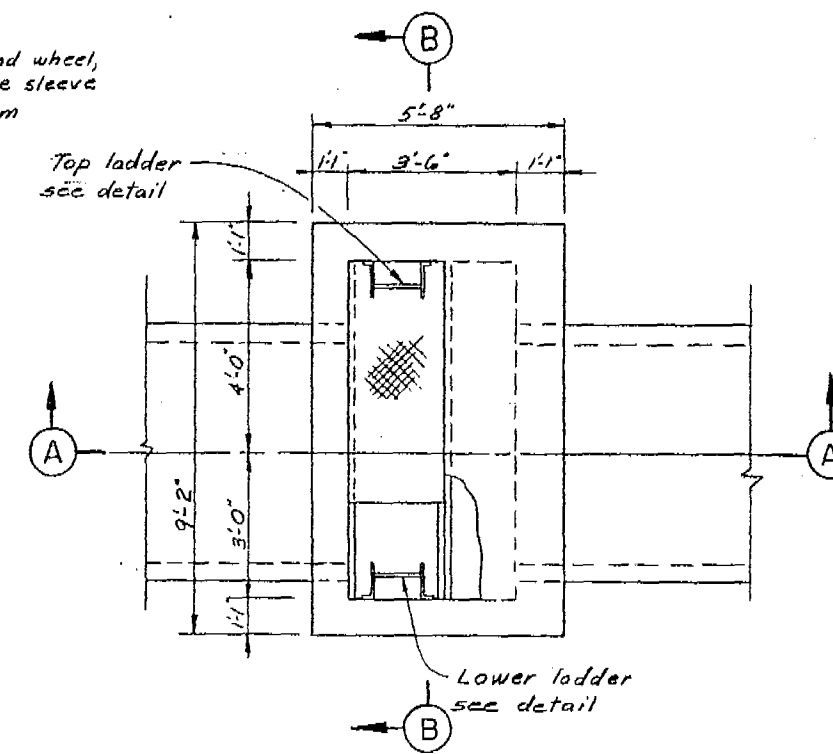


SLUICE GATE PLAN
SCALE: 1/2" = 1'-0"

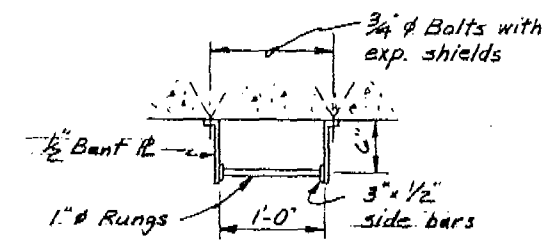

SECTION D-D
SCALE: 3/4" = 1'-0"

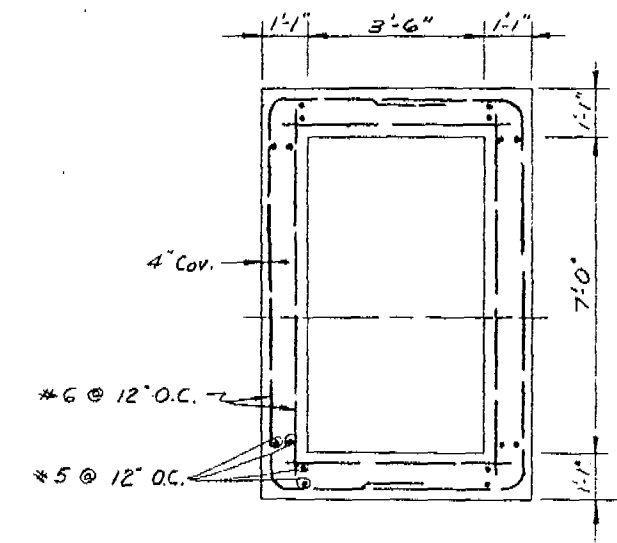


SECTION C-C
SCALE: 1/2" = 1'-0"

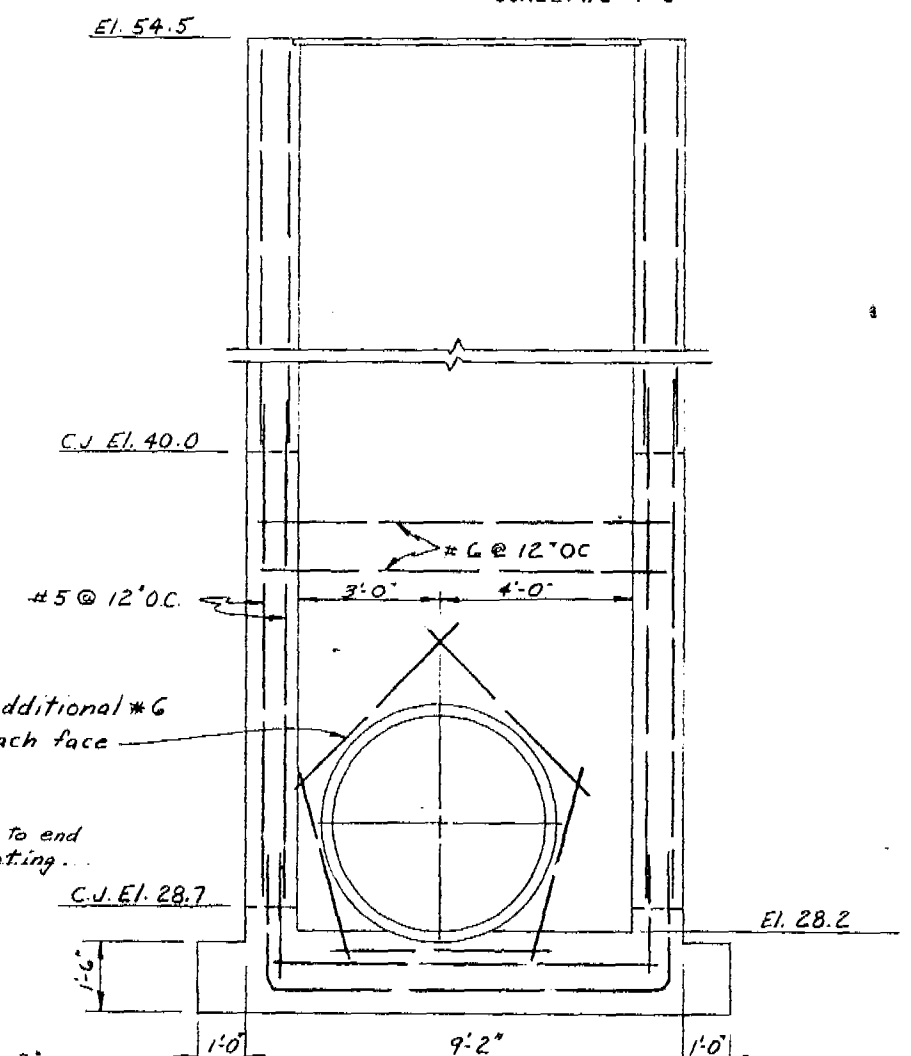


SECTION B-B
SCALE: 1/2" = 1'-0"

As Built Drawing


Contract No. DACW 33-76-C-0098

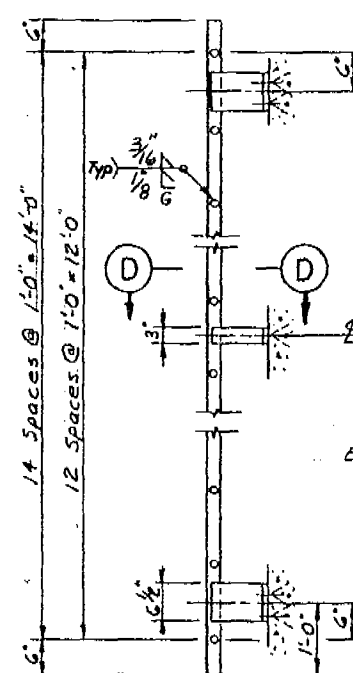


LADDER DETAIL
SCALE: 3/4" = 1'-0"

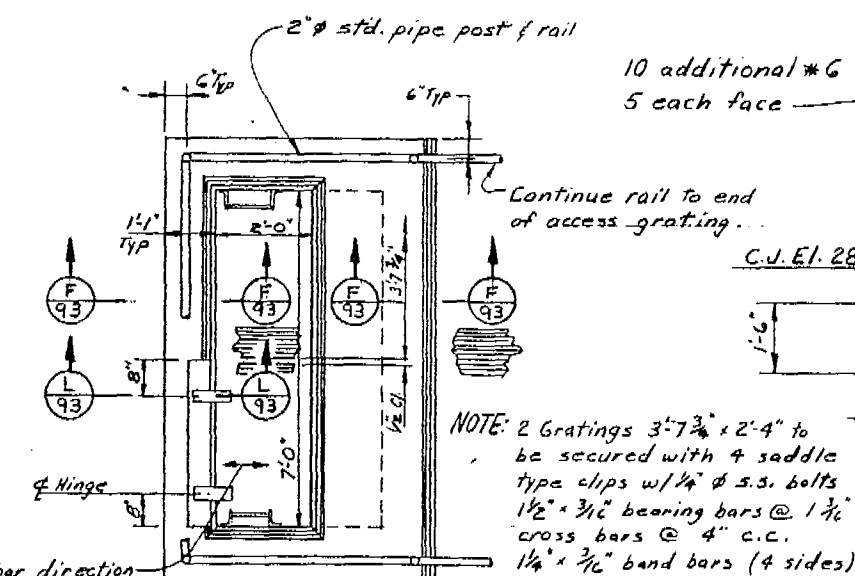

GRATING & RAILING PLAN
SCALE: 1/2" = 1'-0"

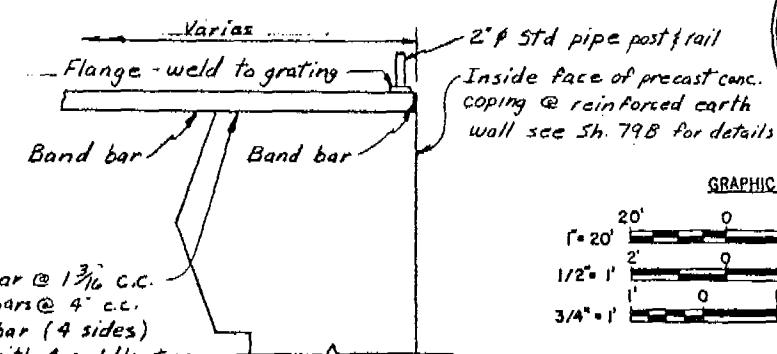

ACCESS GRATING DETAIL
N.T.S.

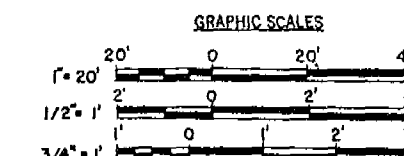

REVISION	DATE	DESCRIPTION	BY

DES. BY W.E./J.C.		DR. BY KAV.	CK. BY J.C.
SUBMITTED <i>[Signature]</i>			
CHIEF, CIVIL ENGINEERING SECTION			
APPROVAL RECOMMENDED <i>[Signature]</i>			
CHIEF, DESIGN BRANCH			
REVIEWED <i>[Signature]</i>			
PROJECT ENGINEER			
APPROVAL RECOMMENDED CHIEF, PROJECT BRANCH		APPROVED <i>[Signature]</i>	
HARTFORD		CONNECTICUT	
DATE APRIL 1979			
SCALE AS SHOWN SPEC. NO. DACW 33-76-B-0040			
DRAWING NUMBER PAR - I			
SHEET 87A			