
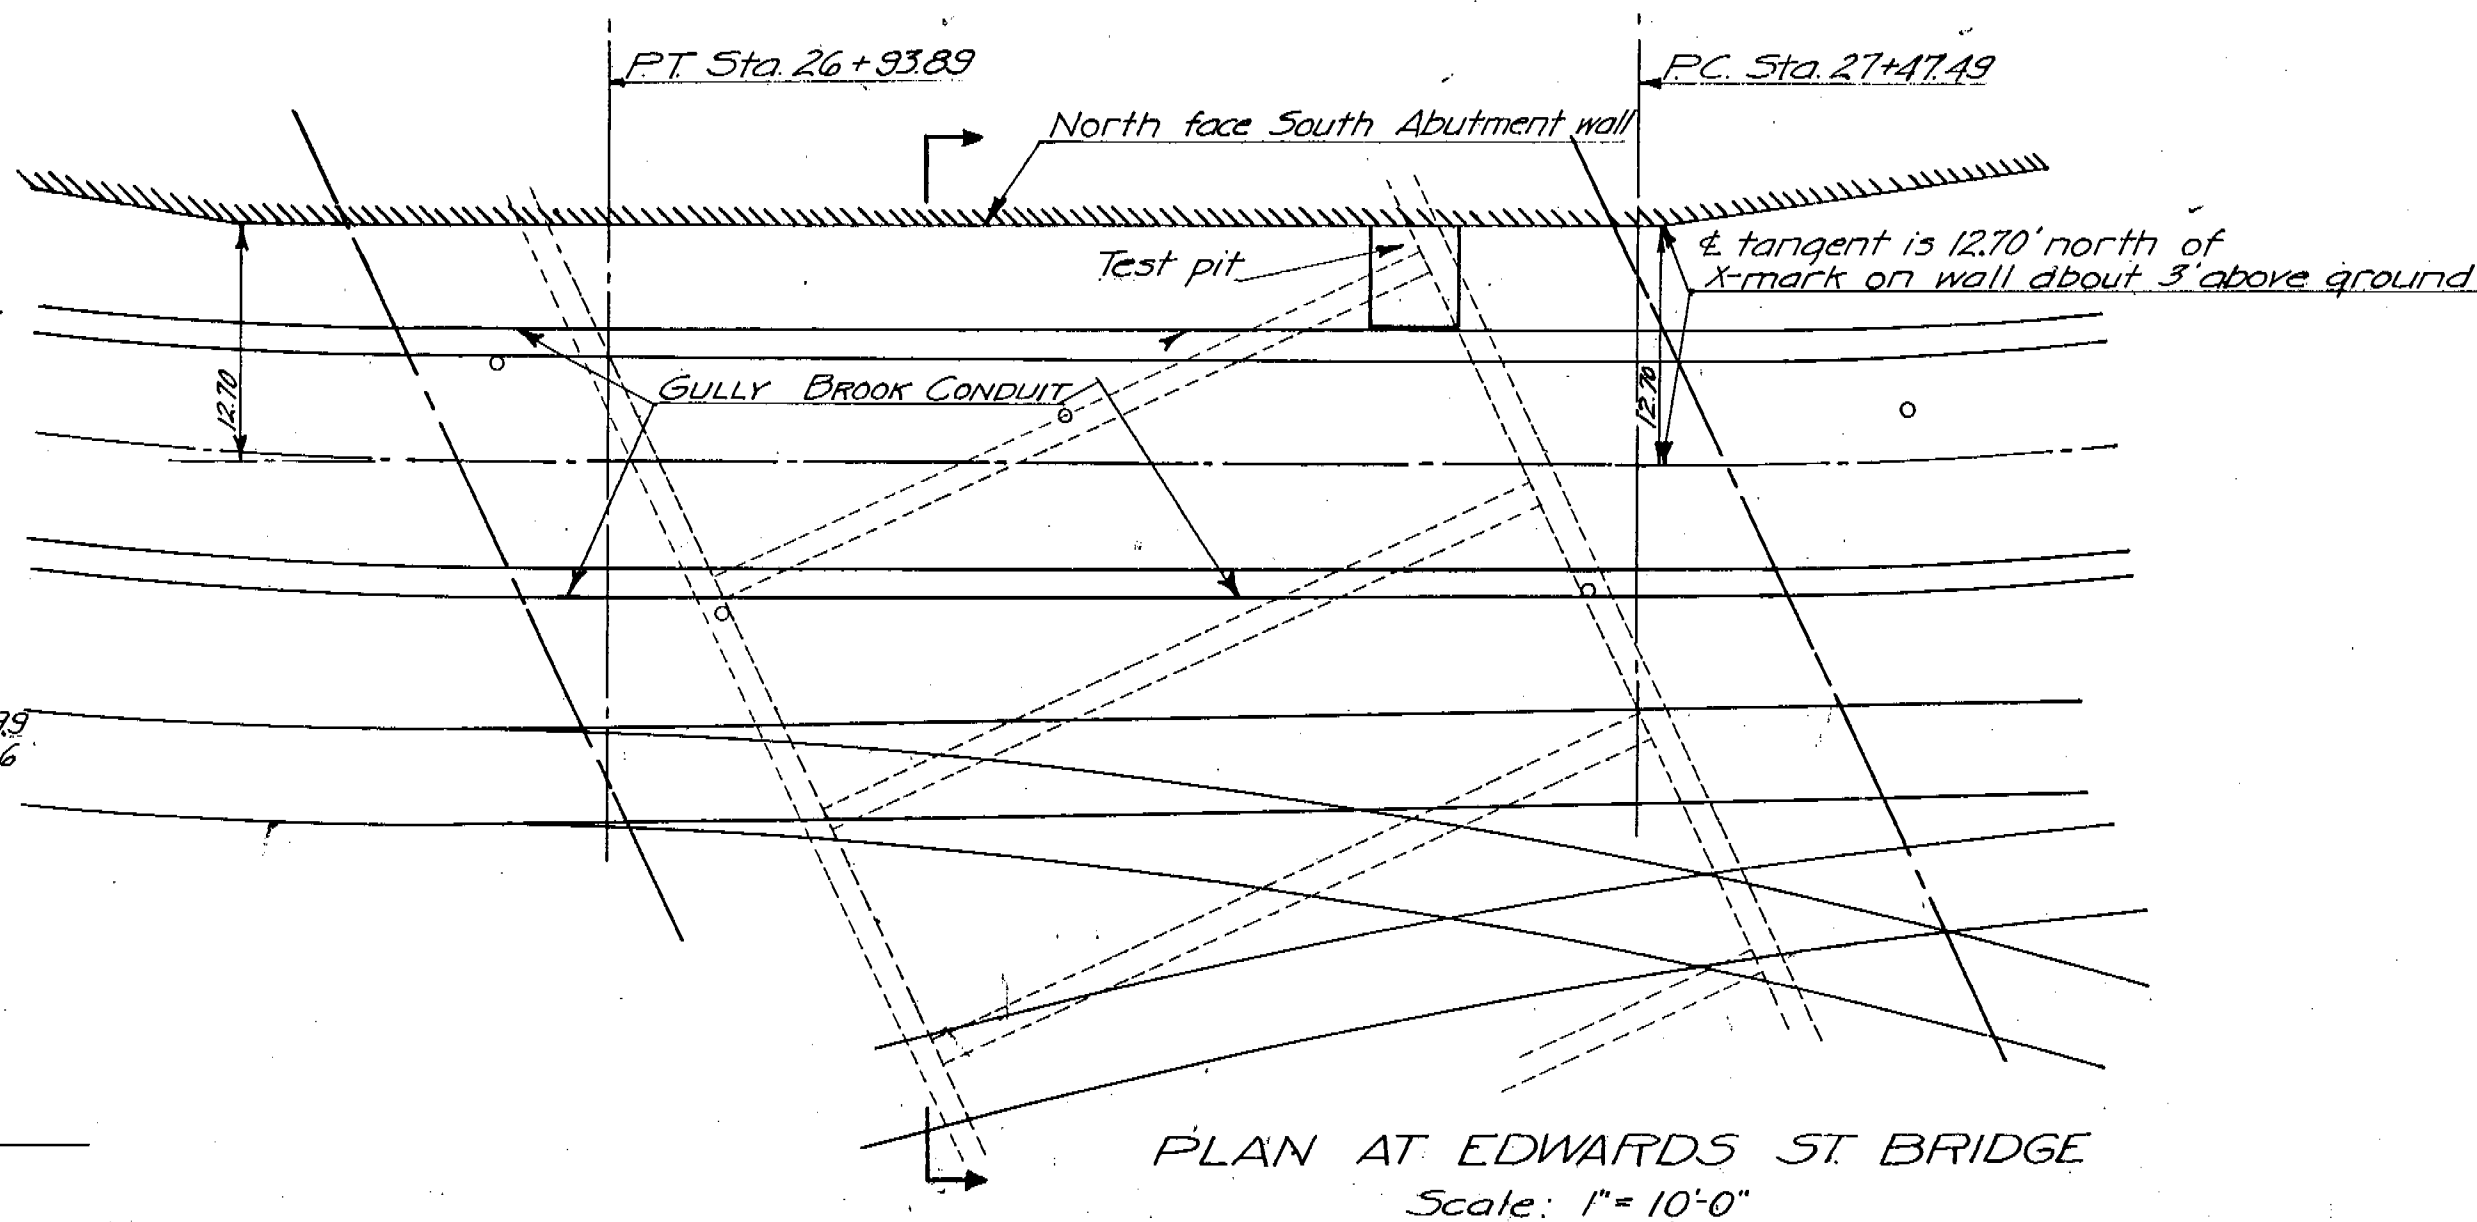
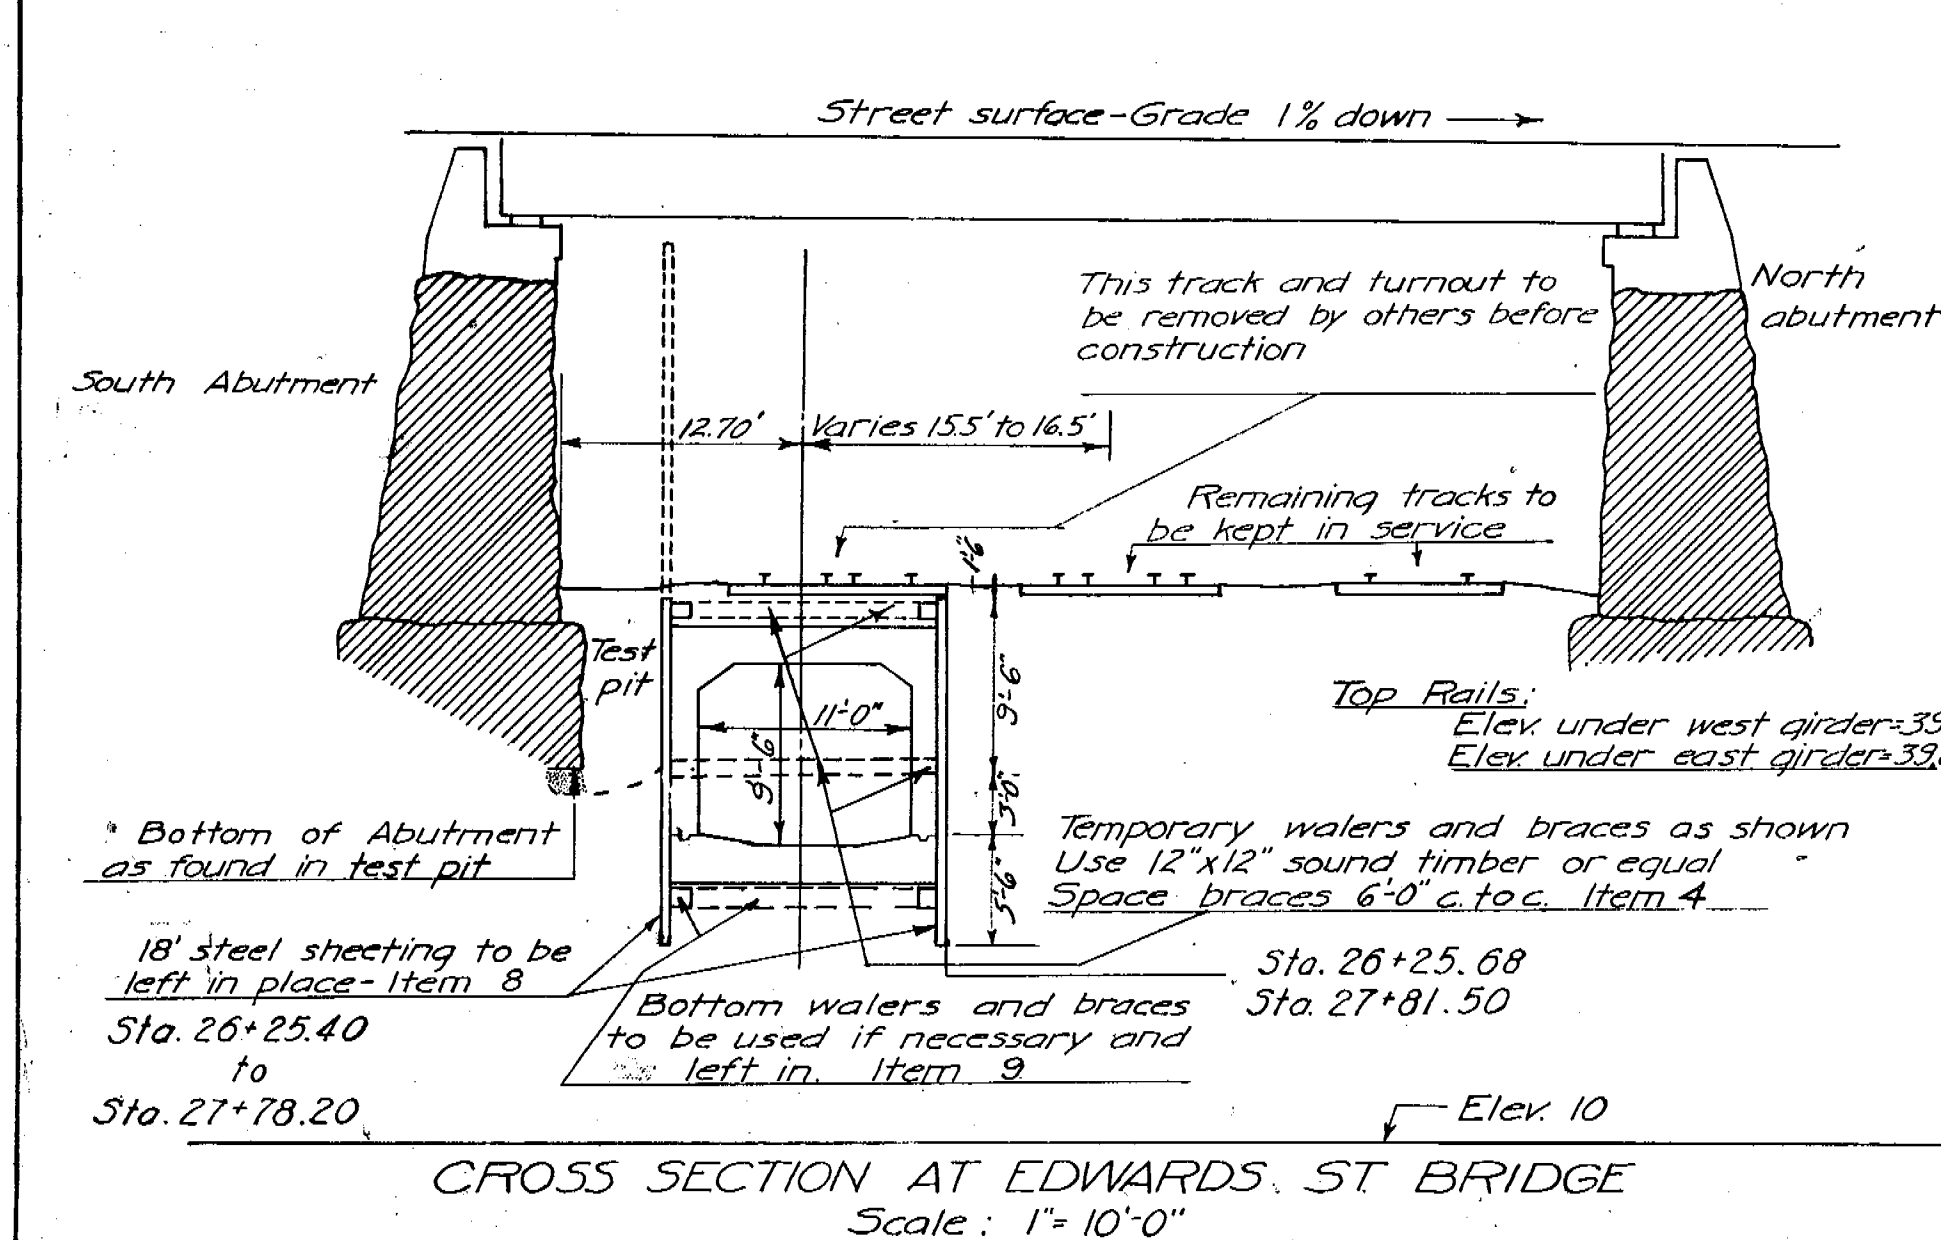


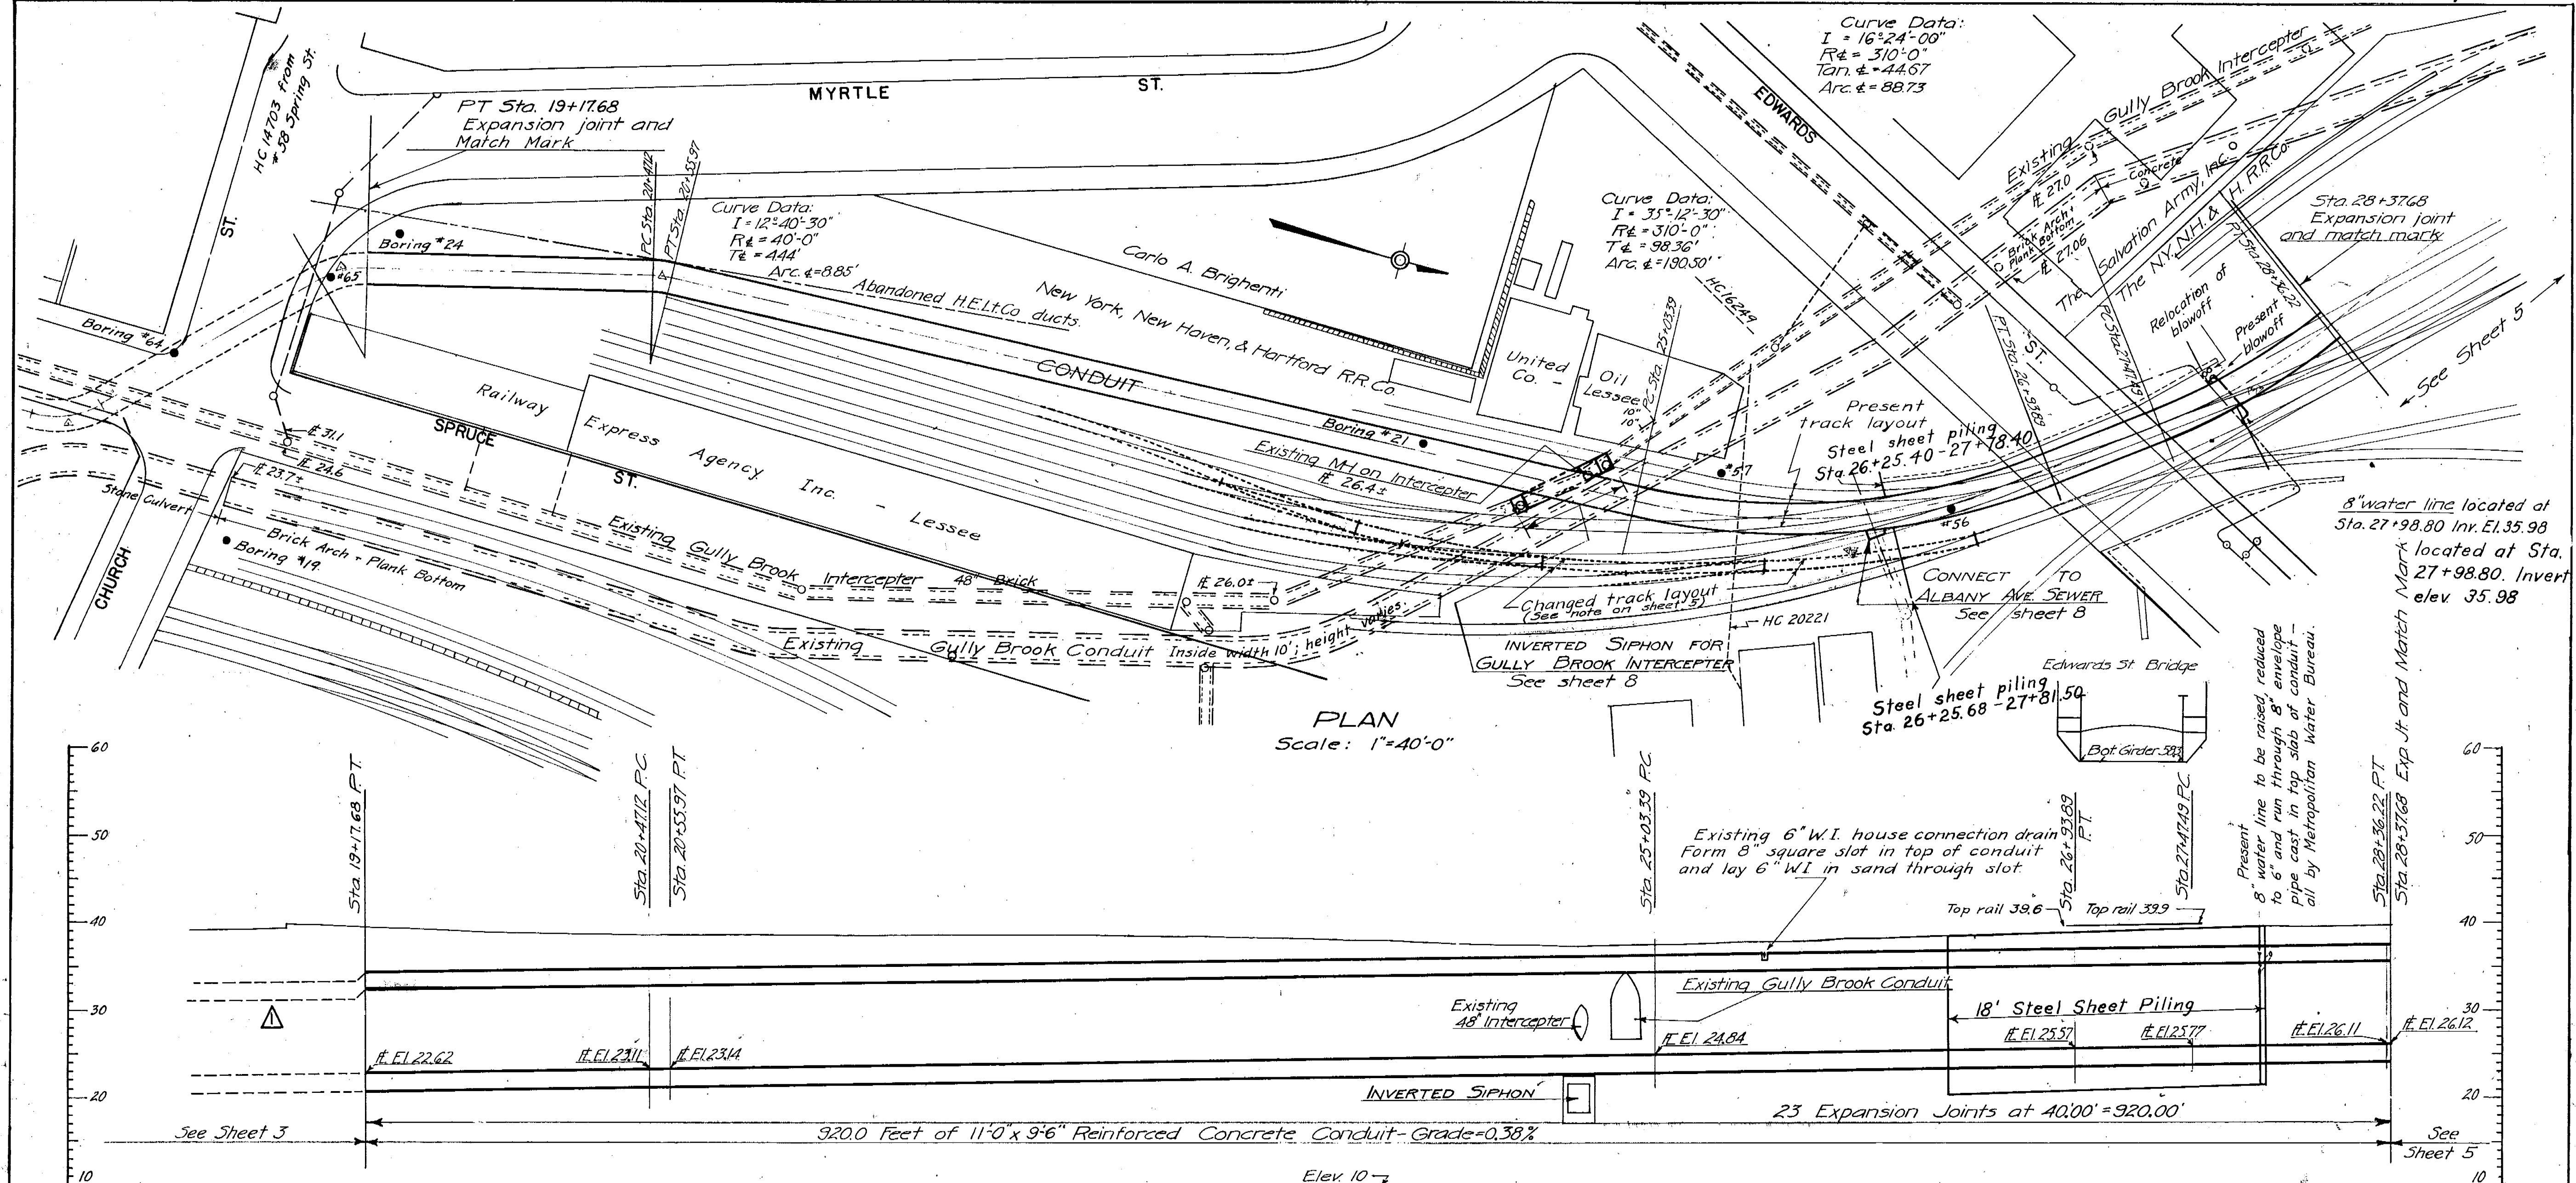

12-31-45	As built revisions		
9-4-43	Conduit Roof lowered 1 ft.	Aug 1943	280
KEY	DATE	REVISION (Indicated by Δ)	REV BY CK BY AP BY
CONNECTICUT RIVER FLOOD CONTROL GULLY BROOK CONDUIT HARTFORD CONN. PLAN AND PROFILE FROM CHURCH STREET TO EDWARDS STREET STA. 19+17.68 TO STA. 28+37.68			
PARK RIVER		CONNECTICUT	
IN 9 SHEETS		SHEET NO. 4	
U. S. ENGINEER OFFICE, PROVIDENCE, R. I.,		JULY, 1943	
REVIEWED:	APPROVED:	RECOMMENDED:	APPROVED:
E. M. Lane	W. G. D.	W. G. D.	W. G. D.
ENGINEER	PRINCIPAL ENGINEER	CHIEF, P.C. PLANNING DIV.	DISTRICT ENGINEER
BASIC DESIGN	DRAWN:	W. G. D.	
BY	TRACED:	W. G. D.	
THE CITY OF HARTFORD	CHECKED:	A. W. S.	
FILE NO. CT-4-3152			