


CROSS SECTIONS
SCALE 1 INCH = 5 FEET

STATE		TOWN		PROJ. NO.		YEAR		SHEET NO.		TOTAL SHEETS	
CONN.		HARTFORD				1958		6		7	

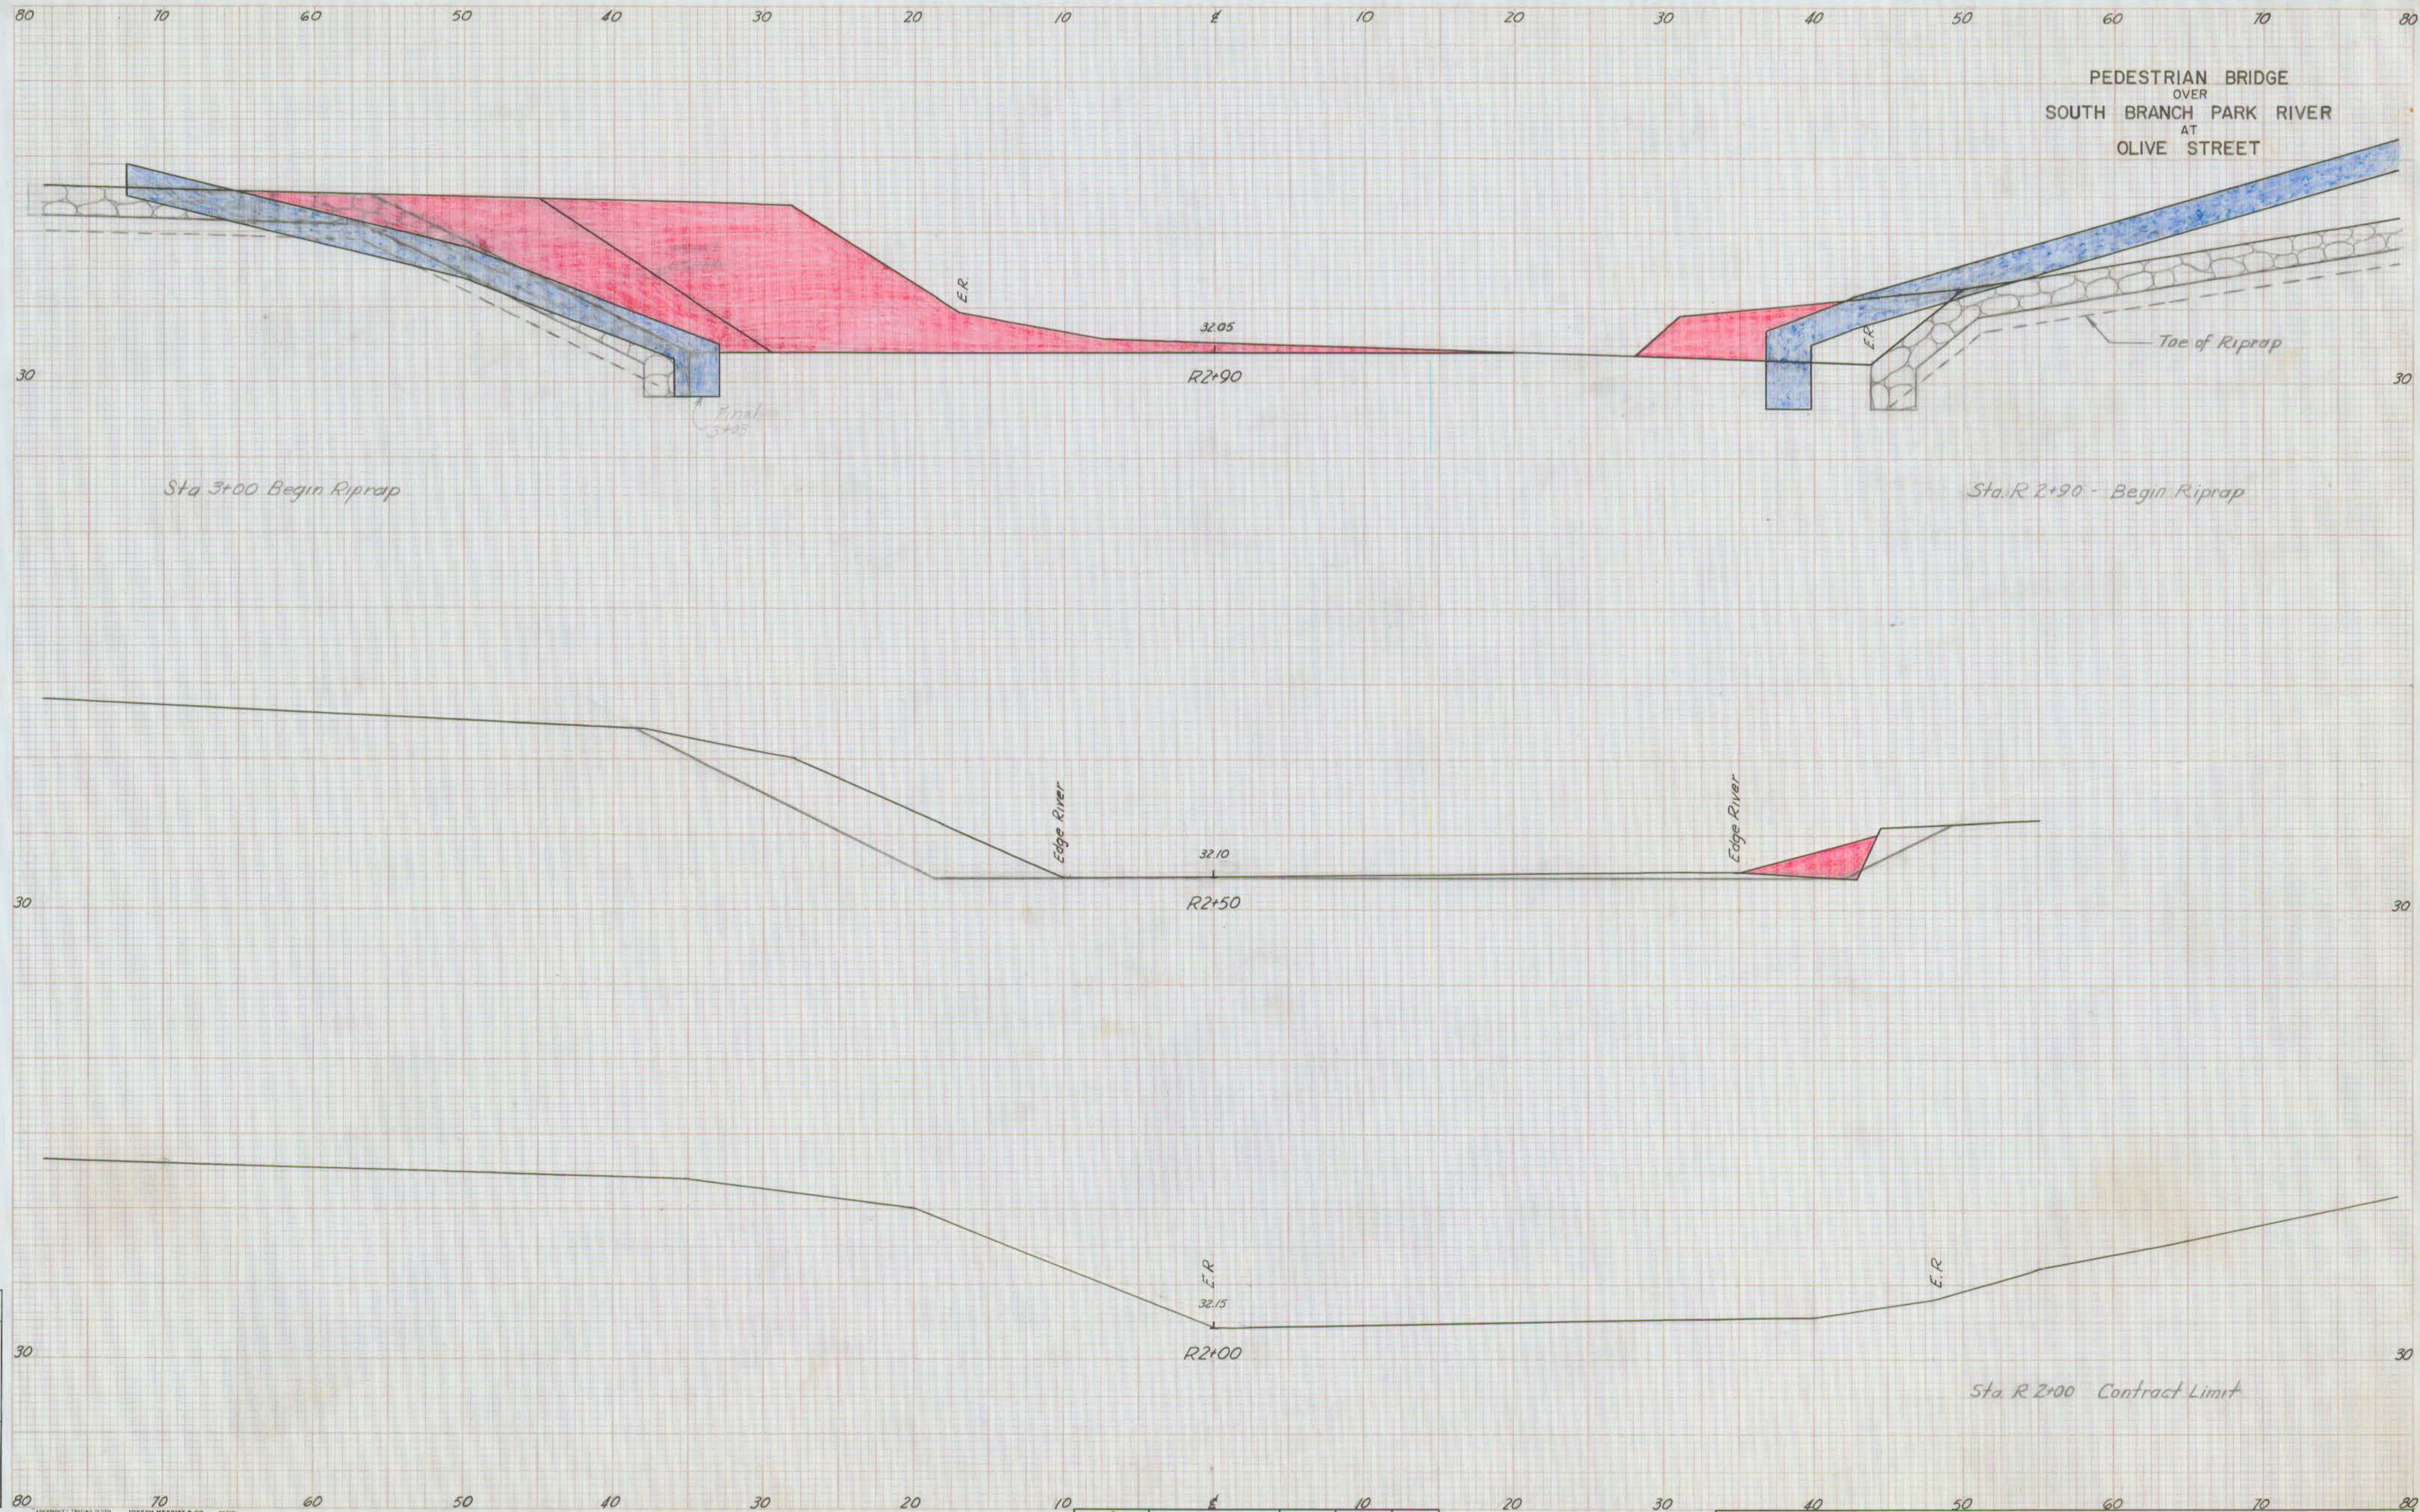

NOTE BOOK NO. 46-1	
Ground Surface Plotted by	M. Jacobson
" " Checked by	F. Ceballos
Template Sections Plotted by	M. Jacobson
" " Checked by	F. Ceballos
Areas by	
" " Checked by	
Final Sections Plotted by	
" " Checked by	
Final Areas by	
" " Checked by	
Quantity Transferred and Inked by	

1*	AS BUILT	9/30/58	K.H.W.	E.L.F.
REVISION		DATE	DRAWN	CHKD

G.H.F.C. Serial No. 000627

THE INFORMATION, INCLUDING ESTIMATED QUANTITIES OF WORK, SHOWN ON THESE SHEETS IS BASED ON LIMITED INVESTIGATIONS BY THE COMM. AND IS IN NO WAY WARRANTED TO INDICATE THE TRUE CONDITIONS OR ACTUAL QUANTITIES OR DISTRIBUTION OF QUANTITIES OF WORK WHICH WILL BE REQUIRED.