


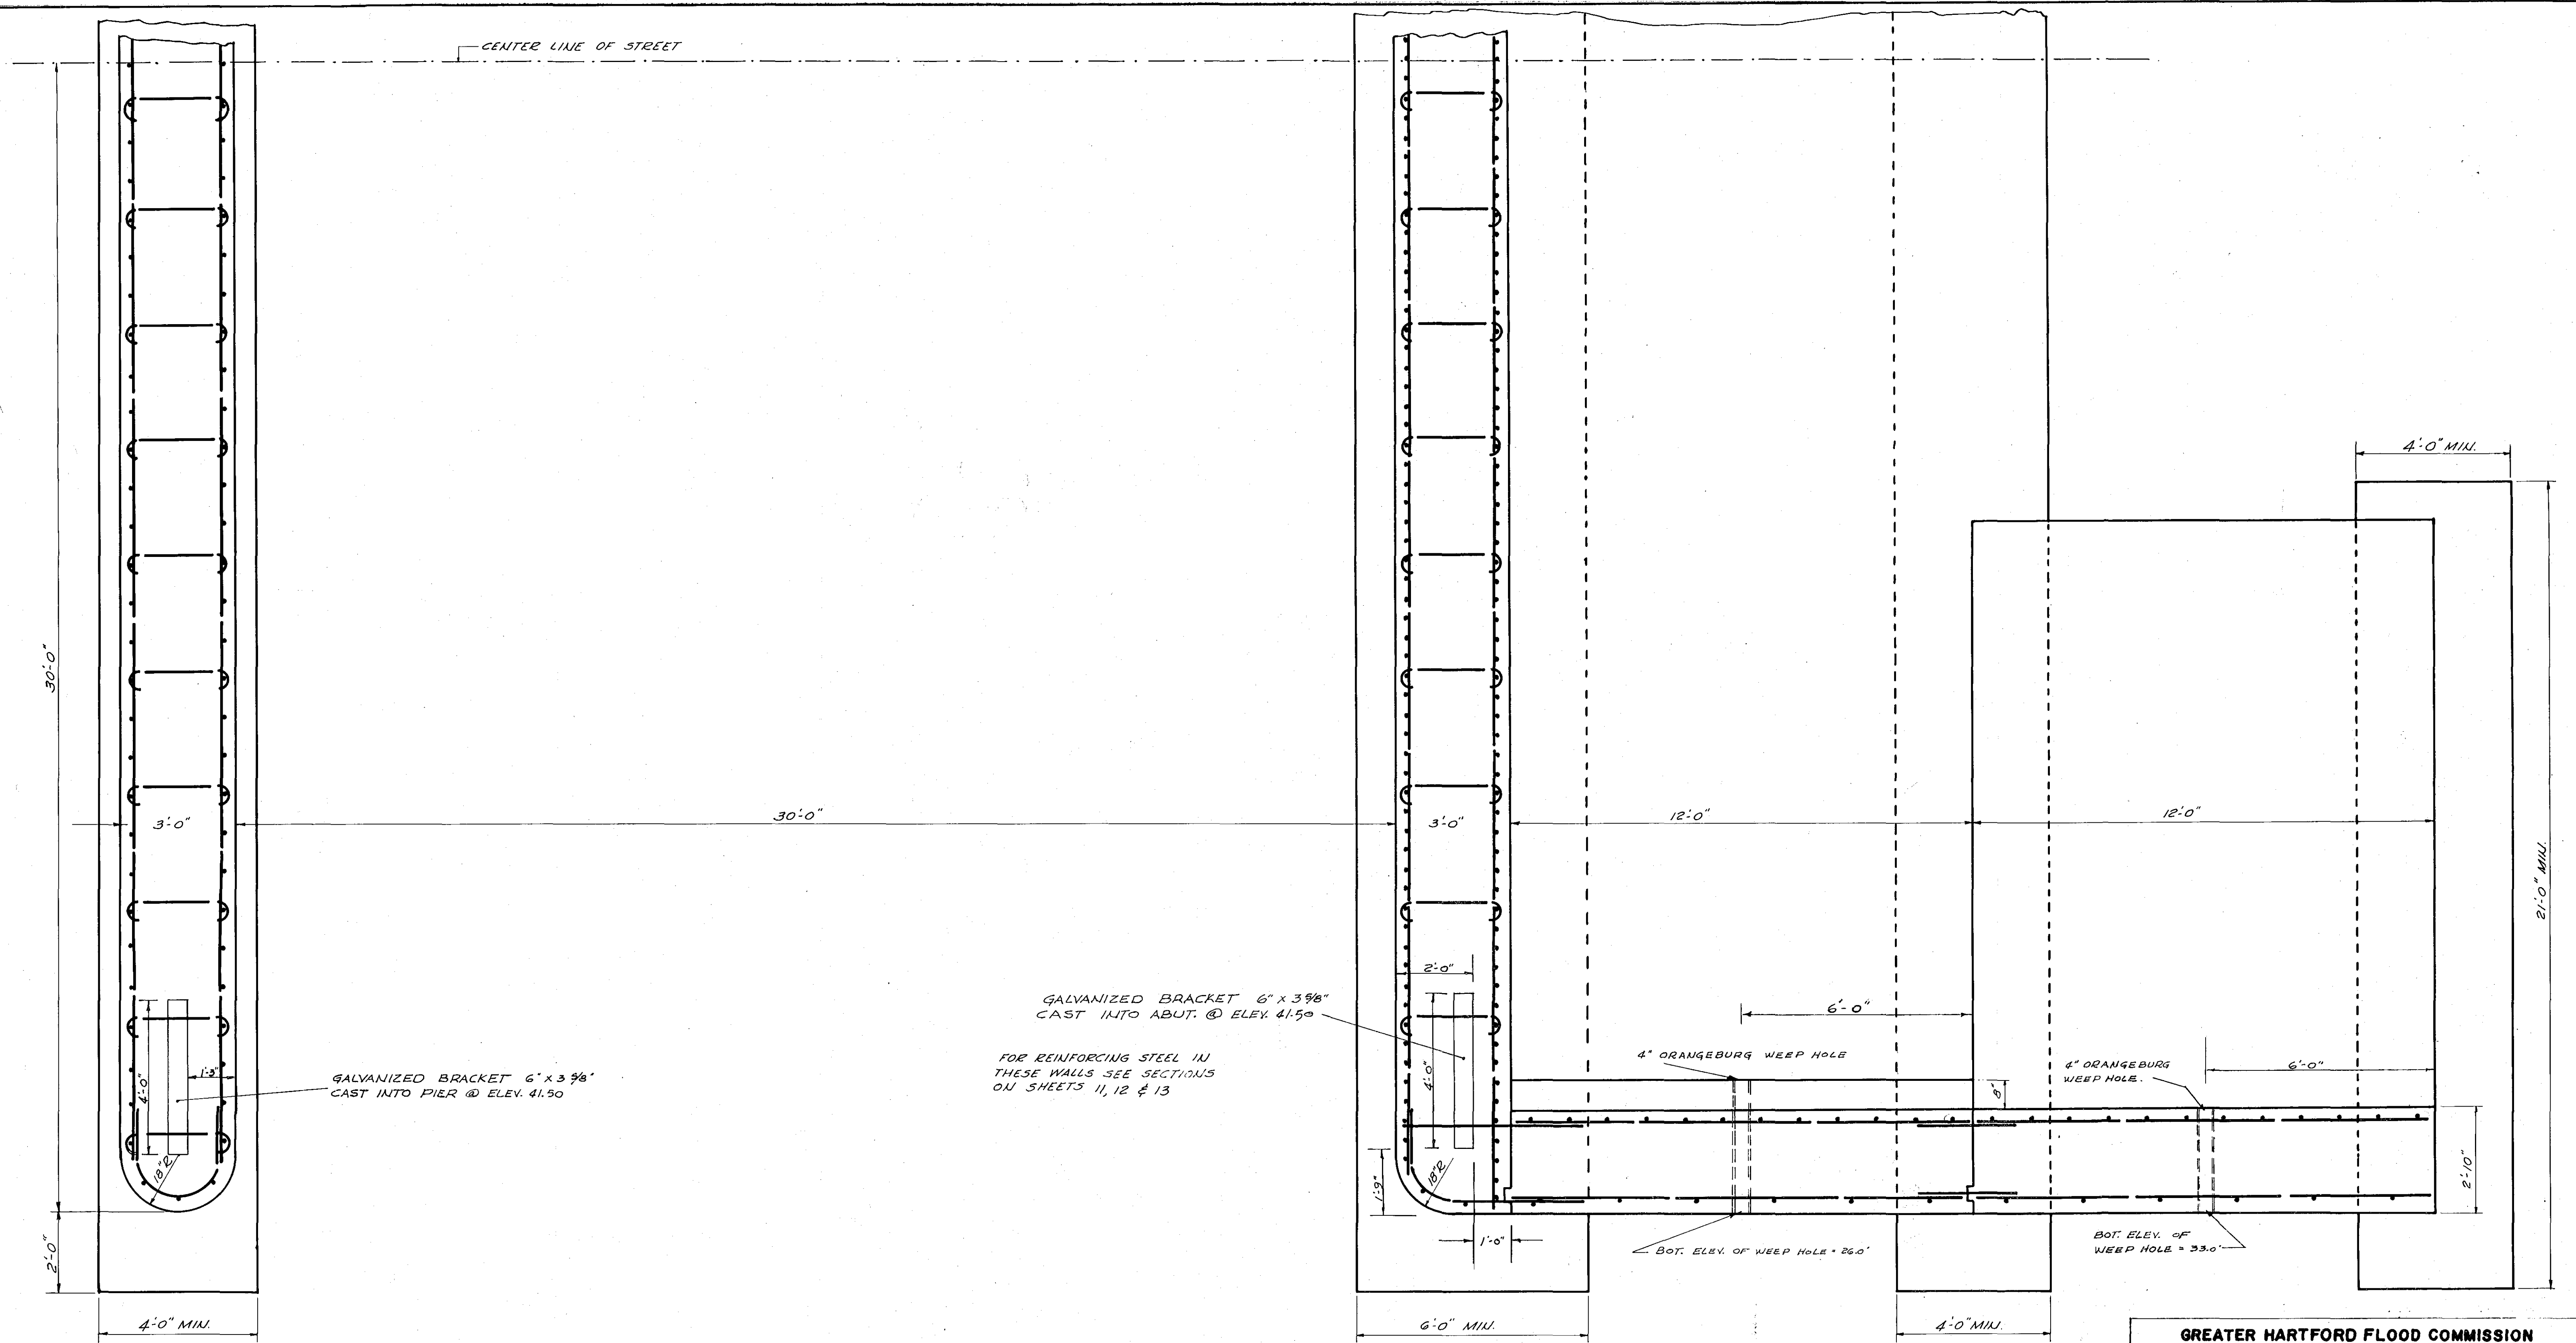

HORIZONTAL SECTION
AT ELEVATION 31.0'

AS BUILT PLAN NOV. 1959

GREATER HARTFORD FLOOD COMMISSION HARTFORD, CONNECTICUT	
DESIGNED BY R.E.C.	HAMILTON ST. BRIDGE
TRACED BY C.C.K.	HORIZONTAL QUARTER SECTION AT ELEVATION 31.0
CHECKED BY	
SCALE 1" = 2'-0"	
DATE MAY 1959	SERIAL NO. 000830
RECOMMENDED BY PE CONN. NO 554 APPROVED BY PE CONN. NO 290	CHIEF ENGINEER DIRECTOR
DRAWING NUMBER 14 SHEET 14 OF 16	